






Mobile Home Permit Worksheet

Installer: Ronald Ryan Davis License # 1H115509

Address of home being installed: 130 NW Sunset Amanda Way
Lake City FL

Manufacturer: _____ Length x width: 16 x 60

NOTE: If home is a single wide fill out one half of the blocking plan
If home is a triple or quad wide sketch in remainder of home
I understand Lateral Arm Systems cannot be used on any home (new or used)
where the sidewall ties exceed 5 ft 4 in. Installer's initials: [Signature]

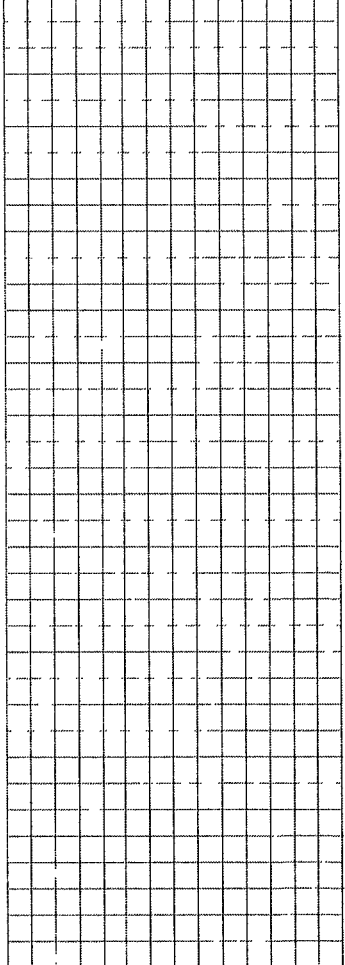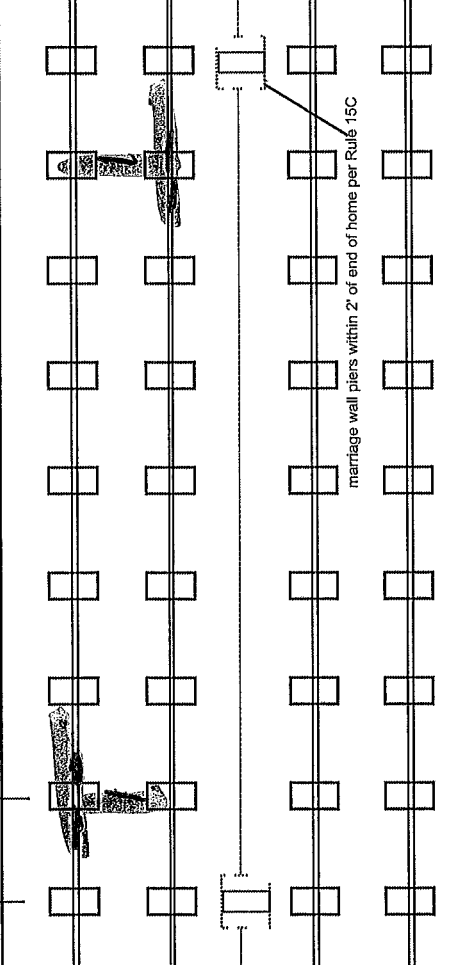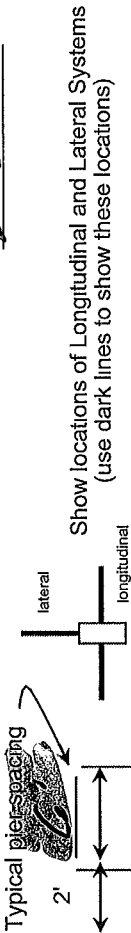

Permit Number: _____ Date: _____

New Home ☐ Used Home ☒

Home installed to the Manufacturer's Installation Manual
Home is installed in accordance with Rule 15-C ☒

Single wide ☒ Wind Zone I ☒ Wind Zone II ☐ Wind Zone III ☐

Double wide ☐ Installation Decal # _____

Triple/Quad ☐ Serial # 113417

PIER SPACING TABLE FOR USED HOMES

Load bearing capacity	Footer size (sq in)	16" x 16" (256)	18 1/2" x 18 1/2" (342)	20" x 20" (400)	22" x 22" (484)*	26" x 26" (676)
1500 psf	3'	4'	5'	6'	8'	8'
2000 psf	4'	6'	7'	8'	8'	8'
2500 psf	6'	8'	8'	8'	8'	8'
3000 psf	7'	8'	8'	8'	8'	8'
3500 psf	8'	8'	8'	8'	8'	8'

*interpolated from Rule 15C-1 pier spacing table.

PIER PAD SIZES

I-beam pier pad size: 24 x 24
Perimeter pier pad size: 16 x 16
Other pier pad sizes (required by the mfg.): _____

POPULAR PAD SIZES

Pad Size	Sq In
16 x 16	256
16 x 18	288
18.5 x 18.5	342
16 x 22.5	360
17 x 22	374
13 1/4 x 26 1/4	348
20 x 20	400
17 3/16 x 25 3/16	441
17 1/4 x 25 1/4	446
24 x 24	576
26 x 26	676

Draw the approximate locations of marriage wall openings 4 foot or greater. Use this symbol to show the piers.

List all marriage wall openings greater than 4 foot and their pier pad sizes below.

Opening _____ Pier pad size _____

ANCHORS ☒

FRAME TIES ☒

within 2' of end of home spaced at 5' 4" oc

TIEDOWN COMPONENTS

Longitudinal Stabilizing Device (LSD)
Manufacturer: 1131 VDT
Longitudinal Stabilizing Device w/ Lateral Arms
Manufacturer: [Signature]

OTHER TIES

Sidewall _____
Longitudinal _____
Marriage Wall _____
Shear Wall _____



Mobile Home Permit Worksheet

POCKET PENETROMETER TEST

The pocket penetrometer tests are rounded down to _____ psf or check here to declare 1000 lb. soil without testing.

x 1000 x 1000 x 1000

POCKET PENETROMETER TESTING METHOD

1. Test the perimeter of the home at 6 locations.
2. Take the reading at the depth of the footer.
3. Using 500 lb. increments, take the lowest reading and round down to that increment.

x 1000 x 1000 x 1000

TORQUE PROBE TEST

The results of the torque probe test is 275 inch pounds or check here if you are declaring 5' anchors without testing _____. A test showing 275 inch pounds or less will require 5' anchors.

Note: A state approved lateral force system is being used and 4 ft. anchors are allowed at the sidewall locations. Understand 5' anchors are required at all centerline tie points where the torque test reading is 275 or less and where the mobile home manufacturer may require anchors with 4000 lb. holding capacity.

Installer's Initials

ALL TESTS MUST BE PERFORMED BY A LICENSED INSTALLER

Installer Name Ronald Ryan Davis

Date Tested 5-6-2026

ELECTRICAL

Connect electrical conductors between multi-wide units, but not to the main power source. This includes the bonding wire between multi-wide units. Pg. 15/c

PLUMBING

Connect all sewer drains to an existing sewer tap or septic tank. Pg. 15/c
Connect all potable water supply piping to an existing water meter, water tap, or other independent water supply systems. Pg. 15/c

Permit Number: _____

Date: _____

Site Preparation

Debris and organic material removed _____
Water drainage: Natural _____ Swale _____ Pad _____ Other _____

Fastening multi wide units

Floor- Type Fastener: N/A Length: N/A Spacing: N/A
Walls- Type Fastener: N/A Length: N/A Spacing: N/A
Roof- Type Fastener: N/A Length: N/A Spacing: N/A

For used homes a min. 30 gauge, 8" wide, galvanized metal strip will be centered over the peak of the roof and fastened with galv. roofing nails at 2" on center on both sides of the centerline.

Gasket (weatherproofing requirement)

I understand a properly installed gasket is a requirement of all new and used homes and that condensation, mold, mildew and buckled marriage walls are a result of a poorly installed or no gasket being installed. I understand a strip of tape will not serve as a gasket.

Installer's initials _____

Type gasket _____ Installed: N/A

Pg. _____ Between Floors _____ Yes _____

Between Walls _____ Yes _____

Bottom of ridge beam _____ Yes _____

Weatherproofing

The bottom board will be repaired and/or taped. _____ Yes 15/c

Siding on units is installed to manufacturer's specifications. _____ Yes _____

Fireplace chimney installed so as not to allow intrusion of rain water. _____ Yes 15/c

Miscellaneous

Skirting to be installed. _____ Yes _____ No N/A

Dryer vent installed outside of skirting. _____ Yes _____ No N/A

Range downflow vent installed outside of skirting. _____ Yes 15/c _____ No N/A

Drain lines supported at 4' intervals. _____ Yes _____ No N/A

Electrical crossovers protected. _____ Yes _____ No N/A

Other _____

Installer verifies all information given with this permit worksheet is accurate and true based on the manufacturer's installation instructions and or Rule 15C-1 & 2

Installer's Signature _____

Date 5-6-2026