



Mobile Home Permit Worksheet



8/3-695-7078

Installer: DANIEL HALL License # 1H/1144605
 Address of home being installed: 1744 SW DARY St.
Lake City, FL 32055
 Manufacturer: Distim Length x width: 46' x 32'


Permit Number: _____ Date: _____
 New Home Used Home
 Home installed to the Manufacturer's Installation Manual
 Home is installed in accordance with Rule 15-C
 Single wide Wind Zone II Wind Zone III
 Double wide Installation Decal # 119969
 Triple/Quad Serial # CAV290GA 25-14894AB

NOTE: If home is a single wide fill out one half of the blocking plan
 If home is a triple or quad wide sketch in remainder of home
 I understand Lateral Arm Systems cannot be used on any home (new or used)
 where the sidewall ties exceed 5 ft 4 in.

Installer's initials DAH

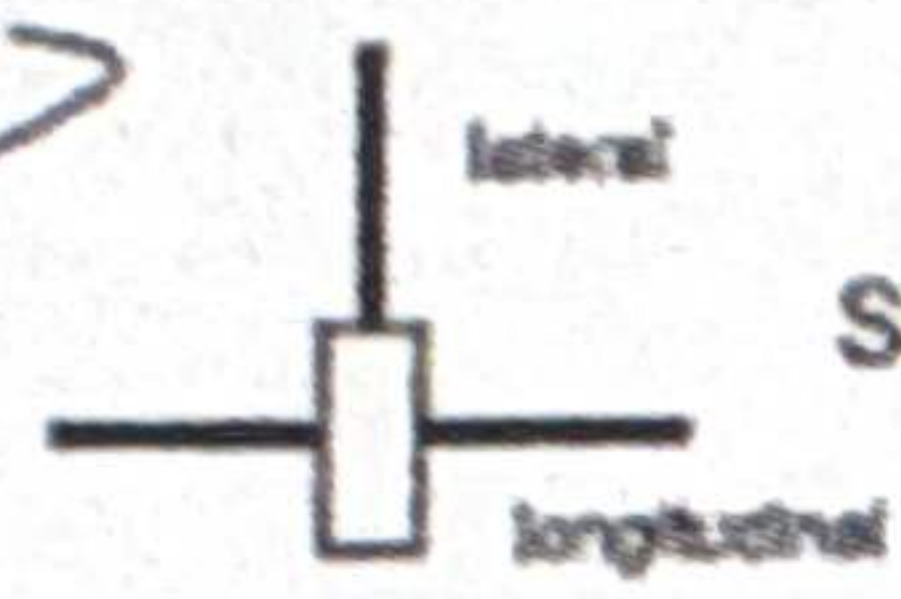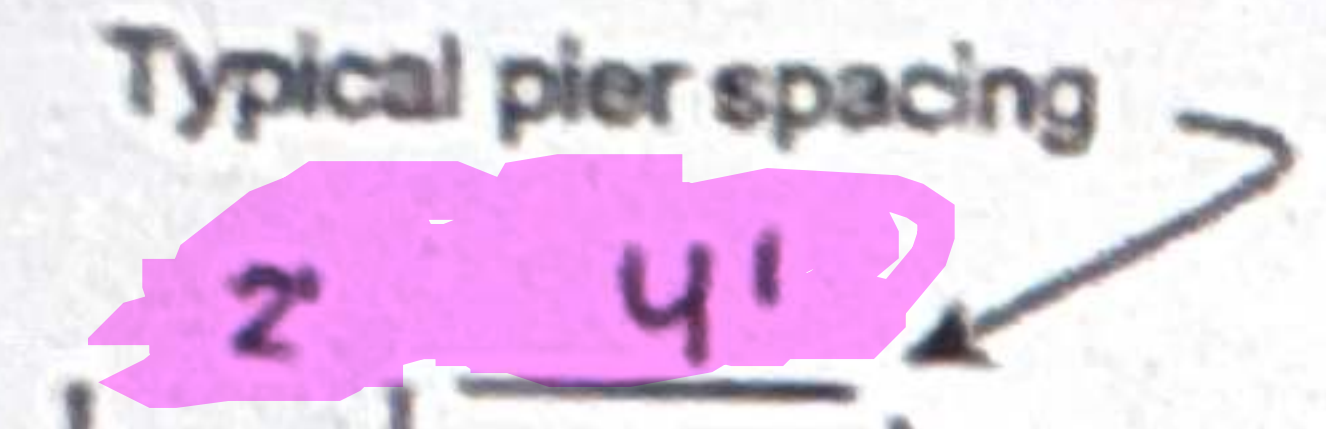

Show locations of Longitudinal and Lateral Systems
 (use dark lines to show these locations)

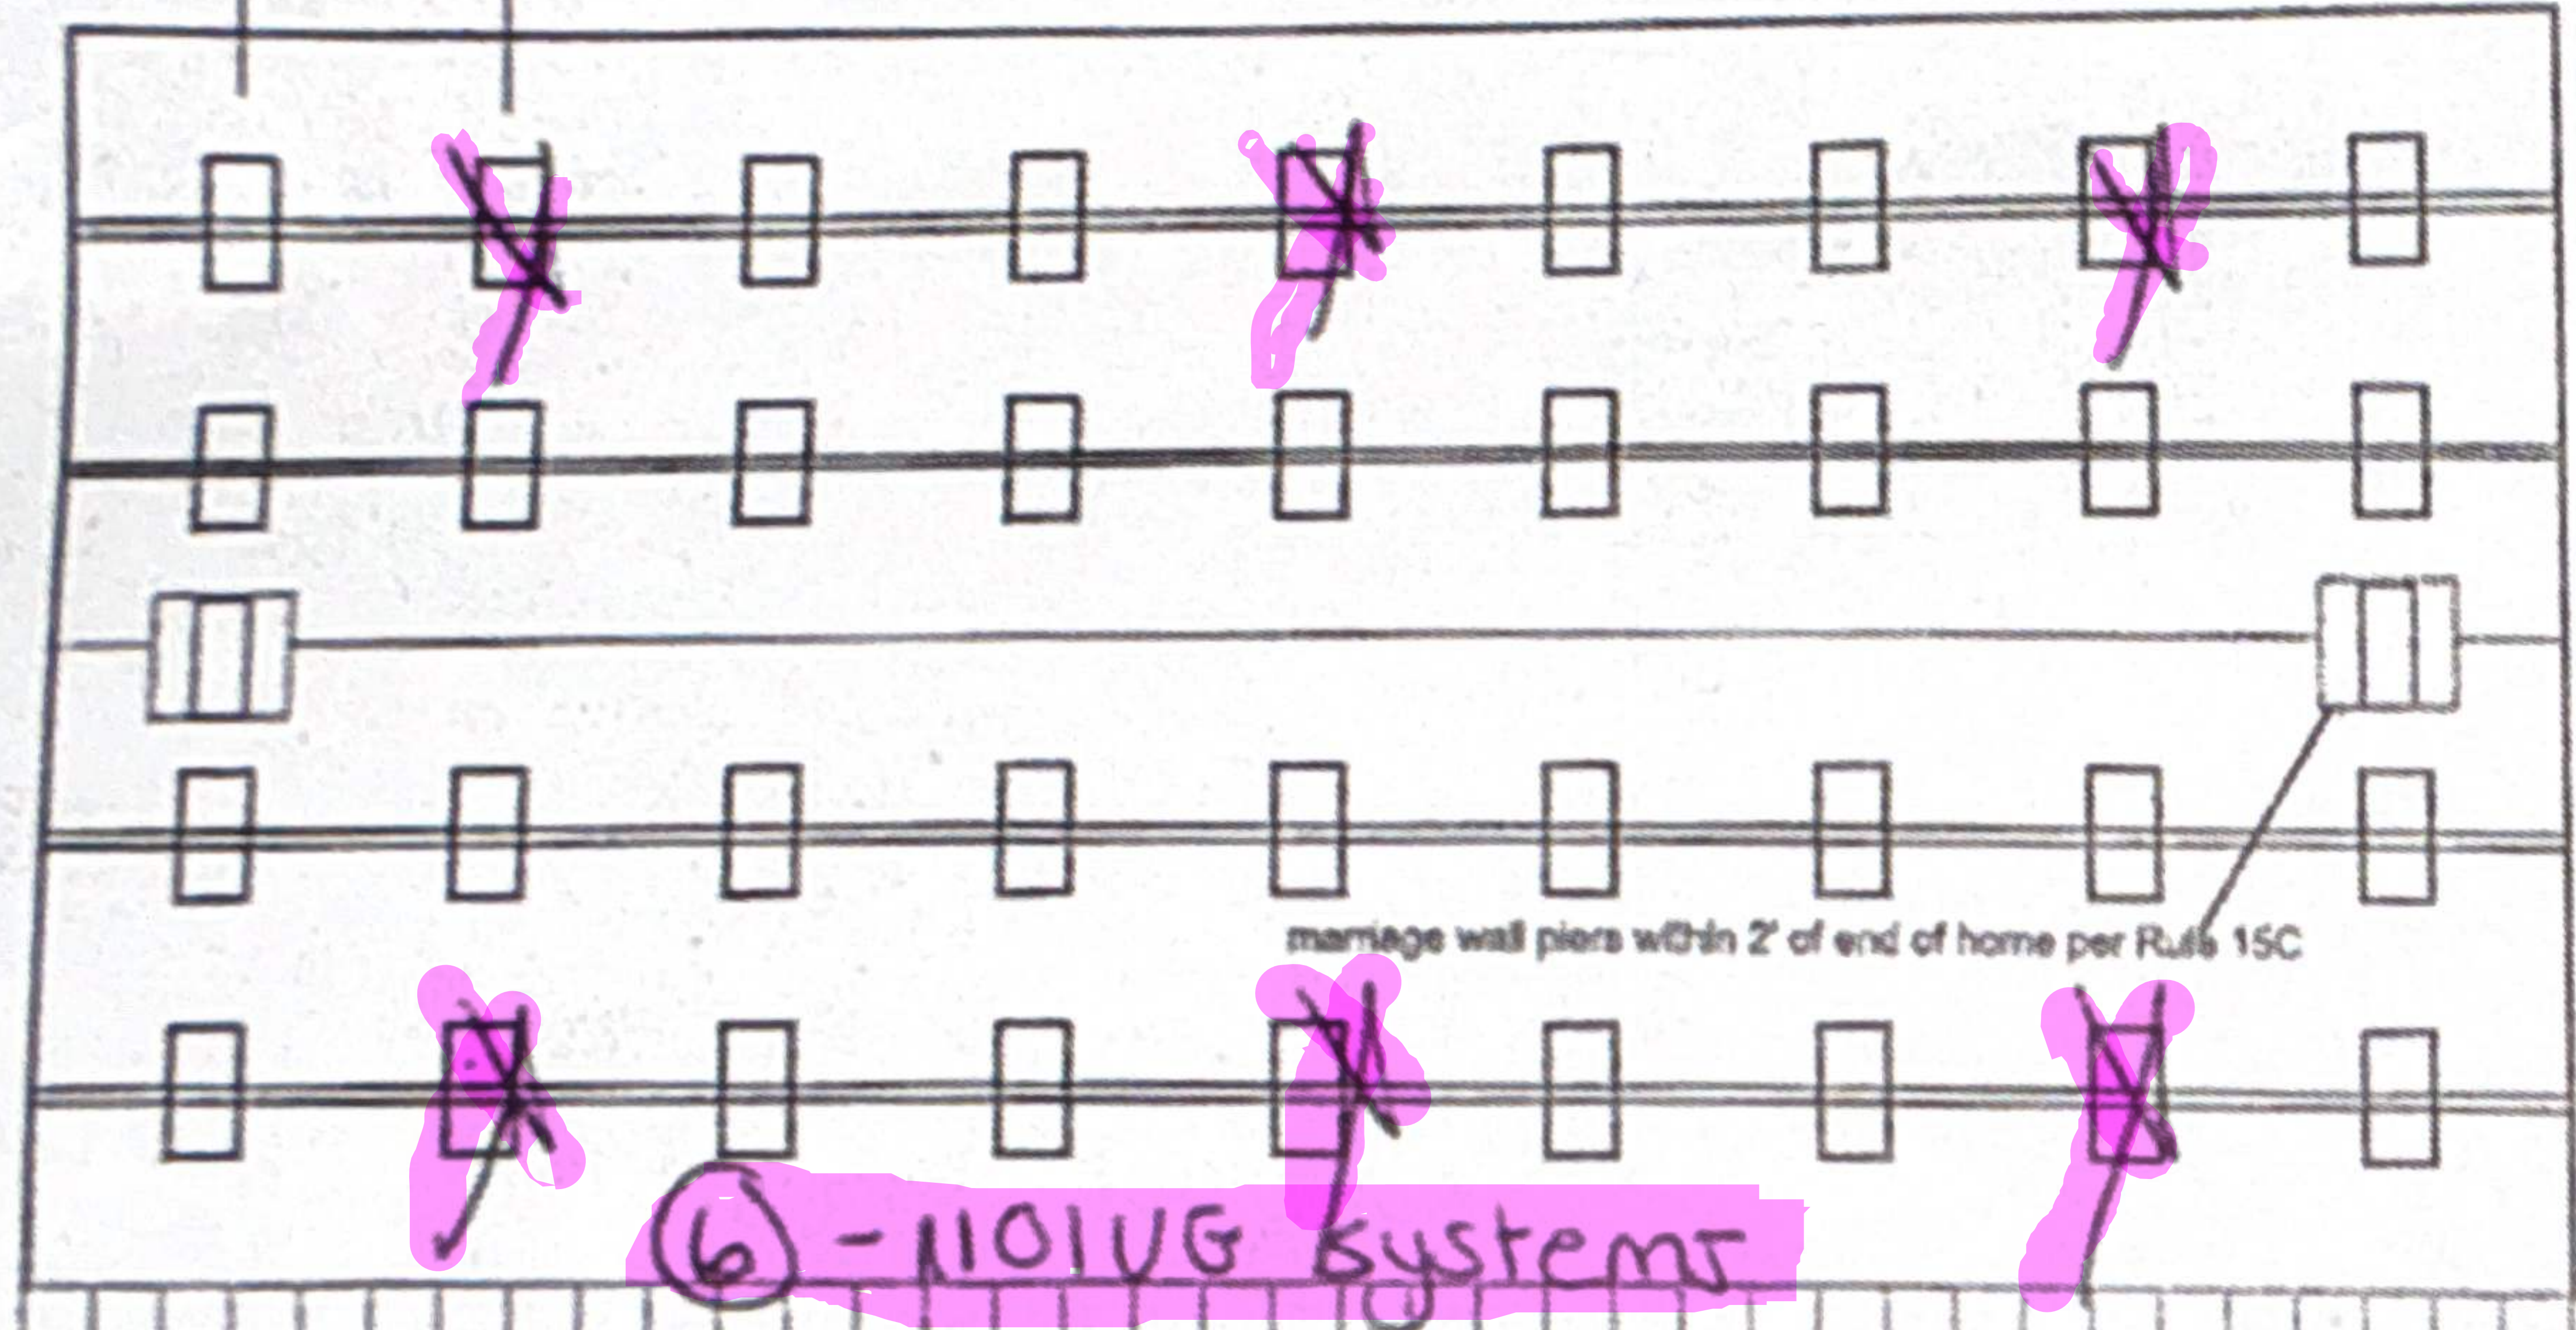

PIER SPACING TABLE FOR USED HOMES

Load bearing capacity	Footer size (sq in)	16" x 16" (256)	18 1/2" x 18 1/2" (342)	20" x 20" (400)	22" x 22" (484)*	24" x 24" (576)*	26" x 26" (676)
1000 psf		3'	4'	5'	6'	7'	8'
1500 psf		4'6"	6'	7'	8'	8'	8'
2000 psf		6'	8'	8'	8'	8'	8'
2500 psf		7'6"	8'	8'	8'	8'	8'
3000 psf		8'	8'	8'	8'	8'	8'
3500 psf		8'	8'	8'	8'	8'	8'

*interpolated from Rule 15C-1 pier spacing table.

PIER PAD SIZES

I-beam pier pad size 17-5 x 22-5
 Perimeter pier pad size 16 x 16
 Other pier pad sizes (required by the mfg.) 24 x 24

Draw the approximate locations of marriage wall openings 4 foot or greater. Use this symbol to show the piers.

List all marriage wall openings greater than 4 foot and their pier pad sizes below.

Opening	Pier pad size
<u>4 ft</u>	<u>24 x 24</u>
<u>12 ft</u>	<u>24 x 24</u>

POPULAR PAD SIZES

Pad Size	Sq In
16 x 16	256
16 x 18	288
18.5 x 18.5	342
16 x 22.5	360
17 x 22	374
13 1/2 x 26 1/2	348
20 x 20	400
17 3/16 x 25 3/16	441
17 1/2 x 25 1/2	446
24 x 24	576
26 x 26	676

4 ft 30 5 ft 5

ANCHORS

FRAME TIES

within 2' of end of home spaced at 5' 4" oc N/A

OTHER TIES

	Number
Sidewall	<u>30</u>
Longitudinal	<u>-</u>
Marriage Wall	<u>5</u>
Shear Wall	<u>-</u>

TIEDOWN COMPONENTS

Longitudinal Stabilizing Device (LSD)
 Manufacturer: OLIVER TECH
 Longitudinal Stabilizing Device w/ Lateral Arms
 Manufacturer: OLIVER TECH



PERMIT NUMBER

POCKET PENETROMETER TEST

The pocket penetrometer tests are rounded down to _____ psf or check here to declare 1000 lb soil without testing.

X _____ X _____ X _____

POCKET PENETROMETER TESTING METHOD

1. Test the perimeter of the home at 6 locations.
2. Take the reading at the depth of the footer.
3. Using 500 lb. increments, take the lowest reading and round down to that increment.

X _____ X _____ X _____

TORQUE PROBE TEST

The results of the torque probe test is 350 inch pounds or check here if you are declaring 5' anchors without testing _____. A test showing 275 inch pounds or less will require 5 foot anchors.

Note: A state approved lateral arm system is being used and 4 ft. anchors are allowed at the sidewall locations. I understand 5 ft anchors are required at all centerline tie points where the torque test reading is 275 or less and where the mobile home manufacturer may require anchors with 4000 lb holding capacity.

DAH Installer's Initials

ALL TESTS MUST BE PERFORMED BY A LICENSED INSTALLER

Installer Name DANIEL HALL

Date Tested 11-10-25

Electrical

Connect electrical conductors between multi-wide units, but not to the main power source. This includes the bonding wire between multi-wide units. Pg. 69

Plumbing

Connect all sewer drains to an existing sewer tap or septic tank. Pg. 69

Connect all potable water supply piping to an existing water meter, water tap, or other independent water supply systems. Pg. 69

Site Preparation

Debris and organic material removed yes
 Water drainage: Natural Swale yes Pad Other _____

Fastening multi wide units

Floor: Type Fastener: LAGS Length: 3/8 x 6 Spacing: 4'00
 Walls: Type Fastener: LAGS Length: 3/8 x 6 Spacing: 4'00
 Roof: Type Fastener: SCREWS Length: #10 Spacing: 4'00
 For used homes a min. 30 gauge, 8" wide, galvanized metal strip will be centered over the peak of the roof and fastened with galv. roofing nails at 2" on center on both sides of the centerline.

Gasket weatherstripping requirement

I understand a properly installed gasket is a requirement of all new and used homes and that condensation, mold, mildew and buckled marriage walls are a result of a poorly installed or no gasket being installed. I understand a strip of tape will not serve as a gasket.

Installer's initials DAH

Type gasket Foam
 Pg. 93

Installed:
 Between Floors Yes
 Between Walls Yes
 Bottom of ridgebeam Yes

Weatherproofing

The bottomboard will be repaired and/or taped. Yes Pg. 112
 Siding on units is installed to manufacturer's specifications. Yes
 Fireplace chimney installed so as not to allow intrusion of rain water. Yes

Miscellaneous

Skirting to be installed. Yes No _____
 Dryer vent installed outside of skirting. Yes N/A _____
 Range downflow vent installed outside of skirting. Yes N/A
 Drain lines supported at 4 foot intervals. Yes
 Electrical crossovers protected. Yes
 Other: _____

Installer verifies all information given with this permit worksheet is accurate and true based on the manufacturer's installation instructions and or Rule 15C-1 & 2

Installer Signature Daniel Hall Date 11-10-25

Number: IH / 1144605 / 1 Name: DANIEL A HALL

6599	Label #: 119969	Manufacturer: CAUCO	(Check Size of Home)
mc:	LYNN <u>AMBUEN</u>	Year Model: 2025	Single _____
	1744 SW DAIRY ST	Length & Width: 32x66	Double <input checked="" type="checkbox"/> _____
ic/Zip:	LAKE CITY FL 32055	Type Longitudinal System: OLIVER TECH	Triple _____
	(813) 695-7078	Type Lateral Arm System: OLIVER TECH	HUD Label #:
alled:		New Home: <input checked="" type="checkbox"/> Used Home: _____	Soil Bearing / PSF:
Wind Zone: II		Data Plate Wind Zone: II	Torque Probe / in-lbs:
			Permit #:

SERIAL # CAU2906A25-1'



STATE OF FLORIDA
INSTALLATION CERTIFICATION LABEL

119969	
LABEL #	DATE OF INSTALLATION
DANIEL A HALL	
NAME	
IH / 1144605 / 1	6599
LICENSE #	ORDER #

CERTIFIES THAT THE INSTALLATION OF THIS MOBILE HOME IS IN ACCORDANCE WITH FLORIDA STATUTES 320.8249, 320.8325 AND RULES OF THE HIGHWAY SAFETY AND MOTOR VEHICLES.

INSTRUCTIONS

PLEASE WRITE DATE OF INSTALLATION AND AFFIX LABEL NEXT TO HUD LABEL. USE PERMANENT INK PEN OR MARKER ONLY. COMPLETE INFORMATION ABOVE AND KEEP ON FILE FOR A MINIMUM OF 2 YEARS YOU ARE REQUIRED TO PROVIDE COPIES WHEN REQUESTED.