

COLUMBIA COUNTY PERMIT WORKSHEET

These worksheets must be completed and signed by the installer. Submit the originals with the packet.


Installer Fernon Jones License # TH1025418

911 Address where home is being installed X 481 SW grapevine ct Ft. white TX 76038

Manufacturer X Conner Length x width X 14 x 70

NOTE: if home is a single wide fill out one half of the blocking plan if home is a triple or quad wide sketch in remainder of home

I understand Lateral Arm Systems cannot be used on any home (new or used) where the sidewall ties exceed 5 ft 4 in
Installer's initials F.J.

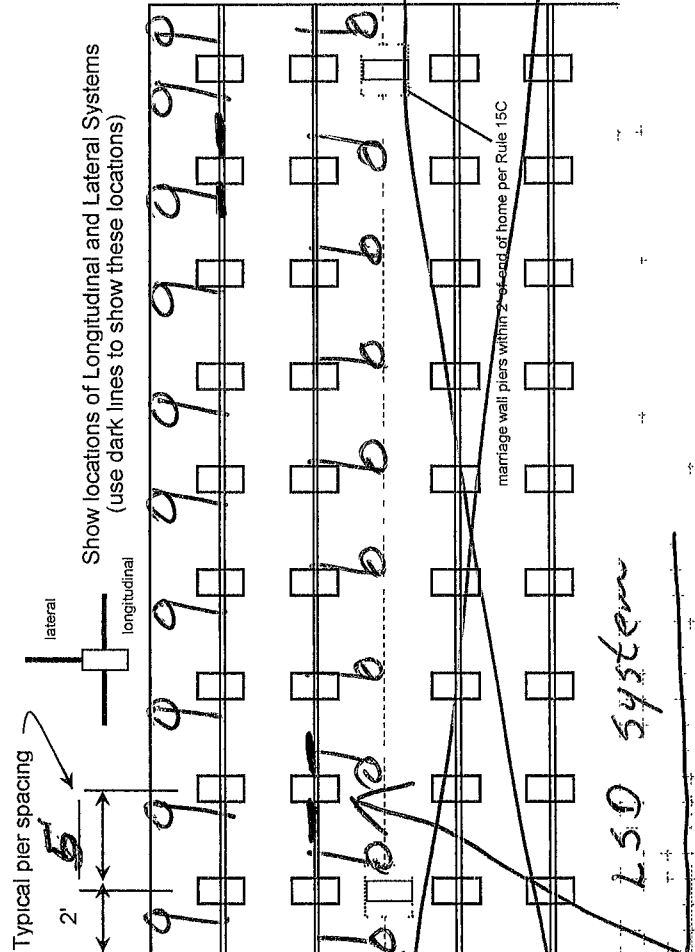

New Home Used Home

Home installed to the Manufacturer's Installation Manual

Home is installed in accordance with Rule 15-C

Single wide Wind Zone II Wind Zone III

Double wide Installation Decal # 20379

Triple/Quad Serial # CHCEGA6819700850

PIER SPACING TABLE FOR USED HOMES

Load bearing capacity	Footer size (sq in)	16" x 16" (256)	18 1/2" x 18 1/2" (342)	20" x 20" (400)	22" x 22" (484)*	24" x 24" (576)*	26" x 26" (676)
1000 bsf	3'		4'	5'	6'	7'	8'
1500 bsf	4.6"		6'	7'	8'	8'	8'
2000 bsf	6"		8'	8'	8'	8'	8'
2500 bsf	7.6"		8'	8'	8'	8'	8'
3000 bsf	8'		8'	8'	8'	8'	8'
3500 bsf	8'		8'	8'	8'	8'	8'

* interpolated from Rule 15C-1 pier spacing table

PIER PAD SIZES

I-beam pier pad size 20x20

Perimeter pier pad size 16x16 Decors

Other pier pad sizes (required by the mfg) ---

POPULAR PAD SIZES

Pad Size	Sq In
16 x 16	256
16 x 18	288
18.5 x 18.5	342
16 x 22.5	360
17 x 22	374
13 1/4 x 26 1/4	348
20 x 20	400
17 3/16 x 25 3/16	441
17 1/2 x 25 1/2	446
24 x 24	576
26 x 26	676

Draw the approximate locations of marriage wall openings 4 foot or greater Use this symbol to show the piers

List all marriage wall openings greater than 4 foot and their pier pad sizes below

Opening --- Pier pad size ---

ANCHORS

FRAME TIES

OTHER TIES

TIEDOWN COMPONENTS

Longitudinal Stabilizing Device (LSD)
Manufacturer Oliver Tech

Longitudinal Stabilizing Device w/ Lateral Arms
Manufacturer ---

Sidewall Longitudinal Marriage wall Shearwall

Number 2

within 2' of end of home spaced at 5' 4" oc

POCKET PENETROMETER TEST

The pocket penetrometer tests are rounded down to _____ psf or check here to declare 1000 lb soil _____ without testing

x 1500 x 1000 x 1000

POCKET PENETROMETER TESTING METHOD

- 1 Test the perimeter of the home at 6 locations
- 2 Take the reading at the depth of the footer
- 3 Using 500 lb increments, take the lowest reading and round down to that increment

x 1000 x 1500 x 1000

TORQUE PROBE TEST

The results of the torque probe test is 285 inch pounds or check here if you are declaring 5' anchors without testing _____ A test showing 275 inch pounds or less will require 5 foot anchors

Note: A state approved lateral arm system is being used and 4 ft. anchors are allowed at the sidewall locations I understand 5 ft anchors are required at all centerline tie points where the torque test reading is 275 or less and where the mobile home manufacturer may require anchors with 4000 lb holding capacity

F.D. Installer's initials

ALL TESTS MUST BE PERFORMED BY A LICENSED INSTALLER

Installer Name Fernon Jones

Date Tested 9-26-14

Electrical

Connect electrical conductors between multi-wide units, but not to the main power source This includes the bonding wire between multi-wide units Pg 15

Plumbing

Connect all sewer drains to an existing sewer tap or septic tank. Pg 15

Connect all potable water supply piping to an existing water meter, water tap, or other independent water supply systems Pg 15

Site Preparation

Debris and organic material removed _____
 Water drainage Natural Swale _____ Pad _____ Other _____

Fastening multi wide units

Floor Type Fastener self Length _____ Spacing _____
 Walls Type Fastener _____ Length _____ Spacing _____
 Roof Type Fastener _____ Length _____ Spacing _____
 For used homes a min 30 gauge, 8" wide, galvanized metal strip will be centered over the peak of the roof and fastened with galv roofing nails at 2" on center on both sides of the centerline

Gasket (weatherproofing requirement)

I understand a properly installed gasket is a requirement of all new and used homes and that condensation, mold, mildew and buckled marriage walls are a result of a poorly installed or no gasket being installed I understand a strip of tape will not serve as a gasket.

Installer's initials F.D.

Type gasket _____ Installed _____
 Pg _____ Between Floors Yes _____
 Between Walls Yes _____
 Bottom of ridgebeam Yes _____

Weatherproofing

The bottomboard will be repaired and/or taped Yes _____ Pg _____
 Siding on units is installed to manufacturer's specifications Yes _____
 Fireplace chimney installed so as not to allow intrusion of rain water Yes _____

Miscellaneous

Skirting to be installed Yes No _____
 Dryer vent installed outside of skirting Yes N/A _____
 Range downflow vent installed outside of skirting Yes _____ N/A _____
 Drain lines supported at 4 foot intervals Yes No _____
 Electrical crossovers protected Yes _____
 Other _____

Installer verifies all information given with this permit worksheet is accurate and true based on the

Installer Signature Fernon Jones Date 9/25/14