





Mobile Home Permit Worksheet

Installer: William Price License # IH-1641936
 Address of home being installed: 713D SW Luke Greet Ct
Lake City FL 32024
 Manufacturer: Legacy Length x width: 24'x68'

NOTE: If home is a single wide fill out one half of the blocking plan
 If home is a triple or quad wide sketch in remainder of home
 I understand Lateral Arm Systems cannot be used on any home (new or used)
 where the sidewall ties exceed 5 ft 4 in.

Installer's initials: WMP

Typical pier spacing

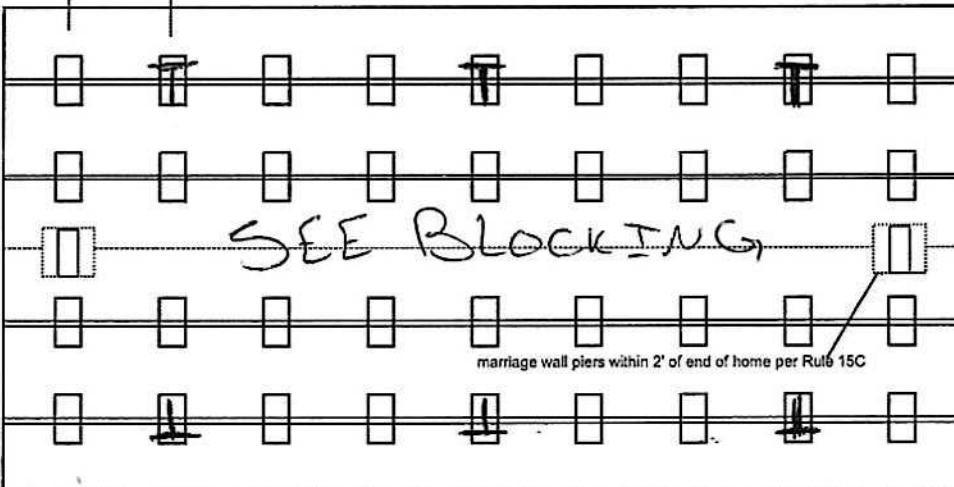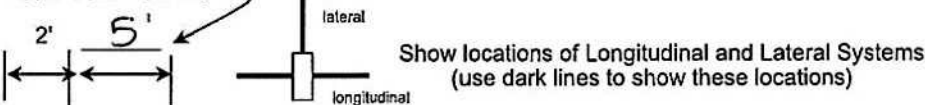

6711 CLV
Oliver System

Permit Number: _____ Date: _____

New Home ☒ Used Home ☐

Home installed to the Manufacturer's Installation Manual ☒
 Home is installed in accordance with Rule 15-C ☐

Single wide ☐ Wind Zone II ☒ Wind Zone III ☐

Double wide ☒ Installation Decal # 116406

Triple/Quad ☐ Serial # L36978AB

PIER SPACING TABLE FOR USED HOMES

Load bearing capacity	Footer size (sq in)	16" x 16" (256)	18 1/2" x 18 1/2" (342)	20" x 20" (400)	22" x 22" (484)*	24" X 24" (576)*	26" x 26" (676)
1000 psf		3'	4'	5'	6'	7'	8'
1500 psf		4'6"	6'	7'	8'	8'	8'
2000 psf		6'	8'	8'	8'	8'	8'
2500 psf		7'6"	8'	8'	8'	8'	8'
3000 psf		8'	8'	8'	8'	8'	8'
3500 psf		8'	8'	8'	8'	8'	8'

*interpolated from Rule 15C-1 pier spacing table.

PIER PAD SIZES

I-beam pier pad size 17x25

Perimeter pier pad size 16x16

Other pier pad sizes (required by the mfg.) _____

Draw the approximate locations of marriage wall openings 4 foot or greater. Use this symbol to show the piers.

List all marriage wall openings greater than 4 foot and their pier pad sizes below.

Opening	Pier pad size
<u>Large</u>	<u>23x31</u>

POPULAR PAD SIZES

Pad Size	Sq In
16 x 16	256
16 x 18	288
18.5 x 18.5	342
16 x 22.5	360
17 x 22	374
13 1/2 x 26 1/2	348
20 x 20	400
17 3/16 x 25 3/16	441
17 1/2 x 25 1/2	446
24 x 24	576
26 x 26	676

4 ft W 5 ft _____

ANCHORS

FRAME TIES

within 2' of end of home spaced at 5' 4" oc ☒

OTHER TIES

	Number
Sidewall	<u>1</u>
Longitudinal	<u>1</u>
Marriage Wall	<u>1</u>
Shear Wall	<u>1</u>


TIEDOWN COMPONENTS

Longitudinal Stabilizing Device (LSD)

Manufacturer: _____

Longitudinal Stabilizing Device w/ lateral arms

Manufacturer: Oliver Tech

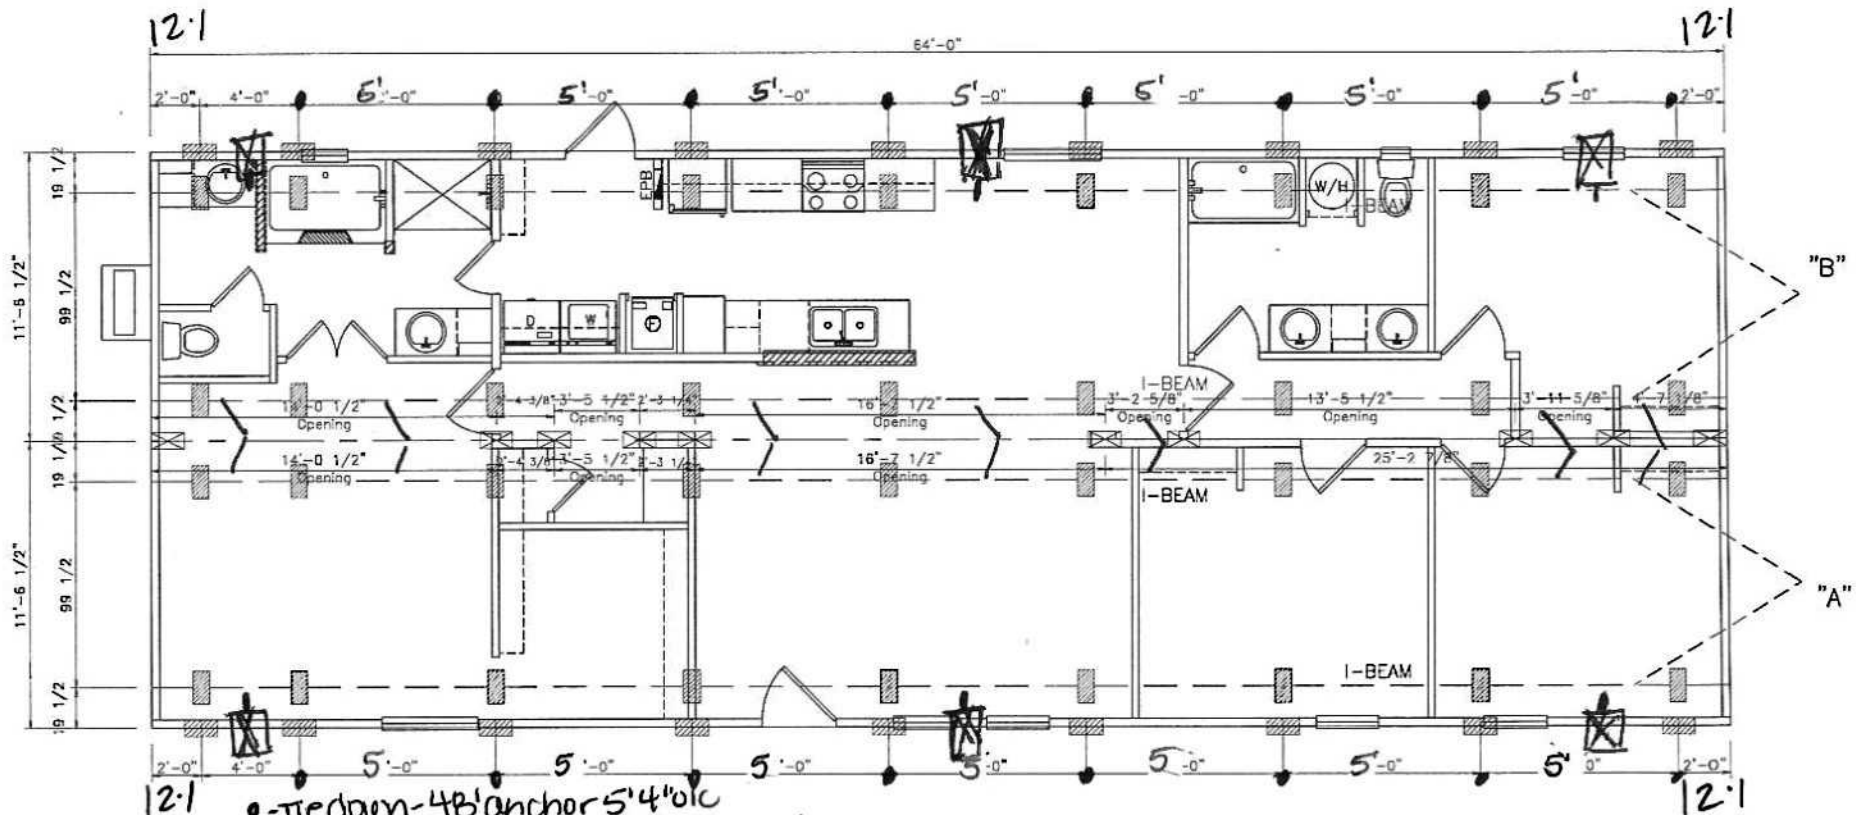

12'-1
 11'-5 1/2"
 19 1/2
 99 1/2
 19 1/2
 11'-5 1/2"
 19 1/2
 12'-1

• Tie down - 48' anchor 5'4" o/c
 = SUPPORT PIER - 17x25 abs w/ 8x8x14 5' o/c
 = MARRIAGE LINE OPENING SUPPORT PIER -
 17x25 abs or 23x31 abs or 17x25 abs
 triple stacked
 [X] - Oliver System
 } - Double Frame tie - 48' anchor
 5' from end then 12' o/c
 * All perimeter doors 14x16 * All centerline / sheetrock anchors 60'

- FOUNDATION NOTES:
1. PIER LOCATIONS INDICATED ARE FOR REFERENCE ONLY. REFER TO INSTALLATION MANUAL FOR ADDITIONAL REQUIRED LOCATIONS SUCH AS FOR OPTIONAL ITEMS LIKE FIREPLACES OR ALTERNATIVE PIER SPACINGS AND ROOF LOADS.
 2. SINGLE STACKED PIERS LESS THAN 36" HIGH.
 3. DOUBLE STACKED PIERS 36" TO 67" HIGH.
 4. UTILITY LOCATIONS ARE "GENERAL" AND IF AN EXACT DIMENSION IS REQUIRED PLEASE VERIFY WITH SPECIFIC HOME SERIAL NUMBER.

Legacy Housing

DATE: 02/01/2018
 SCALE: NTS
 MODEL: 2468-42A
 DRAWN BY: JMS

TITLE: FOUNDATION PLAN
 (ALTERNATE WINDOWS)

DWG #:



Mobile Home Permit Worksheet

POCKET PENETROMETER TEST

The pocket penetrometer tests are rounded down to _____ psf or check here to declare 1000 lb. soil XV without testing.

x 1000 x 1000 x 1000

POCKET PENETROMETER TESTING METHOD

1. Test the perimeter of the home at 6 locations.
2. Take the reading at the depth of the footer.
3. Using 500 lb. increments, take the lowest reading and round down to that increment.

x 1000 x 1000 x 1000

TORQUE PROBE TEST

The results of the torque probe test is 1774 inch pounds or check here if you are declaring 5' anchors without testing 1774. A test showing 275 inch pounds or less will require 5' anchors.

Note: A state approved lateral arm system is being used and 4 ft. anchors are allowed at the sidewall locations. I understand 5' anchors are required at all centerline tie points where the torque test reading is 275 or less and where the mobile home manufacturer may require anchors with 4000 lb. holding capacity.

Installer's initials _____

ALL TESTS MUST BE PERFORMED BY A LICENSED INSTALLER

Installer Name _____

Date Tested _____

ELECTRICAL

Connect electrical conductors between multi-wide units, but not to the main power source. This includes the bonding wire between multi-wide units. Pg. ✓

PLUMBING

Connect all sewer drains to an existing sewer tap or septic tank. Pg. ✓

Connect all potable water supply piping to an existing water meter, water tap, or other independent water supply systems. Pg. ✓

Permit Number: _____

Date: _____

Site Preparation

Debris and organic material removed 40% Yes
Water drainage: Natural _____ Swale _____ Pad X Other _____

Fastening multi wide units

Floor- Type Fastener: 2x55 Length: _____ Spacing: 18"
Walls- Type Fastener: Screws Length: _____ Spacing: 18"
Roof- Type Fastener: metal Length: _____ Spacing: 18"

For used homes a min. 30 gauge, 8" wide, galvanized metal strip will be centered over the peak of the roof and fastened with galv. roofing nails at 2" on center on both sides of the centerline.

Gasket (weatherproofing requirement)

I understand a properly installed gasket is a requirement of all new and used homes and that condensation, mold, mildew and buckled marriage walls are a result of a poorly installed or no gasket being installed. I understand a strip of tape will not serve as a gasket.

Installer's initials WJA

Type gasket: foam
Pg. 5a 2.4.6

Installed:
Between Floors-----Yes ✓
Between Walls-----Yes ✓
Bottom of ridge beam-----Yes ✓

Weatherproofing

The bottom board will be repaired and/or taped.-----Yes ✓ Pg. _____
Siding on units is installed to manufacturer's specifications.-----Yes ✓
Fireplace chimney installed so as not to allow intrusion of rain water.-----Yes ✓

Miscellaneous

Skirting to be installed.-----Yes ✓ No _____ N/A _____
Dryer vent installed outside of skirting.-----Yes ✓ No _____ N/A _____
Range downflow vent installed outside of skirting.-----Yes ✓ No _____ N/A _____
Drain lines supported at 4' intervals.-----Yes ✓ No _____ N/A _____
Electrical crossovers protected.-----Yes ✓ No _____ N/A _____
Other: _____

Installer verifies all information given with this permit worksheet is accurate and true based on the manufacturer's installation instructions and or Rule 15C-1 & 2


Installer's Signature _____

Date 6/24/26

Kelly Guerra

Parcel # 19-45-16-03063-011

TBD SW Lukeget Ct Lake City FL 33024

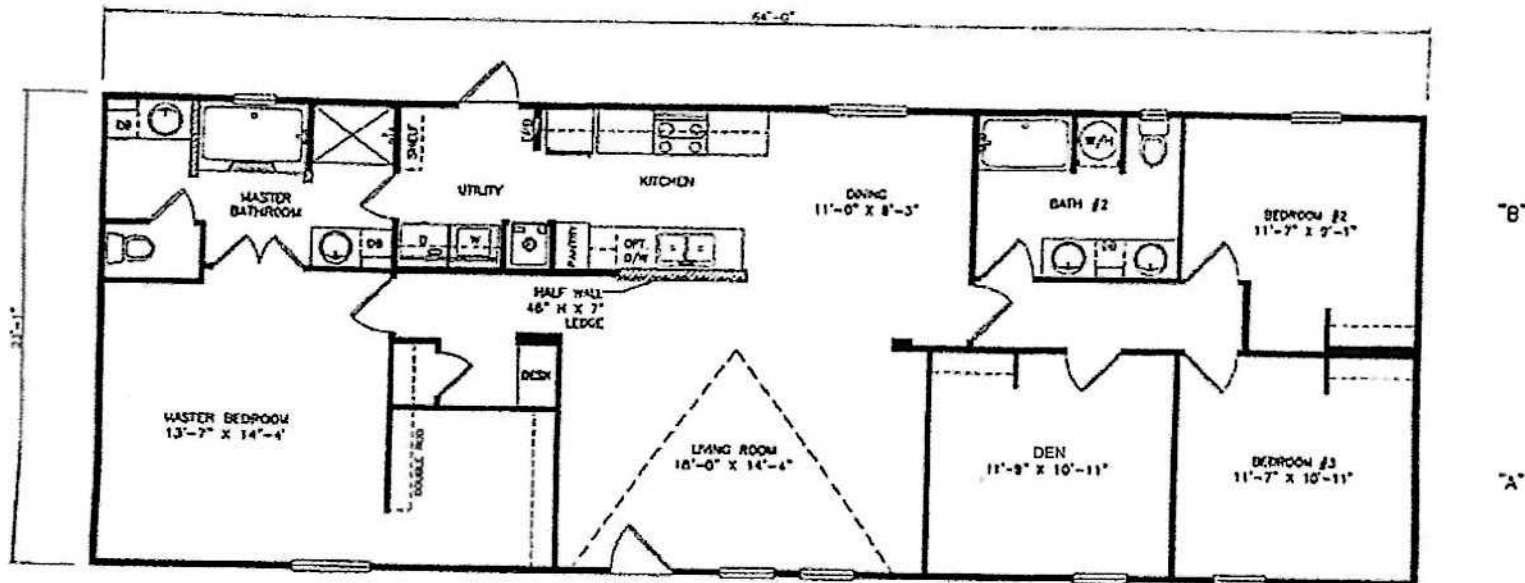

S-2468-42A

BOX SIZE= 23'-1" x 64'-0"

3 BEDROOM / 2 BATH W/ DEN (1483 SQ. FT.)

Legacy Housing

DATE 02/01/2018
SCALE NTS
DRAWN BY JVS

SALES LITERATURE (ALTERNATE WINDOWS)

OP

Key & Alex Guerra

The 301e19h
24x68'

perm HS
Columbia

License Number: IH / 1041936 / 1 Name: WILLIAM R PRICE

Order #: 6454

Label #: 116406

Manufacturer:

Homeowner:

Year Model:

Address:

Length & Width:

City/State/Zip:

Type Longitudinal System:

Phone #:

Type Lateral Arm System:

Date Installed:

New Home: _____ Used Home: _____

Installed Wind Zone:

Data Plate Wind Zone:

Note:

(Check Size of Home)

Single _____

Double _____

Triple _____

HUD Label #:

Soil Bearing / PSF:

Torque Probe / in-lbs:

Permit #:

STATE OF FLORIDA
INSTALLATION CERTIFICATION LABEL

116406

LABEL #

DATE OF INSTALLATION

WILLIAM R PRICE

NAME

IH / 1041936 / 1

6454

LICENSE #

ORDER #

CERTIFIES THAT THE INSTALLATION OF THIS MOBILE HOME IS
IN ACCORDANCE WITH FLORIDA STATUTES 320.8249, 320.8325
AND RULES OF THE HIGHWAY SAFETY AND MOTOR VEHICLES.

INSTRUCTIONS

PLEASE WRITE DATE OF
INSTALLATION AND AFFIX
LABEL NEXT TO HUD LABEL.
USE PERMANENT INK PEN
OR MARKER ONLY.
COMPLETE INFORMATION
ABOVE AND KEEP ON FILE
FOR A MINIMUM OF 2 YEARS.
YOU ARE REQUIRED TO
PROVIDE COPIES WHEN
REQUESTED.