



Mobile Home Permit Worksheet

Installer: Christopher Olin License # 1H/1025395

Address of home being installed 631 SE CROFT ST
Lulu Fl 32061



Manufacturer Live oak Length x width 32x76

NOTE: If home is a single wide fill out one half of the blocking plan
If home is a triple or quad wide sketch in remainder of home

I understand Lateral Arm Systems cannot be used on any home (new or used) where the sidewall ties exceed 5 ft 4 in.

Installer's initials _____

Typical pier spacing

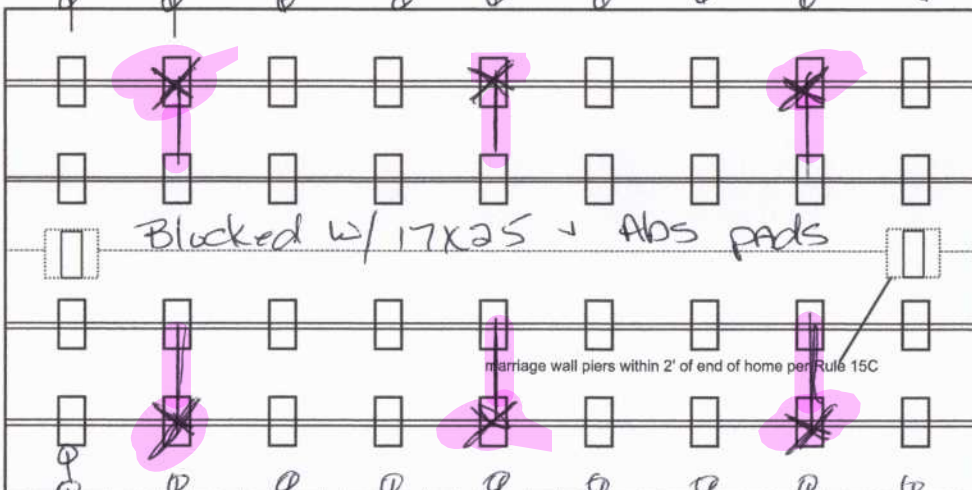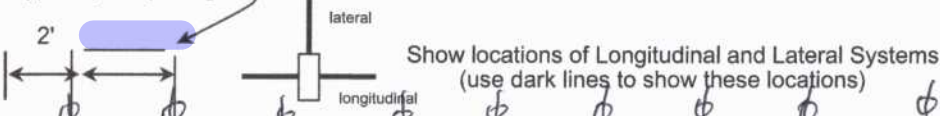

Oliver Technologies

Permit Number: _____ Date: _____

New Home ☒ Used Home ☐

Home installed to the Manufacturer's Installation Manual ☐
Home is installed in accordance with Rule 15-C ☐

Single wide ☐ Wind Zone II ☒ Wind Zone III ☐

Double wide ☒ Installation Decal # 126225

Triple/Quad ☐ Serial # LDHGA30076460 A+B

PIER SPACING TABLE FOR USED HOMES

Load bearing capacity	Footer size (sq in)	16" x 16" (256)	18 1/2" x 18 1/2" (342)	20" x 20" (400)	22" x 22" (484)*	24" X 24" (576)*	26" x 26" (676)
1000 psf		3'	4'	5'	6'	7'	8'
1500 psf		4'6"	6'	7'	8'	8'	8'
2000 psf		6'	8'	8'	8'	8'	8'
2500 psf		7'6"	8'	8'	8'	8'	8'
3000 psf		8'	8'	8'	8'	8'	8'
3500 psf		8'	8'	8'	8'	8'	8'

*interpolated from Rule 15C-1 pier spacing table.

PIER PAD SIZES

I-beam pier pad size 17x25

Perimeter pier pad size 16x16

Other pier pad sizes (required by the mfg.) 17x25x3

Draw the approximate locations of marriage wall openings 4 foot or greater. Use this symbol to show the piers.

List all marriage wall openings greater than 4 foot and their pier pad sizes below.

Opening	Pier pad size
<u>8'+</u>	<u>17x25x3</u>
<u>8'+</u>	<u>17x25</u>

POPULAR PAD SIZES

Pad Size	Sq In
16 x 16	256
16 x 18	288
18.5 x 18.5	342
16 x 22.5	360
17 x 22	374
13 1/4 x 26 1/4	348
20 x 20	400
17 3/16 x 25 3/16	441
17 1/2 x 25 1/2	446
24 x 24	576
26 x 26	676

4 ft ☒ 5 ft ☐

ANCHORS

FRAME TIES

within 2' of end of home ☒
spaced at 5' 4" oc ☒

TIEDOWN COMPONENTS

Longitudinal Stabilizing Device (LSD)

Manufacturer 1101 Oliver Technologies

Longitudinal Stabilizing Device w/ Lateral Arms

Manufacturer 1101 Oliver Technologies

OTHER TIES

	Number
Sidewall	<u>16</u>
Longitudinal	<u>N/A</u>
Marriage Wall	<u>6</u>
Shear Wall	<u>N/A</u>



Mobile Home Permit Worksheet

POCKET PENETROMETER TEST

The pocket penetrometer tests are rounded down to _____ psf or check here to declare 1000 lb. soil / without testing.

X 1000 PSF X / X /

POCKET PENETROMETER TESTING METHOD

1. Test the perimeter of the home at 6 locations.
2. Take the reading at the depth of the footer.
3. Using 500 lb. increments, take the lowest reading and round down to that increment.

X / X / X /

TORQUE PROBE TEST

The results of the torque probe test is ✓ inch pounds or check here if you are declaring 5' anchors without testing _____. A test showing 275 inch pounds or less will require 5' anchors.

Note: A state-approved lateral arm system is being used and 4 ft. anchors are allowed at the sidewall locations. I understand 5' anchors are required at all centerline tie points where the torque test reading is 275 or less and where the mobile home manufacturer may require anchors with 4000 lb. holding capacity.

Installer's initials CO

ALL TESTS MUST BE PERFORMED BY A LICENSED INSTALLER

Installer Name Christopher Olin

Date Tested 03-02-26

ELECTRICAL

Connect electrical conductors between multi-wide units, but not to the main power source. This includes the bonding wire between multi-wide units. Pg. 12-25

PLUMBING

Connect all sewer drains to an existing sewer tap or septic tank. Pg. 12-25

Connect all potable water supply piping to an existing water meter, water tap, or other independent water supply systems. Pg. 12-25

Permit Number: _____

Date: _____

Site Preparation

Debris and organic material removed 425

Water drainage: Natural _____ Swale / Pad _____ Other _____

Fastening multi wide units

Floor- Type Fastener: lag Length: 6" Spacing: 1' o/c
Walls- Type Fastener: screw Length: 4" Spacing: 2' o/c
Roof- Type Fastener: lag Length: 6" Spacing: 3' o/c

For used homes a min. 30 gauge, 8" wide, galvanized metal strip will be centered over the peak of the roof and fastened with galv. roofing nails at 2" on center on both sides of the centerline.

Gasket (weatherproofing requirement)

I understand a properly installed gasket is a requirement of all new and used homes and that condensation, mold, mildew and buckled marriage walls are a result of a poorly installed or no gasket being installed. I understand a strip of tape will not serve as a gasket.

Installer's initials CO

Type gasket Purom
Pg. 12-25

Installed:
Between Floors ----- Yes ✓
Between Walls ----- Yes ✓
Bottom of ridge beam ----- Yes ✓

Weatherproofing

The bottom board will be repaired and/or taped. ✓ Yes _____ Pg. 20-25
Siding on units is installed to manufacturer's specifications. ----- Yes ✓
Fireplace chimney installed so as not to allow intrusion of rain water. ----- Yes ✓

Miscellaneous

Skirting to be installed. ----- Yes ✓ No _____ N/A _____
Dryer vent installed outside of skirting. ----- Yes ✓ No _____ N/A _____
Range downflow vent installed outside of skirting. ----- Yes ✓ No _____ N/A _____
Drain lines supported at 4' intervals. ----- Yes ✓ No _____ N/A _____
Electrical crossovers protected. ----- Yes ✓ No _____ N/A _____
Other: _____

Installer verifies all information given with this permit worksheet is accurate and true based on the manufacturer's installation instructions and or Rule 15C-1 & 2

Installer's Signature Christopher Olin Date 3-02-26

License Number: IH / 1025395 / 1 Name: CHRISTOPHER C. OLIN			
Order #: 6877	Label #: 126225	Manufacturer: <i>Live oak</i>	(Check Size of Home)
Homeowner: <i>Elizabeth Sparkman</i>		Year Model:	Single _____
Address: <i>631 SE CROFT ST</i>		Length & Width:	Double _____
			Triple _____
City/State/Zip: <i>Lulu FL 32061</i>		Type Longitudinal System:	HUD Label #:
Phone #: <i>352-727-3049</i>		Type Lateral Arm System:	Soil Bearing / PSF:
Date Installed:		New Home: _____ Used Home: _____	Torque Probe / in-lbs:
Installed Wind Zone: <i>II</i>		Data Plate Wind Zone:	Permit #:
Note:			

**STATE OF FLORIDA
INSTALLATION CERTIFICATION LABEL**

126225

LABEL #

DATE OF INSTALLATION

CHRISTOPHER C. OLIN

NAME

IH / 1025395 / 1

6877

LICENSE #

ORDER #

CERTIFIES THAT THE INSTALLATION OF THIS MOBILE HOME IS
IN ACCORDANCE WITH FLORIDA STATUTES 320.8249, 320.8325
AND RULES OF THE HIGHWAY SAFETY AND MOTOR VEHICLES.

INSTRUCTIONS

PLEASE WRITE DATE OF
INSTALLATION AND AFFIX
LABEL NEXT TO HUD LABEL.
USE PERMANENT INK PEN
OR MARKER ONLY.
COMPLETE INFORMATION
ABOVE AND KEEP ON FILE
FOR A MINIMUM OF 2 YEARS.
YOU ARE REQUIRED TO
PROVIDE COPIES WHEN
REQUESTED.