



STATE OF FLORIDA  
 DEPARTMENT OF HEALTH  
 ONSITE SEWAGE TREATMENT AND DISPOSAL  
 SYSTEM  
 APPLICATION FOR CONSTRUCTION PERMIT

PERMIT NO. 22-0584  
 DATE PAID: \_\_\_\_\_  
 FEE PAID: 60.00  
 RECEIPT #: 1854807

APPLICATION FOR:

New System     Existing System     Holding Tank     Innovative  
 Repair     Abandonment     Temporary     Like/Like

APPLICANT: Robert Petty & Lindsey Moates-Petty  
 AGENT: Robert Ford III - North Florida Septic Tank Inc TELEPHONE: 386-755-6372  
 MAILING ADDRESS: 741 SE SR 100, Lake City FL 32025

TO BE COMPLETED BY APPLICANT OR APPLICANT'S AUTHORIZED AGENT. SYSTEMS MUST BE CONSTRUCTED BY A PERSON LICENSED PURSUANT TO 489.105(3)(m) OR 489.552, FLORIDA STATUTES. IT IS THE APPLICANT'S RESPONSIBILITY TO PROVIDE DOCUMENTATION OF THE DATE THE LOT WAS CREATED OR PLATTED (MM/DD/YY) IF REQUESTING CONSIDERATION OF STATUTORY GRANDFATHER PROVISIONS.

PROPERTY INFORMATION

LOT: 11 BLOCK: - SUBDIVISION: Double Run Acres PLATTED: SF  
 PROPERTY ID #: 17-35-17-04971-011 ZONING: \_\_\_\_\_ I/M OR EQUIVALENT: [ Y/N ]  
 PROPERTY SIZE: 1.01 ACRES WATER SUPPLY:  PRIVATE PUBLIC [ ] <=2000GPD [ ] >2000GPD  
 IS SEWER AVAILABLE AS PER 381.0065, FS? [ Y/~~X~~ ] DISTANCE TO SEWER: \_\_\_\_\_ FT  
 PROPERTY ADDRESS: 450 ~~NW~~ Rebecca Ter, Lake City FL  
 DIRECTIONS TO PROPERTY: A/N TR on Tammy Ln, 3rd Rd on  
LR) Rebecca St, 9th Drive on R

BUILDING INFORMATION

RESIDENTIAL     COMMERCIAL

Unit No	Type of Establishment	No. of Bedrooms	Building Area Sqft	Commercial/Institutional System Design Table 1, Chapter 64E-6, FAC
1	<u>Old 3.B</u>	<u>3</u>	<u>1248</u>	<u>org attached</u>
2	<u>NEW</u>	<u>3</u>	<u>1976</u>	
3	_____	_____	_____	_____
4	_____	_____	_____	_____

Floor/Equipment Drains     Other (Specify) \_\_\_\_\_

SIGNATURE: Robert Ford III DATE: 6/27/22


22.0584.

Petty Job  
1"=40'

Columbia CHD

APPROVED

7/5/22

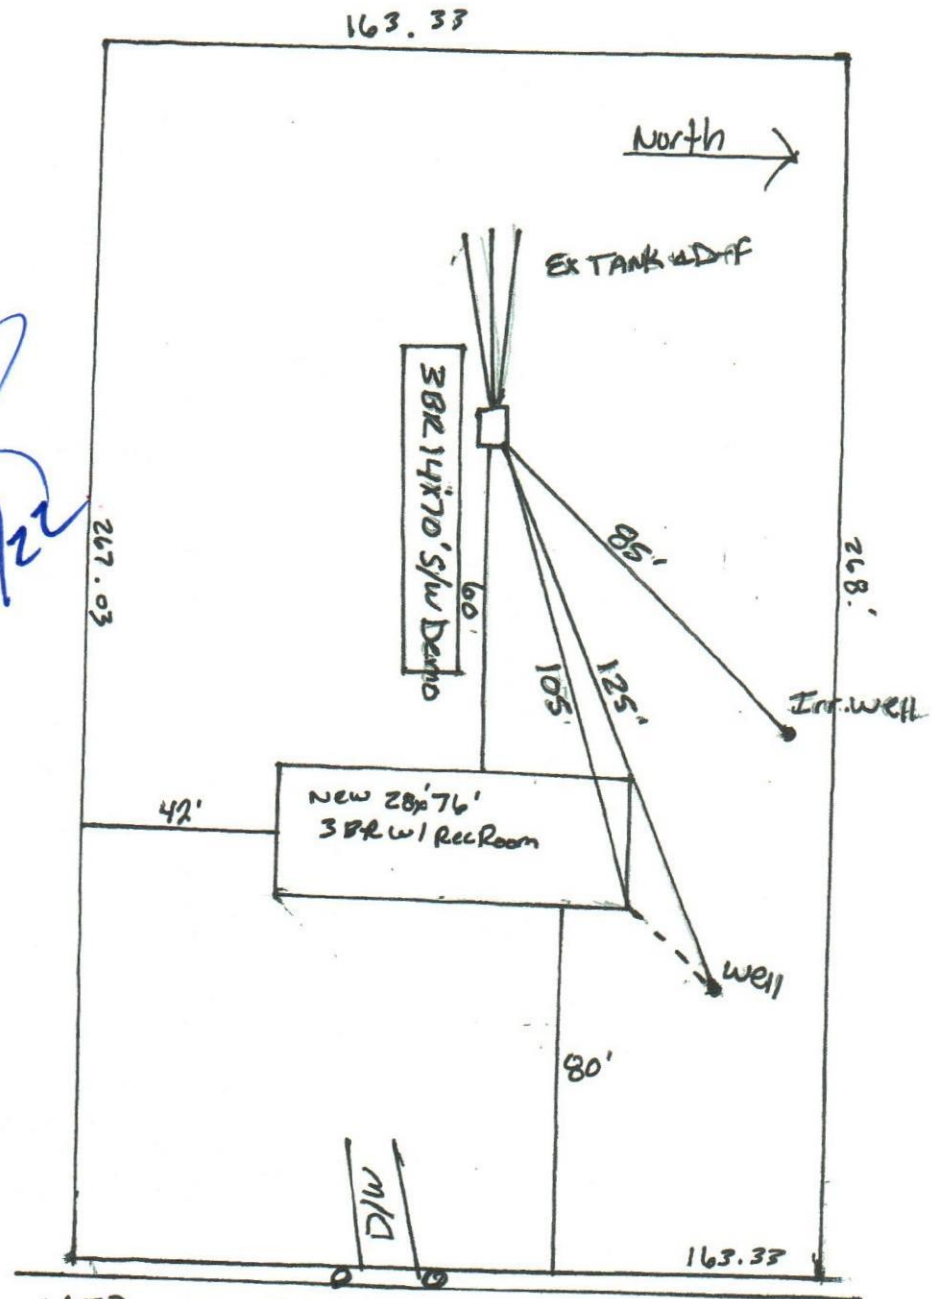

Robert Ford 999

6-27-2022

450 Ne Rebecca Terr. Lake City FL.