



STATE OF FLORIDA
DEPARTMENT OF ENVIRONMENTAL PROTECTION
ONSITE SEWAGE TREATMENT AND DISPOSAL
SYSTEM (OSTDS)

PERMIT NO. 96-1557
DATE PAID: 7/18/16
FEE PAID: 370.00
RECEIPT #: 231411

APPLICATION FOR CONSTRUCTION PERMIT

APPLICATION FOR:

☒ New System ☐ Existing System ☐ Holding Tank ☐ Innovative
☐ Repair ☐ Abandonment ☐ Temporary ☐

APPLICANT: John Goss EMAIL: NFLSEPTICTANK@COMCAST.NET

AGENT: ROBERT FORD III- NORTH FLORIDA SEPTIC TANK INC TELEPHONE: 386-755-6372

MAILING ADDRESS: 741 SE STATE ROAD 100, LAKE CITY FL 32025 *Goss 386-618-1345

TO BE COMPLETED BY APPLICANT OR APPLICANT'S AUTHORIZED AGENT. SYSTEMS MUST BE CONSTRUCTED BY A PERSON LICENSED PURSUANT TO 489.105(3) (m) OR 489.552, FLORIDA STATUTES. IT IS THE APPLICANT'S RESPONSIBILITY TO PROVIDE DOCUMENTATION OF THE DATE THE LOT WAS CREATED OR PLATTED (MM/DD/YY) IF REQUESTING CONSIDERATION OF STATUTORY GRANDFATHER PROVISIONS.

PROPERTY INFORMATION

OSTDS REMEDIATION PLAN? ☒ Y ☐ N

LOT: 28 BLOCK: - SUBDIVISION: Double Run Acres PLATTED: -

PROPERTY ID #: 17-3517-04971-028 ZONING: - I/M OR EQUIVALENT: ☐ Y ☐ N

PROPERTY SIZE: 1.15 ACRES WATER SUPPLY: ☒ PRIVATE PUBLIC ☐ ≤ 2000 GPD ☐ > 2000 GPD

IS SEWER AVAILABLE AS PER 381.0065, FS? ☒ Y ☐ N DISTANCE TO SEWER: - FT

PROPERTY ADDRESS: TBD NE WAYLON Gln, Lake City FL

DIRECTIONS TO PROPERTY: -

BUILDING INFORMATION

☒ RESIDENTIAL ☐ COMMERCIAL

Unit No.	Type of Establishment	No. of Bedrooms	Building Area Sqft	Commercial/Institutional System Design Table I, Chapter 62-6, FAC
1	<u>USED MH</u>	<u>2</u>	<u>420</u>	
2	<u>STORAGE SHED</u>	<u>0</u>	<u>200</u>	<u>R.S. 7-17 26</u>
3				
4				

☐ FLOOR/EQUIPMENT DRAINS ☐ OTHER (SPECIFY) -

SIGNATURE: Robert Ford 999 DATE: 7-6-2026

STATE OF FLORIDA
DEPARTMENT OF ENVIRONMENTAL PROTECTION
APPLICATION FOR CONSTRUCTION PERMIT

1"=40

Permit Application Number _____

----- PART II - SITEPLAN -----

GROSS

See Att.


Site Plan submitted by: Robert Ford PPA Date: 7-6-2026
Plan Approved ☒ Not Approved _____ Date: 7/29/26
By: [Signature] Columbia County Health Department

ALL CHANGES MUST BE APPROVED BY THE COUNTY HEALTH DEPARTMENT

1"=40'
Robert W. Dole
7-6-2026

Goss Job

He-0559

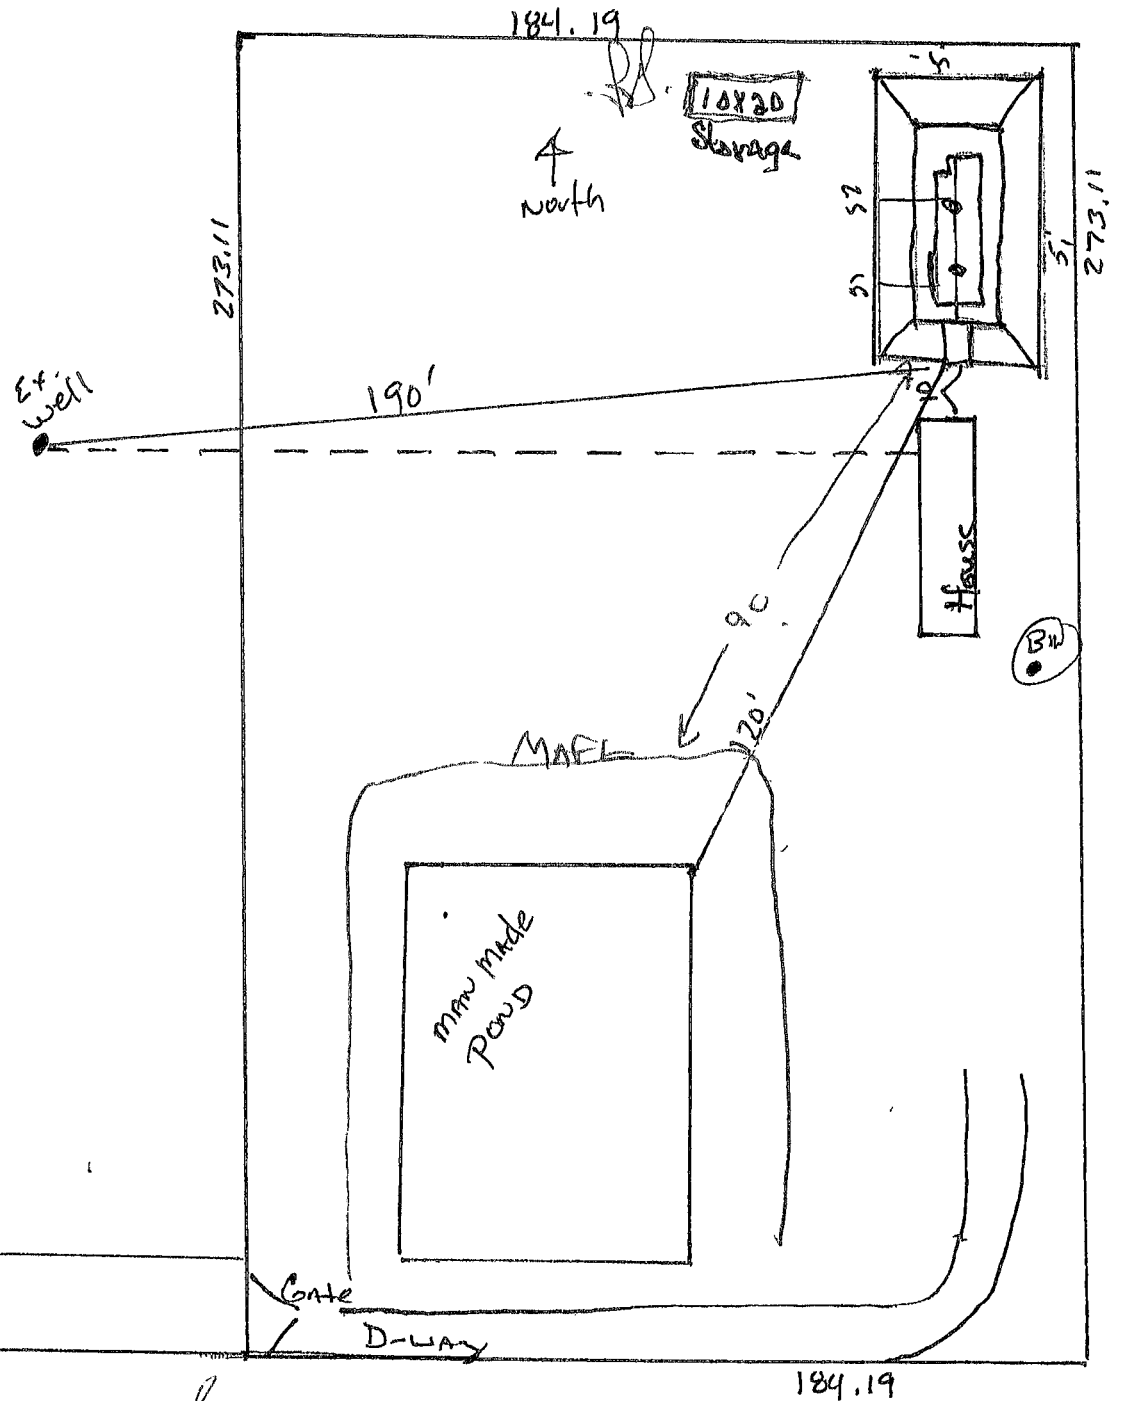

[Signature]



Columbia County Health Department
217 NE Franklin St Lake City, FL 32055

PAYING ON: # 12-SC-4117182 BILL DOC #: 12-BID-8620413 CONSTRUCTION APPLICATION # AP2314111
RECEIVED FROM: North Florida Septic Tank Inc AMOUNT PAID: \$ 310.00
PAYMENT FORM: CREDIT CARD 1624 PAYMENT DATE 07/10/2026
MAIL TO: North Florida Septic Tank Inc
Robert Ford Jr.
741 SE State Road 100
Lake City, FL 32025

FACILITY NAME : _____

PROPERTY LOCATION:

JOHN GOSS 26-0557
NE WAYLON Gln
Lake City, FL 32055

Lot: 28 Block: _____

Property ID: 07971-028

EXPLANATION or DESCRIPTION:	QUANTITY	FEE
128 - OSTDS Construction System Inspection Research Fee	1	\$ 5.00
-1 - COUNTY FEE 1 (OSTDS)	1	\$ 25.00
-1 - OSTDS Construction Application and Plan Review, New	1	\$ 100.00
126 - OSTDS Construction Permit (New or Mod, Amendment)	1	\$ 55.00
127 - OSTDS Construction System Inspection	1	\$ 75.00
133 - OSTDS Construction Reinspection	1	\$ 50.00

RECEIVED BY: MobleySJ AUDIT CONTROL NO. 12-PID-8057390

Note: NFS/26-0557 150294838 USED MH 2 BDRM 420 SQ FT