





Mobile Home Permit Worksheet

Installer: Rodney Carmichael License # IH/1025656
Address of home being installed: 2349 SW Centerville Ave FT White

Manufacturer: Pion Length x width: 16x76

NOTE: If home is a single wide fill out one half of the blocking plan. If home is a triple or quad wide sketch in remainder of home. I understand Lateral Arm Systems cannot be used on any home (new or used) where the sidewall ties exceed 5 ft 4 in.

Installer's initials: RC

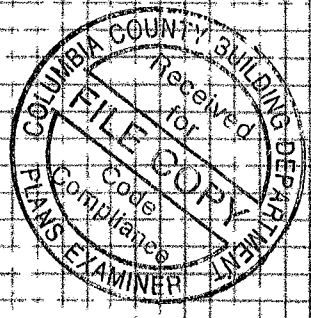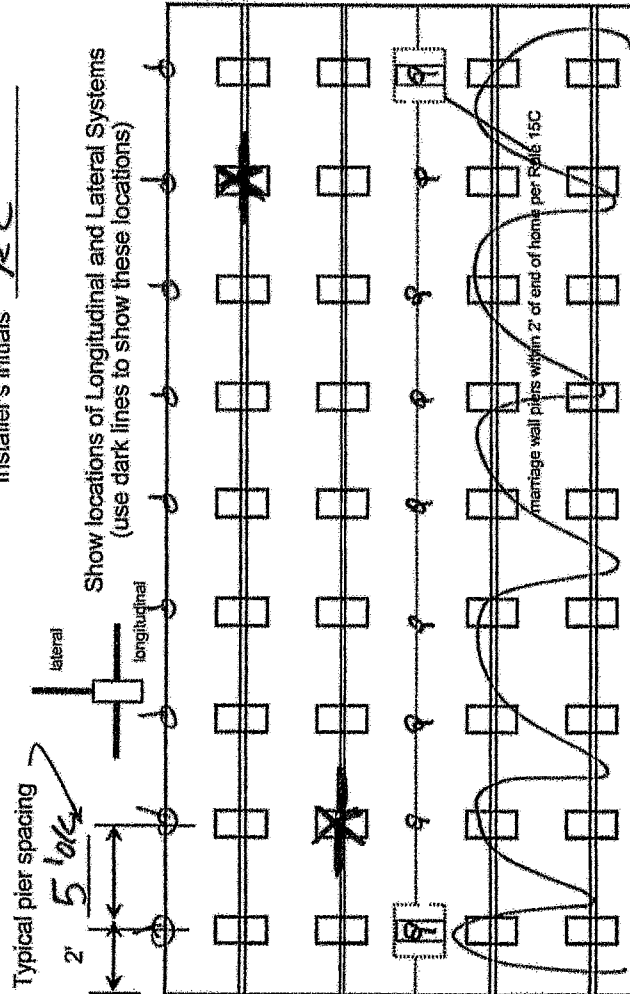

Permit Number:

Date:

Form fields for New Home, Used Home, Home installed to the Manufacturer's Installation Manual, Home is installed in accordance with Rule 15-C, Single wide, Double wide, Triple/Quad, Wind Zone II, Wind Zone III, Installation Decal #, Serial #.

PIER SPACING TABLE FOR USED HOMES

Table with 7 columns: Load bearing capacity, Footer size (sq in), 16' x 16" (256), 18 1/2' x 18 1/2" (342), 20' x 20" (400), 22' x 22" (484), 24' x 24" (576), 26' x 26" (676).

*Interpolated from Rule 15C-1 pier spacing table.

PIER PAD SIZES

I-beam pier pad size: 17x85
Perimeter pier pad size: 16x16
Other pier pad sizes (required by the mfg.): N/A

POPULAR PAD SIZES

Table with 2 columns: Pad Size, Sq In. Rows include 16 x 16, 16 x 18, 18.5 x 18.5, 16 x 22.5, 17 x 22, 13 1/2 x 26 1/2, 20 x 20, 17 3/16 x 25 3/16, 17 1/2 x 25 1/2, 24 x 24, 26 x 26.

Draw the approximate locations of marriage wall openings 4 foot or greater. Use this symbol to show the piers.

List all marriage wall openings greater than 4 foot and their pier pad sizes below.

Opening Pier pad size

4 ft 5 ft

ANCHORS

FRAME TIES

within 2' of end of home spaced at 5' 4" oc

TIEDOWN COMPONENTS

Longitudinal Stabilizing Device (LSD) Manufacturer: Oliver Technologies 1021 LV
Longitudinal Stabilizing Device w/ Lateral Arms Manufacturer: N/A

OTHER TIES

Number: 6
Sidewall Longitudinal Marriage Wall: N/A
Shear Wall: N/A



Mobile Home Permit Worksheet

POCKET PENETROMETER TEST

The pocket penetrometer tests are rounded down to _____ psf or check here to declare 1000 lb. soil ☒ without testing.

X 1000 psf X ☒ X ☒

POCKET PENETROMETER TESTING METHOD

1. Test the perimeter of the home at 6 locations.
2. Take the reading at the depth of the footer.
3. Using 500 lb. increments, take the lowest reading and round down to that increment.

X ☒ X ☒ X ☒

TORQUE PROBE TEST

The results of the torque probe test is 290 inch pounds or check here if you are declaring 5' anchors without testing. A test showing 275 inch pounds or less will require 5' anchors.

Note: A state approved lateral arm system is being used and 4 ft. anchors are allowed at the sidewall locations. I understand 5' anchors are required at all centerline tie points where the torque test reading is 275 or less and where the mobile home manufacturer may require anchors with 4000 lb. holding capacity.

Installer's initials RC

ALL TESTS MUST BE PERFORMED BY A LICENSED INSTALLER

Installer Name Rodney Carrichael

Date Tested 11-20-25

ELECTRICAL

Connect electrical conductors between multi-wide units, but not to the main power source. This includes the bonding wire between multi-wide units. Pg. N/A

PLUMBING

Connect all sewer drains to an existing sewer tap or septic tank. Pg. 15-22
Connect all potable water supply piping to an existing water meter, water tap, or other independent water supply systems. Pg. 15-25

Permit Number: _____

Date: _____

Site Preparation

Debris and organic material removed YES
Water drainage: Natural _____ Swale _____ Pad ☒ Other _____

Fastening multi wide units

Floor- Type Fastener: _____ Length: _____ Spacing: _____
Walls- Type Fastener: N/A Length: N/A Spacing: N/A
Roof- Type Fastener: _____ Length: _____ Spacing: _____

For used homes a min. 30 gauge, 8" wide, galvanized metal strip will be centered over the peak of the roof and fastened with galv. roofing nails at 2" on center on both sides of the centerline.

Gasket (weatherproofing requirement)

I understand a properly installed gasket is a requirement of all new and used homes and that condensation, mold, mildew and buckled marriage walls are a result of a poorly installed or no gasket being installed. I understand a strip of tape will not serve as a gasket.

Installer's initials _____

Type gasket N/A
Pg. _____
Installed:
Between Floors N/A
Between Walls N/A
Bottom of ridge beam N/A

Weatherproofing

The bottom board will be repaired and/or taped. Yes ☒ Pg. _____
Siding on units is installed to manufacturer's specifications. Yes ☒
Fireplace chimney installed so as not to allow intrusion of rain water. Yes N/A

Miscellaneous

Skirting to be installed. Yes ☒ No _____
Dryer vent installed outside of skirting. Yes ☒ No _____
Range downflow vent installed outside of skirting. Yes ☒ No _____
Drain lines supported at 4' intervals. Yes ☒ No _____
Electrical crossovers protected. Yes ☒ No _____
Other: _____

Installer verifies all information given with this permit worksheet is accurate and true based on the manufacturer's installation instructions and or Rule 15C-1 & 2

Installer's Signature [Signature] Date 11-20-25