

License Number: IH / 1133271 / 1 Name: DALE HOUSTON		
Order #: 6743	Label #: 123584	Manufacturer: SKYLINE
Homeowner: JERRY CORBETT	Year Model: 2026	(Check Size of Home) Single _____ Double X Triple _____
Address: 195 KENMORE GLEN	Length & Width: 52 x 24	HUD Label #:
City/State/Zip: LAKE CITY FL. 32055	Type Longitudinal System:	Soil Bearing / PSF:
Phone #:	Type Lateral Arm System:	Torque Probe / in-lbs:
Date Installed:	New Home: X Used Home: _____	Permit #:
Installed Wind Zone:	Data Plate Wind Zone:	
Note:		

STATE OF FLORIDA
INSTALLATION CERTIFICATION LABEL

123584

LABEL #	* DATE OF INSTALLATION
DALE HOUSTON	
NAME	
IH / 1133271 / 1	6743
LICENSE #	ORDER #

CERTIFIES THAT THE INSTALLATION OF THIS MOBILE HOME IS IN ACCORDANCE WITH FLORIDA STATUTES 320.8249, 320.8325 AND RULES OF THE HIGHWAY SAFETY AND MOTOR VEHICLES.

INSTRUCTIONS
PLEASE WRITE DATE OF INSTALLATION AND AFFIX LABEL NEXT TO HUD LABEL. USE PERMANENT INK PEN OR MARKER ONLY. COMPLETE INFORMATION ABOVE AND KEEP ON FILE FOR A MINIMUM OF 2 YEARS. YOU ARE REQUIRED TO PROVIDE COPIES WHEN REQUESTED.






Mobile Home Permit Worksheet

Installer: DALE HOUSTON License # IH/1133271
 Address of home being installed 195 KENMORE GLEN
LAKE CITY, FL 32055
 Manufacturer Skyline Length x width 52x24

NOTE: If home is a single wide fill out one half of the blocking plan
 If home is a triple or quad wide sketch in remainder of home
 I understand Lateral Arm Systems cannot be used on any home (new or used)
 where the sidewall ties exceed 5 ft 4 in.

Installer's initials DH

Typical pier spacing

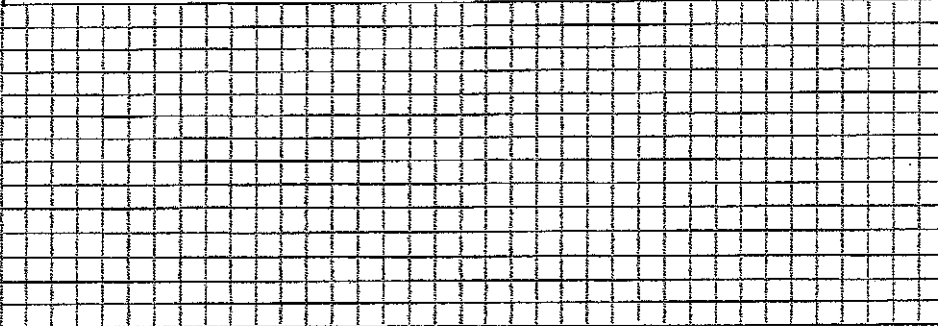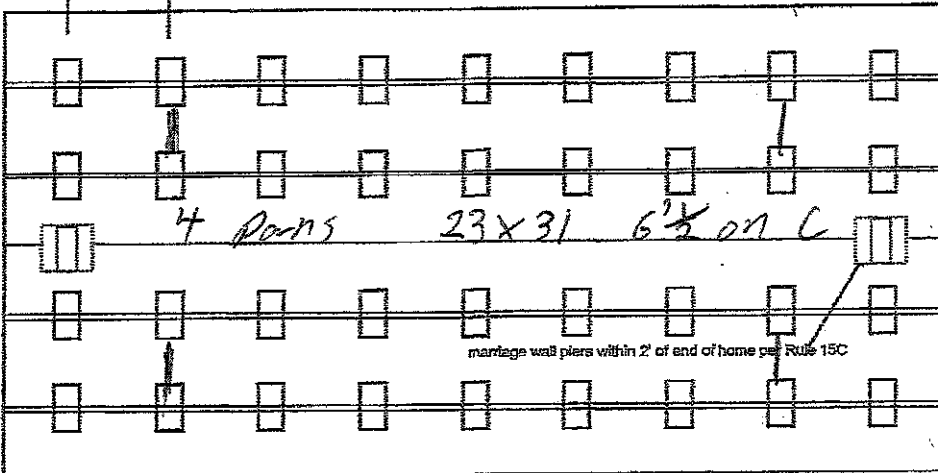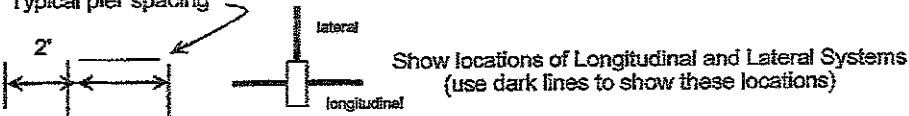

Permit Number: _____ Date: _____

New Home ☐ Used Home ☒

Home installed to the Manufacturer's Installation Manual
 Home is installed in accordance with Rule 15-C ☒

Single wide ☐ Wind Zone II ☒ Wind Zone III ☐

Double wide ☒ Installation Decal # 123584

Triple/Quad ☐ Serial # 17630497AU

PIER SPACING TABLE FOR USED HOMES

Load bearing capacity	Footer size (sq in)	16" x 16" (256)	18 1/2" x 18 1/2" (342)	20" x 20" (400)	22" x 22" (484)*	24" X 24" (576)*	26" x 26" (676)
1000 psf		3'	4'	5'	6'	7'	8'
1500 psf		4'	6'	7'	8'	8'	8'
2000 psf		6'	8'	8'	8'	8'	8'
2500 psf		7'	8'	8'	8'	8'	8'
3000 psf		8'	8'	8'	8'	8'	8'
3500 psf		8'	8'	8'	8'	8'	8'

*interpolated from Rule 15C-1 pier spacing table.

PIER PAD SIZES

I-beam pier pad size 23x31

Perimeter pier pad size 16x16

Other pier pad sizes
 (required by the mfg.) _____

Draw the approximate locations of marriage wall openings 4 foot or greater. Use this symbol to show the piers.

List all marriage wall openings greater than 4 foot and their pier pad sizes below.

Opening _____ Pier pad size _____

_____ 23x31

TIEDOWN COMPONENTS

Longitudinal Stabilizing Device (LSD)

Manufacturer _____

Longitudinal Stabilizing Device w/ Lateral Arms

Manufacturer _____

POPULAR PAD SIZES

Pad Size	Sq In
16 x 16	256
16 x 18	288
18.5 x 18.5	342
16 x 22.5	360
17 x 22	374
13 1/4 x 26 1/4	348
20 x 20	400
17 3/16 x 25 3/16	441
17 1/2 x 25 1/2	446
24 x 24	576
26 x 26	676

4 ft ☒ 5 ft ☒

ANCHORS

FRAME TIES

within 2' of end of home
 spaced at 5' 4" oc _____

OTHER TIES

	Number
Sidewall	<u>2</u>
Longitudinal	<u>4</u>
Marriage Wall	<u>2</u>
Shear Wall	<u>4</u>



Mobile Home Permit Worksheet

POCKET PENETROMETER TEST

The pocket penetrometer tests are rounded down to 1 psf or check here to declare 1000 lb. soil _____ without testing.

X _____ X _____ X _____

POCKET PENETROMETER TESTING METHOD

1. Test the perimeter of the home at 6 locations.
2. Take the reading at the depth of the footer.
3. Using 500 lb. increments, take the lowest reading and round down to that increment.

X _____ X _____ X _____

TORQUE PROBE TEST

The results of the torque probe test is 285 inch pounds or check here if you are declaring 5' anchors without testing _____. A test showing 275 inch pounds or less will require 5' anchors.

Note: A state approved lateral arm system is being used and 4 ft. anchors are allowed at the sidewall locations. I understand 5' anchors are required at all centerline tie points where the torque test reading is 275 or less and where the mobile home manufacturer may require anchors with 4000 lb. holding capacity.

Installer's initials DH

ALL TESTS MUST BE PERFORMED BY A LICENSED INSTALLER

Installer Name Dale Houston

Date Tested 3/16/26

ELECTRICAL

Connect electrical conductors between multi-wide units, but not to the main power source. This includes the bonding wire between multi-wide units. Pg. _____

PLUMBING

Connect all sewer drains to an existing sewer tap or septic tank. Pg. _____

Connect all potable water supply piping to an existing water meter, water tap, or other independent water supply systems. Pg. _____

Permit Number: _____

Date: _____

Site Preparation

Debris and organic material removed _____
Water drainage: Natural _____ Swale _____ Pad ☒ Other _____

Fastening multi wide units

Floor- Type Fastener: lags Length: 6" Spacing: 18"
Walls- Type Fastener: 1" Length: 1" Spacing: 1"
Roof- Type Fastener: 1" Length: 1" Spacing: 1"

For used homes a min. 30 gauge, 8" wide, galvanized metal strip will be centered over the peak of the roof and fastened with galv. roofing nails at 2" on center on both sides of the centerline.

Gasket (weatherproofing requirement)

I understand a properly installed gasket is a requirement of all new and used homes and that condensation, mold, mildew and buckled marriage walls are a result of a poorly installed or no gasket being installed. I understand a strip of tape will not serve as a gasket.

Installer's initials DH

Type gasket Feom
Pg. Feom

Installed:
Between Floors _____ Yes ☒
Between Walls _____ Yes ☒
Bottom of ridge beam _____ Yes ☒

Weatherproofing

The bottom board will be repaired and/or taped. _____ Yes ☒ Pg. _____
Siding on units is installed to manufacturer's specifications. _____ Yes ☒
Fireplace chimney installed so as not to allow intrusion of rain water. _____ Yes ☒

Miscellaneous

Skirting to be installed. _____ Yes _____ No _____ N/A
Dryer vent installed outside of skirting. _____ Yes _____ No _____ N/A
Range downflow vent installed outside of skirting. _____ Yes _____ No _____ N/A
Drain lines supported at 4' intervals. _____ Yes _____ No _____ N/A
Electrical crossovers protected. _____ Yes _____ No _____ N/A
Other: _____

Installer verifies all information given with this permit worksheet is accurate and true based on the manufacturer's installation instructions and or Rule 15C-1 & 2

Installer's Signature Dale Houston

Date _____