





RIGHT ELEVATION
SCALE: 1/4" = 1'-0"



LEFT ELEVATION
SCALE: 1/4" = 1'-0"

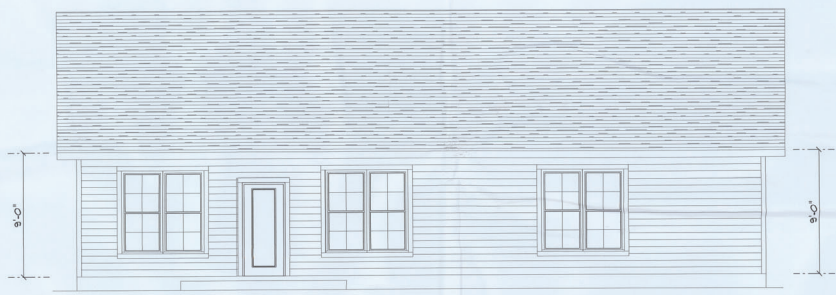

REAR ELEVATION
SCALE: 1/4" = 1'-0"

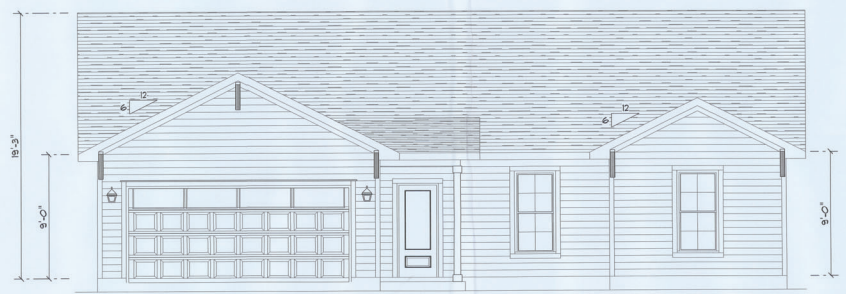

FRONT ELEVATION
SCALE: 1/4" = 1'-0"

REVISIONS SCHEDULE	
NO.	PROPOSAL


THE 1680 MODEL
 LOT 20, CANNON CREEK, LAKE CITY, FLORIDA 32024
ADAM'S CONSTRUCTION
 LAKE CITY, FLORIDA

RIDGEPOINT DESIGN
 1000 INTERNATIONAL STATE, LAKE CITY, FLORIDA 32095
 P: 386-288-1188
 E: RIDGEPOINTDESIGN@GMAIL.COM




SHEET NUMBER
A.1
 OF 4 SHEETS
 # 4072-1



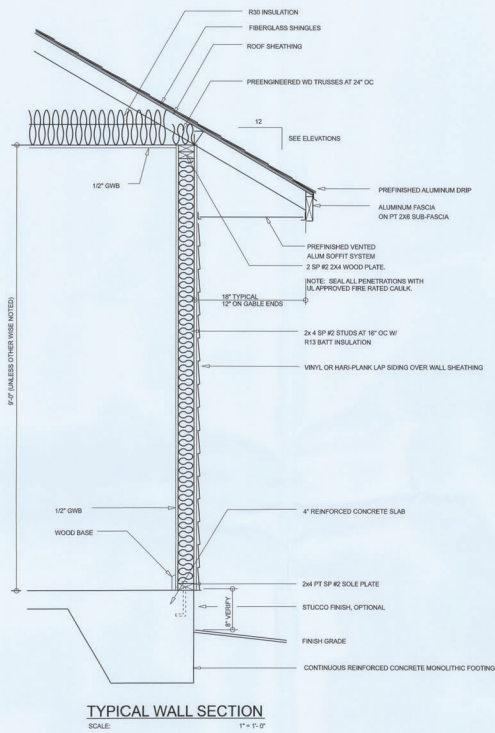

Garage fire separations shall comply with the following:

1. The private garage shall be separated from the dwelling unit and its attic area by means of a minimum 1/2-inch (12.7 mm) gypsum board applied to the garage side. Garages beneath habitable rooms shall be separated from all habitable rooms above by not less than 5/8-inch Type X gypsum board or equivalent. Door openings between a private garage and the dwelling unit shall be equipped with either solid wood doors, or solid or honeycomb core steel doors not less than 1 3/8 inches (34.9 mm) thick, or doors in compliance with Section 715.3.3. Openings from a private garage directly into a room used for sleeping purposes shall not be permitted.
2. Ducts in a private garage and ducts penetrating the walls or ceilings separating the dwelling unit from the garage shall be constructed of a minimum 0.015-inch (0.48 mm) sheet steel and shall have no openings into the garage.
3. A separation is not required between a Group R-3 and U carport provided the carport is entirely open on two or more sides and there are not enclosed areas above.
4. When installing an attic access and/or pull-down stair unit in the garage, devise shall have a minimum 20 min. fire rating.

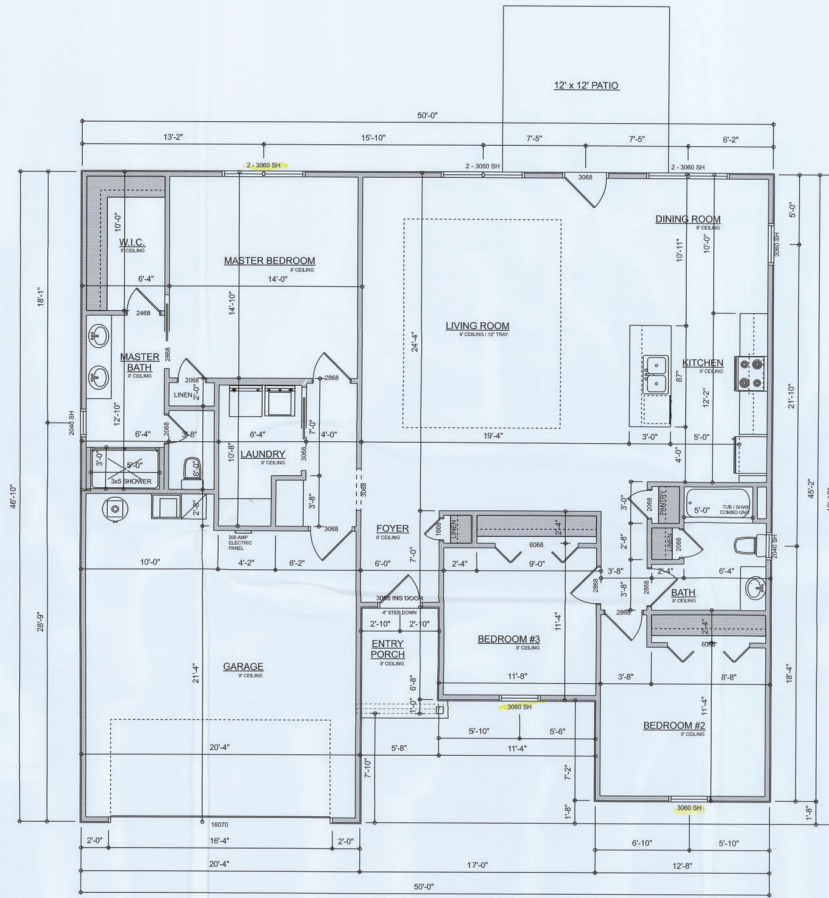

AREA SUMMARY

Room	Area (S.F.)	Unit
LIVING	1,680	S.F.
FRONT PORCH	43	S.F.
BACK PORCH	100	S.F.
GARAGE	453	S.F.
TOTAL AREA	2,276	S.F.

TOTAL CUBIC FOOTAGE OF CONDITIONED SPACE IS 14,320

REVISIONS SCHEDULE

NO.	DATE	DESCRIPTION
1	April 2nd, 2020	PROPOSAL

THE 1680 MODEL
LOT 20, CANNON CREEK, LAKE CITY, FLORIDA 32824
ADAM'S CONSTRUCTION
LAKE CITY, FLORIDA


RIDGEPOINT DESIGN
101 MARKET STREET, LAKE CITY, FLORIDA 32805
P: 386-298-1888
E: RIDGEPOINTDESIGN@GMAIL.COM

SHEET NUMBER
A.2
OF 4 SHEETS

ELECTRICAL LEGEND		
ELECTRICAL	COUNT	SYMBOL
CEILING FAN	4	
CAN LIGHT 6inch	6	
FLUORESCENT LIGHT 1x4	3	
PENDANT LIGHT	2	
EXTERIOR SCOURCE	2	
MOTION SECURITY LIGHT	3	
ELECTRIC PANEL	1	
CABLE TV OUTLET	4	
CARBON DETECTOR	1	
EXHAUST FAN	1	
EXHAUST FAN & LIGHT COMBO	1	
LAN CONNECTION	2	
OUTLET	32	
OUTLET 220v	5	
OUTLET GFI	12	
OUTLET WP	4	
SMOKE DETECTOR	5	
STANDARD LIGHT	8	
SWITCH	27	
SWITCH 3 WAY	6	
VANITY BAR LIGHT - SMALL	3	
UNDER CABINET LIGHT	2	

ELECTRICAL PLAN NOTES:

INSTALLATION SHALL BE PER 2017 NATL. ELECTRIC CODE.
 WIRE ALL APPLIANCES, HVAC UNITS AND OTHER EQUIPMENT PER MANUF. SPECIFICATIONS
 CONSULT WITH THE OWNER FOR THE NUMBER OF SEPERATE TELEPHONE LINES TO BE INSTALLED
 ALL SMOKE DETECTORS SHALL BE 120v W/ BATTERY BACKUP OF THE PHOTOELECTRIC TYPE AND SHALL BE INTERLOCKED TOGETHER. INSTALL INSIDE AND NEAR ALL BEDROOMS
 TELEPHONE, TELEVISION AND OTHER LOW VOLTAGE DEVICES OR OUTLETS SHALL BE AS PER THE OWNERS DIRECTIONS, & IN ACCORDANCE W/ APPLICABLE SECTIONS OF NEC-LATEST EDITION.
 ALL RECEPTICALS, NOT OTHERWISE NOTED, SHALL BE ARC FAULT INTERRUPTER TYPE, EXCEPT DEDICATED OUTLETS
 ALL RECEPTICALS IN WET AREAS SHALL BE GROUND FAULT INTERRUPTER TYPE (GFI)
 ALL EXTERIOR RECEPTICALS SHALL BE WEATHERPROOF GROUND FAULT INTERRUPTER TYPE (WP/GFI)
 NOTE:
 ELECTRICAL CONTR'S SHALL PREPARE "AS-BUILT" SHOP DWGS INDICATING ALL ELECTRICAL WORK, INCLUDING ANY CHANGES TO THE ELEC. PLAN, ADDNS TO THE ELEC. PLAN, RISER DIAGRAM, AS-BUILT PANEL SCHEDULE W/ ALL CRTS IDENTIFIED W/ CRT N. DESCRIPTION & BRKR. SERVICE ENT. & ALL UNDERGROUND WIRE LOCATIONS(ROUTING) (DEPTH). RISER DIA. SHALL INCLUDE WIRE SIZES/TYPE & EQUIPMENT TYPE W/ RATINGS & LOADS.
 CONTRACTOR SHALL PROVIDE 1 COPY OF AS-BUILT DWGS TO OWNER & 1 COPY TO THE PERMIT ISSUING AUTHORITY

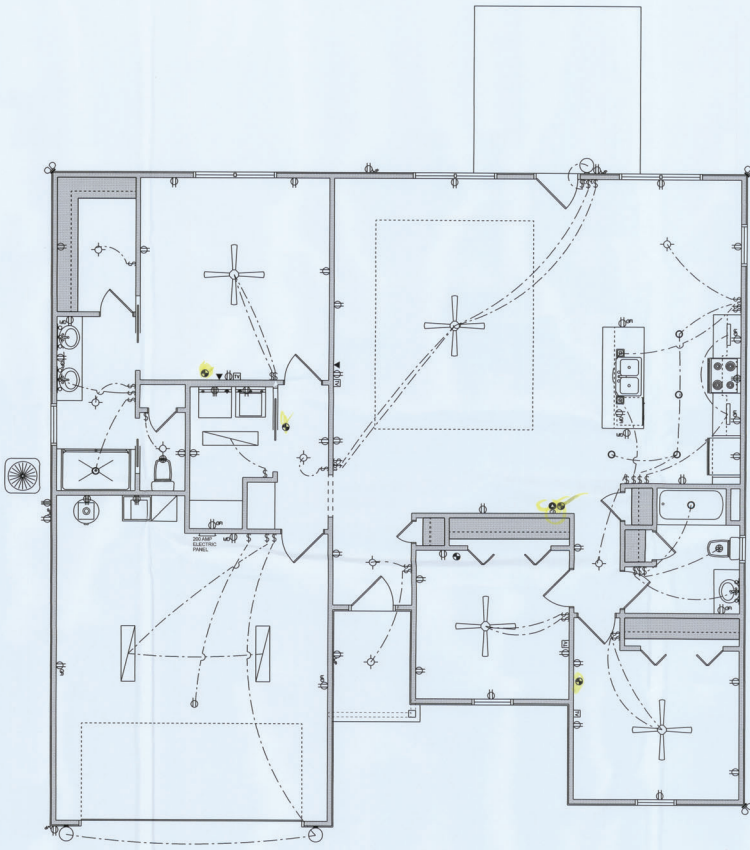


ELECTRIC FLOOR PLAN
 SCALE: 1/4" = 1'-0"

REVISIONS SCHEDULE
PROPOSAL
April 2nd, 2020


THE 1680 MODEL
 LOT 20, CANNON CREEK, LAKE CITY, FLORIDA 32024
 ADAM'S CONSTRUCTION
 LAKE CITY, FLORIDA

RIDGEPOINT DESIGN
 811 MARKET PLACE STREET, LAKE CITY, FLORIDA 32005
 P: 386-298-1188
 E: RIDGEPOINTDESIGN@GMAIL.COM


SHEET NUMBER
A.3
 OF 4 SHEETS

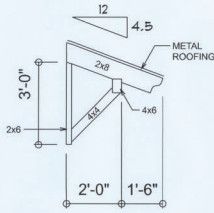


WINDOW AWNING DETAIL
SCALE: NOT TO SCALE

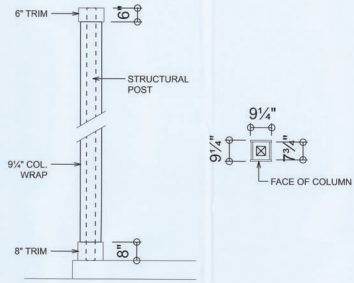


POST WRAP DETAIL
SCALE: NOT TO SCALE

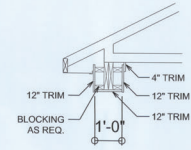


PORCH BEAM WRAP DETAIL
SCALE: NOT TO SCALE

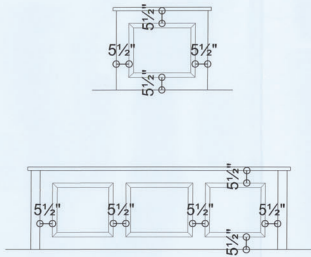

KITCHEN ISLAND DETAIL
SCALE: NOT TO SCALE

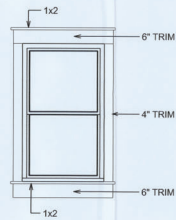

WINDOW TRIM DETAIL
SCALE: NOT TO SCALE

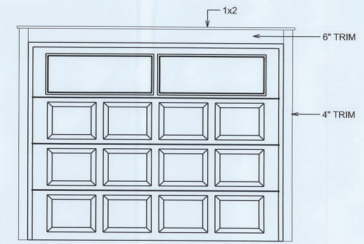

GARAGE TRIM DETAIL
SCALE: NOT TO SCALE

REVISIONS SCHEDULE	
PROPOSAL	
April 2nd, 2020	

THE 1680 MODEL
LOT 20, CANNON CREEK, LAKE CITY, FLORIDA 32824
ADAM'S CONSTRUCTION
LAKE CITY, FLORIDA

RIDGEPOINT DESIGN
818 WEST DUNAL STREET, LAKE CITY, FLORIDA 32805
P: 386.286.1888
F: RIDGEPOINTDESIGN@GMAIL.COM


SHEET NUMBER
A.4
OF 4 SHEETS

REVISIONS
Mar. 24th, 2020


WOOD STRUCTURAL NOTES

- TEMPORARY BRACING OF THE STRUCTURE DURING ERECTION, REQUIRED FOR SAFE AND STABLE CONSTRUCTION, SHALL BE THE SOLE RESPONSIBILITY OF THE CONTRACTOR SO ENGAGED. TEMPORARY & PERMANENT BRACING OF ROOF TRUSSES SHALL BE AS PER THE STANDARD GUIDELINES OF THE "TRUSS PLATE INSTITUTE".
- ALL TRUSSES SHALL BE DESIGNED BY A LICENSED PROFESSIONAL ENGINEER & SHALL BE SIGNED AND SEALED BY SAME. TRUSS DESIGN SHALL INCLUDE PLACEMENT PLANS, TRUSS DETAILS, TRUSS TO TRUSS CONNECTIONS & THE STANDARD SPECIFICATIONS & RECOMMENDATIONS OF INSTALLATION OF THE "TRUSS PLATE INSTITUTE".
- WOOD STUDS IN EXTERIOR WALLS & INTERIOR BEARING WALLS SHALL BE NOT LESS THAN N/2 HEY-FIR OR BETTER.
- CONNECTORS FOR WOOD FRAMING SHALL BE GALVANIZED METAL OR BLACK METAL AS MANUFACTURED OR AS CALLED FOR IN THE PLANS AND BE OF A DESIGN SUITABLE FOR THE LOADS AND USE INTENDED. REFER TO THE JOINT REINFORCEMENT SCHEDULE FOR PRINCIPLE CONNECTIONS.

AREA OF ATTIC	REQD LF OF VENT	NET FREE AREA OF STACK
400 SF	10 LF	140 SQ. IN.
800 SF	21 LF	280 SQ. IN.
1200 SF	28 LF	420 SQ. IN.
1600 SF	35 LF	560 SQ. IN.
2000 SF	42 LF	700 SQ. IN.
2400 SF	49 LF	840 SQ. IN.

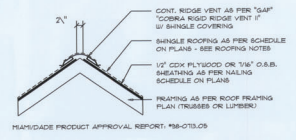


Ridge Vent DETAIL
SCALE: 3/4" = 1'-0" (B)

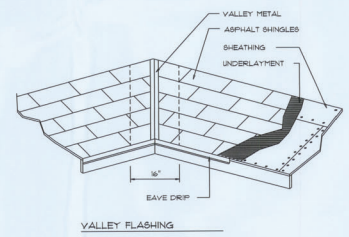

ROOFING METALS for FLASHING/ROOFING MINIMUM THICKNESS REQUIREMENTS			
MATERIAL	THICKNESS (in.)	GAGE	WEIGHT (LBS.)
COPPER			16
ALUMINUM	0.024		
STAINLESS STEEL		28	
GALVANIZED STEEL	0.078	36 (ZINC COATED 95%)	
ZINC ALLOY LEAD FINISHED TERNE	0.021		40

Roofing/Flashing DETS.
SCALE: NONE (A)

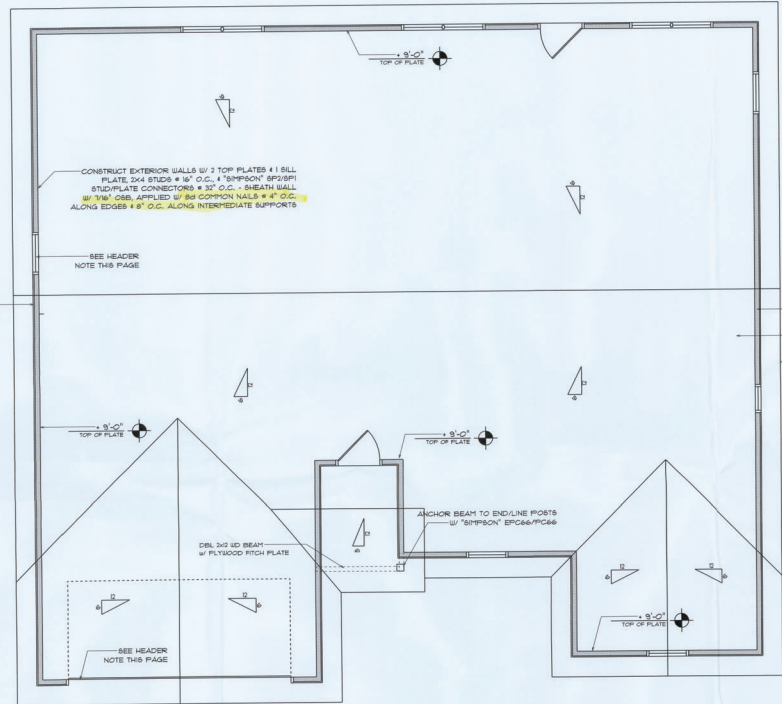

Roof Framing PLAN
SCALE: 1/4" = 1'-0"

NOTE:
ANCHOR GIRDER TRUSSES TO HEADER WITH 2 "SIMPSON" L572.3 OR 4", ANCHOR HEADERS TO KING TRUSS w/ 2 "SIMPSON" 872 EA. END - TYP. - T.O.

GENERAL TRUSS NOTES:

- TRUSSES SHALL BE DESIGNED BY A LICENSED ENGINEER AND IN ACCORDANCE WITH THE REQUIREMENTS OF THE "NATIONAL FOREST PRODUCTS ASSOCIATION" MANUAL FOR "STRESS RATED LUMBER AND T&E CONNECTIONS". LATEST EIA, ALONG w/ THE TRUSS PLATE INSTITUTE SUGGESTED GUIDELINES FOR TEMPORARY AND PERMANENT BRACING, AND HANDLING OF TRUSSES. TRUSS SHOP DRAWINGS SHALL INCLUDE TRUSS DESIGN, PLACEMENT PLANS, DETS. & TRUSS TO TRUSS CONNECTIONS.
- TRUSS SHOP DRAWINGS SHALL BE SIGNED & SEALED BY THE DESIGNING ENGINEER.
- FOLLOWING DEVELOPMENT OF TRUSS SHOP DRAWINGS, ADJUSTMENTS TO THE ANCHOR REQUIREMENTS MAY BE REQUIRED. DEPENDS ON THE ENGINEER'S QUALITY AND WIND UPLIFT REQUIREMENTS OF TRUSSES OR GARDENS. THE CONTRACTOR SHALL MAKE AVAILABLE A COMPLETE SET OF TRUSS SHOP DRAWINGS TO THE ARCHITECT FOR THE PURPOSE OF REVIEW OF LOADS IMPOSED ON THE BALANCE OF THE STRUCTURE. ANY SUCH REQUIRED CHANGE SHALL BE INCORPORATED INTO THE CONSTRUCTION OF THE STRUCTURE.

NOTE:

ALL PENETRATIONS OF THE TOP PLATE OF ALL LOAD BEARING WALLS SHALL BE SEALED WITH FIRE RETARDANT CAULKING, INCLUDING WIRING, PIPING, OR OTHER SUCH PENETRATIONS. WALLS OVER 8'-0" TALL SHALL HAVE CONTINUOUS BLOCKINGS TO LIFT CAVITY HEIGHT TO 8'-0". PENETRATIONS THROUGH SUCH BLOCKINGS SHALL BE TREATED IN THE SAME MANNER AS TOP PLATES, NOTED ABOVE.

NOTE:

THE DESIGN WIND SPEED FOR THIS PROJECT IS 150 MPH PER FBC 1603 AND LOCAL JURISDICTION REQUIREMENTS.

NOTE:

THE DESIGN WIND SPEED FOR THIS PROJECT IS 150 MPH PER FBC 1603 AND LOCAL JURISDICTION REQUIREMENTS.

ROOF PLAN NOTES

- R-1 SEE ELEVATIONS FOR ROOF PITCH
- R-2 ALL OVERHANGS 18" (0" on gables) UNLESS OTHERWISE NOTED
- R-3 PROVIDE ATTIC VENTILATION IN ACCORDANCE WITH SCHEDULE ON 80.3
- R-4 SEE EXTERIOR ELEVATIONS AND FLOOR PLANS TO VERIFY PLATE AND SHEET HEIGHTS
- R-5 MOVE ALL VENTS AND OTHER ROOF PENETRATIONS TO REAR

STANDARD HEADER SCHEDULE

- 0'-0" UP TO 6'-0" OPENINGS**
DOUBLE 2x6 NAT'L SOUTHERN PINE WITH 1/2" OSB SOLID CONTINUOUS SPACER GLUED AND NAILED WITH 10d x 0.28" x 3" NAILS IN 2 ROWS @ 12" O.C. STAGGERED EACH SIDE WITH 1 - SIMPSON MBT4B TOP AND 1 - SIMPSON SPMR BOTTOM EACH SIDE OF OPENING WITH 1 - HEADER STUD AND 3 FULL HEIGHT STUDS EACH SIDE OF OPENING
- 6'-0" UP TO 9'-0" OPENINGS**
DOUBLE 2x6 NAT'L SOUTHERN PINE WITH 1/2" OSB SOLID CONTINUOUS SPACER GLUED AND NAILED WITH 10d x 0.28" x 3" NAILS IN 2 ROWS @ 12" O.C. STAGGERED EACH SIDE WITH 1 - SIMPSON MBT42A TOP AND 2 - SIMPSON SPMR BOTTOM EACH SIDE OF OPENING WITH 1 - HEADER STUD AND 2 FULL HEIGHT STUDS EACH SIDE OF OPENING
- 9'-0" UP TO 12'-0" OPENINGS**
DOUBLE 2x6 NAT'L SOUTHERN PINE WITH 1/2" OSB SOLID CONTINUOUS SPACER GLUED AND NAILED WITH 10d x 0.28" x 3" NAILS IN 2 ROWS @ 12" O.C. STAGGERED EACH SIDE WITH 3 - SIMPSON MBT4B EACH SIDE OF OPENING WITH 2 - HEADER STUDS AND 3 FULL HEIGHT STUDS EACH SIDE OF OPENING
- 12'-0" GARAGE DOOR OPENINGS**
2 PLY: 1x4 x 8-1/8" 2x6 MICROLAMR LVL HEADR FR GLUED AND NAILED WITH 10d x 0.28" x 3" NAILS IN 2 ROWS @ 12" O.C. STAGGERED EACH SIDE WITH 3 - SIMPSON MBT4B EACH SIDE OF OPENING WITH 2 - HEADER STUDS AND 3 FULL HEIGHT STUDS EACH SIDE OF OPENING

THE 1680 MODEL
LOT 20, CANNON CREEK, LAKE CITY, FLORIDA 32024
ADAM'S CONSTRUCTION
LAKE CITY, FLORIDA

NICHOLAS PAUL ARCHITECT
1500 W. 10th Street, Suite 200
LAKE CITY, FLORIDA 32009
(813) 788-9021

SHEET NUMBER
S.2
OF 4 SHEETS




General Roofing NOTES:

DECK REQUIREMENTS:
ASPHALT SHINGLES SHALL BE FASTENED TO SOLIDLY SHEATHED DECKS.
SLOPE:
ASPHALT SHINGLES SHALL BE USED ONLY ON ROOF SLOPES OF 2:12 OR GREATER. FOR ROOF SLOPES FROM 2:12 TO 4:12, DEL. UNDERLAYMENT IS REQUIRED.
UNDERLAYMENT:
UNLESS OTHERWISE NOTED, UNDERLAYMENT SHALL CONFORM W/ ASTM D 226, TYPE 1 OR ASTM D 4848, TYPE 1.
SELF-ADHERING POLYMER MODIFIED BITUMEN SHEET:
SELF-ADHERING POLYMER MODIFIED BITUMEN SHALL COMPLY W/ ASTM D 1810.
ASPHALT SHINGLES:
ASPHALT SHINGLES SHALL HAVE SELF SEAL STRIPS OR BE INTERLOCKING, AND COMPLY WITH ASTM D 226 OR ASTM D 3462.
FASTENERS:
FASTENERS FOR ASPHALT SHINGLES SHALL BE GALVANIZED, STAINLESS STEEL, ALUMINUM OR COPPER ROOFING NAILS, MINIMUM 12 GAUGE SHANK WITH A MINIMUM 3/8 INCH DIAMETER HEAD, OF A LENGTH TO PENETRATE THROUGH THE ROOFING MATERIAL AND A MINIMUM 3/4" INTO THE ROOF SHEATHING, WHERE THE SHEATHING IS LESS THAN 3/4" THICK, THE NAILS SHALL PENETRATE THROUGH THE SHEATHING.
ATTACHMENT:
ASPHALT SHINGLES SHALL BE SECURED TO THE ROOF WITH NOT LESS THAN FOUR FASTENERS PER STRIP SHINGLE OR TWO FASTENERS PER INDIVIDUAL SHINGLE WHERE ROOFS LOCATED IN BASIC WIND SPEED OF 100 MPH OR GREATER. SPECIAL METHODS OF FASTENING ARE REQUIRED. UNLESS OTHERWISE NOTED, ATTACHMENT OF ASPHALT SHINGLES SHALL CONFORM WITH ASTM D 394 OR MDG PA 101-95.
UNDERLAYMENT APPLICATION:
FOR ROOF SLOPES FROM 2:12 TO 4:12, UNDERLAYMENT SHALL BE A MINIMUM OF TWO LAYERS APPLIED AS FOLLOWS:
1. STARTING AT THE EAVE, A 19 INCH STRIP OF UNDERLAYMENT SHALL BE APPLIED PARALLEL WITH THE EAVE AND FASTENED SUFFICIENTLY TO STAY IN PLACE.
2. STARTING AT THE EAVE, 36 INCH WIDE STRIPS OF UNDERLAYMENT FELT SHALL BE APPLIED OVERLAPPING SUCCESSIVE SHEETS 9 INCHES AND FASTENED SUFFICIENTLY TO STAY IN PLACE.
FOR ROOF SLOPES 4:12 AND GREATER, UNDERLAYMENT SHALL BE A MINIMUM OF ONE LAYER OF UNDERLAYMENT FELT APPLIED AS FOLLOWS:
STARTING AT THE EAVE, UNDERLAYMENT SHALL BE APPLIED SHINGLE FASHION PARALLEL TO THE EAVE, LAPPED 3 INCHES, AND FASTENED SUFFICIENTLY TO STAY IN PLACE.


BASE AND CAP FLASHINGS:
BASE AND CAP FLASHINGS SHALL BE INSTALLED IN ACCORDANCE W/ MFG'S INSTALLATION INSTRUCTIONS. BASE FLASHING SHALL BE OF EITHER CORROSION RESISTANT METAL OF MINIMUM NOMINAL THICKNESS 0.019 INCH OR MINERAL SURFACE ROLL ROOFING WEIGHING A MINIMUM OF 71 LBS PER 100 SQUARE FEET. CAP FLASHING SHALL BE CORROSION RESISTANT METAL OF MINIMUM NOMINAL THICKNESS OF 0.019 INCH.

VALLEYS:
VALLEY LININGS SHALL BE INSTALLED IN ACCORDANCE W/ MANUFACTURER'S INSTALLATION INSTRUCTIONS BEFORE APPLYING ASPHALT SHINGLES. VALLEY LININGS OF THE FOLLOWING TYPES SHALL BE PERMITTED:
1. FOR OPEN VALLEYS LINED WITH METAL, THE VALLEY LINING SHALL BE AT LEAST 1/8" WIDE AND 90° OF ANY OF THE CORROSION RESISTANT METALS IN FBC TABLE 1801.3.2.
2. FOR OPEN VALLEYS, VALLEY LINING OF TWO PLIES OF MINERAL SURFACE ROLL ROOFING SHALL BE PERMITTED. THE BOTTOM LAYER SHALL BE 18 INCHES AND THE TOP LAYER A MINIMUM OF 36 INCHES WIDE.
3. FOR CLOSED VALLEYS VALLEY LINING SHALL BE ONE OF THE FOLLOWING:
1. BOTH TYPES 1 AND 2 ABOVE COMBINED.
2. ONE PLY OF SMOOTH ROLL ROOFING AT LEAST 36 INCHES WIDE AND COMPLYING WITH ASTM D 224.
3. SPECIALTY UNDERLAYMENT AT LEAST 36 INCHES WIDE AND COMPLYING WITH ASTM D 1930.


NOTE 1111
ROOF SHINGLES SHALL BE AS MANUFACTURED BY "MANKO ROOFING PRODUCTS" OF THE FOLLOWING MODELS:
GLASS-SEAL AIR
ELITE GLASS-SEAL AIR
HERITAGE 30 AIR
HERITAGE 40 AIR
HERITAGE 50 AIR
THESE SHINGLES MEET THE REQUIREMENTS OF ASTM D-394 TYPE 1 MODIFIED TO 130 MPH WINDS & FBC TAB 100, USING 4 NAILS/SHINGLE

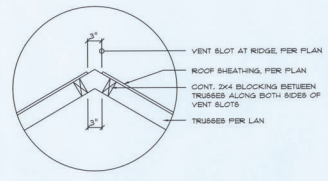

Vent DETAIL
SCALE: NONE **A1**

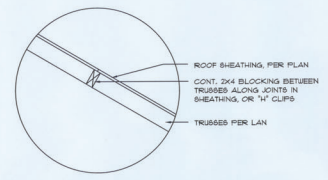

Joint DETAIL
SCALE: NONE **A2**

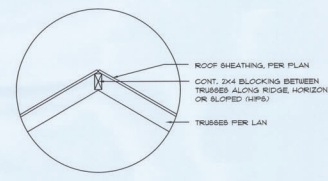

Ridge DETAIL
SCALE: NONE **A3**

BASE AND CAP FLASHINGS:
BASE AND CAP FLASHINGS SHALL BE INSTALLED IN ACCORDANCE W/ MFG'S INSTALLATION INSTRUCTIONS. BASE FLASHING SHALL BE OF EITHER CORROSION RESISTANT METAL OF MINIMUM NOMINAL THICKNESS 0.019 INCH OR MINERAL SURFACE ROLL ROOFING WEIGHING A MINIMUM OF 71 LBS PER 100 SQUARE FEET. CAP FLASHING SHALL BE CORROSION RESISTANT METAL OF MINIMUM NOMINAL THICKNESS OF 0.019 INCH.

VALLEYS:
VALLEY LININGS SHALL BE INSTALLED IN ACCORDANCE W/ MANUFACTURER'S INSTALLATION INSTRUCTIONS BEFORE APPLYING ASPHALT SHINGLES. VALLEY LININGS OF THE FOLLOWING TYPES SHALL BE PERMITTED:
1. FOR OPEN VALLEYS LINED WITH METAL, THE VALLEY LINING SHALL BE AT LEAST 1/8" WIDE AND 90° OF ANY OF THE CORROSION RESISTANT METALS IN FBC TABLE 1801.3.2.
2. FOR OPEN VALLEYS, VALLEY LINING OF TWO PLIES OF MINERAL SURFACE ROLL ROOFING SHALL BE PERMITTED. THE BOTTOM LAYER SHALL BE 18 INCHES AND THE TOP LAYER A MINIMUM OF 36 INCHES WIDE.
3. FOR CLOSED VALLEYS VALLEY LINING SHALL BE ONE OF THE FOLLOWING:
1. BOTH TYPES 1 AND 2 ABOVE COMBINED.
2. ONE PLY OF SMOOTH ROLL ROOFING AT LEAST 36 INCHES WIDE AND COMPLYING WITH ASTM D 224.
3. SPECIALTY UNDERLAYMENT AT LEAST 36 INCHES WIDE AND COMPLYING WITH ASTM D 1930.

NOTE 1111
ROOF SHINGLES SHALL BE AS MANUFACTURED BY "MANKO ROOFING PRODUCTS" OF THE FOLLOWING MODELS:
GLASS-SEAL AIR
ELITE GLASS-SEAL AIR
HERITAGE 30 AIR
HERITAGE 40 AIR
HERITAGE 50 AIR
THESE SHINGLES MEET THE REQUIREMENTS OF ASTM D-394 TYPE 1 MODIFIED TO 130 MPH WINDS & FBC TAB 100, USING 4 NAILS/SHINGLE

MULTIPLE GANG LAM. DETAIL
NOT TO SCALE

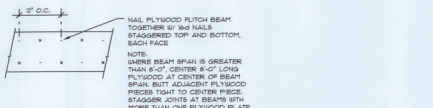

PLYWOOD FLITCH BEAM DETAIL
NOT TO SCALE



B/U Beam DETAILS
SCALE: NONE **B**

FRAMING ANCHOR SCHEDULE

APPLICATION	MANUF'R/MODEL	CAP.
TRUSS TO WALL	SIMPSON 42 SB or SDUC16400	600#
GINDER TRUSS TO POST/HEADER:	SIMPSON LGT. W/ 28 - 64 NAILS	180#
HEADER TO KING STUD(S):	SIMPSON B72	170#
PLATE TO STUD:	NO CONNECTION REQ. WHEN USING WINDSTORM BOARD	170#
STUD TO BILL:	NO CONNECTION REQ. WHEN USING WINDSTORM BOARD	220#
PORCH BEAM TO POST:	SIMPSON PC44 or (2) 5/8" LAG BOLTS EA. POST	38#/240#
PORCH POST TO FND.:	SIMPSON AB44	
MISC. JOINTS	SIMPSON A34	


NOTE:
ALL ANCHORS SHALL BE SECURED W/ NAILS AS PRESCRIBED BY THE MANUFACTURER FOR MAXIMUM JOINT STRENGTH, UNLESS NOTED OTHERWISE.
NOTE:
REFER TO THE INCLUDED STRUCTURAL DETAILS FOR ADDITIONAL ANCHORS/ JOINT REINFORCEMENT AND FASTENERS.
NOTE:
ALL UNLISTED JOINTS IN THE LOAD PATH SHALL BE REINFORCED WITH SIMPSON A34 FRAMING ANCHORS, TYPICAL T.O.
NOTE:
"SIMPSON" PRODUCT APPROVAL:
MIAMI/DADE COUNTY REPORT #18-0818.B
NOTE:
"SIMPSON" PRODUCT APPROVAL:
MIAMI/DADE COUNTY REPORT #18-01-05, #16-10-11, #19-06-23, 04 SBCCI NER-143, NER-393

BUILDING COMPONENTS 4 CLADDING LOADS
MEAN BUILDING HEIGHT = 30.0', EXPOSURE "B"
ROOF ANGLE 1° TO 11°

WIND SPEED (MPH)	WIND		WIND		WIND	
	10 MPH	20 MPH	30 MPH	40 MPH	50 MPH	60 MPH
1	10.0 / -18.9	14.9 / -23.1	17.8 / -21.8	20.3 / -23.3	22.8 / -23.3	25.3 / -23.3
2	11.4 / -18.4	16.4 / -23.0	19.0 / -21.0	21.5 / -23.4	24.0 / -23.4	26.5 / -23.4
3	12.9 / -18.6	17.7 / -22.2	20.7 / -20.0	23.2 / -23.0	25.9 / -23.0	28.6 / -23.0
4	14.4 / -18.7	19.2 / -21.3	22.6 / -19.4	25.3 / -22.1	28.4 / -22.1	31.5 / -22.1
5	16.0 / -18.8	20.9 / -20.4	24.8 / -18.5	27.7 / -21.2	31.0 / -21.2	34.4 / -21.2
6	17.6 / -18.9	22.8 / -19.5	27.3 / -17.6	30.4 / -20.3	33.9 / -20.3	37.5 / -20.3
7	19.3 / -19.0	24.9 / -18.6	30.1 / -16.7	33.4 / -19.4	37.1 / -19.4	40.9 / -19.4
8	21.1 / -19.1	27.2 / -17.7	33.2 / -15.8	36.7 / -18.5	40.7 / -18.5	44.6 / -18.5
9	23.0 / -19.2	29.7 / -16.8	36.7 / -14.9	40.4 / -17.6	44.7 / -17.6	48.7 / -17.6
10	25.0 / -19.3	32.4 / -15.9	40.6 / -14.0	44.5 / -16.7	49.1 / -16.7	53.2 / -16.7

HEIGHT 4 EXPOSURE ADJUSTMENT COEFFICIENTS
FOR BUILDING COMPONENTS 4 CLADDING

BUILDING HEIGHT	EXPOSURE "B"	EXPOSURE "C"	EXPOSURE "D"
10	1.00	1.21	1.47
20	1.00	1.29	1.59
30	1.00	1.36	1.67
40	1.00	1.40	1.69

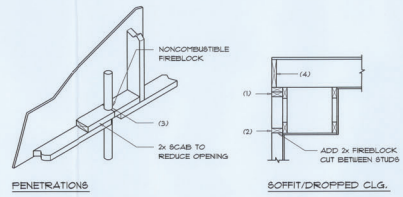

PENETRATIONS
FIREBLOCKING NOTES:

1. IN CONCEALED SPACES OF STUD WALLS AND PARTITIONS INCLUDING PURSED SPACES AT CEILING AND FLOOR LEVELS.
2. AT ALL INTERCONNECTIONS BETWEEN CONCEALED VERTICAL AND HORIZONTAL SPACES SUCH AS OCCUR AT SOFFITS, DROP CEILING, COVE CEILING, ETC.
3. AT OPENINGS AROUND VENTS, PIPES, DUCTS, CHIMNEYS AND FIREPLACES AT CEILING AND FLOOR LEVELS WITH PYROPLANEL MULTIFLEX SEALANT.
4. AT ALL INTERCONNECTIONS BETWEEN CONCEALED VERTICAL STUD WALL OR PARTITION SPACES AND CONCEALED SPACES CREATED BY AN ASSEMBLY OF FLOOR JOISTS FIREBLOCKING SHALL BE PROVIDED FOR THE FULL DEPTH OF THE JOISTS AT THE END OF AND OVER THE SUPPORTS.

Fire Stopping DETAILS
SCALE: NONE

FLORIDA BUILDING CODE
Compliance Summary

TYPE OF CONSTRUCTION
Roof: Gable Construction Wood Trusses # 24" O.C. 2x4 Wood Studs # 16" O.C.
Floor: 4" TH. Concrete Slab w/ Fiberglass Concrete Additive
Foundation: Continuous Footer/Beam Wall

ROOF DECKING
Header: 1/2" CD Plywood or 1 1/2" O.S.B.
Sheet Size: 48" x 96" Sheets Perpendicular to Roof Framing
Fasteners: 8d Common Nails per schedule on sheet A.1

SHEAR WALLS
Header: 1/2" CD Plywood or 1 1/2" O.S.B.
Sheet Size: 48" x 96" Sheets Placed Vertical
Fasteners: 8d Common Nails # 4" O.C. Edges # 8" O.C. Interior
Diaphragm: Double Top Flange (S.P.F.) Lined Nails # 12" O.C.
Wall Studs: 2x4 Studs # 16" O.C.

HURRICANE UPLIFT CONNECTORS
Trim Anchors: SIMPSON 42 SB or SDUC16400 # EA. Trim Bolt (Fig. U.O.J.) Uplift Tension: 8d Shearlag Nailing in Adequate # 8d # 4" O.C. Top # Bolt Anchor Bolts: 1/2" A307 Bolts # 48" O.C. - 1st Bolt # 6" from corner
Corner Hold-down Device: (1) UCLAS # each corner
Porch Column Base Connector: Simpson AB46 # each column
Porch Column to Beam Connector: Simpson EPCLAS/PCCLAS # each column

FOOTINGS AND FOUNDATIONS
Footings: 18" x 18" Cont. w/ 3- #5 Bar. Cont. on wireplastic chairs 48" O.C.

STRUCTURAL DESIGN CRITERIA:

1. THE DESIGN COMPLIES WITH THE REQUIREMENTS OF THE 2017 FLORIDA BUILDING CODE SECTION 605 AND OTHER RELEVANT CODES AND SPECIFICATIONS. ALL CODES AND SPECIFICATIONS SHALL BE LATEST EDITION AT THE OF PERMIT.
2. WIND LOAD CRITERIA: RISK CATEGORY: 2, EXPOSURE: "B"
BASED ON ANEMOGRAPHY: 301 FPM WIND VELOCITY, V₁₀ 101 MPH
V₆₀ 101 MPH
3. ROOF DESIGN LOADS:
SUPERIMPOSED DEAD LOADS: 20 PSF
SUPERIMPOSED LIVE LOADS: 20 PSF
4. FLOOR DESIGN LOADS:
SUPERIMPOSED DEAD LOADS: 20 PSF
SUPERIMPOSED LIVE LOADS: 40 PSF
RESIDENTIAL: 40 PSF
BALCONIES: 40 PSF
5. WIND NET UPLIFT: ARE AS INDICATED ON PLANS

TERMITE PROTECTION NOTES:

1. SOIL CHEMICAL BARRIER METHOD:
A. A PERMANENT SIGN WHICH IDENTIFIES THE TERMITE TREATMENT PROVIDER AND NEED FOR REINJECTION AND TREATMENT CONTRACT RENEWAL SHALL BE PROVIDED. THE SIGN SHALL BE POSTED NEAR THE WATER HEATER OR ELECTRIC PANEL. FBC 903.4.4
2. CONDENSATE AND RICE DISCHARGES SHALL DISCHARGE AT LEAST 1'-0" AWAY FROM BUILDING SIDE WALLS. FBC 903.4.4
3. IRRIGATION/SPRINKLER SYSTEMS INCLUDING ALL RIRERS AND SPRAY HEADS SHALL NOT BE INSTALLED WITHIN 1'-0" FROM BUILDING SIDE WALLS. FBC 903.4.4
4. TO PROVIDE FOR INSPECTION FOR TERMITE INFESTATION, BETWEEN WALL COVERINGS AND FINAL EARTH GRADE SHALL NOT BE LESS THAN 6". EXCEPTION: PAINT AND DECORATIVE CEMENTOUS FINISH LESS THAN 5/8" THICK ADHERED DIRECTLY TO THE FOUNDATION WALL. FBC 1403.18
5. INITIAL TREATMENT SHALL BE DONE AFTER ALL EXCAVATION AND BACKFILL IS COMPLETE. FBC 904.1.1
6. SOIL DISTURBED AFTER THE INITIAL TREATMENT SHALL BE RETREATED INCLUDING SPACES BOXED OR FORMED. FBC 186.1.2
7. BOXED AREAS IN CONCRETE FLOOR FOR SUBSEQUENT INSTALLATION OF TRAPS, ETC., SHALL BE MADE WITH PERMANENT METAL OR PLASTIC FORMS. PERMANENT FORMS MUST BE OF A SIZE AND DEPTH THAT WILL ELIMINATE THE DISTURBANCE OF SOIL AFTER THE INITIAL TREATMENT. FBC 186.1.3
8. MINENT & HL VAPOR RETARDER MUST BE INSTALLED TO PROTECT AGAINST RAINFALL DILUTION. IF RAINFALL OCCURS BEFORE VAPOR RETARDER PLACEMENT, RETREATMENT IS REQUIRED. FBC 904.1.4
9. CONCRETE OVERPOUR AND MORTAR ALONG THE FOUNDATION PERIMETER MUST BE RECEIVED BEFORE EXTERIOR SOIL TREATMENT. FBC 186.1.9
10. SOIL TREATMENT MUST BE APPLIED UNDER ALL EXTERIOR CONCRETE OR GRADE WITHIN 1'-0" OF THE STRUCTURE SIDEWALLS. FBC 186.1.6
11. AN EXTERIOR VERTICAL CHEMICAL BARRIER MUST BE INSTALLED AFTER CONSTRUCTION IS COMPLETE INCLUDING LANDSCAPING AND IRRIGATION. ANY SOIL DISTURBED AFTER THE VERTICAL BARRIER IS APPLIED, SHALL BE RETREATED. FBC 186.1.6
12. ALL BUILDINGS ARE REQUIRED TO HAVE FIRE-CONSTRUCTION TREATMENT. FBC 186.1.1
13. A CERTIFICATE OF COMPLIANCE MUST BE ISSUED TO THE BUILDING DEPARTMENT BY A LICENSED PEST CONTROL COMPANY BEFORE A CERTIFICATE OF OCCUPANCY WILL BE ISSUED. THE CERTIFICATE OF COMPLIANCE SHALL STATE "THE BUILDING HAS RECEIVED A COMPLETE TREATMENT FOR THE PREVENTION OF SUBTERNEAN INFESTATION BY TERMITES AND/OR COLLEMBOLA WITH THE RULES AND LAWS OF THE FLORIDA DEPARTMENT OF AGRICULTURE AND CONSUMER SERVICES". TERMITES SERVICES".
14. AFTER ALL WORK IS COMPLETED, LOOSE WOOD AND FILL MUST BE REMOVED FROM BELOW AND WITHIN 1'-0" OF THE BUILDING. THIS INCLUDES ALL GRADE STAKES, TUB TRAP BOXES, FORMS, SHORING OR OTHER CELLULOSE CONTAINING MATERIAL. FBC 2303.13
15. NO WOOD, VEGETATION, STUMPS, CARDBOARD, TRASH, ETC., SHALL BE BURIED WITHIN 10'-0" OF ANY BUILDING OR PROPOSED BUILDING. FBC 2303.14

REVISIONS


NO.	DATE	DESCRIPTION
1	10/26/2020	

THE 1680 MODEL
LOT 20, CANNON CREEK, LAKE CITY, FLORIDA 32024
ADAM'S CONSTRUCTION
LAKE CITY, FLORIDA

NS
NICHOLAS
GESLER
ARCHITECT
1100 N. 1st Street, Suite 100
Lake City, FL 32025
Tel: 407-999-0001
Fax: 407-999-0001


SHEET NUMBER
S.3
OF 4 SHEETS



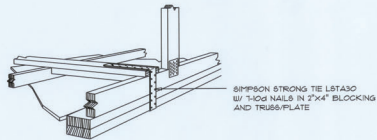

GABLE END GYPSUM DIAPHRAGM HOLDDOWN CONNECTOR
SCALE: NONE

A.1

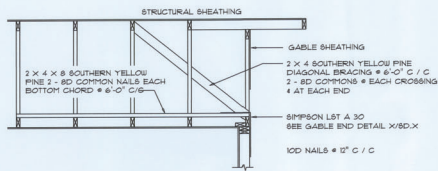


END WALL BRACING FOR CEILING DIAPHRAGM

NTS (ALTERNATIVE TO BALLOON FRAMING)
NOTE: ALL WOOD TO BE NUMBER 2 GRADE SOUTHERN YELLOW PINE


A

ROOF SHEATHING FASTENINGS			
NAILING ZONE	SHEATHING TYPE	FASTENER	SPACING
1	1/2\"	1/2\"	6\"
2	1/2\"	1/2\"	6\"
3	1/2\"	1/2\"	6\"

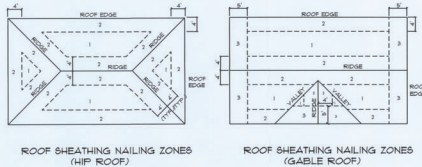


Roof Nail Pattern DET.
SCALE: NONE

B

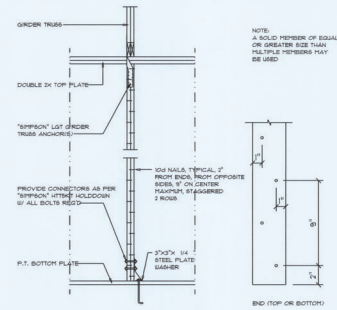

Girder Truss Column DET.
SCALE: 1/2\" = 1'-0\"

C

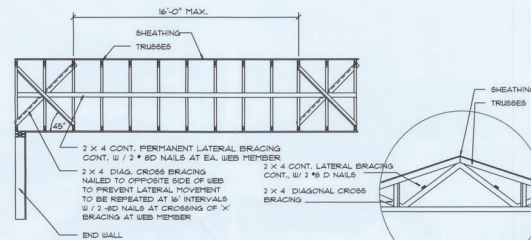

TYP. PERMANENT TRUSS BRACING DIA.
NTS
NOTE: ALL WOOD TO BE NUMBER 2 GRADE SOUTHERN YELLOW PINE

D


Truss Bracing DETAILS
SCALE: AS NOTED

- SHEARWALL NOTES:**
- ALL SHEARWALLS SHALL BE TYPE 1 SHEARWALLS
 - THE WALL SHALL BE ENTIRELY SHEATHED WITH 1/2\"
 - ALL SHEATHING SHALL BE ATTACHED TO FRAMING ALONG ALL FOUR EDGES WITH JOINTS FOR ADJACENT PANELS OCCURRING OVER COMMON FRAMING MEMBERS OR ALONG BLOCKING.
 - NAIL BRACING SHALL BE 6\"
 - TYPE 2 SHEARWALLS ARE DESIGNED FOR THE OPENING IT CONTAINS. FRAMING HEIGHT OF OPENING SHALL BE 8\"

OPENING WIDTH	BILL PLATES	6x6 TOE NAILS EACH END
UP TO 4'-0"	(3) 3x4 OR (3) 3x4	2
4'-0" TO 8'-0"	(3) 3x4 OR (3) 3x4	2
8'-0" TO 12'-0"	(3) 3x4 OR (3) 3x4	3


Shear Wall DETAILS
SCALE: NONE

E

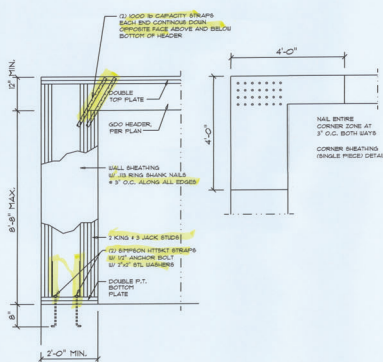

Garage End Wall DETAILS
SCALE: 1/2\" = 1'-0\"

G

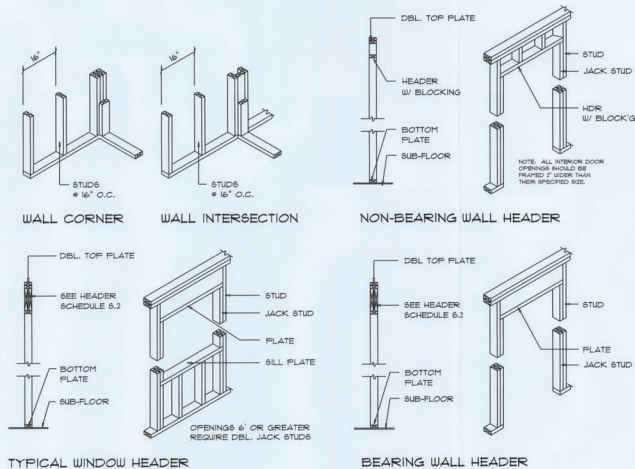

Wall Framing/Header DETAILS
SCALE: NONE

F

REVISIONS
Mar. 24th, 2020

THE 1680 MODEL
LOT 20, CANNON CREEK, LAKE CITY, FLORIDA 32024
ADAM'S CONSTRUCTION
LAKE CITY, FLORIDA

NICHOLAS GEISLER ARCHITECT
1700 N. Brown Blvd.
Lake City, FL 32096
(813) 681-1800

SHEET NUMBER
S.4
OF 4 SHEETS

