



Mobile Home Permit Worksheet

Installer: Ben Stone License # IH/1151868



Address of home being installed 1346 SW Jafus Ave Lake City FL 32024

Manufacturer Live Oak Length x width 16x66/70


NOTE: If home is a single wide fill out one half of the blocking plan
If home is a triple or quad wide sketch in remainder of home
I understand Lateral Arm Systems cannot be used on any home (new or used)
where the sidewall ties exceed 5 ft 4 in.

Installer's initials BCS

Typical pier spacing

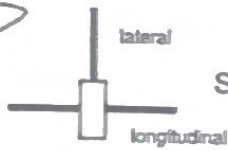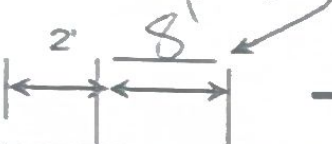

Show locations of Longitudinal and Lateral Systems
(use dark lines to show these locations)

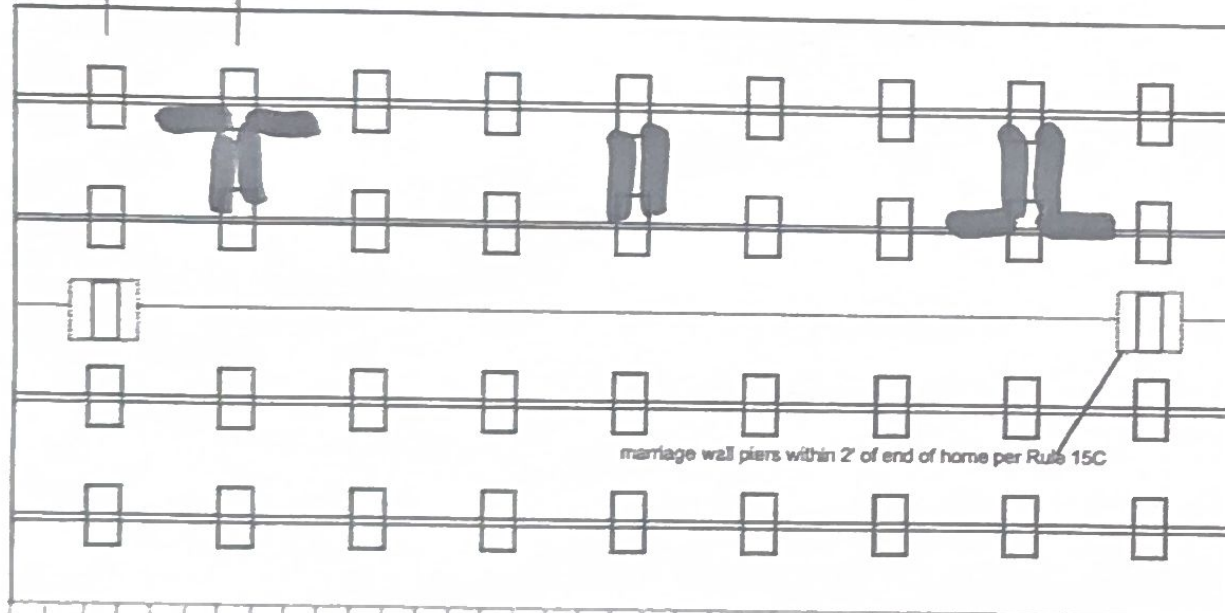

Permit Number: _____ Date: _____

New Home ☒ Used Home ☐

Home installed to the Manufacturer's Installation Manual
Home is installed in accordance with Rule 15-C ☐

Single wide ☒ Wind Zone II ☒ Wind Zone III ☐

Double wide ☐ Installation Decal # 122814

Triple/Quad ☐ Serial # LOHGA10025524

PIER SPACING TABLE FOR USED HOMES

Load bearing capacity	Footer size (sq in)	16" x 16" (256)	18 1/2" x 18 1/2" (342)	20" x 20" (400)	22" x 22" (484)*	24" x 24" (576)*	26" x 26" (676)
1000 psf		3'	4'	5'	6'	7'	8'
1500 psf		4'6"	6'	7'	8'	8'	8'
2000 psf		6'	8'	8'	8'	8'	8'
2500 psf		7'6"	8'	8'	8'	8'	8'
3000 psf		8'	8'	8'	8'	8'	8'
3500 psf		8'	8'	8'	8'	8'	8'

*interpolated from Rule 15C-1 pier spacing table.

PIER PAD SIZES

I-beam pier pad size 17x25

Perimeter pier pad size 16x16

Other pier pad sizes
(required by the mfg.) _____

Draw the approximate locations of marriage wall openings 4 foot or greater. Use this symbol to show the piers.

List all marriage wall openings greater than 4 foot and their pier pad sizes below.

Opening _____ Pier pad size _____

TIEDOWN COMPONENTS

Longitudinal Stabilizing Device (LSD)

Manufacturer Oliver

Longitudinal Stabilizing Device w/ Lateral Arms

Manufacturer Oliver

POPULAR PAD SIZES

Pad Size	Sq In
16 x 16	256
16 x 18	288
18.5 x 18.5	342
16 x 22.5	360
17 x 22	374
13 1/4 x 26 1/4	348
20 x 20	400
17 3/16 x 25 3/16	441
17 1/2 x 25 1/2	448
24 x 24	576
26 x 26	676

4 ft X 5 ft

ANCHORS

FRAME TIES

within 2' of end of home
spaced at 5' 4" oc ☒

OTHER TIES

Sidewall _____ Number 28
Longitudinal _____ 4
Marriage Wall _____
Shear Wall _____



Mobile Home Permit Worksheet

POCKET PENETROMETER TEST

The pocket penetrometer tests are rounded down to 2000 psf or check here to declare 1000 lb. soil _____ without testing.

x 2000

x 2000

x 2000

POCKET PENETROMETER TESTING METHOD

1. Test the perimeter of the home at 6 locations.
2. Take the reading at the depth of the footer.
3. Using 500 lb. increments, take the lowest reading and round down to that increment.

x 2000

x 2000

x 2000

TORQUE PROBE TEST

The results of the torque probe test is 2.85 Inch pounds or check here if you are declaring 5' anchors without testing _____. A test showing 275 inch pounds or less will require 5' anchors.

Note: A state approved lateral arm system is being used and 4 ft. anchors are allowed at the sidewall locations. I understand 5' anchors are required at all centerline tie points where the torque test reading is 275 or less and where the mobile home manufacturer may require anchors with 4000 lb. holding capacity.

Installer's initials BCS

ALL TESTS MUST BE PERFORMED BY A LICENSED INSTALLER

Installer Name Ben Stone

Date Tested 9/22/26

ELECTRICAL

Connect electrical conductors between multi-wide units, but not to the main power source. This includes the bonding wire between multi-wide units. Pg. _____

PLUMBING

Connect all sewer drains to an existing sewer tap or septic tank. Pg. 1-70

Connect all potable water supply piping to an existing water meter, water tap, or other independent water supply systems. Pg. 1-69

Permit Number: _____

Date: _____

Site Preparation

Debris and organic material removed ☒

Water drainage: Natural _____ Swale _____ Pad ☒ Other _____

Fastening multi wide units

Floor- Type Fastener: Lag Length: 6" Spacing: 20" staggered

Walls- Type Fastener: #10 screw Length: 4.5" Spacing: 20"

Roof- Type Fastener: Lag Length: 6" Spacing: 20"

For used homes a min. 30 gauge, 8" wide, galvanized metal strip will be centered over the peak of the roof and fastened with galv. roofing nails at 2" on center on both sides of the centerline.

Gasket (weatherproofing requirement)

I understand a properly installed gasket is a requirement of all new and used homes and that condensation, mold, mildew and buckled marriage walls are a result of a poorly installed or no gasket being installed. I understand a strip of tape will not serve as a gasket.

Installer's initials BCS

Type gasket Factory

Pg. 1-36

Installed:

Between Floors _____ Yes ☒

Between Walls _____ Yes ☒

Bottom of ridge beam _____ Yes ☒

Weatherproofing

The bottom board will be repaired and/or taped. _____ Yes ☒ Pg. 1-37

Siding on units is installed to manufacturer's specifications. _____ Yes ☒

Fireplace chimney installed so as not to allow intrusion of rain water. _____ Yes _____

Miscellaneous

Skirting to be installed. _____ Yes ☒ No _____ N/A _____

Dryer vent installed outside of skirting. _____ Yes ☒ No _____ N/A _____

Range downflow vent installed outside of skirting. _____ Yes _____ No ☒ N/A ☒

Drain lines supported at 4' intervals. _____ Yes ☒ No _____ N/A _____

Electrical crossovers protected. _____ Yes _____ No ☒ N/A ☒

Other: _____

Installer verifies all information given with this permit worksheet is accurate and true based on the manufacturer's installation instructions and or Rule 15C-1 & 2

Installer's Signature B Stone

Date 9/22/26