

# Cool and Cobb Engineering Company

---

---

Date: 1/15/2026

Project: 25-1392

Job: Samuel Martinezl

Location: 1845 SW Haltiwanger Rd., Lake City, FL 32024

Re: Final "As Built" Certification

Permit Number: # 54448

As of this date I have inspected the site records and approve the Installation on the above noted project. Cool and Cobb has not visited the site. The licensed foundation contractor has provided design compliance records including installation logs and digital visual records of the complete installation. I hereby approve the installation as being in accordance with the Florida Building Code 2023 8th Edition, and with the design completed and certified by Cool and Cobb Engineering Company for this project. This certification does not address any possible sinkhole activity as defined in Florida Statute § 627.706.

Sincerely,

1/15/2026

Kenneth F. Wheeler, P.E.  
State of Florida  
Professional Engineer No. 60417

This item has been digitally signed and sealed by Kenneth F. Wheeler, P.E. on the date adjacent to the seal.

Printed copies of this document are not considered signed and sealed and the signature must be verified on any electronic copies.

203 W. Main St.  
Avon Park, FL 33825  
Office: (863) 657-2323  
Fax: (863) 657-2324  
Email: Ken@coolandcobb.com

Contractor: **Solid Foundations**

# Pier Identification & Location Plan

SCALE: 1" = 10'


**As-Built**

This item has been digitally signed and sealed by Kenneth F. Wheeler, P.E. on the date adjacent to the seal.

Printed copies of this document are not considered signed and sealed and the signature must be verified on any electronic copies.


I certify that all work was completed in accordance with the design.

*Andi McElmore 10/17/2025*

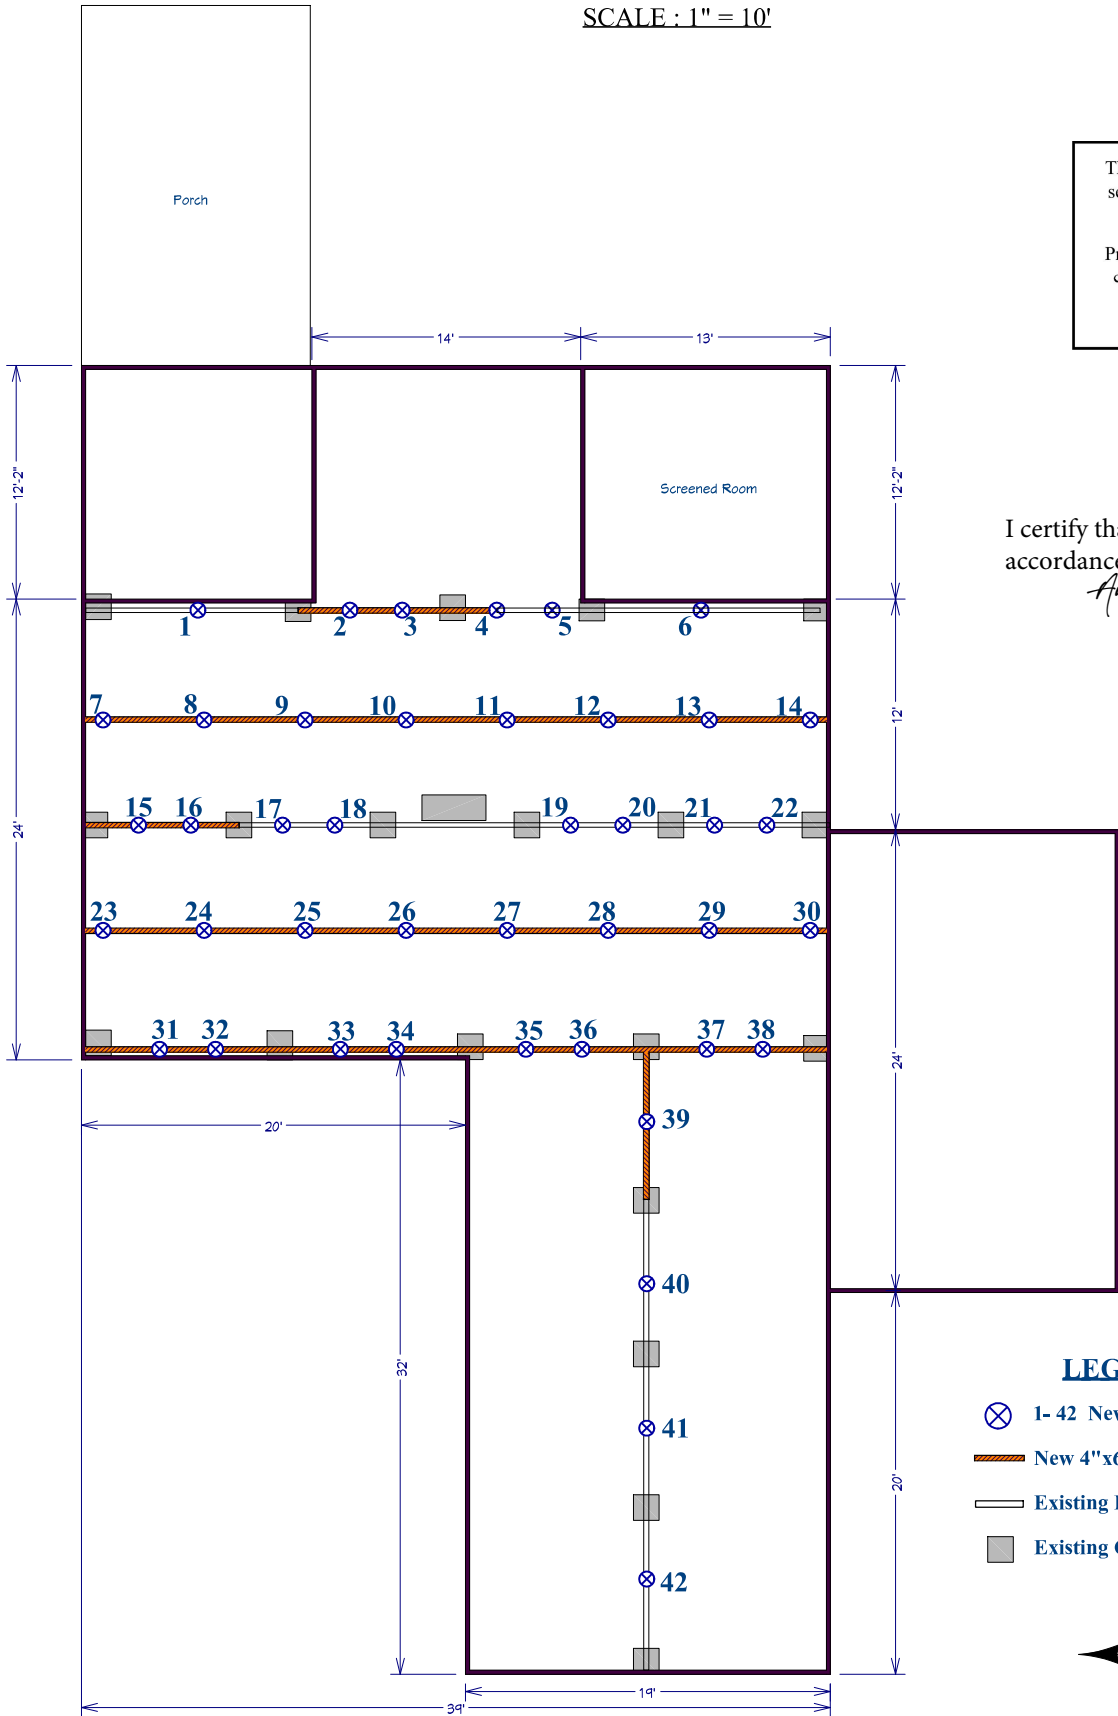

**LEGEND**

- ⊗ 1- 42 New Crawl Space Jacks
- New 4"x6" PT WD Beam
- Existing Beam
- Existing Conc Pier

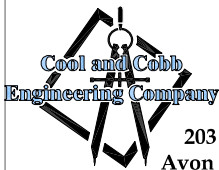

203 West Main St.  
Avon Park, FL 33825

Kenneth F. Wheeler, P.E.  
FL License No. 60417  
(863) 657-2323 Office  
ken@coolandcobb.com

Seal:

1/15/2026

Project:

Samuel Martinez  
1845 SW Haltiwanger Rd.,  
Lake City, FL 32024

Project #:

25-1392