



# Mobile Home Permit Worksheet

Installer: DALES MOBILE HOME SET UP License # EH/1133271



Address of home being installed \_\_\_\_\_

Manufacturer \_\_\_\_\_ Length x width \_\_\_\_\_

**NOTE:** If home is a single wide fill out one half of the blocking plan  
If home is a triple or quad wide sketch in remainder of home  
I understand Lateral Arm Systems cannot be used on any home (new or used)  
where the sidewall ties exceed 5 ft 4 in.

Installer's initials SD

Typical pier spacing

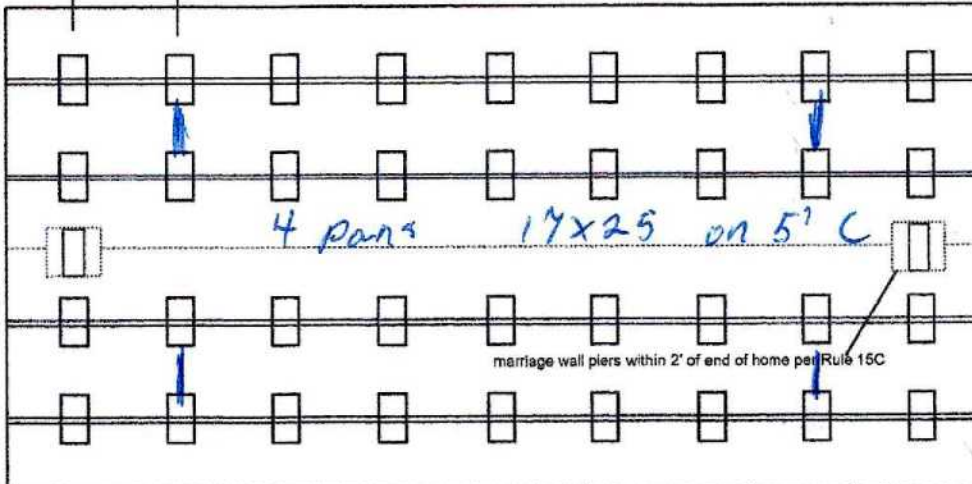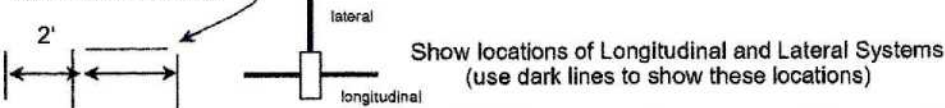

Permit Number: \_\_\_\_\_ Date: \_\_\_\_\_

New Home ☐ Used Home ☒

Home installed to the Manufacturer's Installation Manual  
Home is installed in accordance with Rule 15-C

Single wide ☐ Wind Zone II ☐ Wind Zone III ☐

Double wide ☐ Installation Decal # 127532

Triple/Quad ☐ Serial # \_\_\_\_\_

## PIER SPACING TABLE FOR USED HOMES

| Load bearing capacity | Footer size (sq in) | 16" x 16" (256) | 18 1/2" x 18 1/2" (342) | 20" x 20" (400) | 22" x 22" (484)* | 24" X 24" (576)* | 26" x 26" (676) |
|-----------------------|---------------------|-----------------|-------------------------|-----------------|------------------|------------------|-----------------|
| 1000 psf              |                     | 3'              | 4'                      | 5'              | 6'               | 7'               | 8'              |
| 1500 psf              |                     | 4'6"            | 6'                      | 7'              | 8'               | 8'               | 8'              |
| 2000 psf              |                     | 6'              | 8'                      | 8'              | 8'               | 8'               | 8'              |
| 2500 psf              |                     | 7'6"            | 8'                      | 8'              | 8'               | 8'               | 8'              |
| 3000 psf              |                     | 8'              | 8'                      | 8'              | 8'               | 8'               | 8'              |
| 3500 psf              |                     | 8'              | 8'                      | 8'              | 8'               | 8'               | 8'              |

\*interpolated from Rule 15C-1 pier spacing table.

## PIER PAD SIZES

I-beam pier pad size 17x25

Perimeter pier pad size 16x16

Other pier pad sizes \_\_\_\_\_  
(required by the mfg.)

 Draw the approximate locations of marriage wall openings 4 foot or greater. Use this symbol to show the piers.

List all marriage wall openings greater than 4 foot and their pier pad sizes below.

Opening \_\_\_\_\_ Pier pad size \_\_\_\_\_

\_\_\_\_\_ 17x25

\_\_\_\_\_

## TIEDOWN COMPONENTS

Longitudinal Stabilizing Device (LSD)

Manufacturer \_\_\_\_\_

Longitudinal Stabilizing Device w/ Lateral Arms

Manufacturer \_\_\_\_\_

## POPULAR PAD SIZES

| Pad Size          | Sq In |
|-------------------|-------|
| 16 x 16           | 256   |
| 16 x 18           | 288   |
| 18.5 x 18.5       | 342   |
| 16 x 22.5         | 360   |
| 17 x 22           | 374   |
| 13 1/4 x 26 1/4   | 348   |
| 20 x 20           | 400   |
| 17 3/16 x 25 3/16 | 441   |
| 17 1/2 x 25 1/2   | 446   |
| 24 x 24           | 576   |
| 26 x 26           | 676   |

4 ft ☒ 5 ft ☒

## ANCHORS

## FRAME TIES

within 2' of end of home  
spaced at 5' 4" oc \_\_\_\_\_

## OTHER TIES

|               |          |
|---------------|----------|
|               | Number   |
| Sidewall      | <u>2</u> |
| Longitudinal  | <u>4</u> |
| Marriage Wall | <u>2</u> |
| Shear Wall    | <u>3</u> |



## Mobile Home Permit Worksheet

### POCKET PENETROMETER TEST

The pocket penetrometer tests are rounded down to \_\_\_\_\_ psf or check here to declare 1000 lb. soil ☒ without testing.

X \_\_\_\_\_ X \_\_\_\_\_ X \_\_\_\_\_

### POCKET PENETROMETER TESTING METHOD

1. Test the perimeter of the home at 6 locations.
2. Take the reading at the depth of the footer.
3. Using 500 lb. increments, take the lowest reading and round down to that increment.

X \_\_\_\_\_ X \_\_\_\_\_ X \_\_\_\_\_

### TORQUE PROBE TEST

The results of the torque probe test is 285 inch pounds or check here if you are declaring 5' anchors without testing \_\_\_\_\_. A test showing 275 inch pounds or less will require 5' anchors.

**Note:** A state approved lateral arm system is being used and 4 ft. anchors are allowed at the sidewall locations. I understand 5' anchors are required at all centerline tie points where the torque test reading is 275 or less and where the mobile home manufacturer may require anchors with 4000 lb. holding capacity.

Installer's initials DH

### ALL TESTS MUST BE PERFORMED BY A LICENSED INSTALLER

Installer Name Dale Houston

Date Tested 7/22/26

### ELECTRICAL

Connect electrical conductors between multi-wide units, but not to the main power source. This includes the bonding wire between multi-wide units. Pg. \_\_\_\_\_

### PLUMBING

Connect all sewer drains to an existing sewer tap or septic tank. Pg. \_\_\_\_\_

Connect all potable water supply piping to an existing water meter, water tap, or other independent water supply systems. Pg. \_\_\_\_\_

Permit Number: \_\_\_\_\_

Date: \_\_\_\_\_

### Site Preparation

Debris and organic material removed \_\_\_\_\_

Water drainage: Natural \_\_\_\_\_ Swale \_\_\_\_\_ Pad ☒ Other \_\_\_\_\_

### Fastening multi wide units

Floor- Type Fastener: Large Length: 6" Spacing: 18"

Walls- Type Fastener: 11 Length: 11 Spacing: 11

Roof- Type Fastener: 11 Length: 11 Spacing: 11

For used homes a min. 30 gauge, 8" wide, galvanized metal strip will be centered over the peak of the roof and fastened with galv. roofing nails at 2" on center on both sides of the centerline.

### Gasket (weatherproofing requirement)

I understand a properly installed gasket is a requirement of all new and used homes and that condensation, mold, mildew and buckled marriage walls are a result of a poorly installed or no gasket being installed. I understand a strip of tape will not serve as a gasket.

Installer's initials DH

Type gasket Foam  
Pg. \_\_\_\_\_

Installed:

Between Floors-----Yes 1

Between Walls-----Yes 1

Bottom of ridge beam---Yes 1

### Weatherproofing

The bottom board will be repaired and/or taped.-----Yes \_\_\_\_\_ Pg. \_\_\_\_\_  
Siding on units is installed to manufacturer's specifications.-----Yes \_\_\_\_\_  
Fireplace chimney installed so as not to allow intrusion of rain water.---Yes \_\_\_\_\_

### Miscellaneous

Skirting to be installed.-----Yes \_\_\_\_\_ No \_\_\_\_\_ N/A \_\_\_\_\_

Dryer vent installed outside of skirting.-----Yes \_\_\_\_\_ No \_\_\_\_\_ N/A \_\_\_\_\_

Range downflow vent installed outside of skirting.-----Yes \_\_\_\_\_ No \_\_\_\_\_ N/A \_\_\_\_\_

Drain lines supported at 4' intervals.-----Yes \_\_\_\_\_ No \_\_\_\_\_ N/A \_\_\_\_\_

Electrical crossovers protected.-----Yes \_\_\_\_\_ No \_\_\_\_\_ N/A \_\_\_\_\_

Other: \_\_\_\_\_

Installer verifies all information given with this permit worksheet is accurate and true based on the manufacturer's installation instructions and or Rule 15C-1 & 2

Installer's Signature Dale Houston

Date \_\_\_\_\_

Published 10/2025

17x25

|                                                     |                 |                                                                      |
|-----------------------------------------------------|-----------------|----------------------------------------------------------------------|
| License Number: IH / 1133271 / 1 Name: DALE HOUSTON |                 |                                                                      |
| Order #: 6928                                       | Label #: 127532 | Manufacturer:                                                        |
| Homeowner: <b>MATT HOUSTON</b>                      |                 | Year Model:                                                          |
| Address:                                            |                 | Length & Width:                                                      |
| City/State/Zip:                                     |                 | Type Longitudinal System:                                            |
| Phone #:                                            |                 | Type Lateral Arm System:                                             |
| Date Installed:                                     |                 | New Home: _____ Used Home: _____                                     |
| Installed Wind Zone:                                |                 | Data Plate Wind Zone:                                                |
|                                                     |                 | (Check Size of Home)<br>Single _____<br>Double _____<br>Triple _____ |
|                                                     |                 | HUD Label #:                                                         |
|                                                     |                 | Soil Bearing / PSF:                                                  |
|                                                     |                 | Torque Probe / in-lbs:                                               |
|                                                     |                 | Permit #:                                                            |
| Note:                                               |                 |                                                                      |

**STATE OF FLORIDA  
INSTALLATION CERTIFICATION LABEL**

127532

LABEL #

DATE OF INSTALLATION

DALE HOUSTON

NAME

IH / 1133271 / 1

6928

LICENSE #

ORDER #

CERTIFIES THAT THE INSTALLATION OF THIS MOBILE HOME IS  
IN ACCORDANCE WITH FLORIDA STATUTES 320.8249, 320.8325  
AND RULES OF THE HIGHWAY SAFETY AND MOTOR VEHICLES.

**INSTRUCTIONS**

PLEASE WRITE DATE OF  
INSTALLATION AND AFFIX  
LABEL NEXT TO HUD LABEL.  
USE PERMANENT INK PEN  
OR MARKER ONLY.  
COMPLETE INFORMATION  
ABOVE AND KEEP ON FILE  
FOR A MINIMUM OF 2 YEARS.  
YOU ARE REQUIRED TO  
PROVIDE COPIES WHEN  
REQUESTED.

