




Mobile Home Permit Worksheet

Installer: William Price License # TH-1041936
 Address of home being installed: 408 SW Woodgate Ter.
Lake City FL 32024
 Manufacturer: LOH Length x width: 16 x 76



NOTE: If home is a single wide fill out one half of the blocking plan
 If home is a triple or quad wide sketch in remainder of home
 I understand Lateral Arm Systems cannot be used on any home (new or used)
 where the sidewall ties exceed 5 ft 4 in.

Installer's initials: WPR

Typical pier spacing

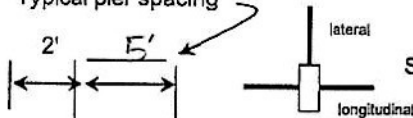

Show locations of Longitudinal and Lateral Systems
 (use dark lines to show these locations)

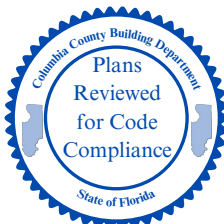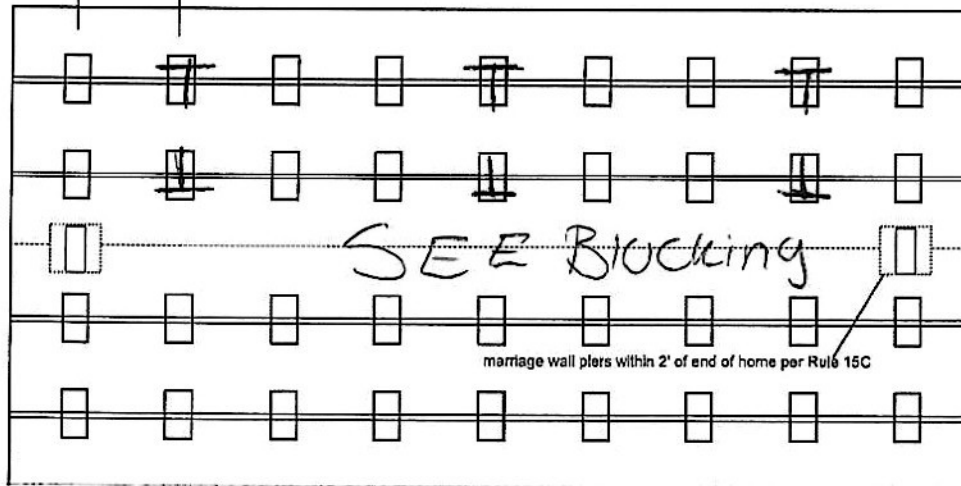

7 11 OK ✓

Permit Number: _____ Date: _____

New Home ☒ Used Home ☐

Home installed to the Manufacturer's Installation Manual
 Home is installed in accordance with Rule 15-C ☒

Single wide ☒ Wind Zone II ☒ Wind Zone III ☐

Double wide ☐ Installation Decal # 116414

Triple/Quad ☐ Serial # LOH G.A 30076156

PIER SPACING TABLE FOR USED HOMES

Load bearing capacity	Footer size (sq in)	16" x 16" (256)	18 1/2" x 18 1/2" (342)	20" x 20" (400)	22" x 22" (484)*	24" x 24" (576)*	26" x 26" (676)
1000 psf		3'	4'	5'	6'	7'	8'
1500 psf		4'6"	6'	7'	8'	8'	8'
2000 psf		6'	8'	8'	8'	8'	8'
2500 psf		7'6"	8'	8'	8'	8'	8'
3000 psf		8'	8'	8'	8'	8'	8'
3500 psf		8'	8'	8'	8'	8'	8'

*Interpolated from Rule 15C-1 pier spacing table.

PIER PAD SIZES

I-beam pier pad size 17 x 25

Perimeter pier pad size 16 x 16

Other pier pad sizes (required by the mfg.) _____

☐ Draw the approximate locations of marriage wall openings 4 foot or greater. Use this symbol to show the piers.

List all marriage wall openings greater than 4 foot and their pier pad sizes below.

Opening _____ Pier pad size _____

N/A

TIEDOWN COMPONENTS

Longitudinal Stabilizing Device (LSD)

Manufacturer: JOHN DEERE

Longitudinal Stabilizing Device w/ Lateral Arms

Manufacturer: JOHN DEERE

POPULAR PAD SIZES

Pad Size	Sq In
16 x 16	256
16 x 18	288
18.5 x 18.5	342
16 x 22.5	360
17 x 22	374
13 1/2 x 26 1/2	348
20 x 20	400
17 3/16 x 25 3/16	441
17 1/2 x 25 1/2	446
24 x 24	576
26 x 26	676

4 ft _____ 5 ft 6

ANCHORS

FRAME TIES


within 2' of end of home spaced at 5' 4" oc 16

OTHER TIES

Number _____
 Sidewall 12
 Longitudinal 4
 Marriage Wall 10
 Shear Wall 8

Chris Buse
408 SW Woodgate Ter.
Lake City, FL
32024

08-45-16-02810-150

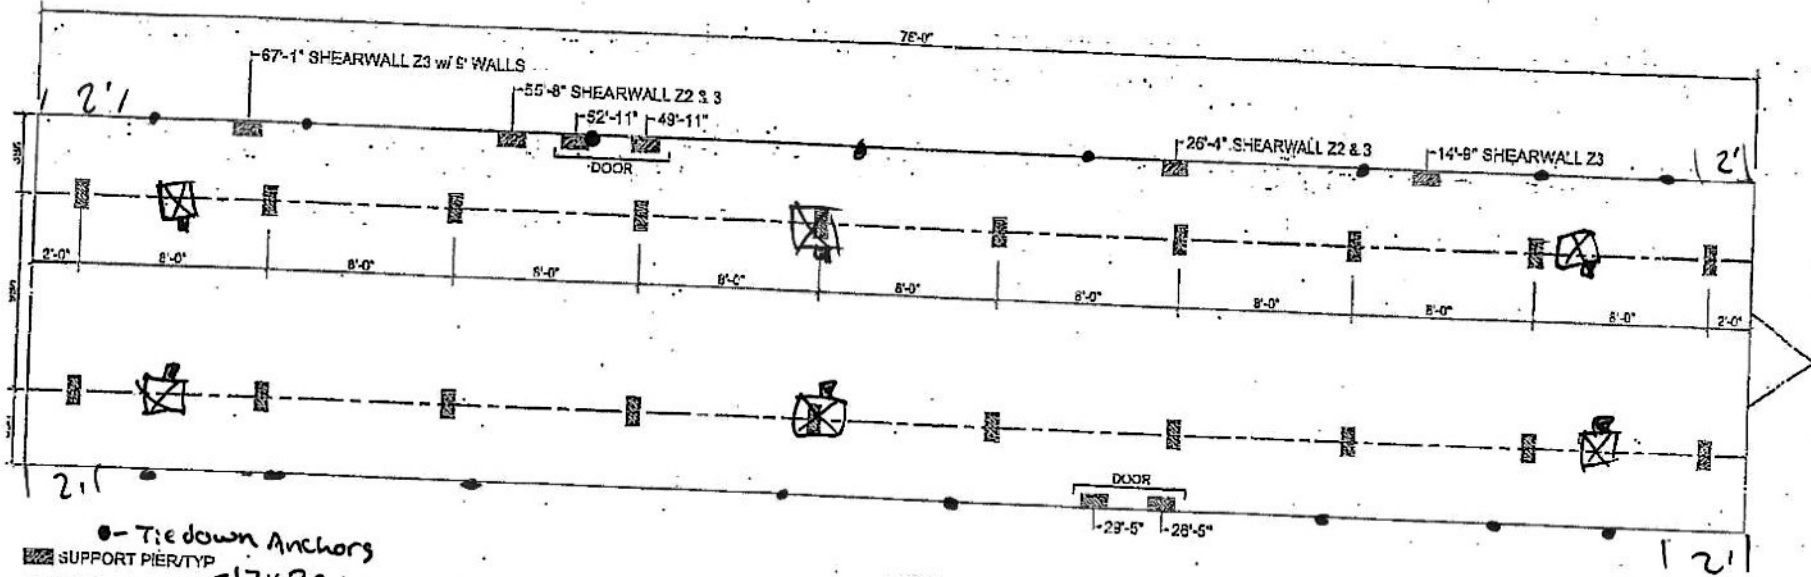

● - Tie down Anchors
 ■ - SUPPORT PIER/TYP
 FOUNDATION NOTES:
 - THIS DRAWING IS DESIGNED FOR THE STANDARD WIND ZONE AND IS TO BE USED IN CONJUNCTION WITH THE INSTALLATION MANUAL AND ITS SUPPLEMENTS.
 - FOOTINGS ARE SHOWN FOR EXAMPLE ONLY QUANTITY AND SPACING MAY VARY BASED ON PAD TYPE, SOIL CONDITION, ETC.
 - FOOTINGS ARE REQUIRED AT SUPPORT POSTS, SEE INSTALLATION MANUAL FOR REQUIREMENTS.
 - Oliver Tech * All Perimeter/doors 16x16
 Live Oak Homes
 MODEL: H-5763T-PS - 16 X 76 (BOX)
 3-BEDROOM / 2-BATH

H-5763T-PS



Mobile Home Permit Worksheet

POCKET PENETROMETER TEST

The pocket penetrometer tests are rounded down to _____ psf or check here to declare 1000 lb. soil X without testing.

x 1000

x 1000

x 1000

POCKET PENETROMETER TESTING METHOD

1. Test the perimeter of the home at 6 locations.
2. Take the reading at the depth of the footer.
3. Using 500 lb. increments, take the lowest reading and round down to that increment.

x 1000

x 1000

x 1000

TORQUE PROBE TEST

The results of the torque probe test is 0 inch pounds or check here if you are declaring 5' anchors without testing _____. A test showing 275 inch pounds or less will require 5' anchors.

Note: A state approved lateral arm system is being used and 4 ft. anchors are allowed at the sidewall locations. I understand 5' anchors are required at all centerline tie points where the torque test reading is 275 or less and where the mobile home manufacturer may require anchors with 4000 lb. holding capacity.

Installer's initials WLP

ALL TESTS MUST BE PERFORMED BY A LICENSED INSTALLER

Installer Name William R. Price

Date Tested 8/14/26

ELECTRICAL

Connect electrical conductors between multi-wide units, but not to the main power source. This includes the bonding wire between multi-wide units. Pg. ✓

PLUMBING

Connect all sewer drains to an existing sewer tap or septic tank. Pg. ✓

Connect all potable water supply piping to an existing water meter, water tap, or other independent water supply systems. Pg. ✓

Permit Number: _____

Date: _____

Site Preparation

Debris and organic material removed 90% Yes
Water drainage: Natural _____ Swale _____ Pad X Other _____

Fastening multi wide units

Floor- Type Fastener: _____ Length: _____ Spacing: _____
Walls- Type Fastener: _____ Length: _____ Spacing: _____
Roof- Type Fastener: _____ Length: _____ Spacing: _____
For used homes a min. 30 gauge, 8" wide, galvanized metal strip will be centered over the peak of the roof and fastened with galv. roofing nails at 2" on center on both sides of the centerline.

Gasket (weatherproofing requirement)

I understand a properly installed gasket is a requirement of all new and used homes and that condensation, mold, mildew and buckled marriage walls are a result of a poorly installed or no gasket being installed. I understand a strip of tape will not serve as a gasket.

Type gasket _____
Pg. _____

Installed: _____
Between Floors _____ Yes _____
Between Walls _____ Yes _____
Bottom of ridge beam _____ Yes _____

Installer's initials _____

Weatherproofing

The bottom board will be repaired and/or taped _____ Yes ✓ Pg. _____
Siding on units is installed to manufacturer's specifications _____ Yes ✓
Fireplace chimney installed so as not to allow intrusion of rain water _____ Yes ✓

Miscellaneous



Skirting to be installed _____ Yes ✓ No _____ N/A _____
Dryer vent installed outside of skirting _____ Yes ✓ No _____ N/A _____
Range downflow vent installed outside of skirting _____ Yes ✓ No _____ N/A _____
Drain lines supported at 4' intervals _____ Yes ✓ No _____ N/A _____
Electrical crossovers protected _____ Yes ✓ No _____ N/A _____
Other: _____

Installer verifies all information given with this permit worksheet is accurate and true based on the manufacturer's installation instructions and or Rule 15C-1 & 2

Installer's Signature William R. Price

Date 8/14/26

32024 08-45-16-02810-150

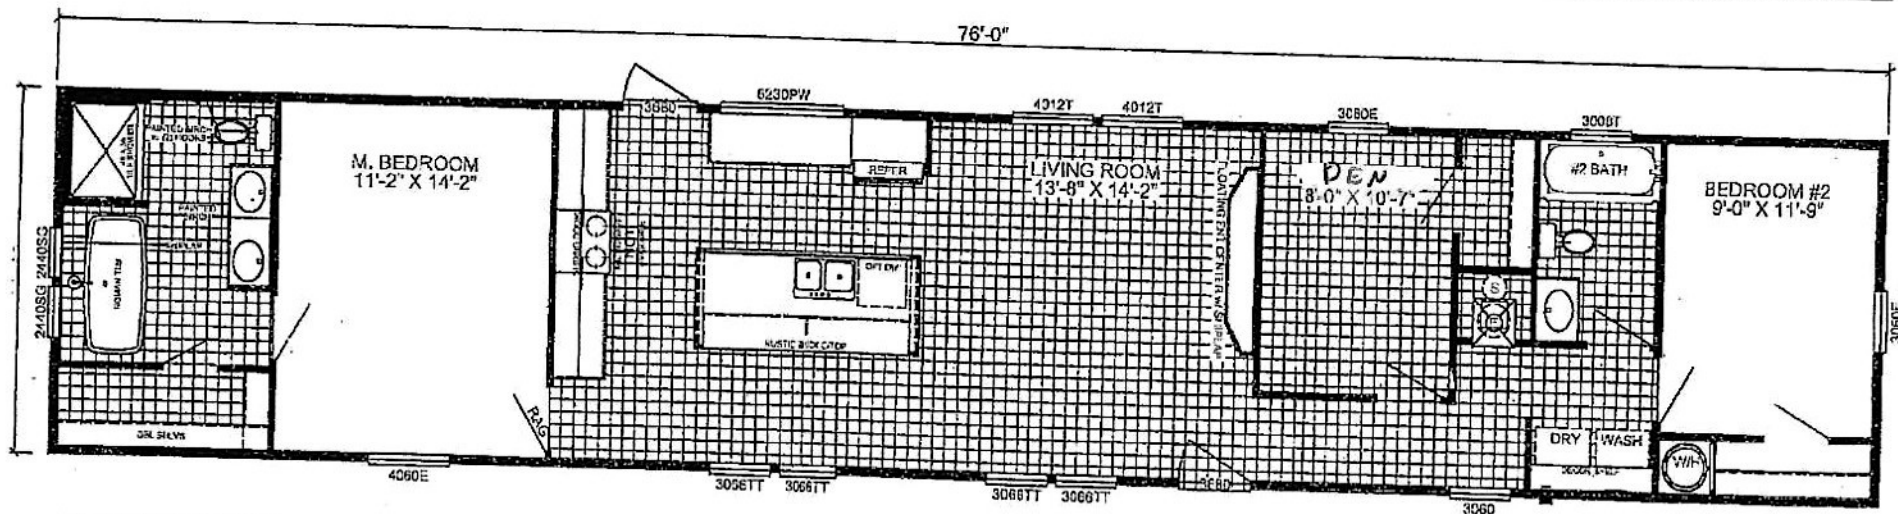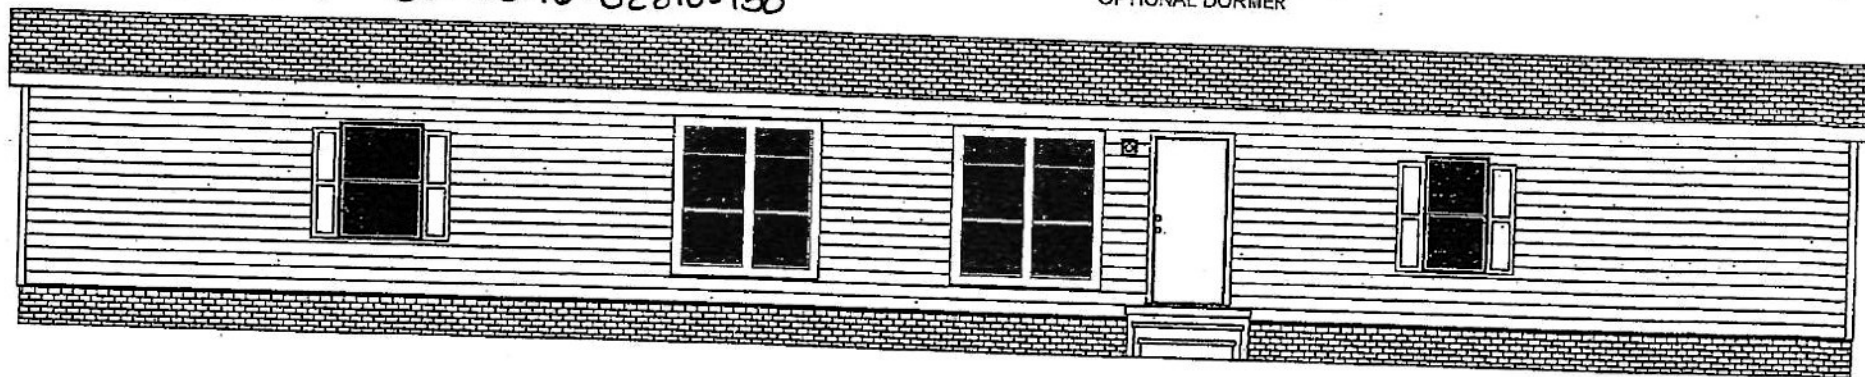

2-BEDROOM / 2-BATH w/ Den
16 X 80 - Approx. 1130 Sq. Ft.

- * All room dimensions include closets and square footage figures are approximate.
- * Transoms: windows are available on optional 9'-0" sidewall houses only.
- * Live Oak Homes reserves the right to modify product offering at any time.

ESCALADE