

17 X 25

License Number: IH / 1133271 / 1 Name: DALE HOUSTON		
Order #: 6928	Label #: 127515	Manufacturer: FIES
Homeowner: CLIFTON KARI	Year Model: 1981	(Check Size of Home) Single ☒ X
Address: 143 SE DANIE CT.	Length & Width: 66 X 14	Double ☐
City/State/Zip: LAKE CITY FL.	Type Longitudinal System:	Triple ☐
Phone #:	Type Lateral Arm System:	HUD Label #:
Date Installed:	New Home: ☐ Used Home: ☒ X	Soil Bearing / PSF:
Installed Wind Zone:	Data Plate Wind Zone:	Torque Probe / in-lbs:
Note: S# 1383		

**STATE OF FLORIDA
INSTALLATION CERTIFICATION LABEL**

127515

LABEL #

DATE OF INSTALLATION

DALE HOUSTON

NAME

IH / 1133271 / 1

6928

LICENSE #

ORDER #

CERTIFIES THAT THE INSTALLATION OF THIS MOBILE HOME IS
IN ACCORDANCE WITH FLORIDA STATUTES 320.8249, 320.8325
AND RULES OF THE HIGHWAY SAFETY AND MOTOR VEHICLES.

INSTRUCTIONS

PLEASE WRITE DATE OF
INSTALLATION AND AFFIX
LABEL NEXT TO HUD LABEL.
USE PERMANENT INK PEN
OR MARKER ONLY.
COMPLETE INFORMATION
ABOVE AND KEEP ON FILE
FOR A MINIMUM OF 2 YEARS.
YOU ARE REQUIRED TO
PROVIDE COPIES WHEN
REQUESTED.



Mobile Home Permit Worksheet



Installer: Dale Houston License # EH/1133271

Address of home being installed: 14353 DAVIS CT.
LAKE CITY FL.

Manufacturer: FIS Length x width: 66 X 14

NOTE: If home is a single wide fill out one half of the blocking plan
If home is a triple or quad wide sketch in remainder of home
I understand Lateral Arm Systems cannot be used on any home (new or used)
where the sidewall ties exceed 5 ft 4 in.

Installer's initials: OH

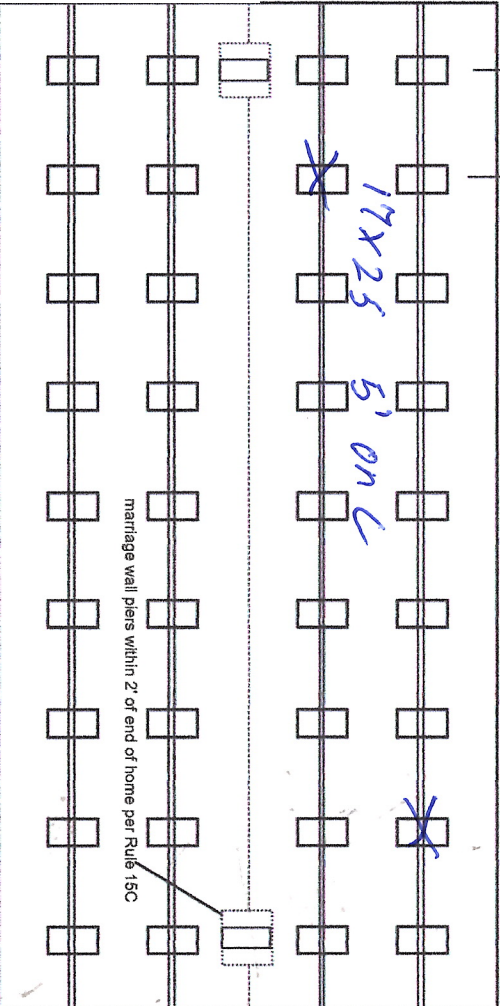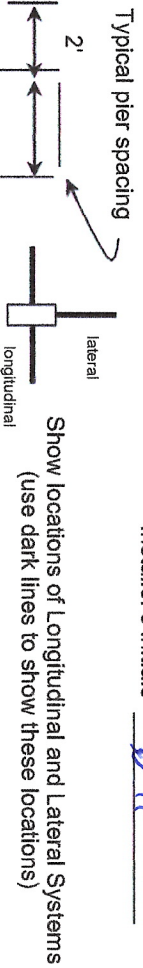

Permit Number: _____ Date: _____

New Home ☐ Used Home ☒

Home installed to the Manufacturer's Installation Manual
Home is installed in accordance with Rule 15-C

Single wide ☐ Wind Zone II ☒ Wind Zone III ☐

Double wide ☐ Installation Decal # 127515

Triple/Quad ☐ Serial # 1383

PIER SPACING TABLE FOR USED HOMES

Load bearing capacity	Footer size (sq in)	16" x 16" (256)	18 1/2" x 18 1/2" (342)	20" x 20" (400)	22" x 22" (484)*	24" x 24" (576)*	26" x 26" (676)
1000 psf	3"	4"	4"	5"	6"	7"	8"
1500 psf	4 1/2"	6"	6"	7"	8"	8"	8"
2000 psf	6"	8"	8"	8"	8"	8"	8"
2500 psf	7 1/2"	8"	8"	8"	8"	8"	8"
3000 psf	8"	8"	8"	8"	8"	8"	8"
3500 psf	8"	8"	8"	8"	8"	8"	8"

*Interpolated from Rule 15C-1 pier spacing table.

PIER PAD SIZES

I-beam pier pad size 17x25

Perimeter pier pad size 16x16

Other pier pad sizes (required by the mfg.) _____

Draw the approximate locations of marriage wall openings 4 foot or greater. Use this symbol to show the piers.

List all marriage wall openings greater than 4 foot and their pier pad sizes below.

Opening _____ Pier pad size _____

17x25

POPULAR PAD SIZES

Pad Size	Sq In
16 x 16	256
16 x 18	288
18.5 x 18.5	342
16 x 22.5	360
17 x 22	374
13 1/2 x 26 1/2	348
20 x 20	400
17 3/16 x 25 3/16	441
17 1/2 x 25 1/2	446
24 x 24	576
26 x 26	676

4 ft ☒ 5 ft ☒

ANCHORS

FRAME TIES

within 2' of end of home spaced at 5' 4" oc _____

TIEDOWN COMPONENTS

Longitudinal Stabilizing Device (LSD)

Manufacturer _____

Longitudinal Stabilizing Device w/ Lateral Arms

Manufacturer _____

OTHER TIES

Number _____

Sidewall

Longitudinal

Marriage Wall

Shear Wall



Mobile Home Permit Worksheet

POCKET PENETROMETER TEST

The pocket penetrometer tests are rounded down to _____ psf or check here to declare 1000 lb. soil ✓ without testing.

X _____ X _____ X _____

POCKET PENETROMETER TESTING METHOD

1. Test the perimeter of the home at 6 locations.
2. Take the reading at the depth of the footer.
3. Using 500 lb. increments, take the lowest reading and round down to that increment.

X _____ X _____ X _____

TORQUE PROBE TEST

The results of the torque probe test is 295 inch pounds or check here if you are declaring 5' anchors without testing _____. A test showing 275 inch pounds or less will require 5' anchors.

Note: A state approved lateral arm system is being used and 4 ft. anchors are allowed at the sidewall locations. 1 understand 5' anchors are required at all centerline tie points where the torque test reading is 275 or less and where the mobile home manufacturer may require anchors with 4000 lb. holding capacity.

Installer's initials DA

ALL TESTS MUST BE PERFORMED BY A LICENSED INSTALLER

Installer Name Dale Houston

Date Tested 6/25/26

ELECTRICAL

Connect electrical conductors between multi-wide units, but not to the main power source. This includes the bonding wire between multi-wide units. Pg. _____

PLUMBING

Connect all sewer drains to an existing sewer tap or septic tank. Pg. _____

Connect all potable water supply piping to an existing water meter, water tap, or other independent water supply systems. Pg. _____

Permit Number: _____

Date: _____

Site Preparation

Debris and organic material removed _____.
Water drainage: Natural _____ Swale _____ Pad ✓ Other _____

Fastening multi wide units

Floor- Type Fastener: _____ Length: _____ Spacing: _____
Walls- Type Fastener: _____ Length: _____ Spacing: _____
Roof- Type Fastener: _____ Length: _____ Spacing: _____

For used homes a min. 30 gauge, 8" wide, galvanized metal strip will be centered over the peak of the roof and fastened with galv. roofing nails at 2" on center on both sides of the centerline.

Gasket (weatherproofing requirement)

I understand a properly installed gasket is a requirement of all new and used homes and that condensation, mold, mildew and buckled marriage walls are a result of a poorly installed or no gasket being installed. I understand a strip of tape will not serve as a gasket.

Installer's initials _____

Type gasket: _____ Installed: _____
Pg. _____ Between Floors: _____ Yes _____
Between Walls: _____ Yes _____
Bottom of ridge beam: _____ Yes _____

Weatherproofing

The bottom board will be repaired and/or taped. _____ Yes _____ Pg. _____
Siding on units is installed to manufacturer's specifications. _____ Yes _____
Fireplace chimney installed so as not to allow intrusion of rain water. _____ Yes _____

Miscellaneous

Skirting to be installed. _____ Yes _____ No _____ N/A _____
Dryer vent installed outside of skirting. _____ Yes _____ No _____ N/A _____
Range downflow vent installed outside of skirting. _____ Yes _____ No _____ N/A _____
Drain lines supported at 4' intervals. _____ Yes _____ No _____ N/A _____
Electrical crossovers protected. _____ Yes _____ No _____ N/A _____
Other: _____

Installer verifies all information given with this permit worksheet is accurate and true based on the manufacturer's installation instructions and or Rule 15C-1 & 2

Installer's Signature Dale Houston Date _____

COLUMBIA COUNTY BUILDING DEPARTMENT**135 NE Hernando Ave, Suite B-21, Lake City, FL 32055****Phone: 386-758-1008 Fax: 386-758-2160****MOBILE HOME INSTALLER LETTER OF AUTHORIZATION**
(JOB SPECIFIC)***Use if only authorized for a specific address***

I, DALE HOUSTON, give this authority for the job address shown below ONLY,
(Installer License Holder's Name)
143 SE DAVIS CT. LAKE CITY FL and I do certify that the below referenced person(s)
(Job Site Address)
 listed on this form is/are under my direct supervision and control and is/are authorized to purchase permits, call for inspections, and sign on my behalf.

Printed Name of Person Authorized	Signature of Person Authorized
1. CLIFTON KARI	1. Signed by: <u>Clifton kari</u> D245E3AC88E4483
2.	2.
3.	3.
4.	4.
5.	5.

I, the license holder, realize that I am responsible for all permits purchased, and all work done under my license. I understand that I am fully responsible for compliance with all Florida Statutes, Codes, and Local Ordinances.

I understand that the State Licensing Board has the power and authority to discipline a license holder for violations committed by him/her or by his/her authorized person(s) through this document and that I have full responsibility for compliance granted by issuance of such permits.

Dale Houston
 License Holders Signature (Notarized)

IH/1133271
 License Number

6/26/26
 Date


NOTARY INFORMATION:STATE OF: Florida COUNTY OF: Columbia

The above license holder, whose name is Dale Houston personally appeared before me and is () known by me or
 (X) has produced identification (type of I.D.) Valid FL DL on this 26 day of June, 2026.

Morgan Durso
 Notary's Signature

(Seal/Stamp)

Morgan Durso
 Notary's Printed Name

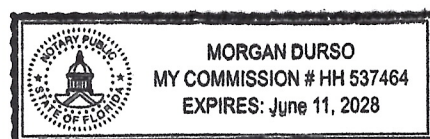**Published 10/2025**