

License Number: IH / 1144605 / 1 Name: DANIELA HALL

Order #: 7062	Label #: 130472	Manufacturer: CAVLO	(Check Size of Home)
Homeowner: OSCAR FIGUEROA +	Year Model: 2026		Single ☒
Address: 399 SW DONAVAN BLVD	Length & Width: 16 X 76		Double ☐
City/State/Zip: LAKE CITY FL	Type Longitudinal System: OLIVER		Triple ☐
Phone #: (330) 957-7762	Type Lateral Arm System: OLIVER		HUD Label #:
Date Installed:	New Home: ☒ Used Home: ☐		Soil Bearing / PSF:
Installed Wind Zone: II	Data Plate Wind Zone: II		Torque Probe / in-lbs:
			Permit #:

Note:

CAVZ906A26-15275A

**STATE OF FLORIDA
INSTALLATION CERTIFICATION LABEL**

130472

LABEL #

DATE OF INSTALLATION

DANIELA HALL

NAME

IH / 1144605 / 1

7062

LICENSE #

ORDER #

CERTIFIES THAT THE INSTALLATION OF THIS MOBILE HOME IS
IN ACCORDANCE WITH FLORIDA STATUTES 320.8249, 320.8325
AND RULES OF THE HIGHWAY SAFETY AND MOTOR VEHICLES.

INSTRUCTIONS

PLEASE WRITE DATE OF
INSTALLATION AND AFFIX
LABEL NEXT TO HUD LABEL.
USE PERMANENT INK PEN
OR MARKER ONLY.
COMPLETE INFORMATION
ABOVE AND KEEP ON FILE
FOR A MINIMUM OF 2
YEARS. YOU ARE REQUIRED
TO PROVIDE COPIES WHEN
REQUESTED.

PERMIT WORKSHEET

OSCAR 49420A
330-957-7762

page 1 of 2

PERMIT NUMBER



Installer DANIEL HALL License # 1144605
 Installer Mobile Phone # (229) 412-0201
 Address of home being installed 399 SW DONAVAN GLN
lake city, FL
 Manufacturer Destiny Length x width 76x16

NOTE: if home is a single wide fill out one half of the blocking plan
 if home is a triple or quad wide sketch in remainder of home

I understand Lateral Arm Systems cannot be used on any home (new or used)
 where the sidewall ties exceed 5 ft 4 in.

Installer's initials DAH

Typical pier spacing

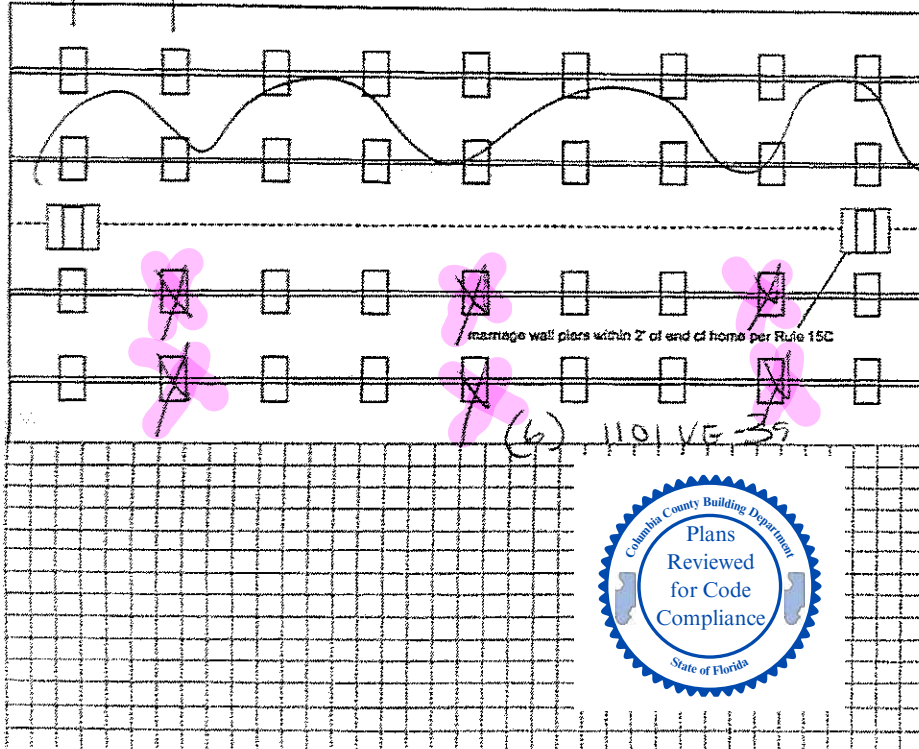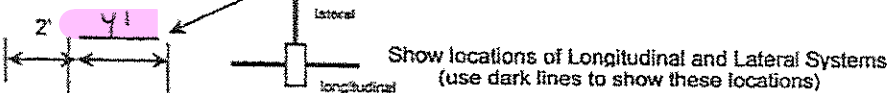

New Home ☒ Used Home ☐

Home installed to the Manufacturer's Installation Manual ☒

Home is installed in accordance with Rule 15-C ☐

Single wide ☒ Wind Zone II ☒ Wind Zone III ☐

Double wide ☐ Installation Decal # 130472

Triple/Quad ☐ Serial # CAV290GA2615275A

Roof System: Typical ☐ Hinged ☐

PIER SPACING TABLE FOR USED HOMES

Load bearing capacity	Footer size (sq in)	16" x 16" (256)	18 1/2" x 18 1/2" (342)	20" x 20" (400)	22" x 22" (484)*	24" X 24" (576)*	26" x 26" (676)
1000 psf	3'	4'	5'	6'	7'	8'	
1500 psf	4' 6"	6'	7'	8'	8'	8'	
2000 psf	6'	8'	8'	8'	8'	8'	
2500 psf	7' 6"	8'	8'	8'	8'	8'	
3000 psf	8'	8'	8'	8'	8'	8'	
3500 psf	8'	8'	8'	8'	8'	8'	

* Interpolated from Rule 15C-1 pier spacing table.

PIER PAD SIZES

I-beam pier pad size 17.5 x 22.5

Perimeter pier pad size 16 x 16

Other pier pad sizes (required by the mfg.) —

Draw the approximate locations of marriage wall openings 4 foot or greater. Use this symbol to show the piers.

List all marriage wall openings greater than 4 foot and their pier pad sizes below.

Opening Pier pad size
N/A —
N/A —

POPULAR PAD SIZES

Pad Size	Sq In
16 x 16	256
16 x 18	288
18.5 x 18.5	342
16 x 22.5	360
17 x 22	374
13 1/4 x 26 1/4	348
20 x 20	400
17 3/16 x 25 3/16	441
17 1/2 x 25 1/2	446
24 x 24	576
26 x 26	676

ANCHORS

4 ft 30 5 ft 0

FRAME TIES

within 2' of end of home spaced at 5' 4" oc NONE

TIEDOWN COMPONENTS

Longitudinal Stabilizing Device (LSD)
 Manufacturer OLIVER TECH
 Longitudinal Stabilizing Device w/ Lateral Arms
 Manufacturer OLIVER TECH

OTHER TIES

Number
 Sidewall 30
 Longitudinal —
 Marriage wall —
 Shearwall —

PERMIT NUMBER

PERMIT WORKSHEET

page 2 of 2

POCKET PENETROMETER TEST

The pocket penetrometer tests are rounded down to _____ psf or check here to declare 1000 lb. soil _____ without testing.

X _____ X _____ X _____

POCKET PENETROMETER TESTING METHOD

1. Test the perimeter of the home at 6 locations
2. Take the reading at the depth of the footer.
3. Using 500 lb. increments, take the lowest reading and round down to that increment.

X _____ X _____

TORQUE PROBE TEST

The results of the torque probe test is 350 inch pounds or check here if you are declaring 5' anchors without testing _____. A test showing 275 inch pounds or less will require 5 foot anchors.

Note: A state approved lateral arm system is being used and 4 ft. anchors are allowed at the sidewall locations. I understand 5 ft anchors are required at all centerline tie points where the torque test reading is 275 or less and where the mobile home manufacturer may requires anchors with 4000 lb holding capacity.

DAH Installer's initials

ALL TESTS MUST BE PERFORMED BY A LICENSED INSTALLER

Installer Name DANIEL HAU

Date Tested 5-13-26

Electrical

Connect electrical conductors between multi-wide units, but not to the main power source. This includes the bonding wire between multi-wide units. Pg. 69

Plumbing

Connect all sewer drains to an existing sewer tap or septic tank. Pg. 69

Connect all potable water supply piping to an existing water meter, water tap, or other independent water supply systems. Pg. 69



Site Preparation

Debris and organic material removed
Water drainage: Natural Swale Pad ☒ Other

Fastening multi wide units

Floor: Type Fastener: _____ Length: _____ Spacing: _____
Walls: Type Fastener: N/A Length: N/A Spacing: N/A
Roof: Type Fastener: _____ Length: _____ Spacing: _____
For used homes a min. 30 gauge, 8" wide, galvanized metal strip will be centered over the peak of the roof and fastened with galv. roofing nails at 2" on center on both sides of the centerline.

16x76

Gasket (weatherproofing requirement)

I understand a properly installed gasket is a requirement of all new and used homes and that condensation, mold, mildew and buckled marriage walls are a result of a poorly installed or no gasket being installed. I understand a strip of tape will not serve as a gasket.

Installer's initials DAH

Type gasket FOAM
Pg. 93

Installed:
Between Floors Yes N/A
Between Walls Yes N/A
Bottom of ridgebeam Yes N/A

16x76

Weatherproofing

The bottomboard will be repaired and/or taped. Yes ☒ Pg. 112
Siding on units is installed to manufacturer's specifications. Yes ☒
Fireplace chimney installed so as not to allow intrusion of rain water. Yes N/A

Miscellaneous

Skirting to be installed. Yes ☒ No _____
Dryer vent installed outside of skirting. Yes ☒ N/A _____
Range downflow vent installed outside of skirting. Yes ☒ N/A _____
Drain lines supported at 4 foot intervals. Yes ☒
Electrical crossovers protected. Yes ☒
Other: _____

Installer verifies all information given with this permit worksheet is accurate and true based on the manufacturer's installation instructions and or Rule 15C-1 & 2

Installer Signature Daniel Hau Date 5-13-26

COLUMBIA COUNTY BUILDING DEPARTMENT AGENT AUTHORIZATION TO SIGN FOR PERMITS

(BLANKET)

Use if authorized to pull all permits on your behalf

License holder still MUST sign Owner and Contractor Signature Page

I, Daniel Hall (License Holder Name), licensed qualifier for Halls Transport (Company Name), do certify that the below referenced person(s) listed on this form is/are contracted/hired by me, the license holder, or is/are employed by me directly through an employee leasing arrangement; or, is an officer of the corporation; or, partner as defined in Florida Statutes Chapter 468, and the said person(s) is/are under my direct supervision and control and is/are authorized to purchase permits, call for inspections and sign on my behalf.

Printed Name of Person Authorized	Signature of Person Authorized
1. <u>TREEA Foster</u>	1. <u>[Signature]</u>
2.	2.
3.	3.
4.	4.
5.	5.

I, the license holder, realize that I am responsible for all permits purchased, and all work done under my license and fully responsible for compliance with all Florida Statutes, Codes, and Local Ordinances. I understand that the State and County Licensing Boards have the power and authority to discipline a license holder for violations committed by him/her, his/her agents, officers, or employees and that I have full responsibility for compliance with all statutes, codes, and ordinances inherent in the privilege granted by issuance of such permits.

If at any time the person(s) you have authorized is/are no longer agents, employee(s), officer(s), you must notify this department in writing of the changes and submit a new letter of authorization form, which will supercede all previous lists. Failure to do so may allow unauthorized persons to use your name and/or license number to obtain permits.

Daniel Hall
License Holders Signature (Notarized)

1H 1144605/1
License Number

6-14-26
Date

NOTARY INFORMATION:


STATE OF: Florida COUNTY OF: Seminole

The above license holder, whose name is Daniel Hall personally appeared before me and is () known by me or () has produced identification (type of I.D.) _____ on this 14 day of June, 2024.

(Seal/Stamp)

Christina Goolsby
Notary's Signature

Christina Goolsby
Notary's Printed Name

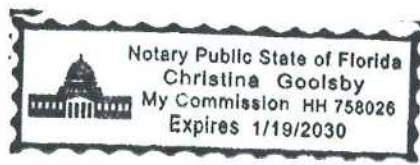

Published 10/2025