



Mobile Home Permit Worksheet

Installer: William Price License # TH-1041936

Address of home being installed 1138 SW Barn Gin
Fort White FL 32038



Manufacturer Live Oak Homes Length x width 32' x 76'

NOTE: If home is a single wide fill out one half of the blocking plan
If home is a triple or quad wide sketch in remainder of home


I understand Lateral Arm Systems cannot be used on any home (new or used)
where the sidewall ties exceed 5 ft 4 in.

Installer's initials WJP

Typical pier spacing

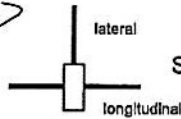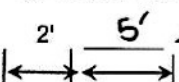

Show locations of Longitudinal and Lateral Systems
(use dark lines to show these locations)

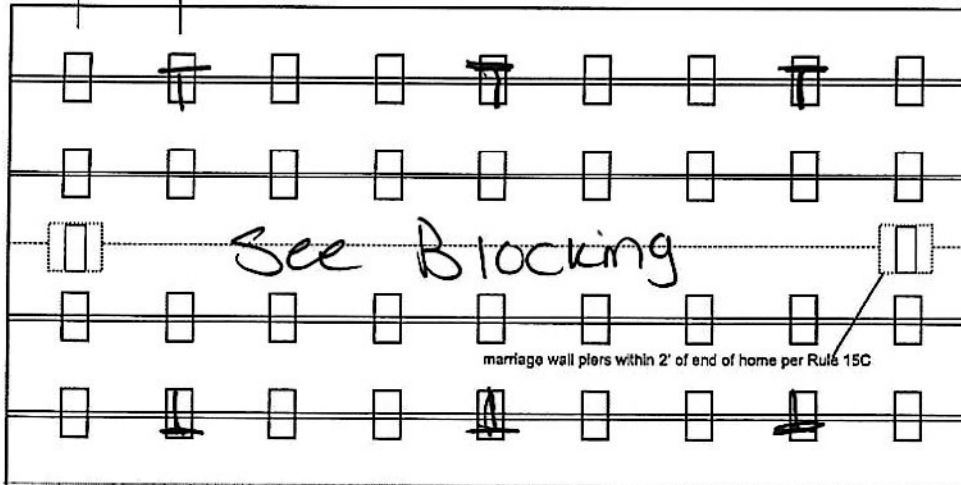

67110LV
Oliver System

Permit Number: _____ Date: _____

New Home ☒ Used Home ☐

Home installed to the Manufacturer's Installation Manual
Home is installed in accordance with Rule 15-C ☒

Single wide ☐ Wind Zone II ☒ Wind Zone III ☐

Double wide ☒ Installation Decal # 116411

Triple/Quad ☐ Serial # 20HGA10025731AB

PIER SPACING TABLE FOR USED HOMES

Load bearing capacity	Footer size (sq in)	16" x 16" (256)	18 1/2" x 18 1/2" (342)	20" x 20" (400)	22" x 22" (484)*	24" x 24" (576)*	26" x 26" (676)
1000 psf		3'	4'	5'	6'	7'	8'
1500 psf		4'6"	6'	7'	8'	8'	8'
2000 psf		6'	8'	8'	8'	8'	8'
2500 psf		7'6"	8'	8'	8'	8'	8'
3000 psf		8'	8'	8'	8'	8'	8'
3500 psf		8'	8'	8'	8'	8'	8'

*Interpolated from Rule 15C-1 pier spacing table.

PIER PAD SIZES

I-beam pier pad size 17x25

Perimeter pier pad size 16x16

Other pier pad sizes (required by the mfg.) _____

Draw the approximate locations of marriage wall openings 4 foot or greater. Use this symbol to show the piers.

List all marriage wall openings greater than 4 foot and their pier pad sizes below.

Opening	Pier pad size
<u>Large</u>	<u>23x31</u>

POPULAR PAD SIZES

Pad Size	Sq In
16 x 16	256
16 x 18	288
18.5 x 18.5	342
16 x 22.5	360
17 x 22	374
13 1/2 x 26 1/2	348
20 x 20	400
17 3/16 x 25 3/16	441
17 1/2 x 25 1/2	446
24 x 24	576
26 x 26	676

4 ft _____ 5 ft ☒

ANCHORS

FRAME TIES

within 2' of end of home
spaced at 5' 4" oc ☒

OTHER TIES

	Number
Sidewall	<u>1</u>
Longitudinal	<u>1</u>
Marriage Wall	<u>1</u>
Shear Wall	<u>1</u>

TIEDOWN COMPONENTS

Longitudinal Stabilizing Device (LSD)

Manufacturer _____

Longitudinal Stabilizing Device with Lateral Arms


Manufacturer Oliver

Davis

35-55-16-03752-424

1138 SW Baron Gln

Ft. White FL

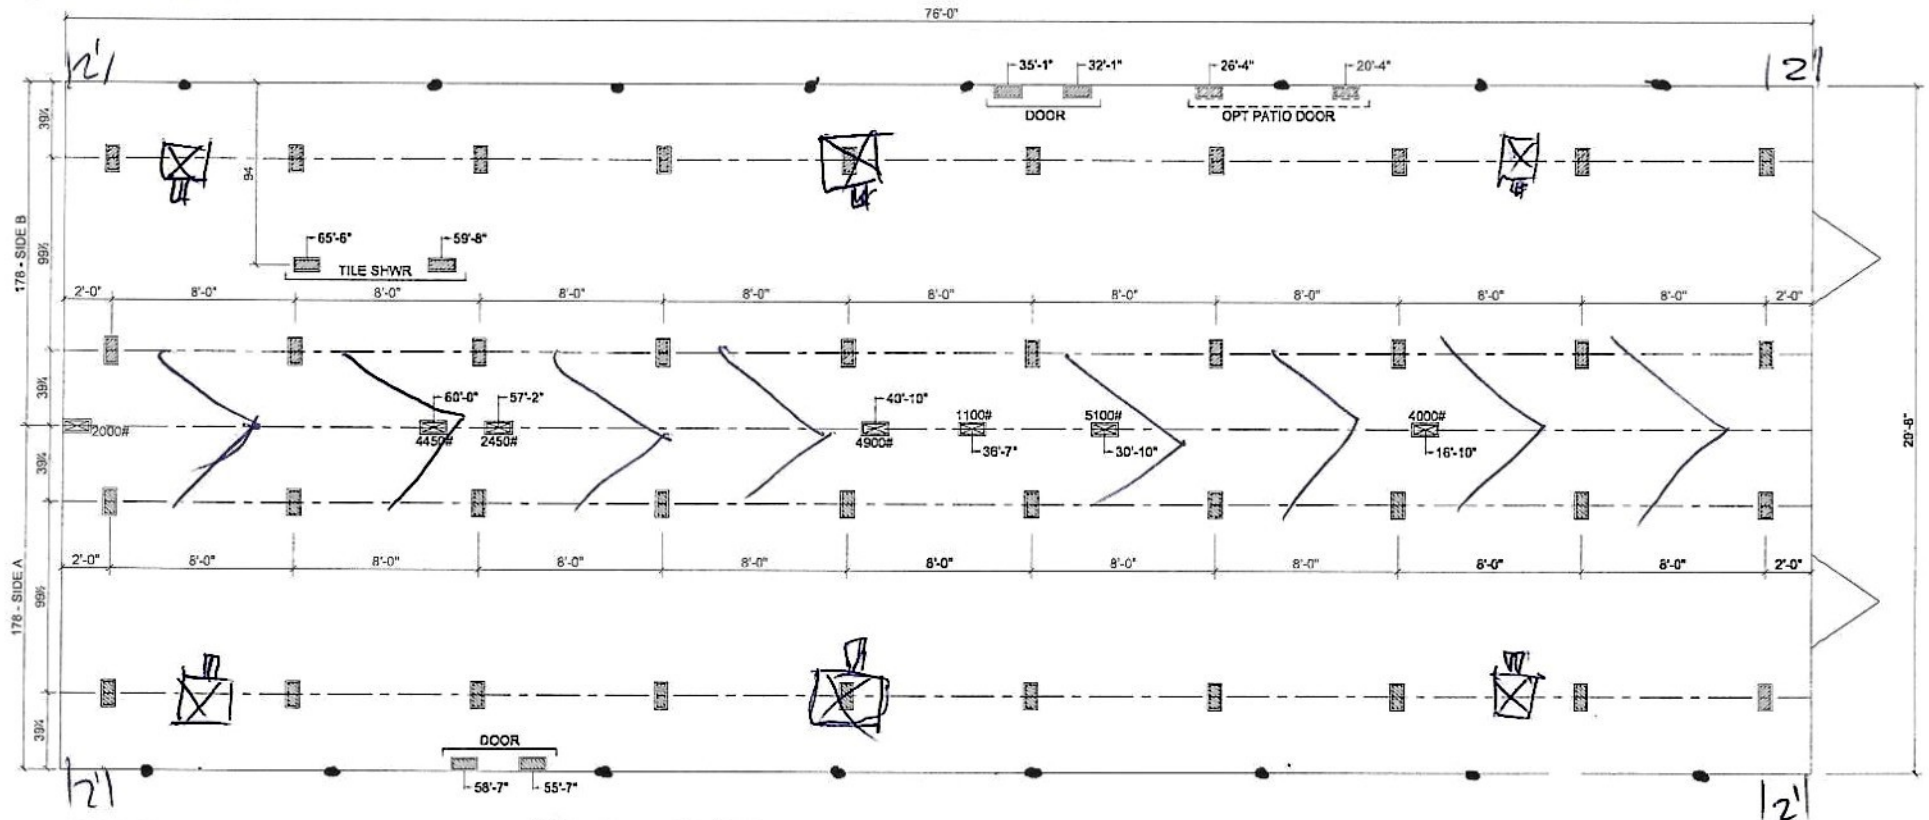

- TIEDOWN LOCATIONS (FOR CONCRETE SLAB SET) - 48" Anchor 5' 4" o/c
- ☒ MARRIAGE LINE OPENING SUPPORT PIER/TYP. - 17x25 ABS or 23x31 ABS or 17x25 tie stacked 805
- ☒ SUPPORT PIER/TYP - 17x25 ABS w/ 8x8x16 5/8" c
- FOUNDATION NOTES:
- THIS DRAWING IS DESIGNED FOR THE STANDARD WIND ZONE AND IS TO BE USED IN CONJUNCTION WITH THE INSTALLATION MANUAL AND ITS SUPPLEMENTS.
- FOOTINGS ARE SHOWN FOR EXAMPLE ONLY QUANTITY AND SPACING MAY VARY BASED ON PAD TYPE, SOIL CONDITION, ETC.
- FOOTINGS ARE REQUIRED AT SUPPORT POSTS, SEE INSTALLATION MANUAL FOR REQUIREMENTS.

09/03/26

Live Oak Homes
MODEL: S-3765A-CLASSIC - 32 X 76 (BOX)
5-BEDROOM / 3-BATH

- ☒ - Giver System
- ➔ - Double Frame Ties - 48" Anchor 5' from end then 12' o/c

S-3765A-CLASSIC



Mobile Home Permit Worksheet

POCKET PENETROMETER TEST

The pocket penetrometer tests are rounded down to _____ psf or check here to declare 1000 lb. soil X without testing.

X 1000

X 1000

X 1000

POCKET PENETROMETER TESTING METHOD

1. Test the perimeter of the home at 6 locations.
2. Take the reading at the depth of the footer.
3. Using 500 lb. increments, take the lowest reading and round down to that increment.

X 1000

X 1000

X 1000

TORQUE PROBE TEST

The results of the torque probe test is _____ inch pounds or check here if you are declaring 5' anchors without testing X. A test showing 275 inch pounds or less will require 5' anchors.

Note: A state approved lateral arm system is being used and 4 ft. anchors are allowed at the sidewall locations. I understand 5' anchors are required at all centerline tie points where the torque test reading is 275 or less and where the mobile home manufacturer may require anchors with 4000 lb. holding capacity.

Installer's initials WMP

ALL TESTS MUST BE PERFORMED BY A LICENSED INSTALLER

Installer Name William Price

Date Tested 7/27/26

ELECTRICAL

Connect electrical conductors between multi-wide units, but not to the main power source. This includes the bonding wire between multi-wide units. Pg. X

PLUMBING

Connect all sewer drains to an existing sewer tap or septic tank. Pg. ✓

Connect all potable water supply piping to an existing water meter, water tap, or other independent water supply systems. Pg. ✓

Permit Number: _____

Date: _____

Site Preparation

Debris and organic material removed 90% Yes

Water drainage: Natural _____ Swale _____ Pad X Other _____

Fastening multi wide units

Floor- Type Fastener: Screws Length: _____ Spacing: 18"

Walls- Type Fastener: Lags Length: _____ Spacing: 12"

Roof- Type Fastener: metal screws Length: _____ Spacing: 18"

For used homes a min. 30 gauge, 8" wide, galvanized metal strip will be centered over the peak of the roof and fastened with galv. roofing nails at 2" on center on both sides of the centerline.

Gasket (weatherproofing requirement)

I understand a properly installed gasket is a requirement of all new and used homes and that condensation, mold, mildew and buckled marriage walls are a result of a poorly installed or no gasket being installed. I understand a strip of tape will not serve as a gasket.

Installer's initials WMP

Type gasket----- Green

Pg. ----- 1

Installed:

Between Floors-----Yes ✓

Between Walls-----Yes ✓

Bottom of ridge beam---Yes ✓

Weatherproofing

The bottom board will be repaired and/or taped.-----Yes ✓ Pg. _____

Siding on units is installed to manufacturer's specifications.-----Yes ✓

Fireplace chimney installed so as not to allow intrusion of rain water.---Yes ✓

Miscellaneous

Skirting to be installed.-----Yes ✓ No _____ N/A _____

Dryer vent installed outside of skirting.-----Yes ✓ No _____ N/A _____

Range downflow vent installed outside of skirting.---Yes ✓ No _____ N/A _____

Drain lines supported at 4' intervals.-----Yes ✓ No _____ N/A _____

Electrical crossovers protected.-----Yes ✓ No _____ N/A _____

Other: _____


Installer verifies all information given with this permit worksheet is accurate and true based on the manufacturer's installation instructions and or Rule 15C-1 & 2

Installer's Signature WMP


Date 7/27/26

Davis
 1138 SW Baron Gln.
 Ft. White, FL,
 32038
 35-55-16-
 03752-424


GEORGIA

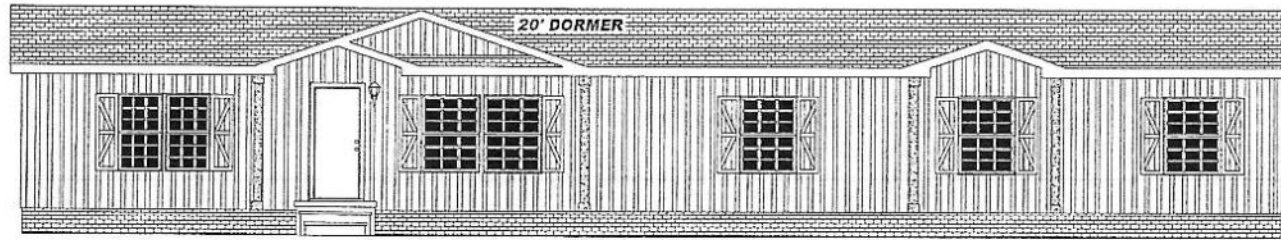

OPT LOFT EXTERIOR

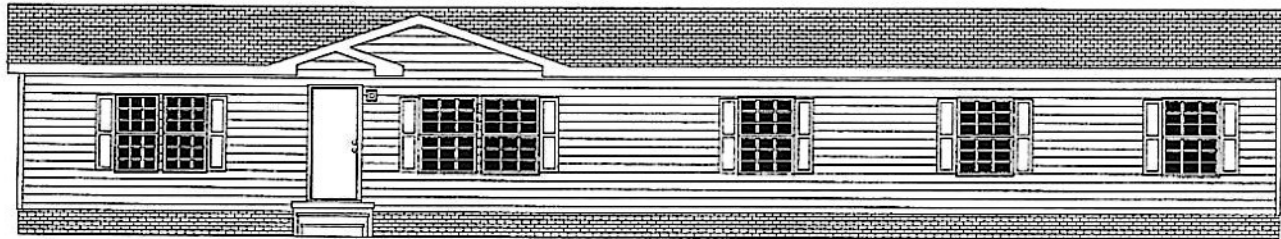

FRONT ELEVATION

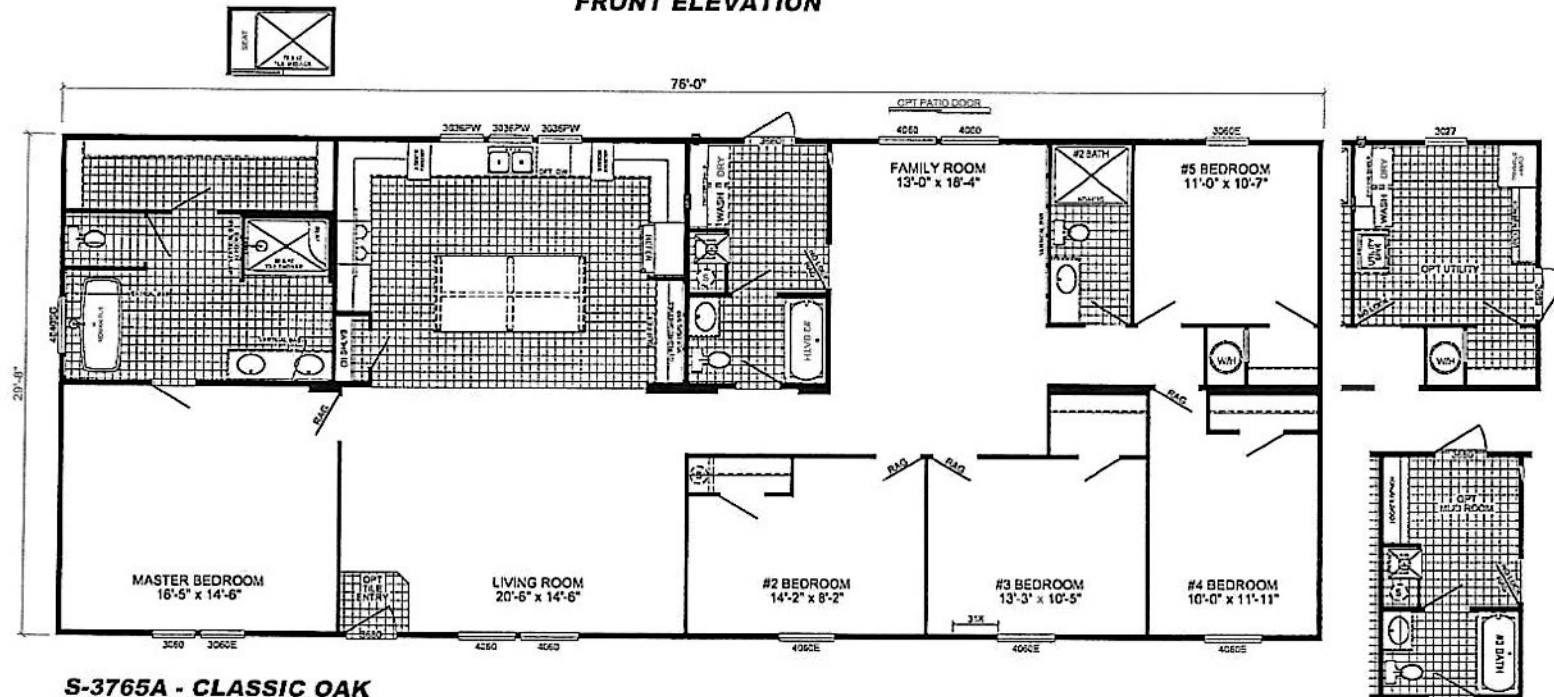

S-3765A - CLASSIC OAK
5-BEDROOM / 3-BATH
32 X 80 - Approx. 2254 Sq. Ft.

Date: 05/19/25

- * All room dimensions include closets and square footage figures are approximate.
- * Transom windows are available on optional 9'-0" sidewall houses only.
- * Siding shown is optional.
- * Floorplan designs, options, features, and amenities are subject to change without notice.

Davis

32' x 76'

Columbia

License Number: IH / 1041936 / 1 Name: WILLIAM R PRICE

Order #: 6454

Label #: 116411

Manufacturer:

(Check Size of Home)

Homeowner:

Year Model:

Single _____

Address:

Length & Width:

Double _____

City/State/Zip:

Type Longitudinal System:

Triple _____

Phone #:

Type Lateral Arm System:

HUD Label #:

Date Installed:

New Home: _____ Used Home: _____

Soil Bearing / PSF:

Installed Wind Zone:

Data Plate Wind Zone:

Torque Probe / in-lbs:

Permit #:

Note:

STATE OF FLORIDA
INSTALLATION CERTIFICATION LABEL

116411

LABEL #

DATE OF INSTALLATION

WILLIAM R PRICE

NAME

IH / 1041936 / 1

6454

LICENSE #

ORDER #

CERTIFIES THAT THE INSTALLATION OF THIS MOBILE HOME IS
IN ACCORDANCE WITH FLORIDA STATUTES 320.8249, 320.8325
AND RULES OF THE HIGHWAY SAFETY AND MOTOR VEHICLES.

INSTRUCTIONS

PLEASE WRITE DATE OF
INSTALLATION AND AFFIX
LABEL NEXT TO HUD LABEL.
USE PERMANENT INK PEN
OR MARKER ONLY.
COMPLETE INFORMATION
ABOVE AND KEEP ON FILE
FOR A MINIMUM OF 2 YEARS.
YOU ARE REQUIRED TO
PROVIDE COPIES WHEN
REQUESTED.