




Mobile Home Permit Worksheet

Installer: Jason Kienlen License # TH1150987
Address of home 275 SW Sunrise Way, L.C. Fl.
being installed 8.14y

Manufacturer Radco Length x width 16x76

NOTE: If home is a single wide fill out one half of the blocking plan
If home is a triple or quad wide sketch in remainder of home
I understand Lateral Arm Systems cannot be used on any home (new or used)
where the sidewall ties exceed 5 ft 4 in.

Typical pier spacing

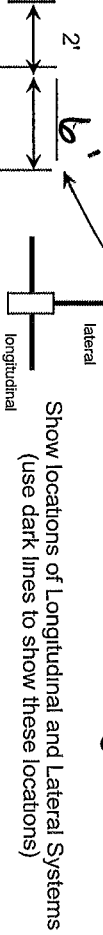

Installer's initials

JK

Permit Number: 130190 Date: 5/20/24

New Home ☐ Used Home ☒
Home installed to the Manufacturer's Installation Manual
Home is installed in accordance with Rule 15-C ☒

Single wide ☒ Wind Zone II ☒ Wind Zone III ☐
Double wide ☐ Installation Decal # 130190
Triple/Quad ☐ Serial # GAFLW75A32751-WT21

PIER SPACING TABLE FOR USED HOMES

Load bearing capacity (sq in)	Footer size (sq in)	16" x 16" (256)	18 1/2" x 18 (342)	20" x 20" (400)	22" x 22" (484)*	24" x 24" (576)*	26" x 26" (676)
1000 psf	3'		4'	5'	6'	7'	8'
1500 psf	4'6"		6'	7'	8'	8'	8'
2000 psf	6'		8'	8'	8'	8'	8'
2500 psf	7'6"		8'	8'	8'	8'	8'
3000 psf	8'		8'	8'	8'	8'	8'
3500 psf	8'		8'	8'	8'	8'	8'

*Interpolated from Rule 15C-1 pier spacing table.

PIER PAD SIZES

I-beam pier pad size 17.5 x 25.5

Perimeter pier pad size

16x16

Other pier pad sizes (required by the mfg.)

Draw the approximate locations of marriage wall openings 4 foot or greater. Use this symbol to show the piers.

List all marriage wall openings greater than 4 foot and their pier pad sizes below.

Opening

Pier pad size

4 ft X 5 ft

Doors 16 x 16
Remainder 16 x 16

TIEDOWN COMPONENTS

Longitudinal Stabilizing Device (LSD) LSD
Manufacturer _____
Longitudinal Stabilizing Device w/ Lateral Arms
Manufacturer _____

OTHER TIES

Number _____
Sidewall _____
Longitudinal Marriage Wall _____
Shear Wall _____

ANCHORS

FRAME TIES

within 2' of end of home JK
spaced at 5' 4" oc



Mobile Home Permit Worksheet

POCKET PENETROMETER TEST

The pocket penetrometer tests are rounded down to 1500 psf or check here to declare 1000 lb. soil _____ without testing.

x 1200 x 1500 x 1500

POCKET PENETROMETER TESTING METHOD

1. Test the perimeter of the home at 6 locations.
2. Take the reading at the depth of the footer.
3. Using 500 lb. increments, take the lowest reading and round down to that increment.

x 1500 x 1200 x 1500

TORQUE PROBE TEST

The results of the torque probe test is 285 inch pounds or check here if you are declaring 5' anchors without testing _____. A test showing 275 inch pounds or less will require 5' anchors.

Note: A state approved lateral arm system is being used and 4 ft. anchors are allowed at the sidewall locations. I understand 5' anchors are required at all centerline tie points where the torque test reading is 275 or less and where the mobile home manufacturer may require anchors with 4000 lb. holding capacity.

Installer's initials SK

ALL TESTS MUST BE PERFORMED BY A LICENSED INSTALLER

Installer Name Jason Kienlen

Date Tested 5/20/26

ELECTRICAL

Connect electrical conductors between multi-wide units, but not to the main power source. This includes the bonding wire between multi-wide units. Pg. N/A

PLUMBING

Connect all sewer drains to an existing sewer tap or septic tank. Pg. SK

Connect all potable water supply piping to an existing water meter, water tap, or other independent water supply systems. Pg. SK

Permit Number: _____

Date: 5/20/26

Site Preparation

Debris and organic material removed X
Water drainage: Natural Swale Pad X Other _____

Fastening multi wide units

Floor- Type Fastener _____ Length _____ Spacing: _____
Walls- Type Fastener _____ Length _____ Spacing: _____
Roof- Type Fastener _____ Length _____ Spacing: _____

For used homes a min. 30 gauge, 8" wide, galvanized metal strip will be centered over the peak of the roof and fastened with galv. roofing nails at 2" on center on both sides of the centerline.

Gasket (weatherproofing requirement)

I understand a properly installed gasket is a requirement of all new and used homes and that condensation, mold, mildew and buckled marriage walls are a result of a poorly installed or no gasket being installed. I understand a strip of tape will not serve as a gasket.

Installer's initials N/A

Type gasket _____ Installed: _____
Pg. _____ Between Floors _____ Yes _____
Between Walls _____ Yes _____
Bottom of ridge beam _____ Yes _____

Weatherproofing

The bottom board will be repaired and/or taped. _____ Yes _____ Pg. _____
Siding on units is installed to manufacturer's specifications. _____ Yes _____
Fireplace chimney installed so as not to allow intrusion of rain water. _____ Yes _____

Miscellaneous

Skirting to be installed. _____ Yes _____ No _____ N/A X
Dryer vent installed outside of skirting. _____ Yes _____ No _____ N/A X
Range downflow vent installed outside of skirting. _____ Yes _____ No _____ N/A X
Drain lines supported at 4' intervals. _____ Yes X _____ No _____ N/A X
Electrical crossovers protected. _____ Yes _____ No _____ N/A X
Other _____

SEWER & WATER CONNECTIONS

Installer verifies all information given with this permit worksheet is accurate and true based on the manufacturer's installation instructions and or Rule 15C-1 & 2

Installer's Signature

Jason Kienlen Date 5/20/26