

ALL REPORTS, SPECIFICATIONS, COMPUTER FILES, RED DATA AND OTHER DOCUMENTATION PREPARED BY KASPER ARCHITECTS & DEVELOPMENT, INC. (KAD) AS INSTRUMENTS OF SERVICE SHALL REMAIN THE PROPERTY OF KAD. KAD SHALL RETAIN ALL COMMON LAW, STATUTORY AND OTHER RESERVED RIGHTS, INCLUDING THE COPYRIGHT THEREIN. THE DRAWINGS SHALL NEVER BE REPRODUCED IN WHOLE OR IN PART WITHOUT THE EXPRESS WRITTEN PERMISSION OF KAD.

ELECTRICAL GENERAL NOTES

- 1
- CONTRACTOR SHALL BE LICENSED BY THE STATE OF FLORIDA ACCORDING TO CHAPTER 489, FLORIDA STATUTES AND SHALL PROVIDE FOR AND ACQUIRE ALL NECESSARY PERMIT(S) AND INSPECTIONS AS MAY BE REQUIRED BY THE AHJ.
- 2
- INSTALLATION SHALL MEET OR EXCEED THE MINIMUM REQUIREMENTS OF THE APPLICABLE CODES AS ADOPTED BY THE JURISDICTION.
- 3
- THE CONTRACTOR SHALL FURNISH ALL MATERIALS AND LABOR NECESSARY TO PROVIDE FOR THE INSTALLATION OF A COMPLETE ELECTRICAL SYSTEM.
- 4
- THE CONTRACTOR SHALL MAKE A THOROUGH EXAMINATION OF THE SITE CONDITIONS AND CONTRACT DOCUMENTS.
- 5
- THE CONTRACTOR SHALL COORDINATE METERING, TRANSFORMER AND SERVICE CONNECTION REQUIREMENTS WITH THE APPROPRIATE UTILITIES.
- 6
- PROVIDE ANY AND ALL NECESSARY TEMPORARY CONNECTIONS OF EQUIPMENT, DEVICES OR LUMINAIRES AS MAY BE REQUIRED FOR CONSTRUCTION.
- 7
- CONDUIT SHALL BE INSTALLED CONCEALED, RECESSED AND IN A NEAT AND WORKMANLIKE MANNER. ALL CONDUIT SHALL BE INSTALLED PARALLEL OR PERPENDICULAR TO BUILDING LINES. EXPOSED CONDUIT ON EXTERIOR WALLS OF FINISHED WALLS IS PROHIBITED.
- 8
- CONDUIT SHALL BE EMT AND FITTINGS SHALL BE STEEL. FOR UNDERGROUND AND UNDER SLAB INSTALLATIONS, CONDUIT SHALL BE PVC OR IMC W/AN ASPHALTIC COATING. ENT OR "SMURF" TUBING IS NOT APPROVED.
- 9
- EACH PANEL BOARD AND DISCONNECTING MEANS SHALL BE MARKED TO INDICATE ITS PURPOSE, FEED, AND OF SUFFICIENT DURABILITY TO WITHSTAND THE ENVIRONMENT INVOLVED
- 10
- SEAL ALL CONDUITS WHERE THE CONDUIT CONNECTS AN INTERIOR CONDUIT BODY TO AN EXTERIOR CONDUIT BODY OR LUMINAIRE.
- 11
- PROVIDE A MINIMUM 1 1/2" SPACE BETWEEN METAL CORRUGATED SHEET ROOF DECKING AND ANY CABLE, CONDUIT OR BOX PER NEC 300.4(E)
- 12
- UNDERGROUND PVC CONDUIT SHALL BE A LEAST 12" UNDER SIDEWALKS, 24" UNDER PARKING LOTS & DRIVEWAYS AND 18" IN ALL OTHER LOCATIONS PER NEC 300.5.
- 13
- PROVIDE SUFFICIENT SPACING BETWEEN CONDUITS TO ALLOW APPROPRIATE COMPACTION AND HEAT DISSIPATION.
- 14
- ALL UNDERGROUND CONDUITS AND CONDUCTORS SHALL BE MARKED WITH A DETECTABLE WARNING RIBBON AT LEAST 12" ABOVE THE CONDUIT OR CONDUCTOR PER NEC 300.5(D)(3).
- 15
- CONDUCTORS IN CONDUIT INSTALLED EXPOSED TO DIRECT SUNLIGHT SHOULD BE DE-RATED DEPENDING ON THE DISTANCE BETWEEN THE ROOF & BOTTOM OF CONDUIT PER NEC 310.15(B)2 & SHOULD BE INSTALLED USING THE APPROPRIATE SPACER.
- 16
- PROVIDE AN INDEPENDENT MEANS OF SUPPORT FOR CONDUIT INSTALLED ABOVE A CEILING WHERE THE SUPPORTS ARE DISTINGUISHABLE BY COLOR, TAGGING OR OTHER EFFECTIVE MEANS. THE CEILING SUPPORT SYSTEM SHALL BE PERMITTED TO SUPPORT BRANCH CIRCUIT WIRING WHERE INSTALLED IN ACCORDANCE WITH THE CEILING MANUFACTURER'S INSTRUCTIONS.
- 17
- PROVIDE AN INSULATED THROAT FITTING OR PLASTIC BUSHING FOR ALL 1" & LARGER CONDUIT TERMINATIONS IN PANELBOARDS, WIREWAYS AND DISCONNECT SWITCHES.
- 18
- PROVIDE GROUNDING BUSHINGS FOR ANY CONDUIT TERMINATIONS AT ECCENTRIC AND CONCENTRIC KNOCKOUTS IN DISCONNECTS, PANELBOARDS & LOADCENTERS OR WHEN REDUCING WASHERS ARE USED.
- 19
- BOND ALL JUNCTION AND PULL BOXES TO GROUND.
- 20
- ALL WIRE SHALL BE COPPER THHN, THWN OR XHHW UON. MINIMUM WIRE SIZE IS #12.
- 21
- AMPACITIES ARE CALCULATED USING THE 75°C COLUMN. SERIES 8000 COMPACT ALUMINUM CONDUCTORS OF EQUIVALENT OR GREATER AMPACITY TO THE COPPER CONDUCTORS SCHEDULED SCHEDULED MAY BE USED FOR LOADS OVER 100A.
- 22
- REFER TO CONDUCTOR VOLTAGE DROP SUMMARY ON SHEET E0.5 FOR MAXIMUM LENGTHS OF CONDUCTORS. ALL WIRING DEVICES SHALL BE TERMINATED AT THE SCREW IN A CLOCKWISE DIRECTION. THE PUSH-IN TERMINATIONS SHALL NOT BE USED.
- 23
- VOLTAGE DROP SHALL NOT EXCEED 5% FOR EACH END DEVICE FROM THE TRANSFORMER AND INCLUDE ALL BRANCH AND FEEDER CIRCUITS.
- 24
- MOTOR STARTING SWITCHES MAY BE ELIMINATED AT DUCT HEATERS AND VAV BOXES IF A DISCONNECTING MEANS HAS BEEN PROVIDED WITH THE EQUIPMENT.
- 25
- INSTALL A FULL SIZE NEUTRAL TO ALL DEVICES INCLUDING SWITCHES.
- 26
- TERMINATE NO MORE THAN ONE WIRE PER TERMINAL PER NEC 110.14A.
- 27
- CONDUCTORS SHALL BE TWISTED TOGETHER PRIOR TO INSTALLATION OF WIRE NUT.
- 28
- REFER TO DATA/COMM DETAIL FOR EXTENT OF INSTALLATION REQUIRED.
- 29
- ALL BOXES SHALL BE A 4" SQUARE METAL BOX WITH THE APPROPRIATE RING. THE MAXIMUM GAP AROUND ANY RECESSED BOX SHALL NOT EXCEED 1/8" AND THE MAXIMUM SETBACK SHALL NOT EXCEED 1/4" PER NEC 314.20 & 314.21.
- 30
- VERIFY DOOR SWINGS AND BACK SPLASH HEIGHTS AT ROUGH IN.
- 31
- STAGGER BACK TO BACK WALL BOXES IN ALL WALLS BY AT LEAST ONE STUD.
- 32
- ALL CONDUIT CUT ENDS SHALL BE REAMED PER NEC 358.28
- 33
- ALL EXTERIOR RECEPTACLES SHALL BE WEATHER RESISTANT PER NEC 406(D)6.
- 34
- AT ROUGH IN, INSTALL ARLINGTON "IN BOX" WHERE AN IN USE COVER IS REQUIRED.
- 35
- PROVIDE IN USE COVERS FOR ELECTRICAL DEVICES INSTALLED IN DAMP AND WET AREAS WITH THE APPROPRIATE DUTY PER NEC 406.9.
- 36
- ALL PANEL BOARD BUS SHALL BE COPPER.
- 37
- WHEN AVAILABLE, ALL BREAKERS SHALL BE THE BOLT ON TYPE.
- 38
- PROVIDE A TYPED PANEL SCHEDULE REFLECTING INSTALLED CONDITIONS FOR ALL PANELBOARDS WITH "SPACE" OR "SPARE" WRITTEN IN PENCIL.
- 39
- INSTALL PANELS AND DISCONNECTS SO THAT AT LEAST 3½ FEET OF WORKING SPACE CAN BE MAINTAINED PER NEC 110.26.
- 40
- ELECTRICAL EQUIPMENT SUPPORT WIRES SHALL BE TAUT & FASTENED AT BOTH ENDS.
- 41
- "TYPICAL" NOTES APPLY TO ALL SIMILAR SITUATIONS.
- 42
- PROVIDE A DISCONNECTING MEANS FOR EACH WATER HEATER PER FPC 504.3.
- 43
- LABEL ALL JUNCTION BOX COVERS WITH CIRCUITS DESIGNATION CONTAINED WITHIN.
- 44
- PROVIDE OPERATING AND INSTALLATION INSTRUCTIONS TO THE OWNER FOR ALL INSTALLED EQUIPMENT.
- 45
- AN FS BOX IS NOT APPROVED AS A SUPPORT FOR A LUMINAIRE.
- 46
- LUMINAIRES INSTALLED IN SUSPENDED CEILINGS SHALL BE FASTENED TO THE CEILING FRAMING MEMBERS WITH LISTED CLIPS IN ACCORDANCE WITH NEC 410.36(B).
- 47
- PROVIDE THE APPROPRIATE FIRE STOP SYSTEM AND/OR FIRE CAULK AT ANY PENETRATION OF A RATED VERTICAL ASSEMBLY.
- 48
- PENETRATIONS OF A RATED HORIZONTAL ASSEMBLY WITH A METAL CONDUIT NOT EXCEEDING 6 INCH NOMINAL DIAMETER, INSTALL CONCRETE, GROUT, OR MORTAR THE FULL THICKNESS OF THE FLOOR AS REQUIRED BY FBC 713.4.1.1 SO TO MAINTAIN THE FIRE RESISTANCE RATING. FOR MULTIPLE PENETRATIONS, REFER TO THE FBC.
- 49
- ALL JUNCTION BOXES ARE TO BE ACCESSIBLE PER NEC ARTICLE 100.
- 50
- NOT ALL ITEMS, NOTES, DETAILS, ABBREVIATIONS, SCHEDULES AND LEGENDS ON THIS SHEET MAY BE APPLICABLE TO THIS PROJECT.
- 51
- CONDUIT TERMINATION AT NEMA 3R ENCLOSURES SHALL BE WITH A MYERS HUBS FOR TOP PENETRATIONS AND LIQUID TIGHT SEALING RINGS OR SEALING LOCKNUTS FOR SIDE PENETRATIONS.
- 52
- INSTALL ALL PLATES SO EDGES ARE FLUSH WITH WALL SURFACE.
- 53
- FOR ALL LED LUMINAIRES, MARK EACH FIXTURE WITH TAG #, MANUFACTURER, MODEL NUMBER, INSTALLATION DATE, INSTALLING CONTRACTOR AND LENGTH OF WARRANTY.
- 54
- PROVIDE AND INSTALL ALL NECESSARY JUNCTION BOXES, SHOWN AND NOT SHOWN, THAT MAY BE REQUIRED FOR A COMPLETE AND ACCESSIBLE CODE COMPLIANT INSTALLATION.
- 55
- RECEPTACLES INSTALLED WITHIN 6' OF WATER SOURCE SHALL BE GFCI PROTECTED IRREGARDLESS OF PLAN DESIGNATION. COORDINATE INSTALLATION OF RECEPTACLES SHOWN ADJACENT TO MILLWORK WITH ARCHITECTURAL ELEVATIONS SO THEY ARE ACCESSIBLE LOCATIONS SHOWN ON PLAN ARE DIAGRAMMATIC.
- 56
- INSTALL A BOX AND SUPPORT FOR A 70LB DYNAMIC LOAD AT ALL CEILING FANS AND LOCATIONS WHERE A FAN MIGHT BE INSTALLED IN THE FUTURE.
- 57
- WHERE A LUMINAIRE IS INSTALLED MOUNTED TO A BOX, INSTALL A BOX AND SUPPORT RATED FOR A 50LB STATIC LOAD. SUCH LUMINAIRES INCLUDE BUT ARE NOT LIMITED TO EXIT LIGHTS, EGRESS LIGHTING, WALL PACS & WALL MOUNTED STRIPS
- 58
- WHERE A CONDUCTOR IS TOO LARGE TO TERMINATE TO A BREAKER OR DISCONNECT, PROVIDE AND INSTALL A STEP DOWN COMPRESSION ADAPTOR OR COUPLER REDUCER.
- 59
- WHERE THREADS ARE FIELD CUT, COAT THE THREADS WITH AN APPROVED CORROSION RESISTANT ELECTRICALLY CONDUCTIVE COMPOUND PER NEC 300.6(A).
- 60
- WHERE A TWO POLE OCCUPANCY SENSOR OR MULTIPLE SWITCHES ARE INSTALLED, THE BUTTON OR SWITCH CLOSEST TO THE DOOR SHALL OPERATE THE LIGHT OF THE ROOM BEING ENTERED.

ELECTRICAL GENERAL NOTES (CONT)

- 61
- WALL LUMINAIRES SHALL BE INSTALLED AFTER WALL FINISHES HAVE BEEN APPLIED.
- 62
- STRUT INSTALLED ABOVE MULTIPLE PANELBOARDS SHALL BE CONTINUOUS IN LIEU OF MULTIPLE SHORT PIECES.
- 63
- PROVIDE HACR BREAKERS FOR ALL HVAC EQUIPMENT.
- 64
- PROVIDE GFCI BREAKERS FOR DRINKING FOUNTAINS.
- 65
- PROVIDE DUAL FUNCTION, GFCI/AFCI BREAKERS FOR DISHWASHERS.
- 66
- PROVIDE AFCI BREAKERS FOR ALL RESIDENTIAL AREAS EXCEPT RESTROOMS AND EXTERIOR USES AS REQUIRED BY NEC 210.12.
- 67
- PROVIDE AS BUILT DRAWINGS AND A COPY OF APPROVED SHOP DRAWINGS UPON COMPLETION PER FLORIDA ENERGY CODE C408.3.2.
- 68
- INSTALL LUMINAIRES WITH BATTERY TEST SWITCHES WITH THE TEST BUTTON DOWN.
- 69
- INSTALL EXIT LIGHTS WITH 2" BETWEEN THE BOTTOM OF THE EXIT AND THE DOOR JAMB, UNO.
- 70
- PROVIDE BLANK PLATES FOR ALL UNUSED BOXES.
- 71
- WHERE THE ELECTRICAL PLANS SHOW THE CONNECTION OF AN EXHAUST HOOD, ADDITIONAL DIRECTION OF WORK TO BE COMPLETED BY THE ELECTRICAL CONTRACTOR WILL BE FOUND IN THE MECHANICAL CONSTRUCTION DOCUMENTS AND SHALL BE PART OF THE BASE BID.
- 72
- THE CONSTRUCTION AND INSTALLATION OF THE PRIMARY ELECTRIC CONDUIT, TRANSFORMER, TRANSFORMER PAD AND METERING ARE SHOWN DIAGRAMMATIC. THE DIRECTION SET FORTH BY THE LOCAL ELECTRIC UTILITY IN ITS DESIGN MANUALS AND SPECIFICATIONS IS APPLICABLE AND BECOMES PART OF THESE CONSTRUCTION DOCUMENTS.




10175 Fortune Parkway, Suite 701
Jacksonville, FL 32256
p 904.683.9201 f 904.683.9702

www.kasperarch.com
FL License No.: AA26000802



www.IMEGCorp.com
9133 R.G. Skinner Parkway
Jacksonville, Florida 32216
Ph: (904) 483-5200 Fax: (904) 483-6700
email: mail@McVeighMangum.com
CRA 6550
Eng. of Record Thomas C. Nielsen
License No.: 53492

ALL DESIGN PRIOR TO 08/28/2025 WAS PERFORMED BY IMEG UNDER THE RESPONSIBLE CHARGE OF THOMAS C. NIELSEN, PE #53492. ALL SUBSEQUENT DESIGN BY IMEG IS UNDER THE RESPONSIBLE CHARGE OF BRIAN J. LEAVITT, PE #87733.

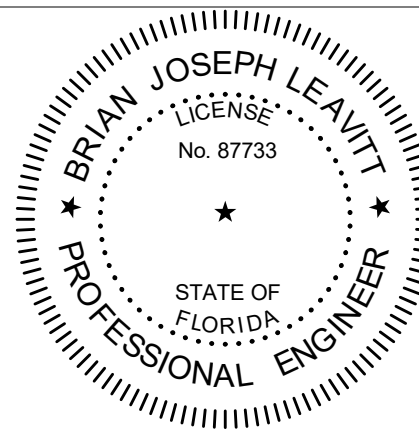

BUSY BEE
ELLISVILLE

136 SW WEBBS GLN
LAKE CITY, FL 32024

PROJECT NO.: 22024

DATE: 06/02/2025

PRIOR ISSUES:

108/24/2025 IASB #1

ELECTRICAL
GENERAL NOTES

E0.1b

DRAWN BY: IMEG
CHECKED BY: IMEG

100%
CONSTRUCTION
DOCUMENTS

ALL REPORTS, SPECIFICATIONS, COMPUTER FILES, FIELD DATA, AND OTHER DOCUMENTATION PREPARED BY KASPER ARCHITECTS & DEVELOPMENT, INC. (KAD) AS INSTRUMENTS OF SERVICE SHALL REMAIN THE PROPERTY OF KAD. KAD SHALL RETAIN ALL COMMON LAW, STATUTORY AND OTHER RESERVED RIGHTS, INCLUDING THE COPYRIGHT THEREIN. THIS DRAWING SHALL NEVER BE REPRODUCED IN WHOLE OR IN PART WITHOUT THE EXPRESS WRITTEN PERMISSION OF KAD.

KITCHEN EQUIPMENT SCHEDULE														
REVISION	ITEM NO	QTY	EQUIPMENT CATEGORY	EQUIPMENT REMARKS	VOLTS	CYCLE	PHASE	DIRECT	CORD/PLUG	NEMA	AMPS	KW	HP	ELECTRICAL REMARKS
	001	1	WALK-IN COOLER AND FREEZER	REFER TO SHOP DRAWINGS	31115	60	1	X			(2)15			114 VERIFY WITH SHOP DRAWINGS
	001.1	1	COOLER EVAPORATOR COIL	REFER TO SHOP DRAWINGS	115	60	1	X			1.6			114 VERIFY WITH SHOP DRAWINGS
	001.2	1	COOLER CONDENSING UNIT	REFER TO SHOP DRAWINGS	208-230	60	1	X			--		--	TBD VERIFY WITH SHOP DRAWINGS
	001.3	1	FREEZER EVAPORATOR COIL	REFER TO SHOP DRAWINGS	208-230	60	1	X			9.8			114 VERIFY WITH SHOP DRAWINGS
	001.4	1	FREEZER CONDENSING UNIT	REFER TO SHOP DRAWINGS	208-230	60	1	X			--		--	TBD VERIFY WITH SHOP DRAWINGS
	100	3	CABINET, MOBILE, WARMING & HOLDING		120	60	1	X	5-15P		8.0	1.0		18
	103	1	UNDERBAR PASS-THRU COOLER		120	60	1	X	5-15P		3.5		1/4	18
	104	1	CHOCOLATE MELTER		120	60	1	X	5-15P		1.1	0.1		TBD
	105	1	CHOCOLATE TEMPERING MACHINE		120	60	1	X	5-15P		7.0			18
	108	1	RAPID COOK SERIES		208	60	1	X	L6-20		20.0	3.6		48
	200	1	EXHAUST HOOD	REFER TO SHOP DRAWINGS	120	60	1	X			15.0			DFA
					120	60	1	X			15.0			DFA
	200.1	1	HOOD CONTROL CENTER	MOUNTED ON TOP OF HOOD; REFER TO SHOP DRAWINGS	120	60	1	X			15.0			DFA
					208	60	3	X			--			DFA
					208	60	3	X			--			DFA
	200.2	1	EXHAUST FAN	REFER TO SHOP DRAWINGS, KEF-1	208	60	3	X			10.6	3.8	3.0	DFA
	200.3	1	SUPPLY FAN	REFER TO SHOP DRAWINGS, KMAU-1 (MAU)	208	60	3	X			50.6	3.0		DFA
	202	1	FREEZER BASE, SELF-CONTAINED		115	60	1	X	5-20P		15.0	3.6	3/4	18
	202.1	1	GRIDDLE, HEAVY DUTY, GAS		120	60	1	X	5-15P		0.5			18
					208	60	1	X	6-15P		4.3	0.9	18	15 AMP BREAKER
	204	1	OVEN-STEAMER, COMBINATION, GAS		208	60	1	X	6-15P		4.3	0.9	48	15 AMP BREAKER
			WATER FILTER EQUIPMENT STAND											
	205	1	OVEN-STEAMER, COMBINATION, GAS		208	60	1				10.6	2.2	18	15 AMP BREAKER
			WATER FILTER SYSTEM											
	206	1	TILT SKILLET		120	60	1	X	5-15P		9.0			18
					115	60	1	X	5-15P		7.0	1.0	1/3	18
	207	1	FRYER BATTERY, DEEP FAT, GAS W/FILTER		115	60	1	X	5-15P		2.0			18
	208	1	FREEZER, REACH-IN, LEFT HINGE		120	60	1	X	5-15P		7.6	1/2	84	
	300	1	REFRIGERATOR, REACH-IN		120	60	1	X	5-15P		5.9	1/4	84	
	303	1	REFRIGERATOR, UNDERCOUNTER		115	60	1	X	5-15P		2.5	1/5	18	
	304	1	SLICER, FOOD		115	60	1	X	5-15P		2.5	1/4	18	
	402	2	REFRIGERATOR, REACH-IN		120	60	1	X	5-15P		8.1	1/3	84	
	404	1	DROP-IN, COLD PAN		120	60	1	X	5-15P		3.7	1/4		INSTALLED IN TABLE ITEM No. 403
	406	1	DROP-IN, HOT WELLS NARROW		120	60	1	X	5-20P		17.0	2.0		INSTALLED IN TABLE ITEM No. 405
	406.1	1	DROP-IN, HOT WELLS		115	60	1	X	5-15P		8.3	1.0		INSTALLED IN TABLE ITEM No. 405
	408	2	VACUUM PACKAGING MACHINE		110-120	60	1	X	5-15P		9.5	3/4		TABLE SURFACE MOUNTED OUTLET
	501	1	REFRIGERATOR, WORKTOP		115	60	1	X	5-15P		2.5	1/5	18	
	502	1	DOUGH DIVIDER/ROUNDER		115	60	1	X	5-15P		7.5	3/4	18	
	503	1	DOUGH DIVIDER		115	60	1				--		18	AMPS TO BE DETERMINED
	504	2	MIXER, SPIRAL		208	60	3	X			34.5	6.0	18	
	505	1	WATER METER		115	60	1	X	5-15P		1.0		72	
	700	4	CABINET, MOBILE, WARMING & HOLDING		120	60	1	X	5-20P		16.0	1.9	78	
	701	2	REFRIGERATOR, REACH-IN		120	60	1	X	5-15P		8.1	1/3	84	
	801	6	PIZZA DOUGH PRESS		220	60	1	X			20.0	4.0	48	
	804	3	PIZZA OVEN		240	60	3	X	14-50R		50.0		48	
	806	3	REFRIGERATOR, PIZZA PREP		115	60	1	X	5-15P		7.4	1/3	18	
	902	1	WAREWASHER, DOOR TYPE, HIGH TEMP	W/BOOSTER HEATER	208	60	3	X			49.0		74	* JB @12" ABOVE FINISHED CEILING. CONNECTED TO NEMA-3R DISCONNECT SWITCH
	902.2	1	EXHAUST FAN	REFER TO SHOP DRAWINGS	115	60	1	X			--		TBD	INTER. W/ WAREWASHER, VREY W/SHOP DWGS
	907	1	ICE MAKER W/O BIN		208-230	60	1	X			11.8		48	20 AMP DEDICATED CIRCUIT
	CO	TBD	CONVENIENCE OUTLET (BY OTHERS)		115	60	1	X	5-15P		15.0		48	

CENTER STAGE EQUIPMENT SCHEDULE																
REVISION	ITEM NO	QTY	EQUIPMENT CATEGORY	MANUFACTURER	MODEL NUMBER	EQUIPMENT REMARKS	VOLTS	CYCLE	PHASE	DIRECT	CORD/PLUG	NEMA	AMPS	KW	HP	ELECTRICAL REMARKS
	A350	1	SERVICE ISLAND WITH GRANITE TOP (CBI CUSTOM)	CBI CUSTOM	CUSTOM FAB	REFER TO SHOP DRAWINGS WHEN AVAILABLE										
	A351	1	SINK, DROP-IN, HAND	JOHN BOOS & CO.	PB-DISINK282012											
	A352	2	RACK, HALF HEIGHT	CHANNEL MANUFACTURING	432A											
	A353	1	KETTLE, ELECTRIC, COUNTERTOP	CALICO COTTAGE / GROEN	TDB-8		120	60	1		X	5-15P	2.5			SURFACE MOUNT (TO BE VERIFIED)
	A354	2	OVEN, MICROWAVE	ACP, INC.	RCSS11DSE		230	50	1		X	5-15P	15.0	15.5		SURFACE MOUNT (TO BE VERIFIED)
	A355	1	REFRIGERATOR, UNDERCOUNTER	CONTINENTAL REFRIGERATOR	SW36N-FB		115	60	1		X	5-15P	2.5		18	
	A356	2	BLENDING POT	GOLD MEDAL PRODUCTS CO.	2703-00-0000		120	60	1		X	5-15P	3.1	3.8		SURFACE MOUNT (TO BE VERIFIED)
	A357	1	TWIN KETTLE PRO PLANT STAND	GOLD MEDAL PRODUCTS CO.	2791-00-101											
	A358	1	CORNADO POPPING UNIT	GOLD MEDAL PRODUCTS CO.	2410-00-210	INSTALLED RIGHT SIDE	120/208	60	1		X	L14-30P	30.0	54.0		SURFACE MOUNT (TO BE VERIFIED)
	A359	1	CORNADO POPPING UNIT	GOLD MEDAL PRODUCTS CO.	2410-00-200	INSTALLED LEFT SIDE	120/208	60	1		X	L14-30P	30.0	54.0		SURFACE MOUNT (TO BE VERIFIED)
	A360	1	SLIDE-OUT SHELF (CBI CUSTOM)	CBI CUSTOM	CUSTOM FAB	REFER TO SHOP DRAWINGS WHEN AVAILABLE										
	A360	1	HEAT HOOD	CBI CUSTOM	CUSTOM FAB	REFER TO SHOP DRAWINGS WHEN AVAILABLE										
	B300	1	SERVICE ISLAND WITH GRANITE TOP (CBI CUSTOM)	CBI CUSTOM	CUSTOM FAB	REFER TO SHOP DRAWINGS WHEN AVAILABLE										
	B301	3	NUT ROASTER	CALICO COTTAGE	EPB000043		120	60	1		X	5-20P	15.0	18.0		SURFACE MOUNT (TO BE VERIFIED)
	B302	2	OVEN, MICROWAVE	ACP, INC.	RCSS11DSE		230	50	1		X	5-15P	15.0	15.5		SURFACE MOUNT (TO BE VERIFIED)
	B303	3	REFRIGERATOR, UNDERCOUNTER	CONTINENTAL REFRIGERATOR	SW36N-FB		115	60	1		X	5-15P	2.5		1/5	18
	B304	2	RACK, HALF HEIGHT	CHANNEL MANUFACTURING	430A											
	B305	1	KETTLE, ELECTRIC, COUNTERTOP	CALICO COTTAGE / GROEN	TDB-8		120	60	1		X	5-15P	2.5			SURFACE MOUNT (TO BE VERIFIED)
	B306	2	SINK, DROP-IN, HAND	JOHN BOOS & CO.	PB-DISINK282012											
	B307	1	SLIDE-OUT SHELF (CBI CUSTOM)	CBI CUSTOM	CUSTOM FAB	REFER TO SHOP DRAWINGS WHEN AVAILABLE										
	B308	2	BLENDING POT	GOLD MEDAL PRODUCTS CO.	2703-00-0000		120	60	1		X	5-15P	3.1	3.8		SURFACE MOUNT (TO BE VERIFIED)
	C250	1	SERVICE ISLAND WITH GRANITE TOP	CBI CUSTOM	CUSTOM FAB	REFER TO SHOP DRAWINGS WHEN AVAILABLE										
	C251	1	LABEL PRINTING SCALE	PENN SCALE	CL5500B-30		100-240	60	1		X	TBD	4.0			SURFACE MOUNT (TO BE VERIFIED)
	C252	2	RACK, HALF HEIGHT	CHANNEL MANUFACTURING	430A											
	D200	1	SERVICE ISLAND WITH GRANITE TOP	CBI CUSTOM	CUSTOM FAB	REFER TO SHOP DRAWINGS WHEN AVAILABLE										
	D201	1	LABEL PRINTING SCALE	PENN SCALE	CL5500B-30		100-240	60	1		X	TBD	4.0			SURFACE MOUNT (TO BE VERIFIED)
	D202	2	RACK, HALF HEIGHT	CHANNEL MANUFACTURING	430A											
	E450	1	SERVICE ISLAND WITH GRANITE (CBI CUSTOM)	CBI CUSTOM	CUSTOM FAB	REFER TO SHOP DRAWINGS WHEN AVAILABLE										
	E451	1	LABEL PRINTING SCALE	PENN SCALE	CL5500B-30		100-240	60	1		X	TBD	4.0			SURFACE MOUNT (TO BE VERIFIED)
	F400	1	SERVICE ISLAND GRANITE TOP (BY OTHERS)	CBI CUSTOM	CUSTOM FAB	REFER TO SHOP DRAWINGS WHEN AVAILABLE										
	F401	1	LABEL PRINTING SCALE	PENN SCALE	CL5500B-30		100-240	60	1		X	TBD	4.0			SURFACE MOUNT (TO BE VERIFIED)
	F402	2	CONVECTION OVEN	WISCO INDUSTRIES, INC.	621		115	60	1		X	5-15P	10.9		13.0	SURFACE MOUNT (TO BE VERIFIED)
	G100	2	DISPLAY CASE, REFRIGERATED (SIZE TO BE DETERMINED)	FEDERAL INDUSTRIES	TO BE DETERMINED		115	60	1		X	5-15P	12.0		1/2	18
	G101	2	DISPLAY CASE, REFRIGERATED (SIZE TO BE DETERMINED)	FEDERAL INDUSTRIES	TO BE DETERMINED		115	60	1		X	5-15P	12.0		1/2	18
	G102	2	AMBIENT CASE (SIZE TO BE DETERMINED)	FEDERAL INDUSTRIES	TO BE DETERMINED		115	60	1		X	5-15P	7.0		18	
	G103	2	AMBIENT CASE (SIZE TO BE DETERMINED)	FEDERAL INDUSTRIES	TO BE DETERMINED		115	60	1		X	5-15P	7.0		18	
	G104	-	SPARE NUMBER													
	G105	-	SPARE NUMBER													
	G106	2	3 SECTION ELITE STORAGE CABINET	GOD METAL PRODUCTS CO	2687-00-030		120	60	1		X	5-15P	13.0		0.9	15 AMP DED. CIR. / SURFACE MOUNT (TO BE VER.)
	G107	1	MILLWORK SALES COUNTER W/ GRANITE TOP (BY OTHERS)	BY OTHERS	BY OTHERS	REFER TO ARCH. DRAWINGS WHEN AVAILABLE										
	G108	1	MILLWORK SALES COUNTER W/ GRANITE TOP (BY OTHERS)	BY OTHERS	BY OTHERS	REFER TO ARCH. DRAWINGS WHEN AVAILABLE										
	G109	1	MILLWORK SALES COUNTER W/ GRANITE TOP (BY OTHERS)	BY OTHERS	BY OTHERS	REFER TO ARCH. DRAWINGS WHEN AVAILABLE										
	G110	1	MILLWORK SALES COUNTER W/ GRANITE TOP (BY OTHERS)	BY OTHERS	BY OTHERS	REFER TO ARCH. DRAWINGS WHEN AVAILABLE										
	G111	1	MILLWORK SALES COUNTER W/ GRANITE TOP (BY OTHERS)	BY OTHERS	BY OTHERS	REFER TO ARCH. DRAWINGS WHEN AVAILABLE										
	G112	1	MILLWORK SALES COUNTER W/ GRANITE TOP (BY OTHERS)	BY OTHERS	BY OTHERS	REFER TO ARCH. DRAWINGS WHEN AVAILABLE										
	G113	1	MILLWORK SALES COUNTER W/ GRANITE TOP (BY OTHERS)	BY OTHERS	BY OTHERS	REFER TO ARCH. DRAWINGS WHEN AVAILABLE										
	G114	48	DROP-DOWN LIGHTING / FOOD WARMERS (BY OTHERS)	BY OTHERS	BY OTHERS	REFER TO M.E.P. DRAWINGS WHEN AVAILABLE										DATA SUPPLIED BY OTHERS
	CO	TBD	CONVENIENCE OUTLET	BY OTHERS	BY OTHERS	REFER TO ARCH. DRAWINGS WHEN AVAILABLE	120	60	1		X	5-15P	15.0			SURFACE MOUNT (TO BE VERIFIED)



EQUIPMENT SCHEDULE									
Type	Mark	Count	Description	MFR/ Model No.	Owner Provided	Contractor Provided	Owner Installed	Contractor Installed	Comments
E01	2	Countertop Ice Machine	Follett - Symphony Plus / 12CI425A-S		Yes	No	Yes	No	
E02	4	Iced Tea Brewer	Bunn / TB6Q		Yes	No	Yes	No	
E03	2	Cappuccino Machine	Curtis / PCGT3		Yes	No	Yes	No	
E04	6	Bean to Cup Coffee	Curtis / Schoerer Soul C		Yes	No	Yes	No	
E05	2	Coffee Brewer	Curtis / G4 GemX Intellifresh Coffee Brewer		Yes	No	Yes	No	
E06	3	Soda Machine	Multiplex / MDH-402 Beverage Dispenser		Yes	No	Yes	No	
E07	4	ICEE Machine	ICEE / Frozen Carbonated Beverage Dispenser 774 4B		Yes	No	Yes	No	
E08	4	Cold Food Drop-In Well	Alto-Shaam 100-CW Series		Yes	No	Yes	No	

EQUIPMENT STARTERS AND DISCONNECTS

ALL REPORTS, SPECIFICATIONS, COMPUTER FILES, RED DATA, AND OTHER DOCUMENTATION PREPARED BY KASPER ARCHITECTURE & DEVELOPMENT, INC. (KAD) AS INSTRUMENTS OF SERVICE SHALL REMAIN THE PROPERTY OF KAD. KAD SHALL RETAIN ALL COMMON LAW, STATUTORY, AND OTHER RESERVED RIGHTS, INCLUDING THE COPYRIGHT THEREIN. THIS DRAWING SHALL NEVER BE REPRODUCED IN WHOLE OR IN PART WITHOUT THE EXPRESS WRITTEN PERMISSION OF KAD.

LIGHTING SYSTEMS COMMISSIONING REQUIREMENTS

LIGHTING CONTROL SYSTEM SHALL UNDERGO FUNCTIONAL TESTING AS DESCRIBED BELOW. TESTING SHALL BE BY THE CONTRACTOR UNDER THE SUPERVISION OF A CERTIFIED REPRESENTATIVE OF THE LIGHTING CONTROL SYSTEMS MANUFACTURER(S).

PRIOR TO PASSING FINAL INSPECTION, THE LIGHTING CONTROL SYSTEMS SHALL HAVE BEEN TESTED TO ENSURE THAT CONTROL HARDWARE AND SOFTWARE ARE CALIBRATED, ADJUSTED, PROGRAMMED AND IN PROPER WORKING CONDITION IN ACCORDANCE WITH THE CONSTRUCTION DOCUMENTS AND MANUFACTURER'S INSTRUCTIONS. THE CONTRACTOR SHALL SUBMIT A LETTER CERTIFYING THE SUCCESSFUL COMPLETION OF FUNCTIONAL TESTING TO THE ENGINEER AT LEAST 2 DAYS PRIOR TO FINAL INSPECTION. THIS CERTIFICATION LETTER MUST BE AVAILABLE TO THE INSPECTOR AT THE TIME OF FINAL INSPECTION.

OCCUPANT SENSOR CONTROLS

1. CERTIFY THAT THE OCCUPANT SENSORS HAVE BEEN LOCATED AND AIMED FOR PROPER COVERAGE OF THE INTENDED AREA IN ACCORDANCE WITH MANUFACTURER RECOMMENDATIONS.

2. FOR PROJECTS WITH SEVEN OR FEWER OCCUPANT SENSORS, EACH SENSOR SHALL BE TESTED.

3. FOR PROJECTS WITH MORE THAN SEVEN OCCUPANT SENSORS, TESTING SHALL BE DONE FOR EACH UNIQUE COMBINATION OF SENSOR TYPE AND SPACE GEOMETRY. WHERE MULTIPLES OF EACH UNIQUE COMBINATION OF SENSOR TYPE AND SPACE GEOMETRY ARE PROVIDED, NOT LESS THAN 10 PERCENT, BUT IN NO CASE LESS THAN ONE, OF EACH COMBINATION SHALL BE TESTED UNLESS THE CODE OFFICIAL REQUIRES A HIGHER PERCENTAGE TO BE TESTED. WHERE 30 PERCENT OR MORE OF THE TESTED CONTROLS FAIL, ALL REMAINING IDENTICAL COMBINATIONS SHALL BE TESTED.

FOR OCCUPANT SENSOR CONTROLS TO BE TESTED, VERIFY THE FOLLOWING:

1. WHERE OCCUPANT SENSOR CONTROLS INCLUDE STATUS INDICATORS, VERIFY CORRECT OPERATION.

2. THE CONTROLLED LIGHTS TURN OFF OR DOWN TO THE PERMITTED LEVEL WITHIN THE REQUIRED TIME.

3. FOR AUTO-ON OCCUPANT SENSOR CONTROLS, THE LIGHTS TURN ON TO THE PERMITTED LEVEL WHEN AN OCCUPANT ENTERS THE SPACE.

4. FOR MANUAL-ON OCCUPANT SENSOR CONTROLS, THE LIGHTS TURN ON ONLY WHEN MANUALLY ACTIVATED.

5. THE LIGHTS ARE NOT INCORRECTLY TURNED ON BY MOVEMENT IN ADJACENT AREAS OR BY HVAC OPERATION.

TIME-SWITCH CONTROLS

1. CONFIRM THAT THE TIME-SWITCH CONTROL IS PROGRAMMED WITH ACCURATE WEEKDAY, WEEKEND AND HOLIDAY SCHEDULES.

2. PROVIDE DOCUMENTATION TO THE OWNER OF TIME-SWITCH CONTROLS PROGRAMMING INCLUDING WEEKDAY, WEEKEND, HOLIDAY SCHEDULES, AND SET-UP AND PREFERENCE PROGRAM SETTINGS ARE AS DIRECTED BY THE OWNER.

3. VERIFY THE CORRECT TIME AND DATE IN THE TIME SWITCH.

4. VERIFY THAT ANY BATTERY BACK-UP IS INSTALLED AND ENERGIZED.

5. VERIFY THAT THE OVERRIDE TIME LIMIT IS SET TO NOT MORE THAN 2 HOURS (OR KEY SWITCH OVERRIDE PROVISION IN RETAIL APPLICATIONS).

6. SIMULATE OCCUPIED CONDITION. VERIFY AND DOCUMENT THE FOLLOWING:

a. ALL LIGHTS CAN BE TURNED ON AND OFF BY THEIR RESPECTIVE AREA CONTROL SWITCH.

b. THE SWITCH ONLY OPERATES LIGHTING IN THE ENCLOSED SPACE IN WHICH THE SWITCH IS LOCATED.

7. SIMULATE NOCUPPIED CONDITION. VERIFY AND DOCUMENT THE FOLLOWING:

a. NONEXEMPT LIGHTING TURNS OFF.

b. MANUAL OVERRIDE SWITCH ALLOWS ONLY THE LIGHTS IN THE ENCLOSED SPACE WHERE THE OVERRIDE SWITCH IS LOCATED TO TURN ON OR REMAIN ON UNTIL THE NEXT SCHEDULED SHUTOFF OCCURS.

DAYLIGHT RESPONSIVE CONTROLS

1. CONTROL DEVICES HAVE BEEN PROPERLY LOCATED, FIELD CALIBRATED AND SET FOR ACCURATE SETPOINTS AND THRESHOLD LIGHT LEVELS.

2. DAYLIGHT CONTROLLED LIGHTING LOADS ADJUST TO LIGHT LEVEL SET POINTS IN RESPONSE TO AVAILABLE DAYLIGHT.

3. THE LOCATIONS OF CALIBRATION ADJUSTMENT EQUIPMENT ARE READILY ACCESSIBLE ONLY TO AUTHORIZED PERSONNEL.

EXTERIOR LIGHTING CONTROLS

1. PHOTOCELL SENSORS HAVE BEEN PROPERLY LOCATED, FIELD CALIBRATED AND SET FOR ACCURATE SETPOINTS AND THRESHOLD LIGHT LEVELS.

2. TIME SWITCH CONTROL AS DESCRIBED ABOVE.

3. AFTER-HOURS LIGHTING LEVEL REDUCTION IS IMPLEMENTED IN ACCORDANCE WITH THE OWNER'S SCHEDULE DIRECTION (EITHER FROM MIDNIGHT TO 6AM OR, FROM ONE HOUR AFTER TO ONE HOUR PRIOR TO BUSINESS HOURS.)

4. THE LOCATIONS OF CALIBRATION ADJUSTMENT EQUIPMENT ARE READILY ACCESSIBLE ONLY TO AUTHORIZED PERSONNEL.

AS-BUILT DOCUMENTATION

DOCUMENTS CERTIFYING THAT THE INSTALLED LIGHTING CONTROLS MEET THE DOCUMENTED PERFORMANCE CRITERIA OF FBC ENERGY CODE SECTION C405 SHALL BE PROVIDED IN THE PROJECT AS-BUILT DOCUMENTATION. DELIVERY OF AS-BUILT DOCUMENTATION SHALL BE PROVIDED TO THE BUILDING OWNER WITHIN 30 DAYS FROM THE DATE OF RECEIPT OF THE CERTIFICATE OF OCCUPANCY.

LUMINAIRE SCHEDULE

TAG	DESCRIPTION	MANUFACTURER	CATALOG NUMBER	VOLTS	TYPE	LUMENS	WATTS	NOTES
E	BACKLIT PANEL 2X4, 6000 lm, 4000K, 80 CRI UNV	LSI	ABP24 FS1 UNV	120-277	LED	6000	48.0	
E1	BACKLIT PANEL 2X2, 3125 lm, 4000K, 80 CRI UNV	LSI	ABP22 FS1 UNV	120-277	LED	3000	25.0	
F3WF	LED FLOOD LIGHT, 16000 lm, 4000K UNV,	LSI	TLFL 16L F UNV 40 KN	120-277	LED	16000	121.0	
P1	LED HIGH BAY LIGHT, 8000 lm, 4000K	VANTAGE LIGHTING	AGV BLED16 80	120-277	LED	8000	85.2	
R1A	LENSED, LED DOWN LIGHT, 1100 lm	VANTAGE LIGHTING	ABVEFLED U 11	120-277	LED	1100	15.4	
R1B	LENSED, LED DOWN LIGHT, 2000 lm	VANTAGE LIGHTING	ABVEFLED U 20	120-277	LED	2000	27.2	
R1C	LENSED, LED DOWN LIGHT, 3000 lm	VANTAGE LIGHTING	ABVEFLED U 30	120-277	LED	3000	33.5	
R1D	LENSED, LED DOWN LIGHT, 2000 lm	VANTAGE LIGHTING	ABVEFLED U 20	120-277	LED	2000	27.2	
R2	SURFACESLICE DOWN LIGHT, 1000 lm	SPRING LIGHTING GROUP	DS SR LS10 G2 UNV 0FSK	120-277	LED	1000	16.3	
R3	4 INCH WIDE RECESSED LIGHT, 600 lm, FROSTED DIFFUSE	LSI	4RLS X LED 06L LF UE	120-277	LED	600	5.7	1
S4	STRIP FIXTURE, 2831 lm, 4000K	LSI	AST X FS SPD UNC TCH10	120-277	LED	2831	20.0	1
S8	STRIP FIXTURE, 2061 lm, 4000K	LSI	AST X FS SPD UNC TCH10	120-277	LED	2061	15.0	1
X	VALUE-SERIES EXIT SIGN UNIVERSAL MOUNT EDGE-LIT LED	LSI	VE U 6 R/G U WB SD2	120-277	LED	N/A	5.0	
KEY NOTES				GENERAL NOTES				
1. SEE PLANS FOR FIXTURE LENGTH.				A				
2				B				
3				C				
4				D				
5				H				

SITE LUMINAIRE SCHEDULE

TAG	QTY	DESCRIPTION	MANUFACTURER	CATALOG NUMBER	VOLTS	TYPE	LUMENS	TOTAL FIXTURE WATTS	NOTES
A	4	LED AREA LIGHT, DIE-CAST ALUMINUM HOUSING, ACRYLIC OPTICS, INTEGRAL SHIELD, IP 66 RATED, FINISH SELECTED BY ARCHITECT.	LSI	VALM-42L-3W-40K8-1S	120-277	LED	27157	1044	Lumens value is per fixture head Each fixture head is 261W
P33	47	LED AREA LIGHT, DIE-CAST ALUMINUM HOUSING, ACRYLIC OPTICS, INTEGRAL SHIELD, IP 66 RATED, 3000K, FINISH SELECTED BY ARCHITECT.	LSI	VALS-12L-3W-30K8-1S	120-277	LED	7627	74	
P34	5	LED AREA LIGHT, DIE-CAST ALUMINUM HOUSING, ACRYLIC OPTICS, IP 66 RATED, FINISH SELECTED BY ARCHITECT.	LSI	VALS-12-4F-40K8	120-277	LED	9852	74	
P35	38	LED 2-HEADED AREA LIGHT, DIE-CAST ALUMINUM HOUSING, ACRYLIC OPTICS, IP 66 RATED, FINISH SELECTED BY ARCHITECT.	LSI	VALS-12-4F-40K8	120-277	LED	9852	148	Lumens value is per fixture head Each fixture head is 74W
GENERAL NOTES									
A. 4000K STANDARD UNLESS OTHERWISE NOTED.									




10175 Fortune Parkway, Suite 701
Jacksonville, FL 32254
p 904.683.9201 f 904.683.9702

www.kasperarch.com
FL License No.: AA26000802



formerly McVeigh & Mangum Engineering
www.IMEGCorp.com
9133 R.G. Skinner Parkway
Jacksonville, Florida 32216
Ph: (904) 483-5200 Fax: (904) 484-7900
email: mail@McVeighMangum.com
CA 6380
Eng. of Record Thomas C. Nielsen
License No.: 53492

ALL DESIGN PRIOR TO 08/28/2025 WAS PERFORMED BY
IMEG UNDER THE RESPONSIBLE CHARGE OF
THOMAS C. NIELSEN, PE #53492.
ALL SUBSEQUENT DESIGN BY IMEG IS UNDER THE
RESPONSIBLE CHARGE OF BRIAN J. LEAVITT, PE #87733.

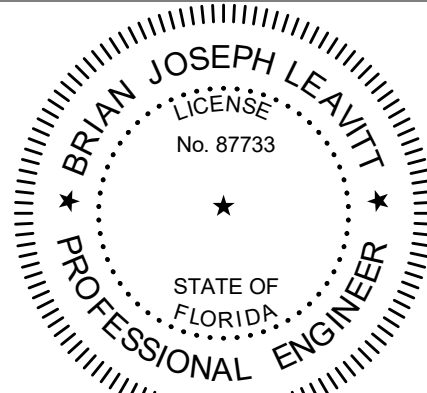

BUSY BEE
ELLISVILLE

136 SW WEBBS GLN
LAKE CITY, FL 32024

PROJECT NO.: 22024

DATE: 06/02/2025

PRIOR ISSUES:


106/24/2025 IASJ #1

LUMINAIRE
NOTES AND
SCHEDULE


E0.3

DRAWN BY: IMEG
CHECKED BY: IMEG

100%
CONSTRUCTION
DOCUMENTS

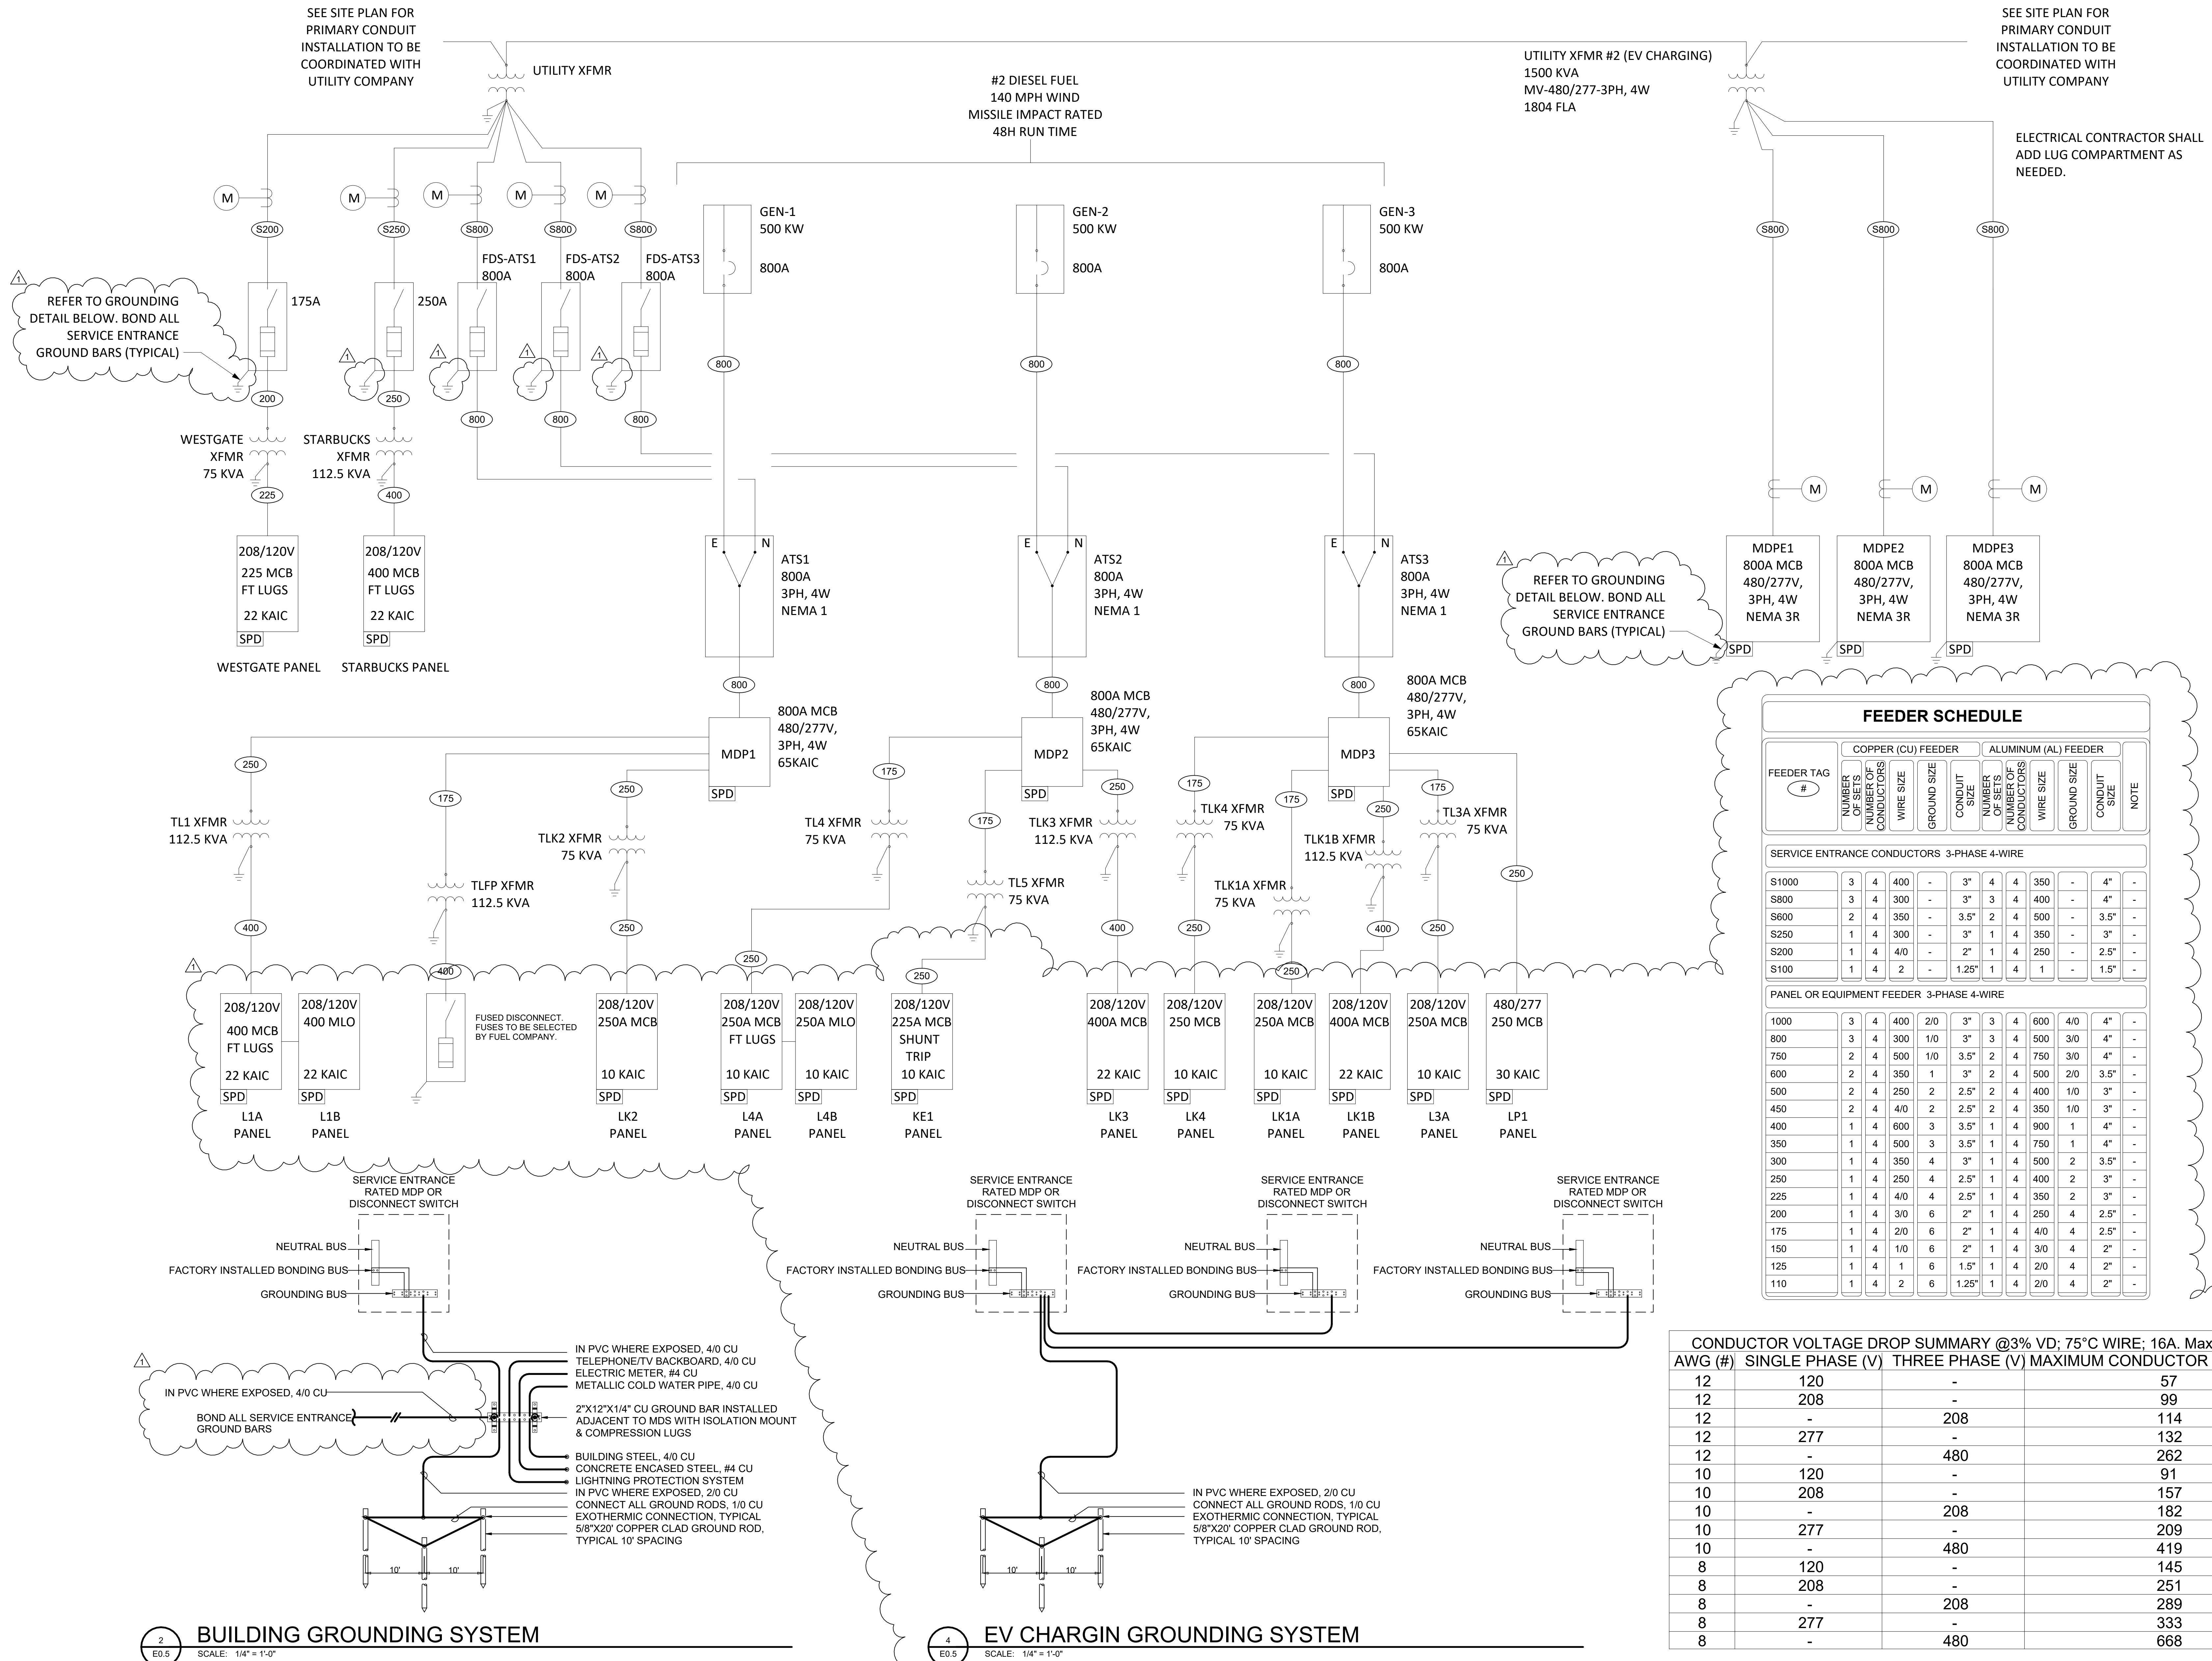

ALL REPORTS, SPECIFICATIONS, COMPUTER FILES, RED DATA, AND OTHER DOCUMENTATION PREPARED BY KASPER ARCHITECTS, A DEVELOPMENT, INC. (KAD) AS INSTRUMENTS OF SERVICE SHALL REMAIN THE PROPERTY OF KAD. KAD SHALL RETAIN ALL COMMON LAW, STATUTORY, AND OTHER RESERVED RIGHTS, INCLUDING THE COPYRIGHT THEREIN. THIS DRAWING SHALL NEVER BE REPRODUCED IN WHOLE OR IN PART WITHOUT THE EXPRESS WRITTEN PERMISSION OF KAD.

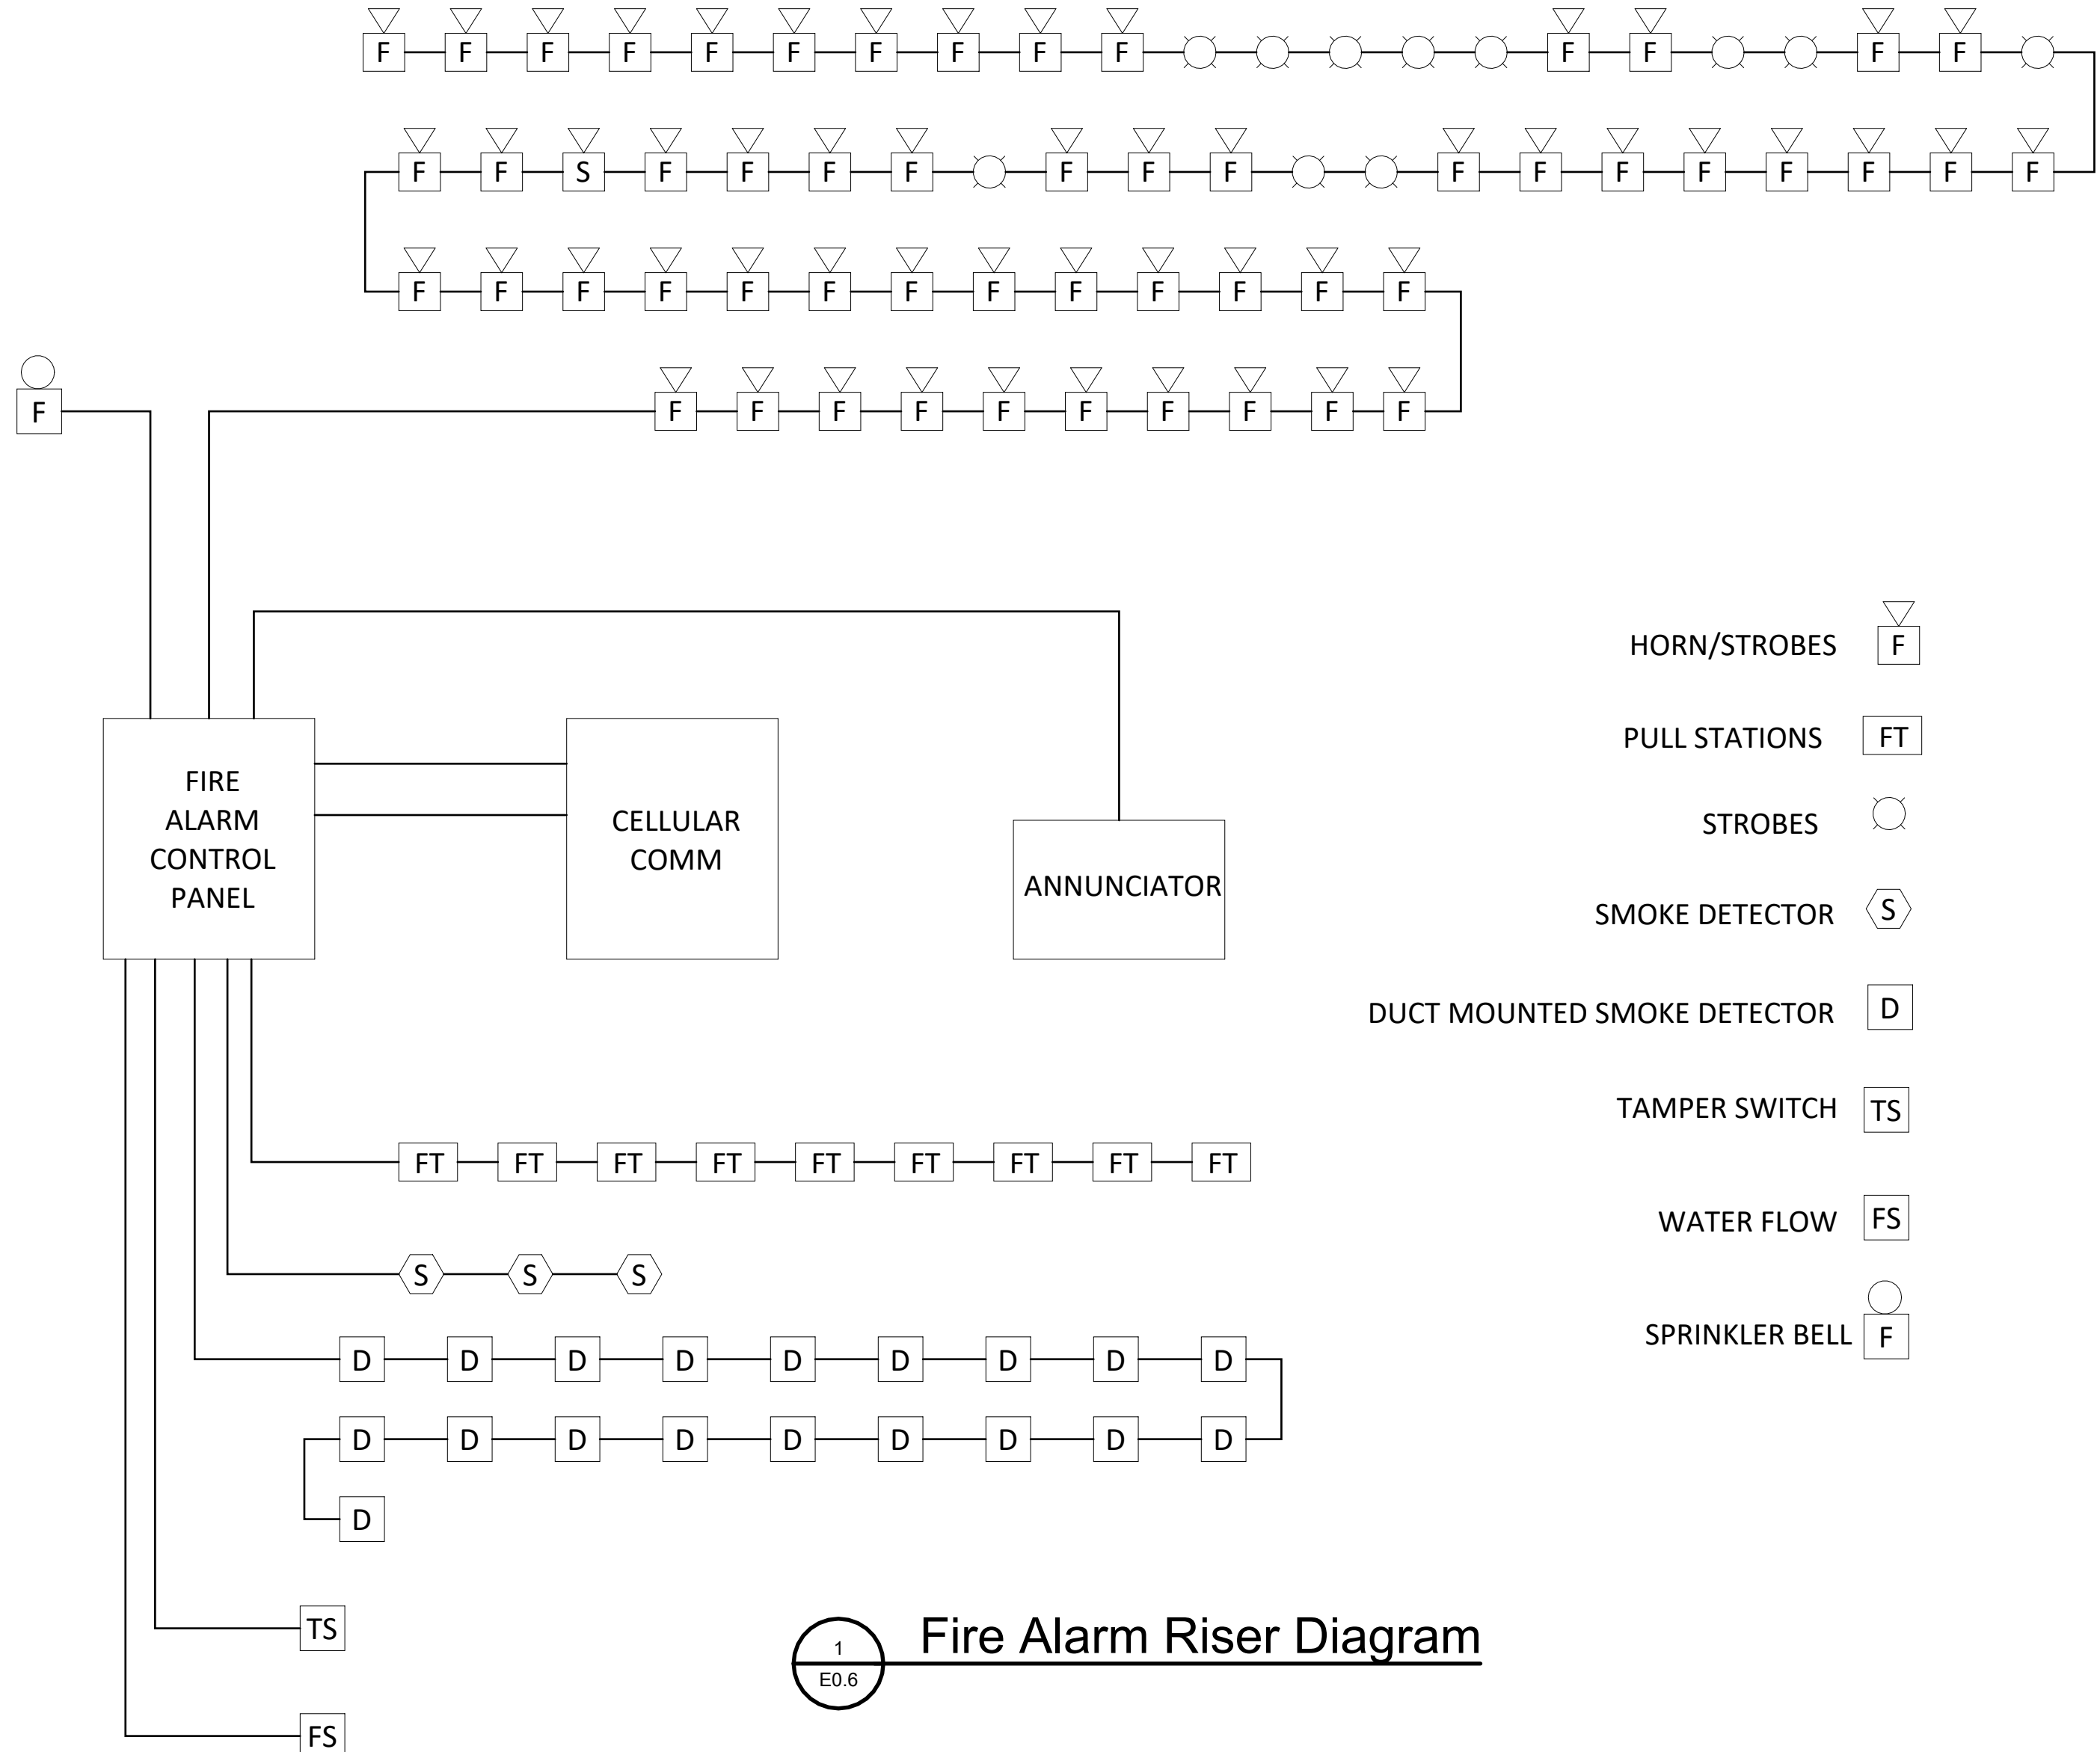

SEQUENCE OF OPERATION		PANEL/ANNUNCIATOR ALARM INDICATION	PANEL/ANNUNCIATOR SUPERVISORY INDICATION	PANEL/ANNUNCIATOR TROUBLE INDICATION	AUDIBLE ALARMS SEQUENCE	VISUAL ALARMS SEQUENCE	ELECTRIC SPRINKLER BELL SEQUENCE	ANY A MECHANICAL FAN SHUTDOWN SEQUENCE	RELEASE AGENT DISCHARGE SEQUENCE	LIGHTING CONTROL OVERRIDE SEQUENCE	ACCESS CONTROL OVERRIDE SEQUENCE
SYSTEM INPUTS											
FIRE ALARM PANEL, TRANSPONDER, NAC PANEL LOW BATTERY		X									
FIRE ALARM PANEL, TRANSPONDER, NAC PANEL BATTERY OR CHARGER FAILURE			X								
FIRE ALARM PANEL, TRANSPONDER, NAC PANEL ABNORMAL SWITCH OR CONTROL POSITION		X									
FIRE ALARM PANEL, TRANSPONDER, NAC PANEL GROUND FAULT, OPEN CIRCUIT, SHORT CIRCUIT			X								
FIRE ALARM PANEL, TRANSPONDER, NAC PANEL AC POWER LOSS OR IRREGULARITY			X								
NOTIFICATION APPLIANCE CIRCUIT OR SLC LOOP GROUND FAULT, OPEN CIRCUIT, SHORT CIRCUIT			X								
INITIATING DEVICE FAILURE OR COMMUNICATION ERROR			X								
FIRE ALARM PANEL MANUAL FIRE DRILL			X		X	X				X	X
MANUAL PULL STATION	FT FT	X			X	X		X		X	X
SMOKE DETECTOR	S# H# S# H#	X			X	X	X	X	X	X	X
HEAT DETECTOR	H# H# H# H#	X			X	X	X	X	X	X	X
SPRINKLER SYSTEM FLOW SWITCH	MM FS	X			X	X	X	X		X	X
SPRINKLER SYSTEM MONITOR SWITCH	MM TS pIV		X								
SMOKE DETECTOR FOR HVAC CONTROL	S# H# S# H#	X	X	X	X	X		X		X	X
KITCHEN HOOD SUPPRESSION SYSTEM ACTIVATION	MM	X	X	X	X	X					
RELEASE AGENT SYSTEM PANEL ALARM	MM	X			X	X	X	X	X	X	X
RELEASE AGENT SYSTEM PANEL TROUBLE	MM			X							
SPECIALTY DETECTOR (i.e., FLAME)	X	X			X	X	X	X		X	X

NOTES:

- ALL SYSTEM EVENTS SHALL BE LOGGED AND DISPLAYED ON THE ANNUNCIATOR INTERFACE, IF APPLICABLE.
- RELOCATION OF OCCUPANTS IS THE STANDARD OPERATING PROCEDURE FOR THIS FACILITY IN THE EVENT OF AN ALARM. THEREFORE, ALL NOTIFICATION APPLIANCE CIRCUITS MUST BE INSTALLED AND PROTECTED IN ACCORDANCE WITH THE CIRCUIT SURVIVABILITY REQUIREMENTS DESCRIBED IN NFPA 72.

KEYNOTES:

- UTILIZE A GENERAL PURPOSE RELAY TO MONITOR POWER LOSS. CONNECT THE CONTACTS OF THE RELAY TO A FIRE ALARM MONITOR MODULE.
- UTILIZE (2) GENERAL PURPOSE RELAYS AS SHOWN ON DRAWINGS WITH A COIL VOLTAGE THAT MATCHES THE MOTOR VOLTAGE TO MONITOR POWER LOSS. CONNECT EACH RELAY COIL TO ONE PHASE OF THE MOTOR FEEDER DOWNSTREAM OF THE DISCONNECTING MEANS, BUT AHEAD OF THE CONTROL CONTACTOR. CONNECT THE CONTACTS OF THE RELAYS IN SERIES TO A FIRE ALARM MONITOR MODULE.

FAC 61G15-32 FIRE PROTECTION (ALARM) CRITERIA
61G15-32-008
(1) OVERALL DESCRIPTION PROVIDE SUPERVISION OF WET-PIPE SPRINKLER SYSTEM VIA TAMPER AND FLOW SWITCHES. PROVIDE SUPERVISION OF THE FIRE ALARM CONTROL PANEL'S POWER FROM BOTH THE DEDICATED 120VAC LINE AND THE INTERNAL BATTERY LINE. PROVIDE ACTIVATION OF ALL DOOR LOCKS FOR SAFE EGRESS FROM THE BUILDING WHEN IN ALARM. PROVIDE ANNUNCIATION OF THE FIRE ALARM SYSTEM VIA AUDIBLE/VISUAL DEVICES LOCATED THROUGHOUT NORMALLY OCCUPIED SPACES.
(2) GOVERNING CODES THE FIRE ALARM SYSTEM SHALL MEET ALL OF THE REQUIREMENTS OF THE LATEST APPLICABLE EDITIONS OF THE FLORIDA BUILDING CODE, THE FLORIDA FIRE PREVENTION CODE, NFPA 72, ADA, AND ALL LOCAL, NATIONAL, AND INTERNATIONAL CODES. THE FIRE ALARM SYSTEM SHALL MEET ALL OF THE REQUIREMENTS OF THE LOCAL AUTHORITY HAVING JURISDICTION.
(3) MINIMUM SYSTEM REQUIREMENTS THE ENGINEERING DRAWINGS CONTAINED HEREIN IDENTIFY MINIMUM FIRE ALARM SYSTEM REQUIREMENTS. ALL FIRE ALARM SWITCHES, MODULES, AND WIRING SHALL BE PROVIDED BY THE FIRE ALARM SUB-CONTRACTOR. FIRE ALARM SYSTEM SUB-CONTRACTOR SHALL BE RESPONSIBLE TO SUBMIT DETAILED SYSTEM DRAWINGS, CUTSHEETS, WIRING DIAGRAMS, ETC. AS REQUIRED FOR FINAL PERMITTING.
(4) PLAN REQUIREMENTS MINIMUM SYSTEM REQUIREMENTS ARE SHOWN ON THE ENGINEERING DRAWINGS CONTAINED HEREIN: a. SYMBOLS LEGEND IS INDICATED ON E0.01a. SYSTEM RISER DIAGRAM WITH ALL INITIATION AND NOTIFICATION COMPONENTS AND CABLING REQUIREMENTS IS INDICATED IN DETAIL 10.06. THIS SHEET. ANY FIRE-RATED WALLS HAVE BEEN INDICATED BY LINE-TYPE OF THE WALLS ON THE ARCHITECTURAL PLANS. THE BUILDING IS A 1-STORY MIXED USE BUILDING AND IS APPROX. 40,000SF NEW CONSTRUCTION. b. LOCATIONS OF INITIATION AND NOTIFICATION DEVICES AND CONNECTIONS TO RELATED SYSTEMS ARE SHOWN IN PLAN 10E1.5. EXTERIOR BELL (OR OTHER AUDIBLE DEVICE) REQUIRED BY NFPA 13 SHALL BE PROVIDED AT LOCATION ACCEPTABLE TO THE FIRE MARSHAL. ADDITIONAL DEVICES SHALL BE INCLUDED IN THE BID AND PROVIDED AS DIRECTED BY THE FIRE MARSHAL. c. STROBE INTENSITY AND AUDIBLE OUTPUT RATINGS FOR ALL NOTIFICATION DEVICES ARE 75cd AND 90dBA, UON. STROBES MAY BE 15cd IN 20 FT WIDE OR NARROWER CORRIDORS. LOWER VISUAL INTENSITIES THAN 75cd ARE ALLOWED AS LONG AS THE ENTIRE NORMALLY OCCUPIED SPACE IS COVERED ACCORDING TO NFPA 72 VISUAL DEVICE CHARACTERISTICS. THE VISUAL AND AUDIBLE INTENSITY SHALL BE INCREASED WHERE REQUIRED FOR COMPLETE COVERAGE OF NORMALLY OCCUPIED SPACE. d. INITIATING DEVICE CIRCUITS, SIGNAL LINE CIRCUITS, AND NOTIFICATION APPLIANCE CIRCUITS SHALL BE CLASS B. e. THE ALARM SYSTEM SHALL RECEIVE INITIATION SIGNALS AND PROVIDE NOTIFICATION SIGNALS AS SHOWN IN THE FIRE ALARM RISER AND OPERATIONS MATRIX. THE TRANSMISSION OF EMERGENCY SIGNALS SHALL BE BY DUAL LINE TELEPHONE CONNECTION TO UL LISTED CENTRAL STATION. ALL ALARM, TROUBLE AND SUPERVISORY CONDITIONS SHALL BE TRANSMITTED TO THE CENTRAL STATION. f. THE FIRE ALARM SYSTEM TYPE SHALL BE ADDRESSABLE, 24VDC, POWER LIMITED, FULLY SUPERVISED, WITH 5 MINUTE ALARM, 24 HOUR STANDBY BATTERY SYSTEM. g. SURGE PROTECTIVE DEVICES SHALL BE LOCATED ON THE INCOMING AC POWER (ADJACENT TO OR WITHIN THE PANEL) AND THE POINT OF ENTRY TO THE BUILDING FOR ANY EXTERIOR CIRCUITS. h. THE FIRE ALARM CONTROL PANEL SHALL BE LOCATED IN 32°F TO 104°F NON-CONDENSING. ANY OUTDOOR NOTIFICATION DEVICES SHALL BE WEATHER PROOF. i. A SITE PLAN HAS BEEN PROVIDED ON E1.0. j. SMOKE DETECTION IS REQUIRED FOR THIS BUILDING AT THE FIRE ALARM CONTROL PANEL AND HVAC SYSTEMS OVER 2,000 CFM. k. SMOKE STRATIFICATION IS NOT APPLICABLE TO THIS CONSTRUCTION. l. THIS PERFORMANCE BASED CRITERIA SHALL PROVIDE THE BASIS OF DESIGN FOR THE FULL FIRE ALARM PERMIT DOCUMENTS AND MEET THE LOCAL AHJ'S REQUIREMENTS. NOTE THAT FIRE ALARM PLANS SUBMITTED HEREIN FOR BUILDING PERMIT ARE NOT PART OF THE FIRE ALARM PERMIT REVIEW. A SEPARATE SUBMITTAL AND PERMIT IS REQUIRED TO BE PROVIDED BY THE CONTRACTOR FOR THE FIRE ALARM SYSTEM MEETING ALL OF THE LOCAL AHJ'S REQUIREMENTS. IF REQUIRED BY THE AHJ, FIRE ALARM PERMIT DRAWINGS SHALL BE SIGNED AND SEALED BY 3RD PARTY PROFESSIONAL ENGINEER. m. THE CONSTRUCTION IS NOT HIGH-RISE OR MULTI-TENANT. THE ENTIRE BUILDING SHALL HAVE A GENERAL EVACUATION SIGNAL. n. WIRING FOR UNDERGROUND AND WET LOCATIONS SHALL BE AS RECOMMENDED BY THE MANUFACTURER. ANY EXTERIOR CIRCUITS SHALL BE INSTALLED IN CONDUIT, MINIMUM 18" BELOW GRADE WITH ORANGE WARNING TAPE ABOVE THE CONDUIT. o. SUBMIT OPERATION AND MAINTENANCE PROCEDURES AND MANUALS. VENDOR TO PROVIDE FULL OPERATION & MAINTENANCE MANUALS AND AS-BUILT PLANS FOR OWNER'S FUTURE USE. VENDOR TO SUBMIT TO OWNER PROPOSED CONTRACT FOR REQUIRED ANNUAL TESTING OF THE SYSTEM. A MINIMUM OF TWO, ONE-HOUR ON-SITE TRAINING SESSIONS FOR SYSTEM OPERATION SHALL BE PROVIDED TO THE OWNER.
(5) WIRING, BATTERY, VOLTAGE DROP RESPONSIBILITY: THE FIRE ALARM SHOP DRAWINGS SHALL INDICATE THE WIRING TO BE PROVIDED, BATTERY AND VOLTAGE DROP (CIRCUIT ANALYSIS) CALCULATIONS. THE CALCULATIONS SHALL APPLY THE MANUFACTURER'S DATA AND APPLICABLE NFPA 72 PROCEDURES.
(6) SYSTEM TEST REQUIREMENTS: VENDOR SHALL FULLY TEST AND CERTIFY THE FIRE ALARM SYSTEM DOCUMENTING PROPER FUNCTION OF ALL DEVICES, INTERLOCKS, PROGRAMMING AND COMMUNICATIONS PROVIDING A FIRE ALARM SYSTEM RECORD OF COMPLETION AS REQUIRED BY NFPA 72, CHAPTER 10.
(7) SPECIAL SYSTEM REQUIREMENTS: PROVIDE FIRE ALARM DOCUMENT CABINET ADJACENT TO MAIN FIRE ALARM PANEL. THERE ARE NO OWNER, INSURANCE UNDERWRITER, OR LOCAL FIRE CODE AMENDMENTS REQUIRED FOR THIS CONSTRUCTION.

Fire Alarm Criteria




10175 Fortune Parkway, Suite 701
Jacksonville, FL 32254
p 904.683.9201 f 904.683.9702
www.kasperarch.com
FL License No.: AA26000802



www.IMEGCorp.com
9133 E.G. Skinner Parkway
Jacksonville, Florida 32216
Ph: (904) 481-5200 Fax: (904) 416-6700
email: mail@McVeighMangum.com
CA 6330
Eng. of Record
License No.:

ALL DESIGN PRIOR TO 08/28/2025 WAS PERFORMED BY IMEG UNDER THE RESPONSIBLE CHARGE OF THOMAS C. NIELSEN, PE #53492. ALL SUBSEQUENT DESIGN BY IMEG IS UNDER THE RESPONSIBLE CHARGE OF BRIAN J. LEAVITT, PE #87733.

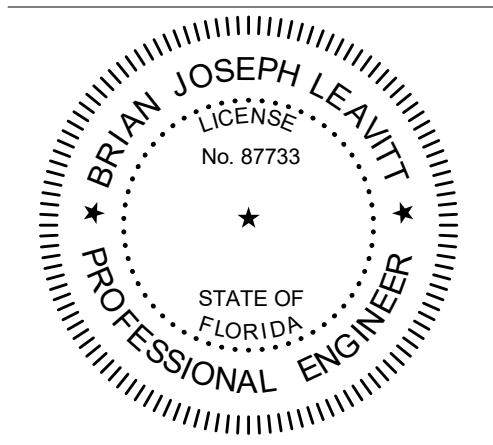

BUSY BEE
ELLISVILLE

136 SW WEBBS GLN
LAKE CITY, FL 32024

PROJECT NO.: 22024

DATE: 06/02/2025

PRIOR ISSUES:

10/24/2025 JAS:BT

FIRE ALARM RISER
DIAGRAM

E0.6

DRAWN BY: IMEG
CHECKED BY: IMEG

100%
CONSTRUCTION
DOCUMENTS




10175 Fortune Parkway, Suite 701
Jacksonville, FL 32256
p 904.683.9201 f 904.683.9702

www.kasperarch.com
FL License No.: AA26000802



formerly McVeigh & Mangum Engineering
www.IMEGCorp.com
9133 E.G. Skinner Parkway
Jacksonville, Florida 32216
Ph: (904) 483-5200 Fax: (904) 483-6700
email: mail@McVeighMangum.com
CA 6330
Eng. of Record
License No.:

ALL DESIGN PRIOR TO 08/20/2025 WAS PERFORMED BY
IMEG UNDER THE RESPONSIBLE CHARGE OF
THOMAS C. NIELSEN, PE #53492.
ALL SUBSEQUENT DESIGN BY IMEG IS UNDER THE
RESPONSIBLE CHARGE OF BRIAN J. LEAVITT, PE #87733.

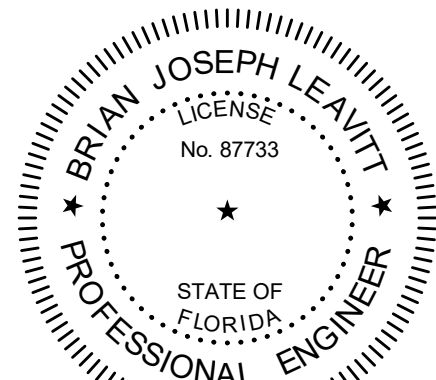

BUSY BEE
ELLISVILLE

136 SW WEBBS GLN
LAKE CITY, FL 32024

PROJECT NO.: 22024

DATE: 06/02/2025

PRIOR ISSUES:

106/24/2025 KAS #1

ELECTRICAL SITE
POWER PLAN

E1.0


DRAWN BY: IMEG
CHECKED BY: IMEG

100%
CONSTRUCTION
DOCUMENTS

© 2013


GENERAL NOTES:
A. COORDINATE WITH CIVIL AND VERIFY
LOCATIONS OF ALL EXISTING AND PROPOSED
UTILITIES PRIOR TO THE START OF WORK.
B. ALL CONDUITS UNDER PAVED AREAS TO BE CONCRETE
ENCASED.

KEY NOTES:
1. 8" X 8" 0" ROUND STEEL CONCRETE FILLED BOLLARDS
PAINTED D.O.T. YELLOW AND BURRIED 4'-0", TYPICAL.
2. PROVIDE 500KW STANDBY RATED GENERATORS WITH
WEATHERPROOF ENCLOSURE AND INTEGRAL TANK
SIZED FOR 48 HOUR RUNTIME. PROVIDE REMOTE
ANNUNCIATOR IN MAIN ELECTRICAL ROOM. PROVIDE ALL
CONTROL WIRING AND 120V CIRCUITS REQUIRED FOR
BATTERY CHARGER, INTERNAL LIGHTS, LOCAL
RECEPTACLE, AND BLOCK HEATER. COORDINATE PAD
REQUIREMENTS WITH GENERATOR SUPPLIER.
3. FUELING ISLAND POWER AND LIGHTING PROVIDED
UNDER SEPARATE CONTRACT.

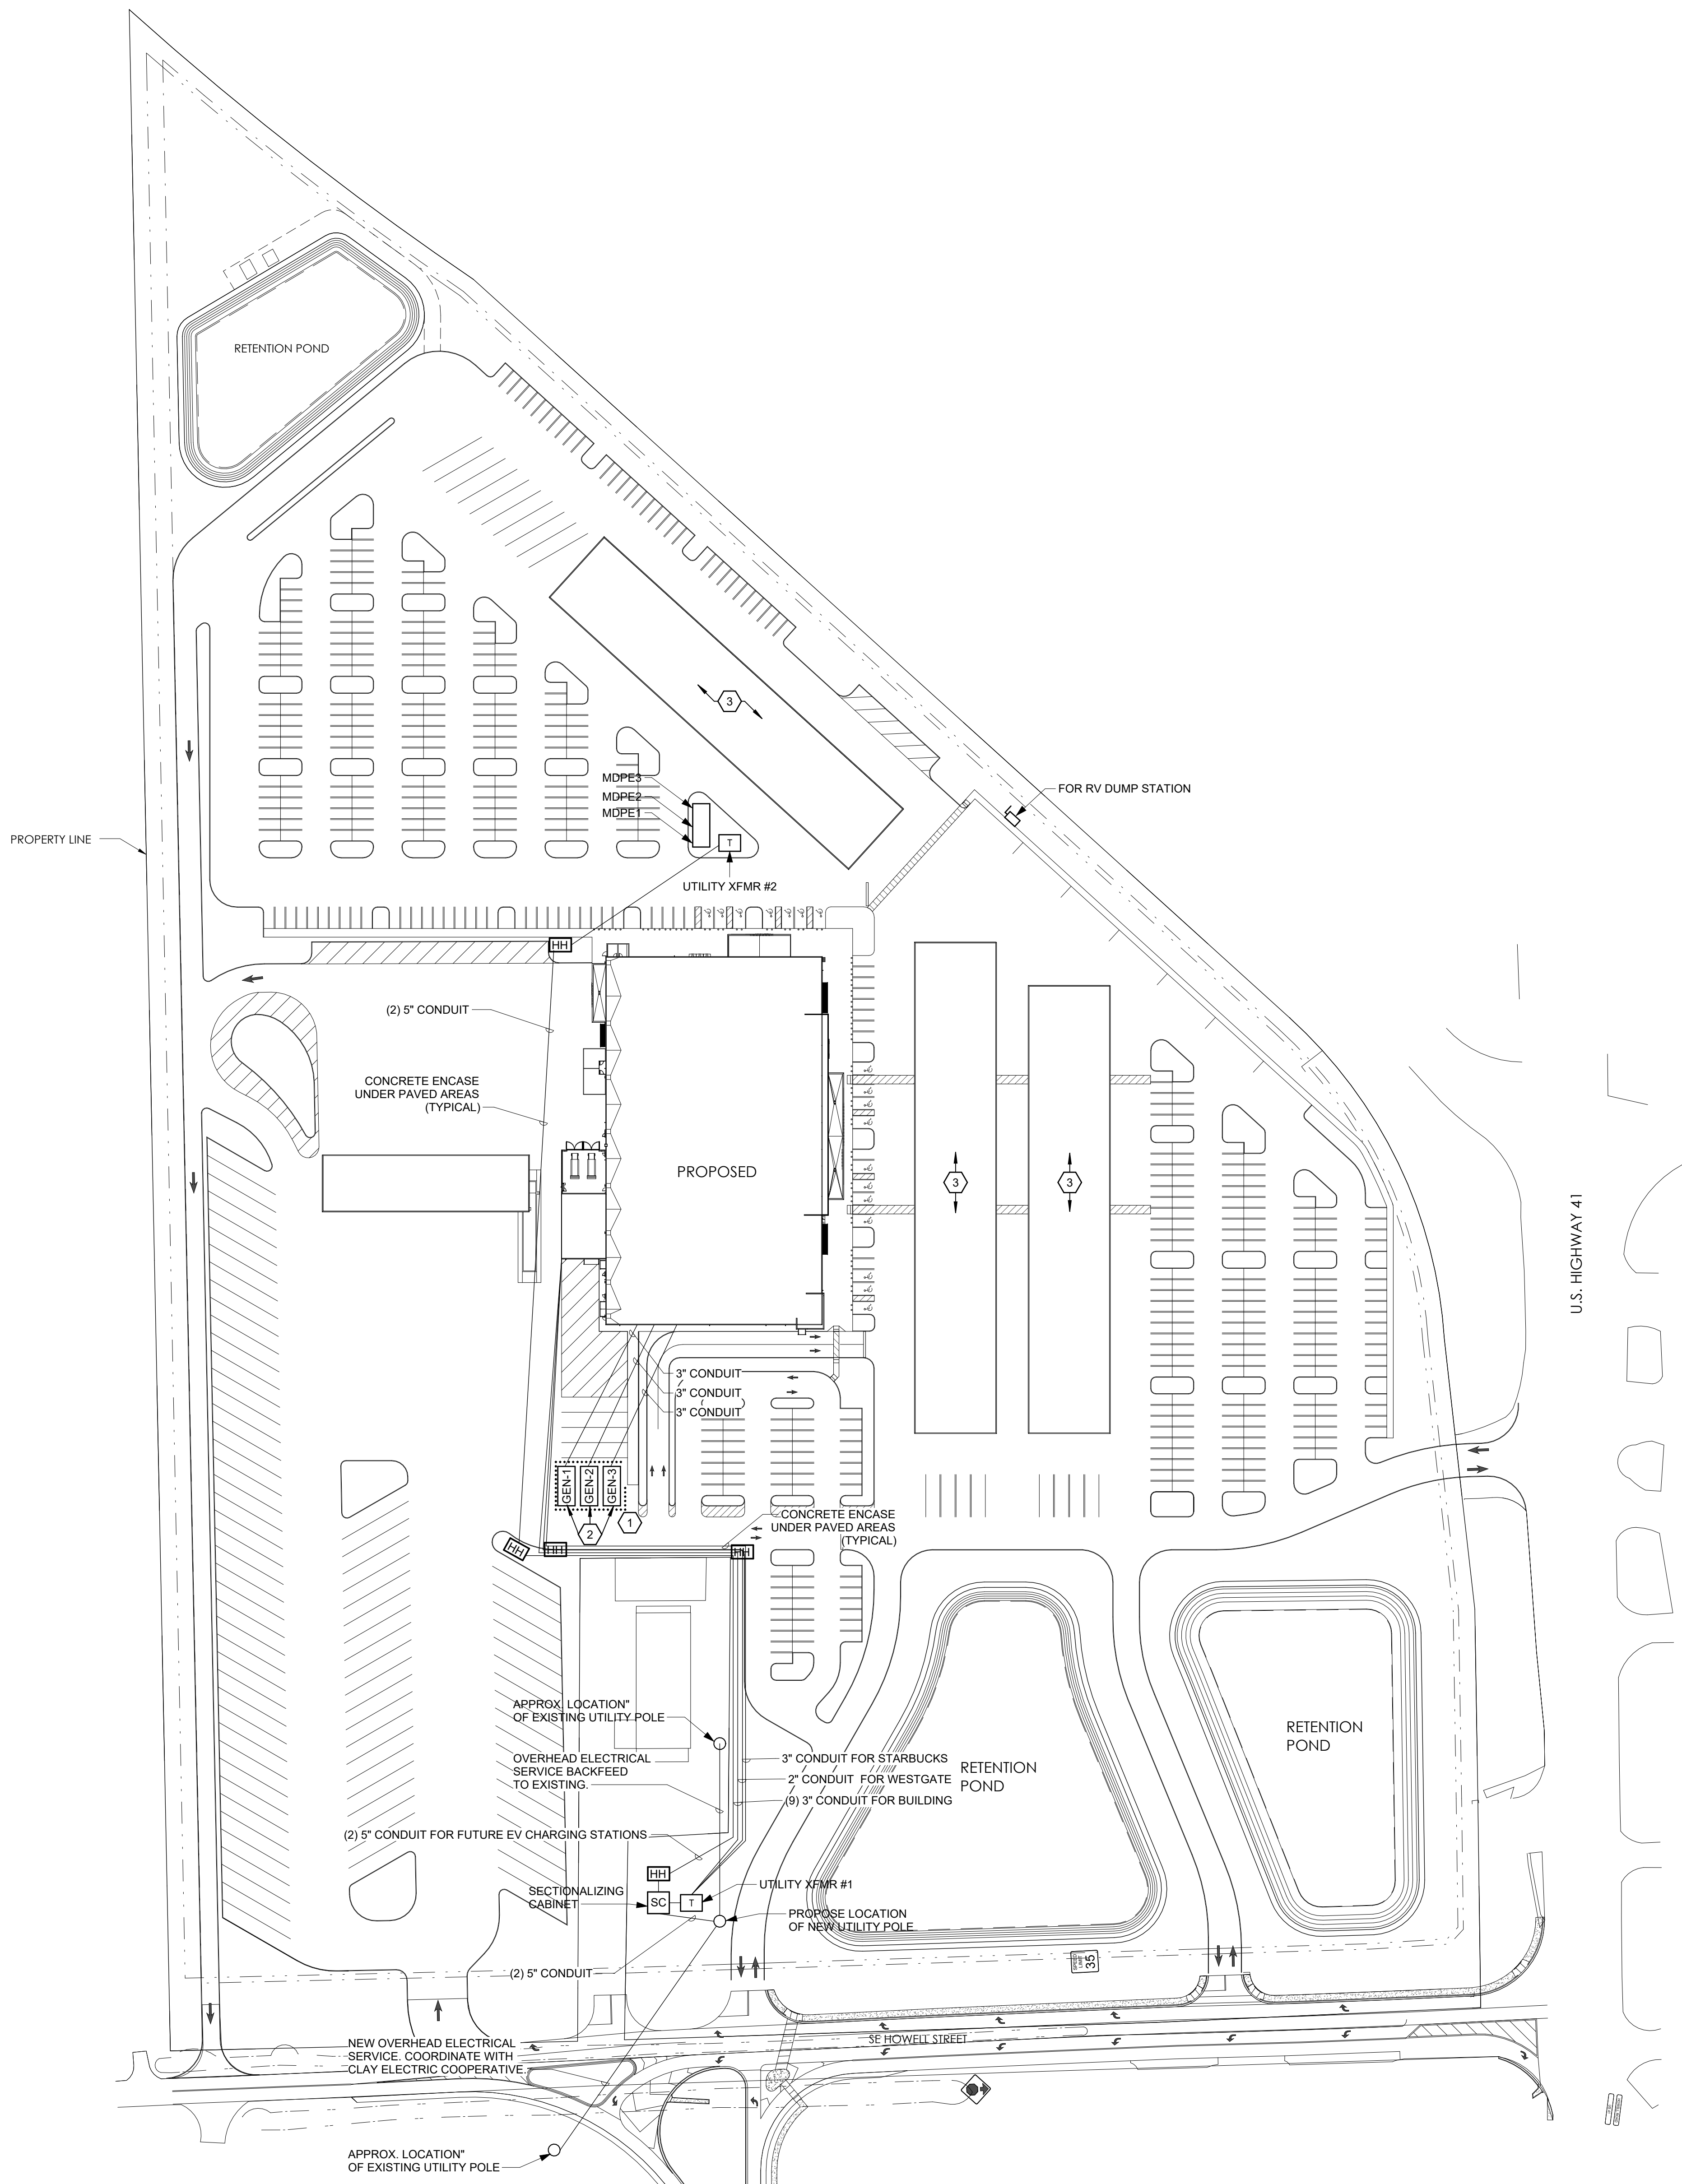

1
E1.0
ELECTRICAL SITE POWER PLAN
SCALE: 1" = 80'-0"

ALL REPORTS, SPECIFICATIONS, COMPUTER FILES, RED DATA, AND OTHER DOCUMENTATION PREPARED BY KASPER ARCHITECTS & DEVELOPMENT, INC. (KAD) AS INSTRUMENTS OF SERVICE SHALL REMAIN THE PROPERTY OF KAD. KAD SHALL RETAIN ALL COMMON LAW, STATUTORY AND OTHER RESERVED RIGHTS, INCLUDING THE COPYRIGHT THEREIN. THIS DRAWING SHALL NEVER BE REPRODUCED IN WHOLE OR IN PART WITHOUT THE EXPRESS WRITTEN PERMISSION OF KAD.

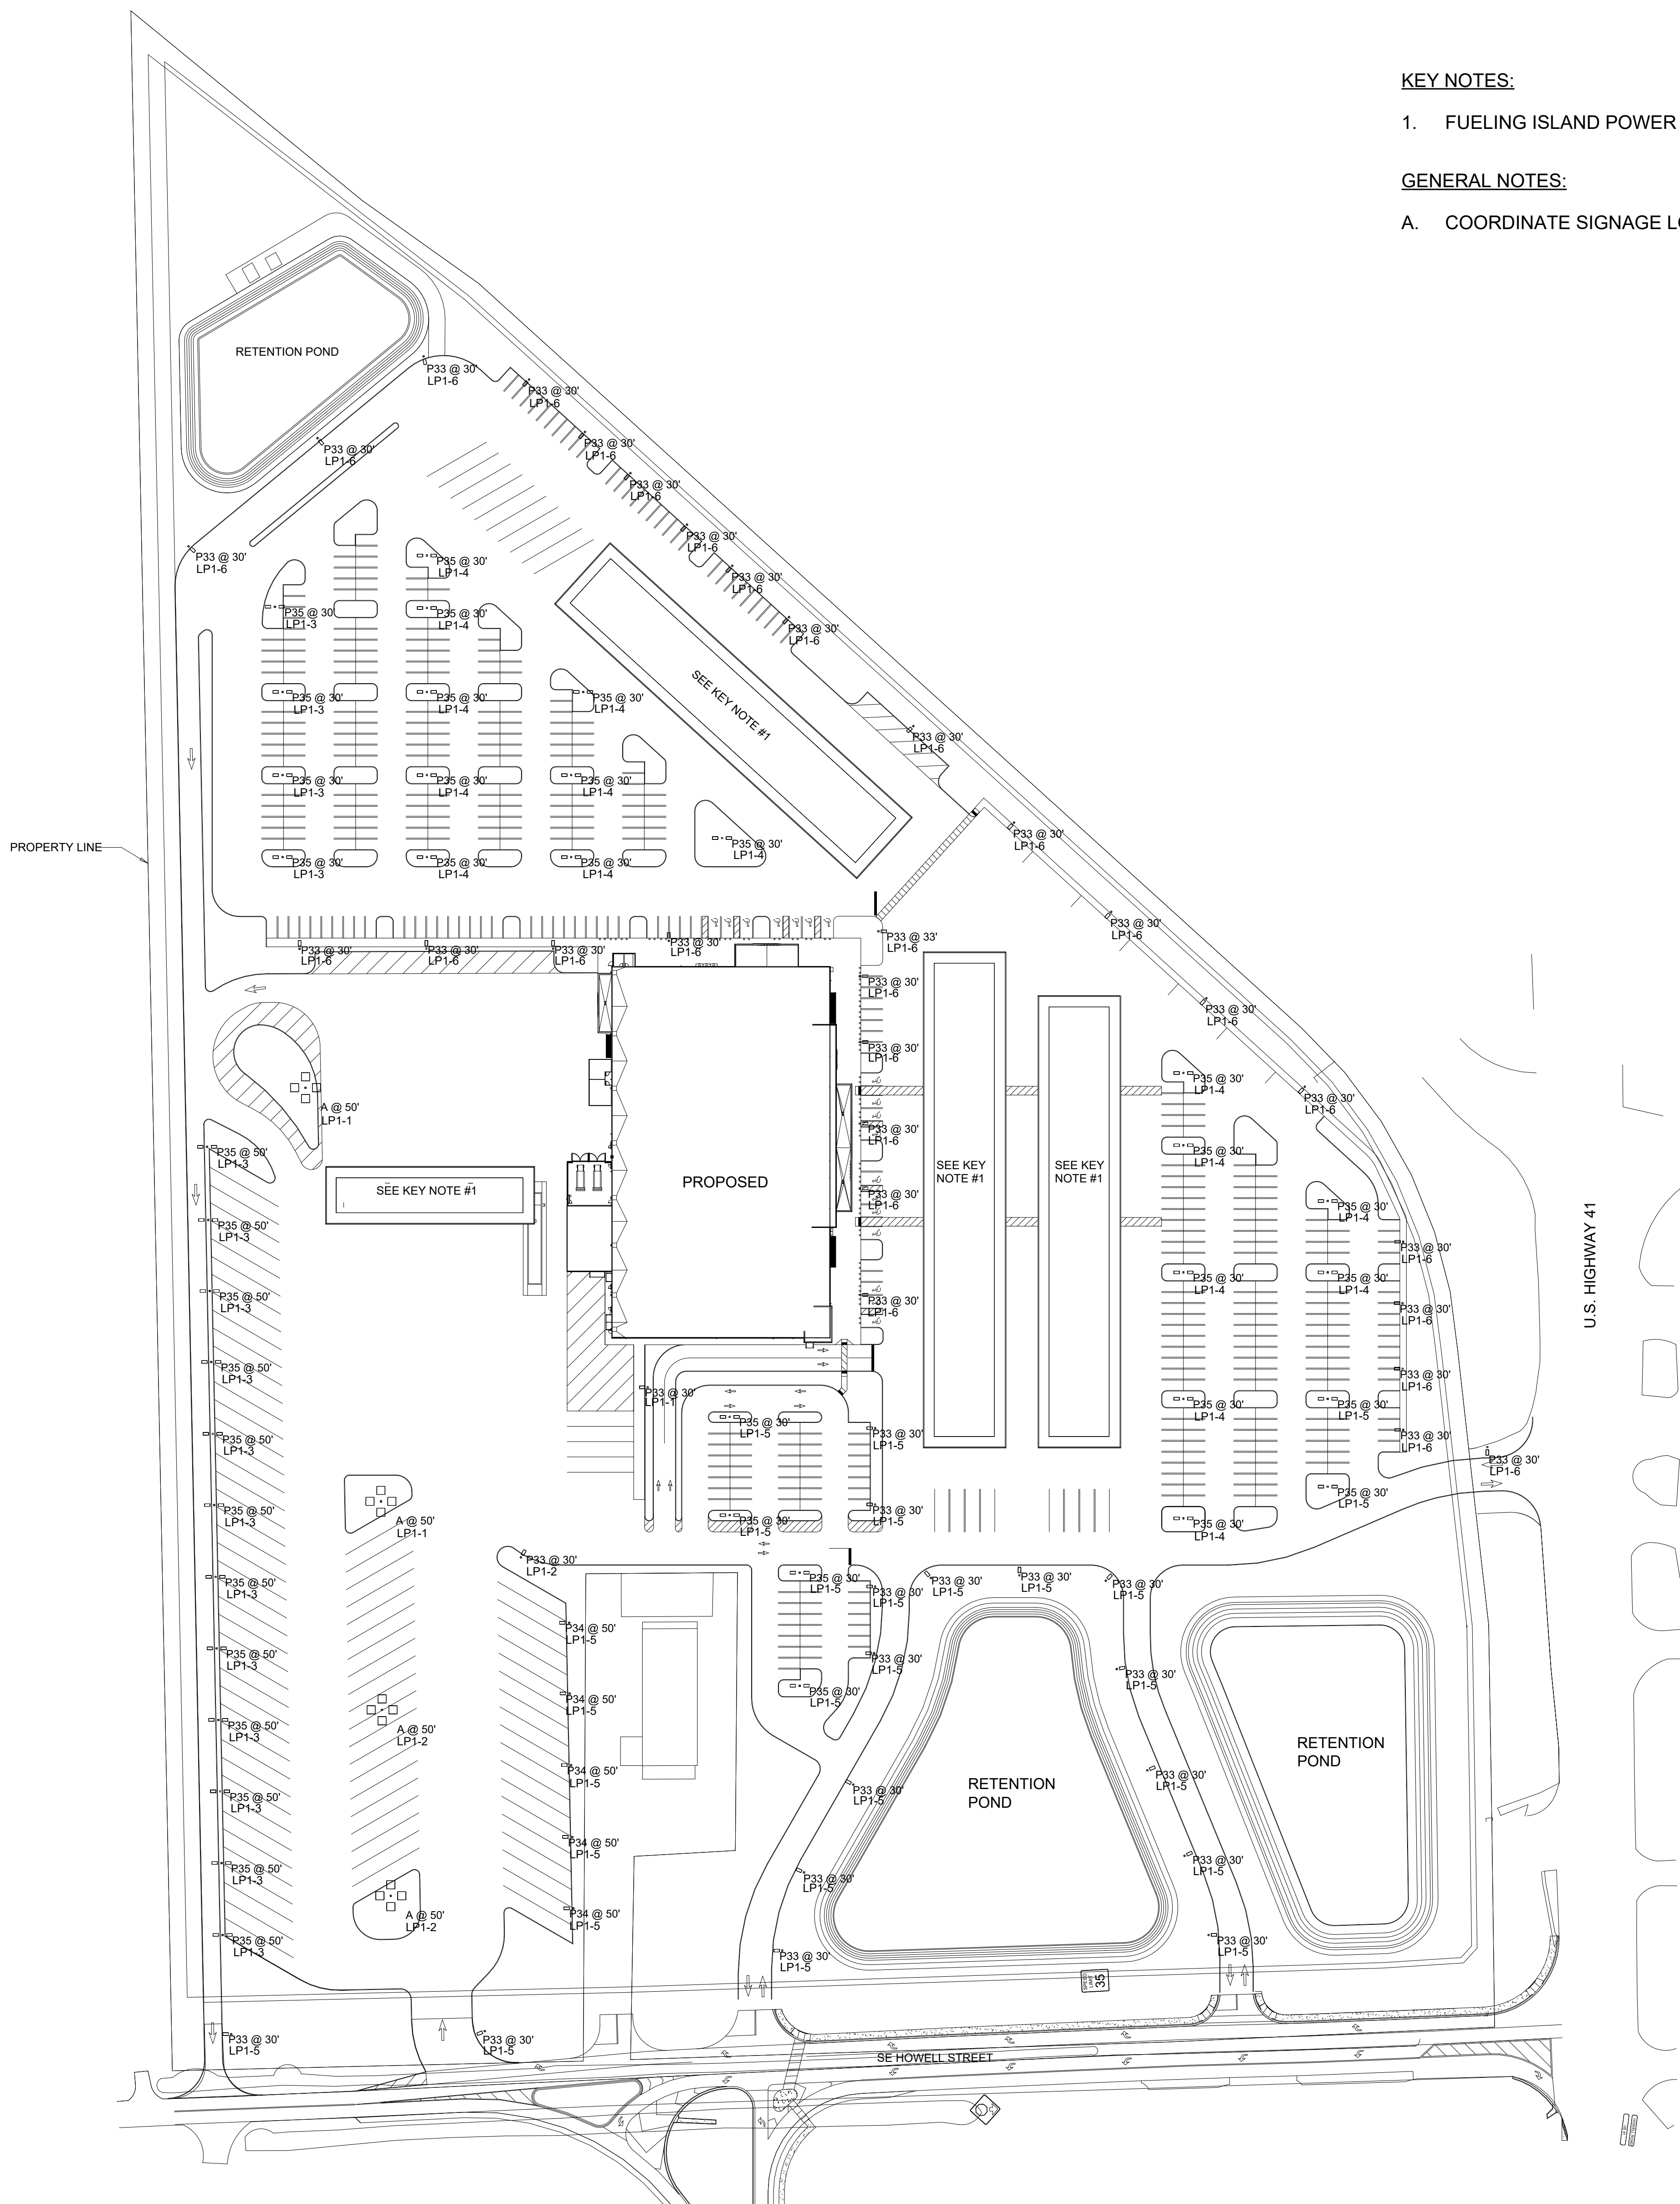

KEY NOTES:

1. FUELING ISLAND POWER AND LIGHTING PROVIDED UNDER SEPARATE CONTRACT.

GENERAL NOTES:

- A. COORDINATE SIGNAGE LOCATIONS AND REQUIREMENTS WITH OWNER.

SITE LIGHTING PLAN
SCALE: 1" = 80'-0"

2
E1.1




10175 Fortune Parkway, Suite 701
Jacksonville, FL 32256
p 904.683.9201 f 904.683.9702

www.kasperarch.com
FL License No.: AA2600802



www.IMEGCorp.com
9133 E.G. Skinner Parkway
Jacksonville, Florida 32216
Ph: (904) 483-5200 Fax: (904) 486-6700
email: mail@McVeighMangum.com
CA 6530
Eng. of Record Thomas C. Nielsen
License No.: 53492

ALL DESIGN PRIOR TO 08/28/2025 WAS PERFORMED BY IMEG UNDER THE RESPONSIBLE CHARGE OF THOMAS C. NIELSEN, PE #53492. ALL SUBSEQUENT DESIGN BY IMEG IS UNDER THE RESPONSIBLE CHARGE OF BRIAN J. LEAVITT, PE #87733.

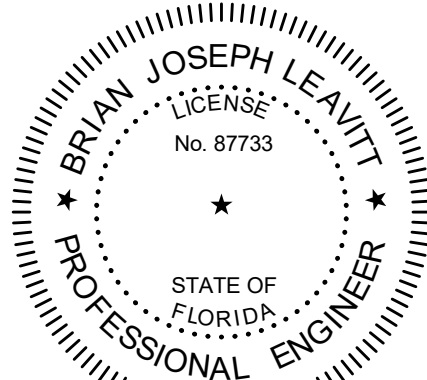

**BUSY BEE
ELLISVILLE**

136 SW WEBBS GLN
LAKE CITY, FL 32024

PROJECT NO.: 22024

DATE: 06/02/2025

PRIOR ISSUES:

**SITE LIGHTING
PLAN**

E1.1

DRAWN BY: IMEG
CHECKED BY: IMEG

100%
CONSTRUCTION
DOCUMENTS




10175 Fortune Parkway, Suite 701
Jacksonville, FL 32256
p 904.683.9201 f 904.683.9702

www.kasperarch.com
FL License No.: AA2600802



formerly McVeigh & Mangum Engineering
www.IMEGCorp.com
9133 E.G. Skinner Parkway
Jacksonville, Florida 32216
Ph: (904) 483-5200 Fax: (904) 483-6700
email: mail@McVeighMangum.com
CA 6330
Eng. of Record
License No.:

ALL DESIGN PRIOR TO 06/20/2025 WAS PERFORMED BY
IMEG UNDER THE RESPONSIBLE CHARGE OF
THOMAS C. NIELSEN, PE #53492.
ALL SUBSEQUENT DESIGN BY IMEG IS UNDER THE
RESPONSIBLE CHARGE OF BRIAN J. LEAVITT, PE #87733.

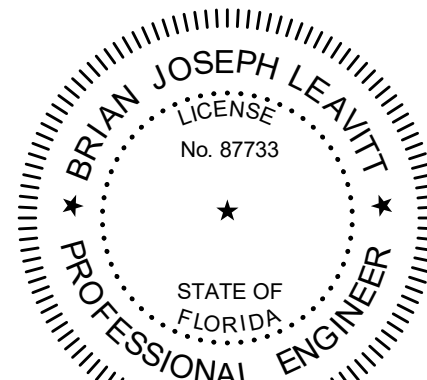

**BUSY BEE
ELLISVILLE**

136 SW WEBBS GLN
LAKE CITY, FL 32024

PROJECT NO.: 22024

DATE: 06/02/2025

PRIOR ISSUES:

106/24/2025 IASB #1

**SITE LIGHTING
PHOTOMETRIC
PLAN**

E1.2

DRAWN BY: IMEG

CHECKED BY: IMEG

**100%
CONSTRUCTION
DOCUMENTS**

© 2013

PROPERTY LINE

U.S. HIGHWAY 41

SE HOWELL STREET

2
E1.2

SITE LIGHTING PHOTOMETRIC PLAN

SCALE: 1" = 80'-0"

ALL DESIGN PRIOR TO 08/28/2025 WAS PERFORMED BY IMEG UNDER THE RESPONSIBLE CHARGE OF THOMAS C. NIELSEN, PE #53492. ALL SUBSEQUENT DESIGN BY IMEG IS UNDER THE RESPONSIBLE CHARGE OF BRIAN J. LEAVITT, PE #87733.

BUSY BEE ELLISVILLE

136 SW WEBBS GLN
LAKE CITY, FL 32024

PROJECT NO.: 22024

DATE: 06/02/2025


PRIOR ISSUES:

ELECTRICAL POWER PLAN


E1.3

DRAWN BY: IMEG
CHECKED BY: IMEG

100%
CONSTRUCTION
DOCUMENTS

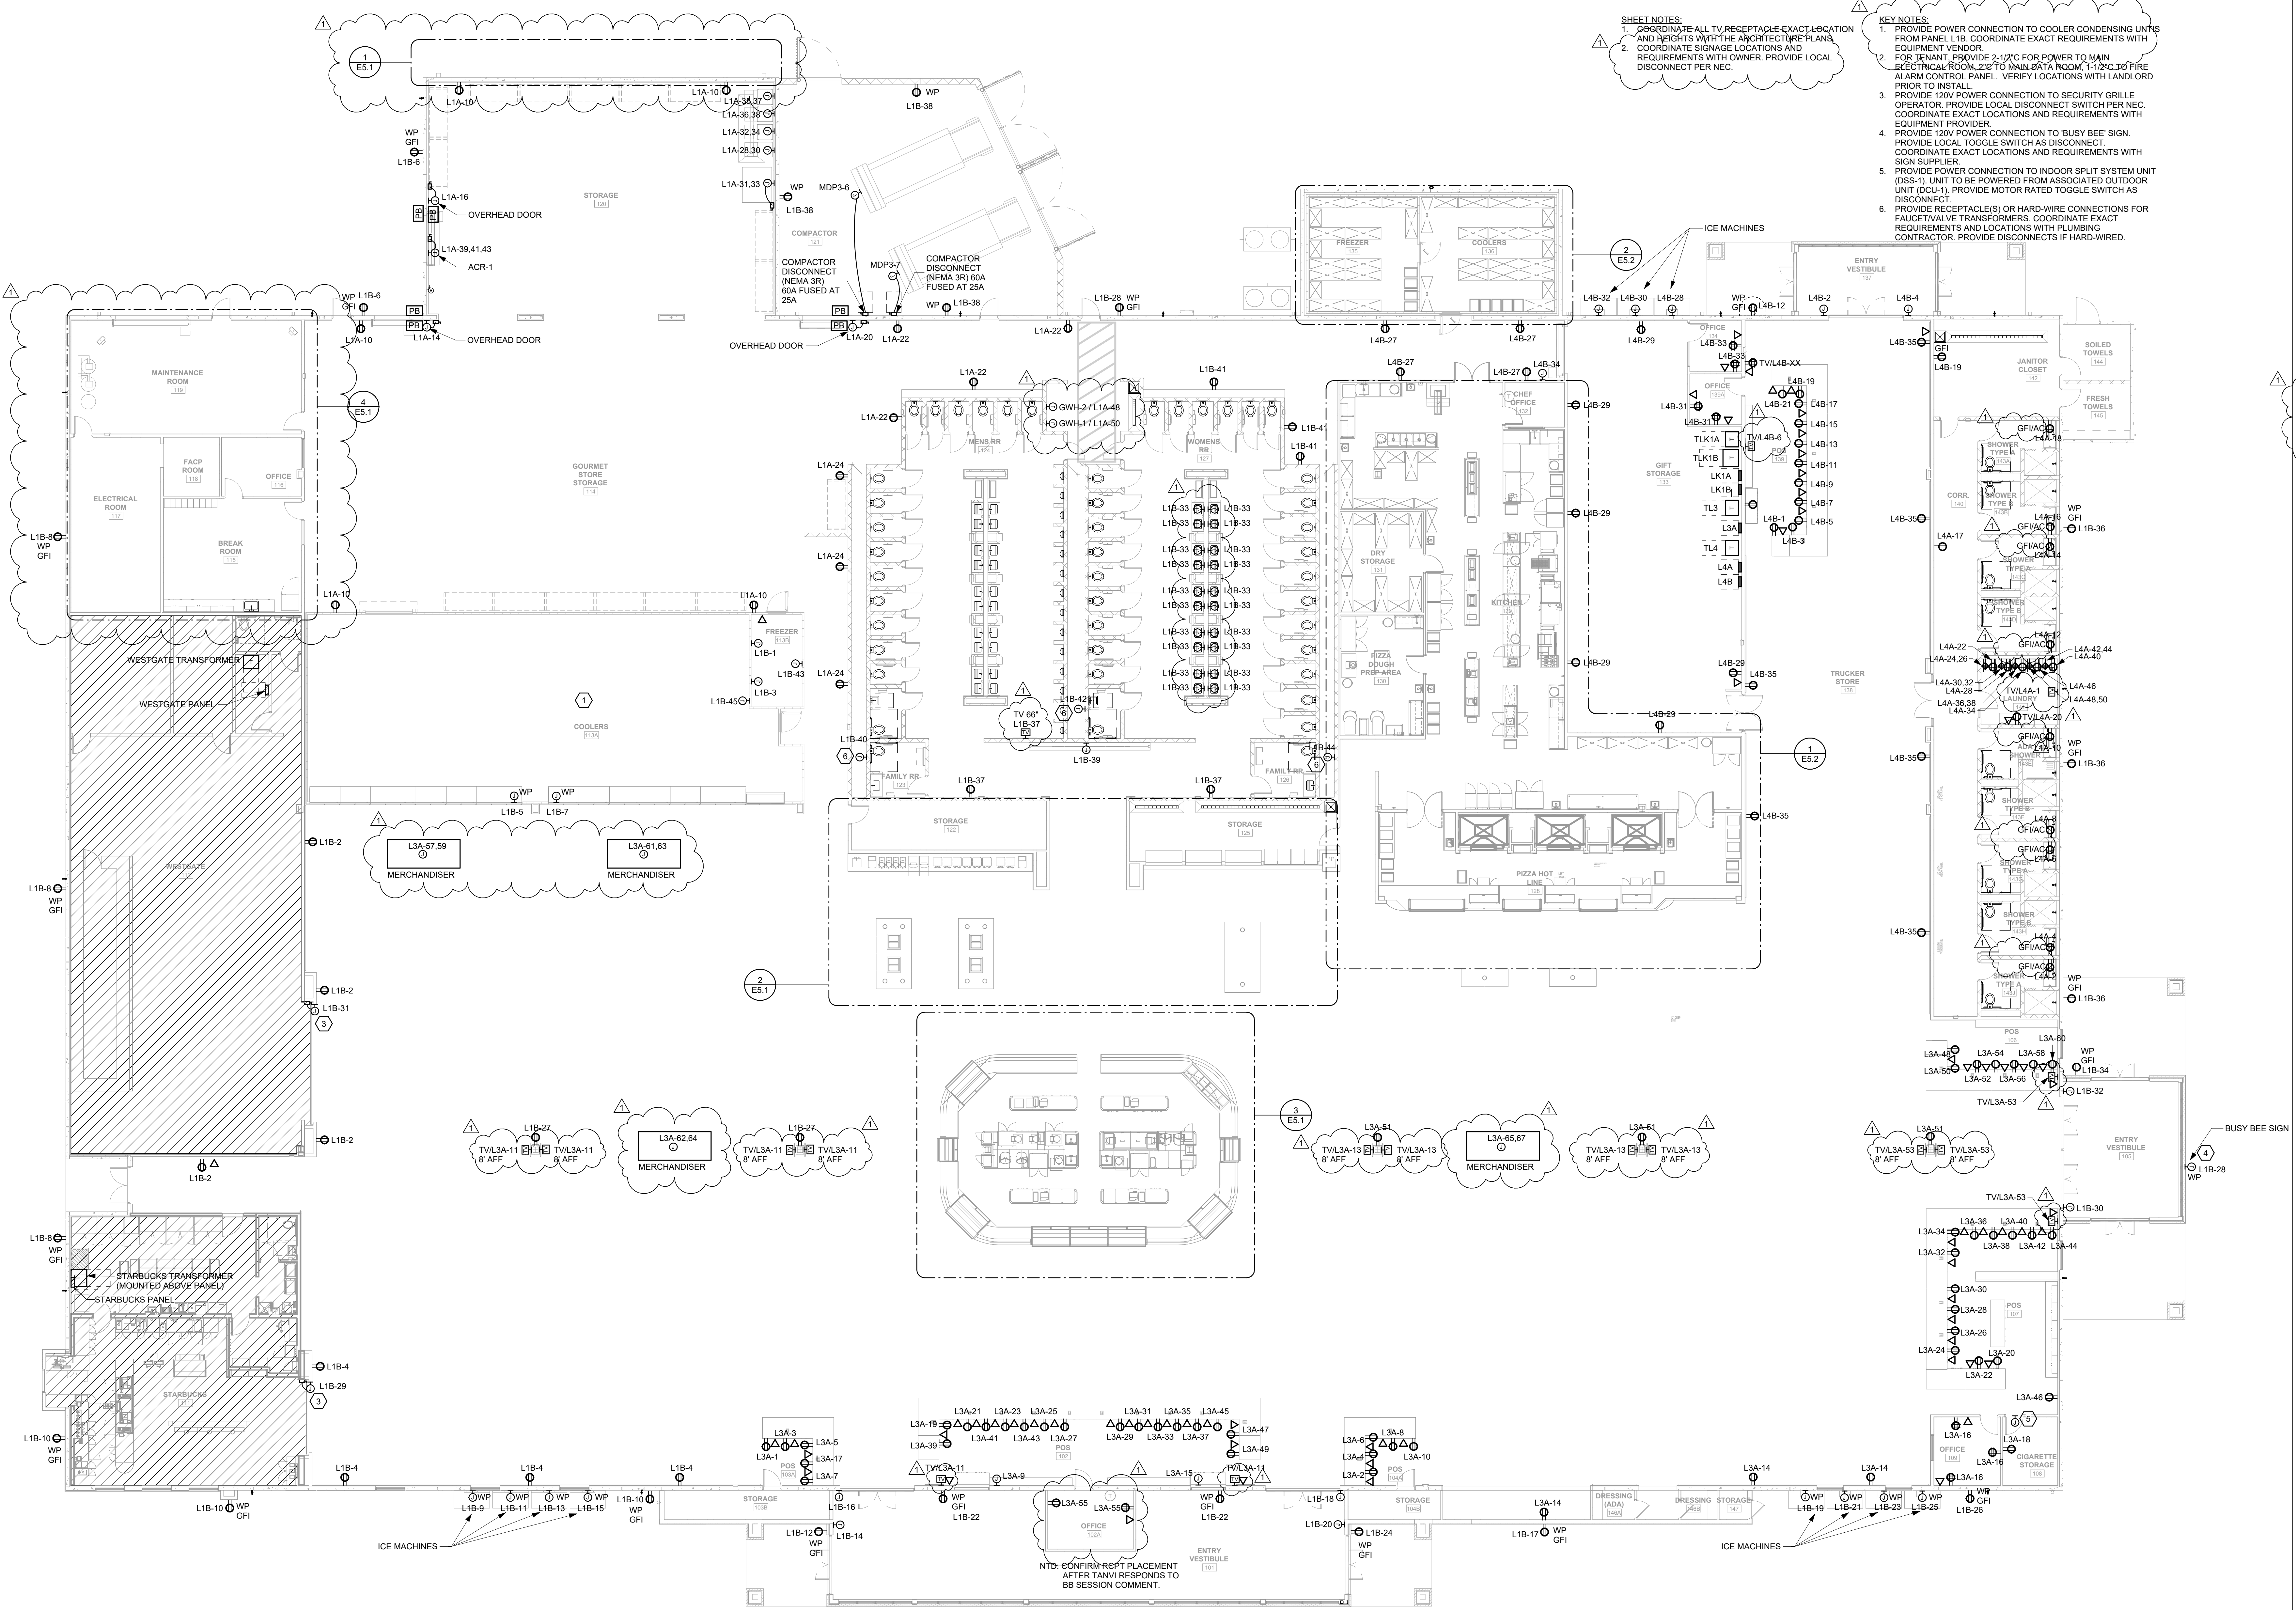

ALL DESIGN PRIOR TO 06/20/2025 WAS PERFORMED BY
IMEG UNDER THE RESPONSIBLE CHARGE OF
THOMAS C. NIELSEN, PE #53492.
ALL SUBSEQUENT DESIGN BY IMEG IS UNDER THE
RESPONSIBLE CHARGE OF BRIAN J. LEAVITT, PE #87733.

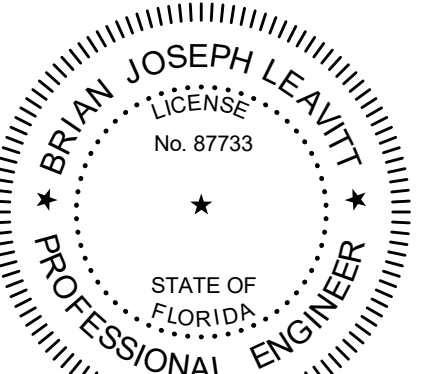

**BUSY BEE
ELLISVILLE**

136 SW WEBBS GLN
LAKE CITY, FL 32024

PROJECT NO.: 22024

DATE: 06/02/2025


PRIOR ISSUES: 106/24/2025 IASB #1

**FIRE ALARM
PLAN**


E1.5

DRAWN BY: IMEG
CHECKED BY: IMEG

100%
CONSTRUCTION
DOCUMENTS

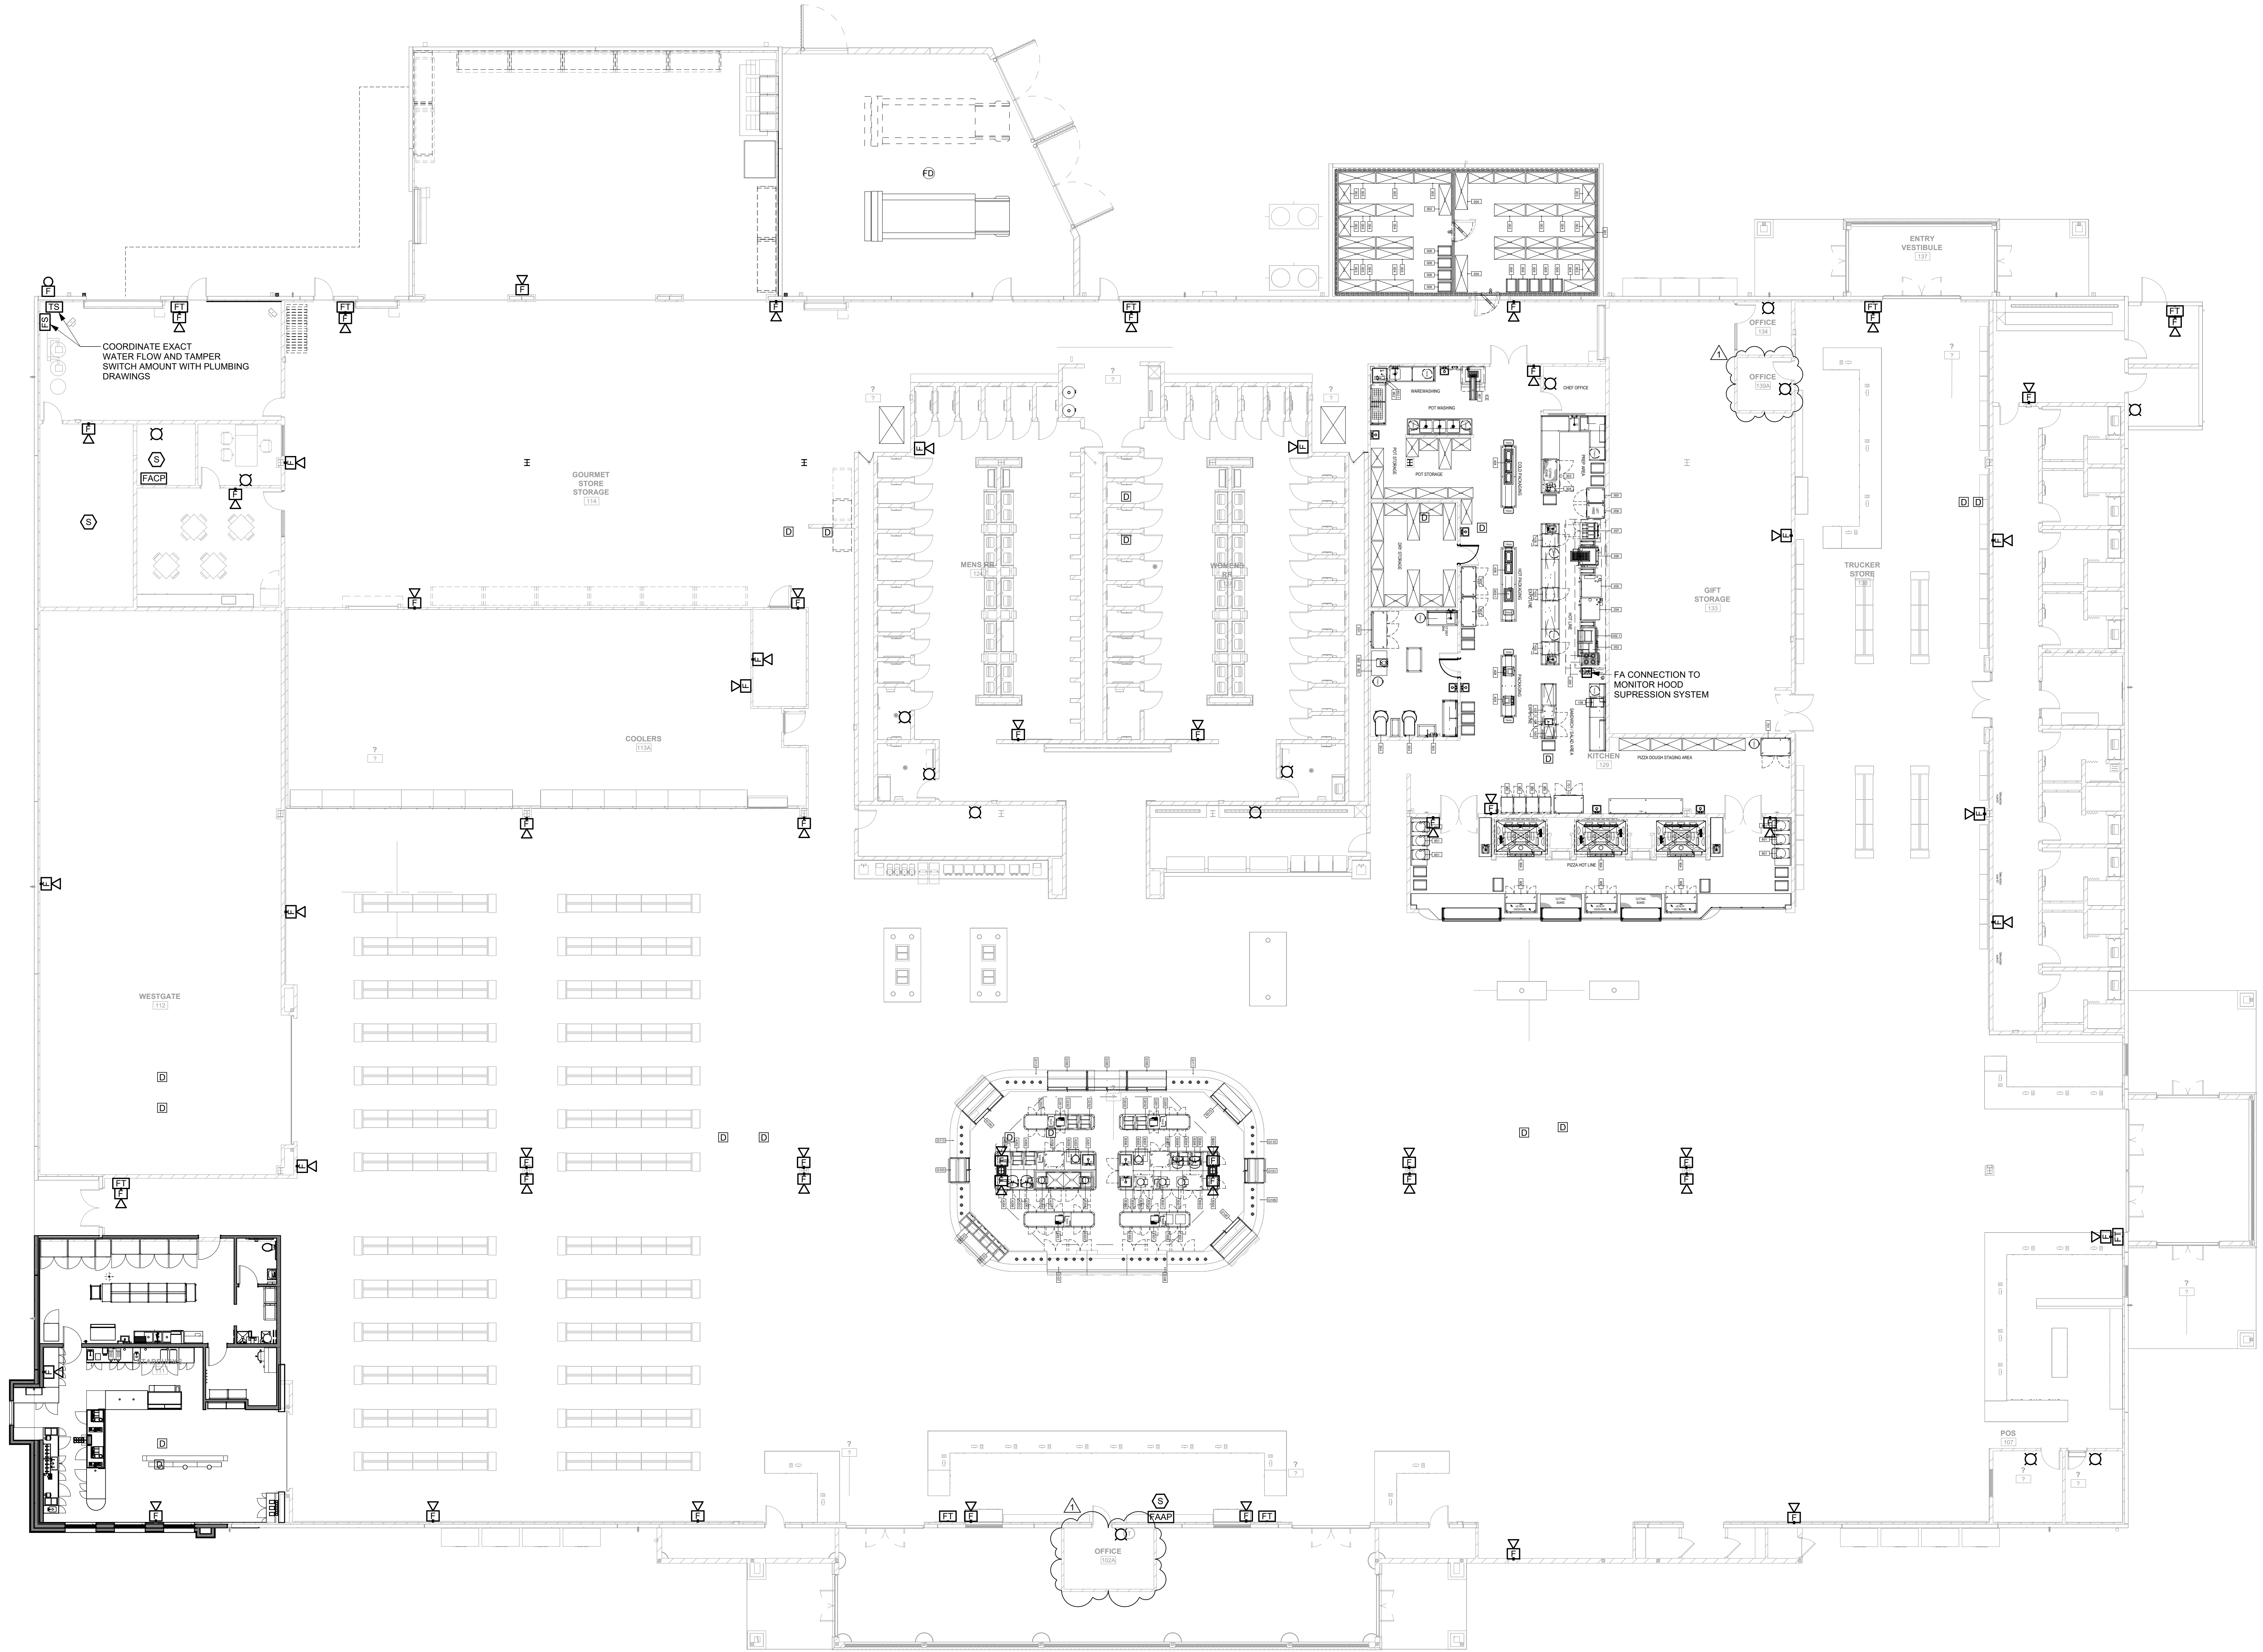

1
E1.5
FIRE ALARM PLAN
SCALE: 3/32" = 1'-0"

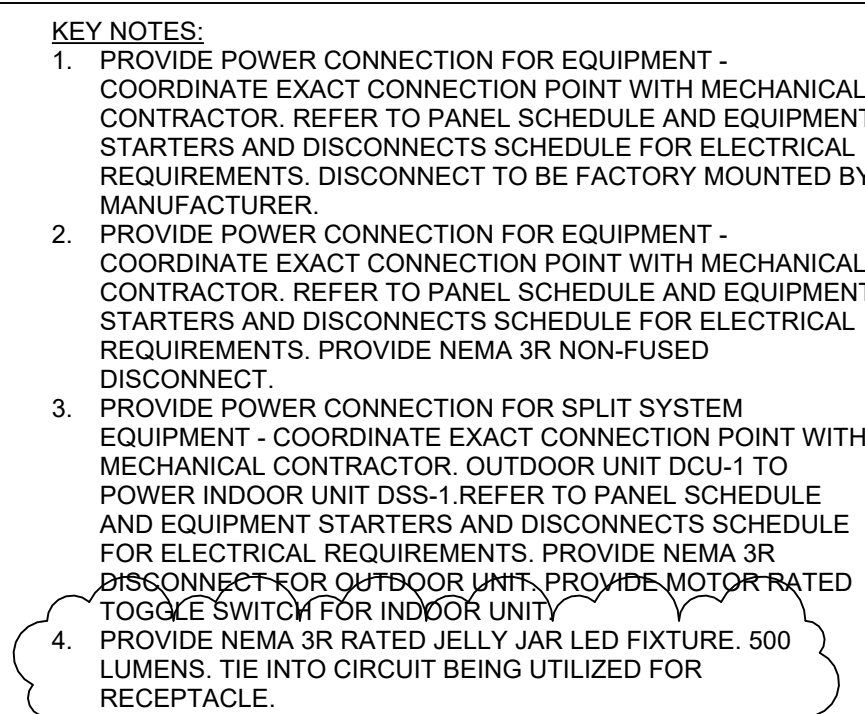

www.kasperarch.com
FL License No.: AA26000802

www.IMEGCorp.com
9133 R.G. Skinner Parkway
Jacksonville, Florida 32256
Ph: (904) 483-5200 Fax: (904) 636-6700
email: mail@McVeighMangum.com
CA 9330
Eng. of Record: THOMAS J. FUGARD
License No.: 82121

ALL DESIGN PRIOR TO 08/28/2025 WAS PERFORMED BY
IMEG UNDER THE RESPONSIBLE CHARGE OF
THOMAS C. NIELSEN, PE #53492.
ALL SUBSEQUENT DESIGN BY IMEG IS UNDER THE
RESPONSIBLE CHARGE OF BRIAN J. LEAVITT, PE #87732.



PRIOR ISSUES:

ELECTRICAL
ROOF PLAN

E4.1

DRAWN BY:	IMEG
CHECKED BY:	IMEG

100%
CONSTRUCTION
DOCUMENTS

© 2013

1
E4.1

KEYNOTES:


4. PROVIDE POWER TO SECURITY PANELS. UTILIZE PANEL "L1A".
COORDINATE POWER SUPPLY WITH EQUIPMENT SUPPLIERS.
UPDATE PANEL SCHEDULE WITH FINAL CIRCUIT INFORMATION.
5. PROVIDE POWER TO INSTANTANEOUS WATER HEATER. UTILIZE
PANEL "L1A". COORDINATE POWER SUPPLY WITH EQUIPMENT
SUPPLIERS. UPDATE PANEL SCHEDULE WITH FINAL CIRCUIT INFORMATION.

GENERAL NOTES:

- A. CONFIRM POWER REQUIREMENTS FOR CENTER STAGE EQUIPMENT
WITH EQUIPMENT SUPPLIER.


1 ENLARGED ELECTRICAL SERVICE DISCONNECTS

E5.1 SCALE: 3/8" = 1'-0"

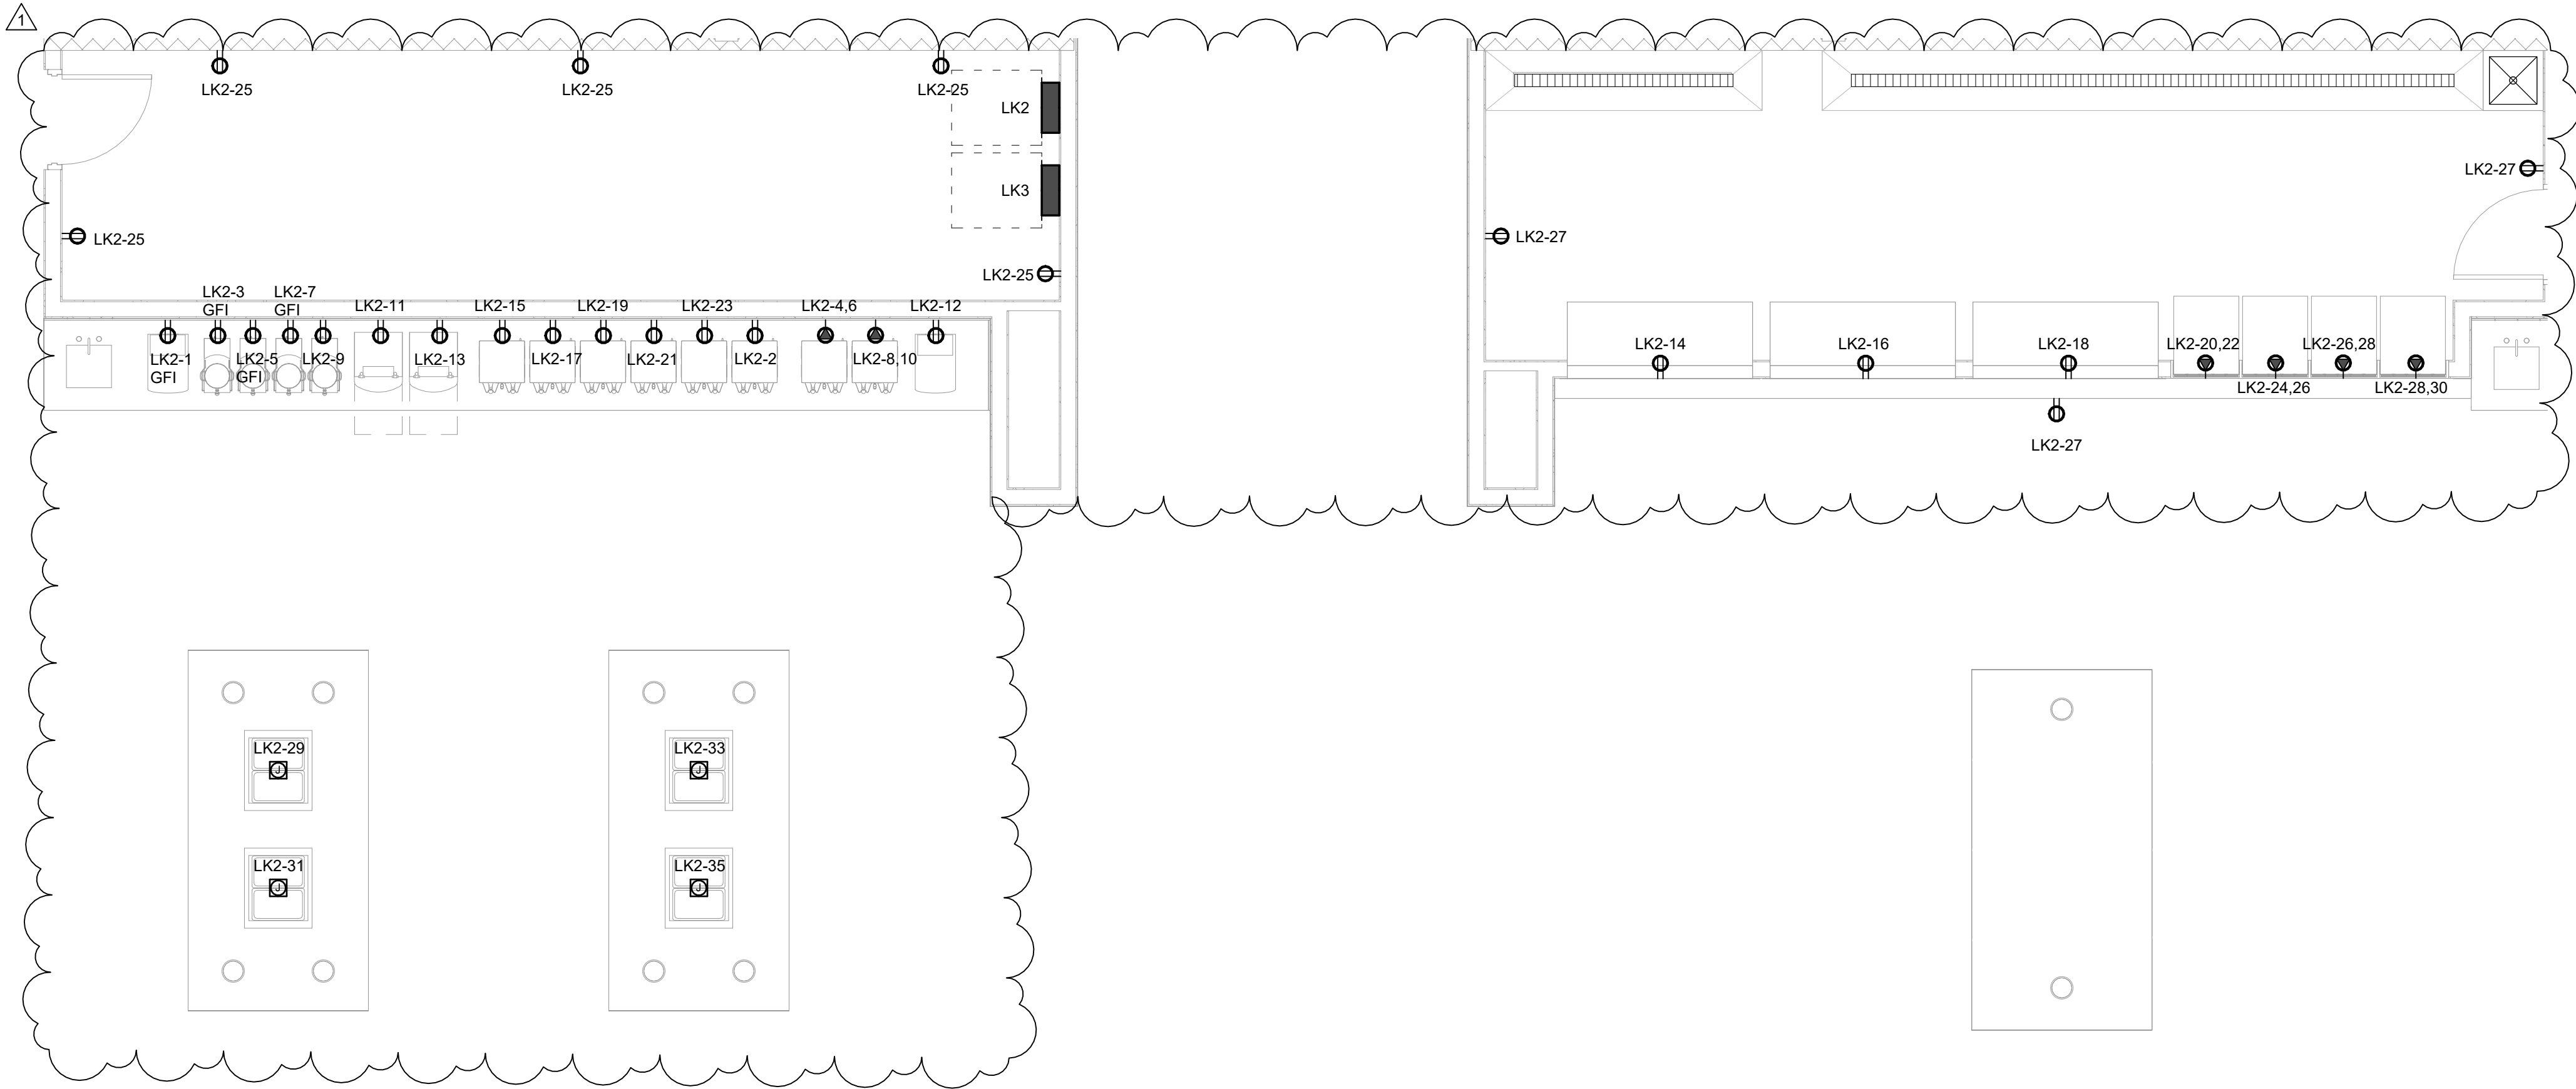


2 ENLARGED KITCHEN EQUIPMENT PLAN SOUTH - POWER

E5.1 SCALE: 1/4" = 1'-0"

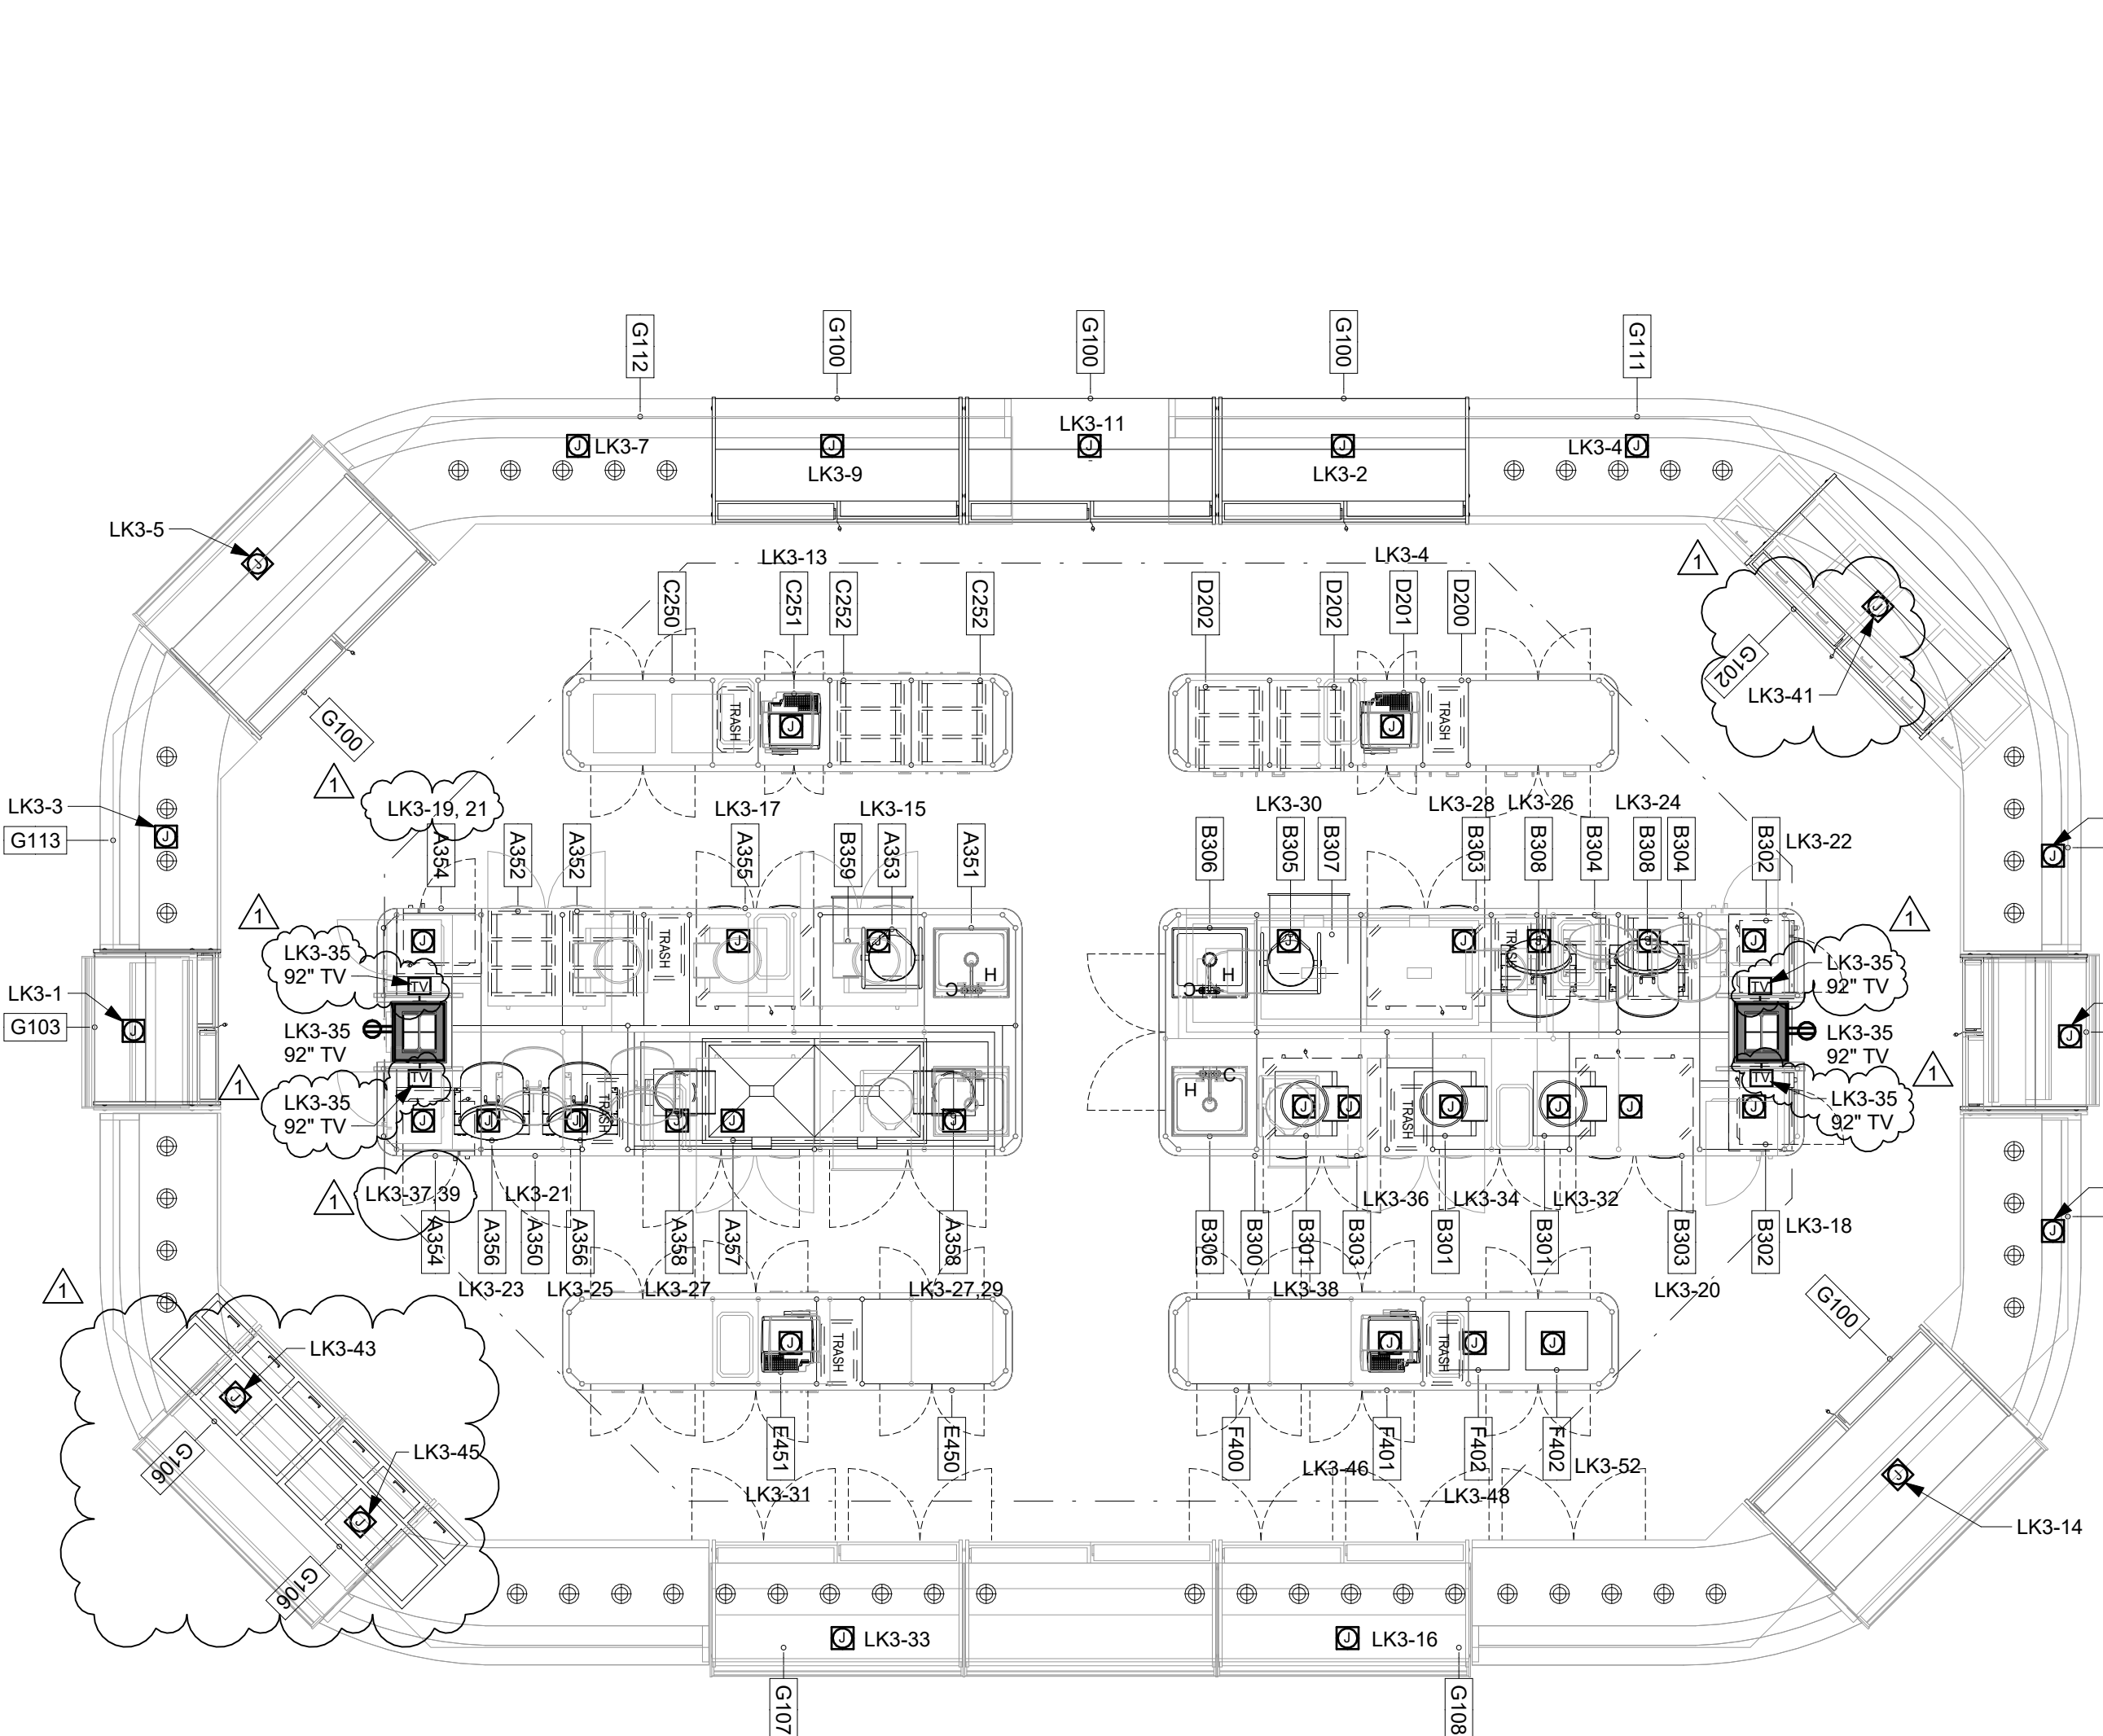

3 ENLARGED CENTER STAGE EQUIPMENT PLAN - POWER

E5.1 SCALE: 1/4" = 1'-0"

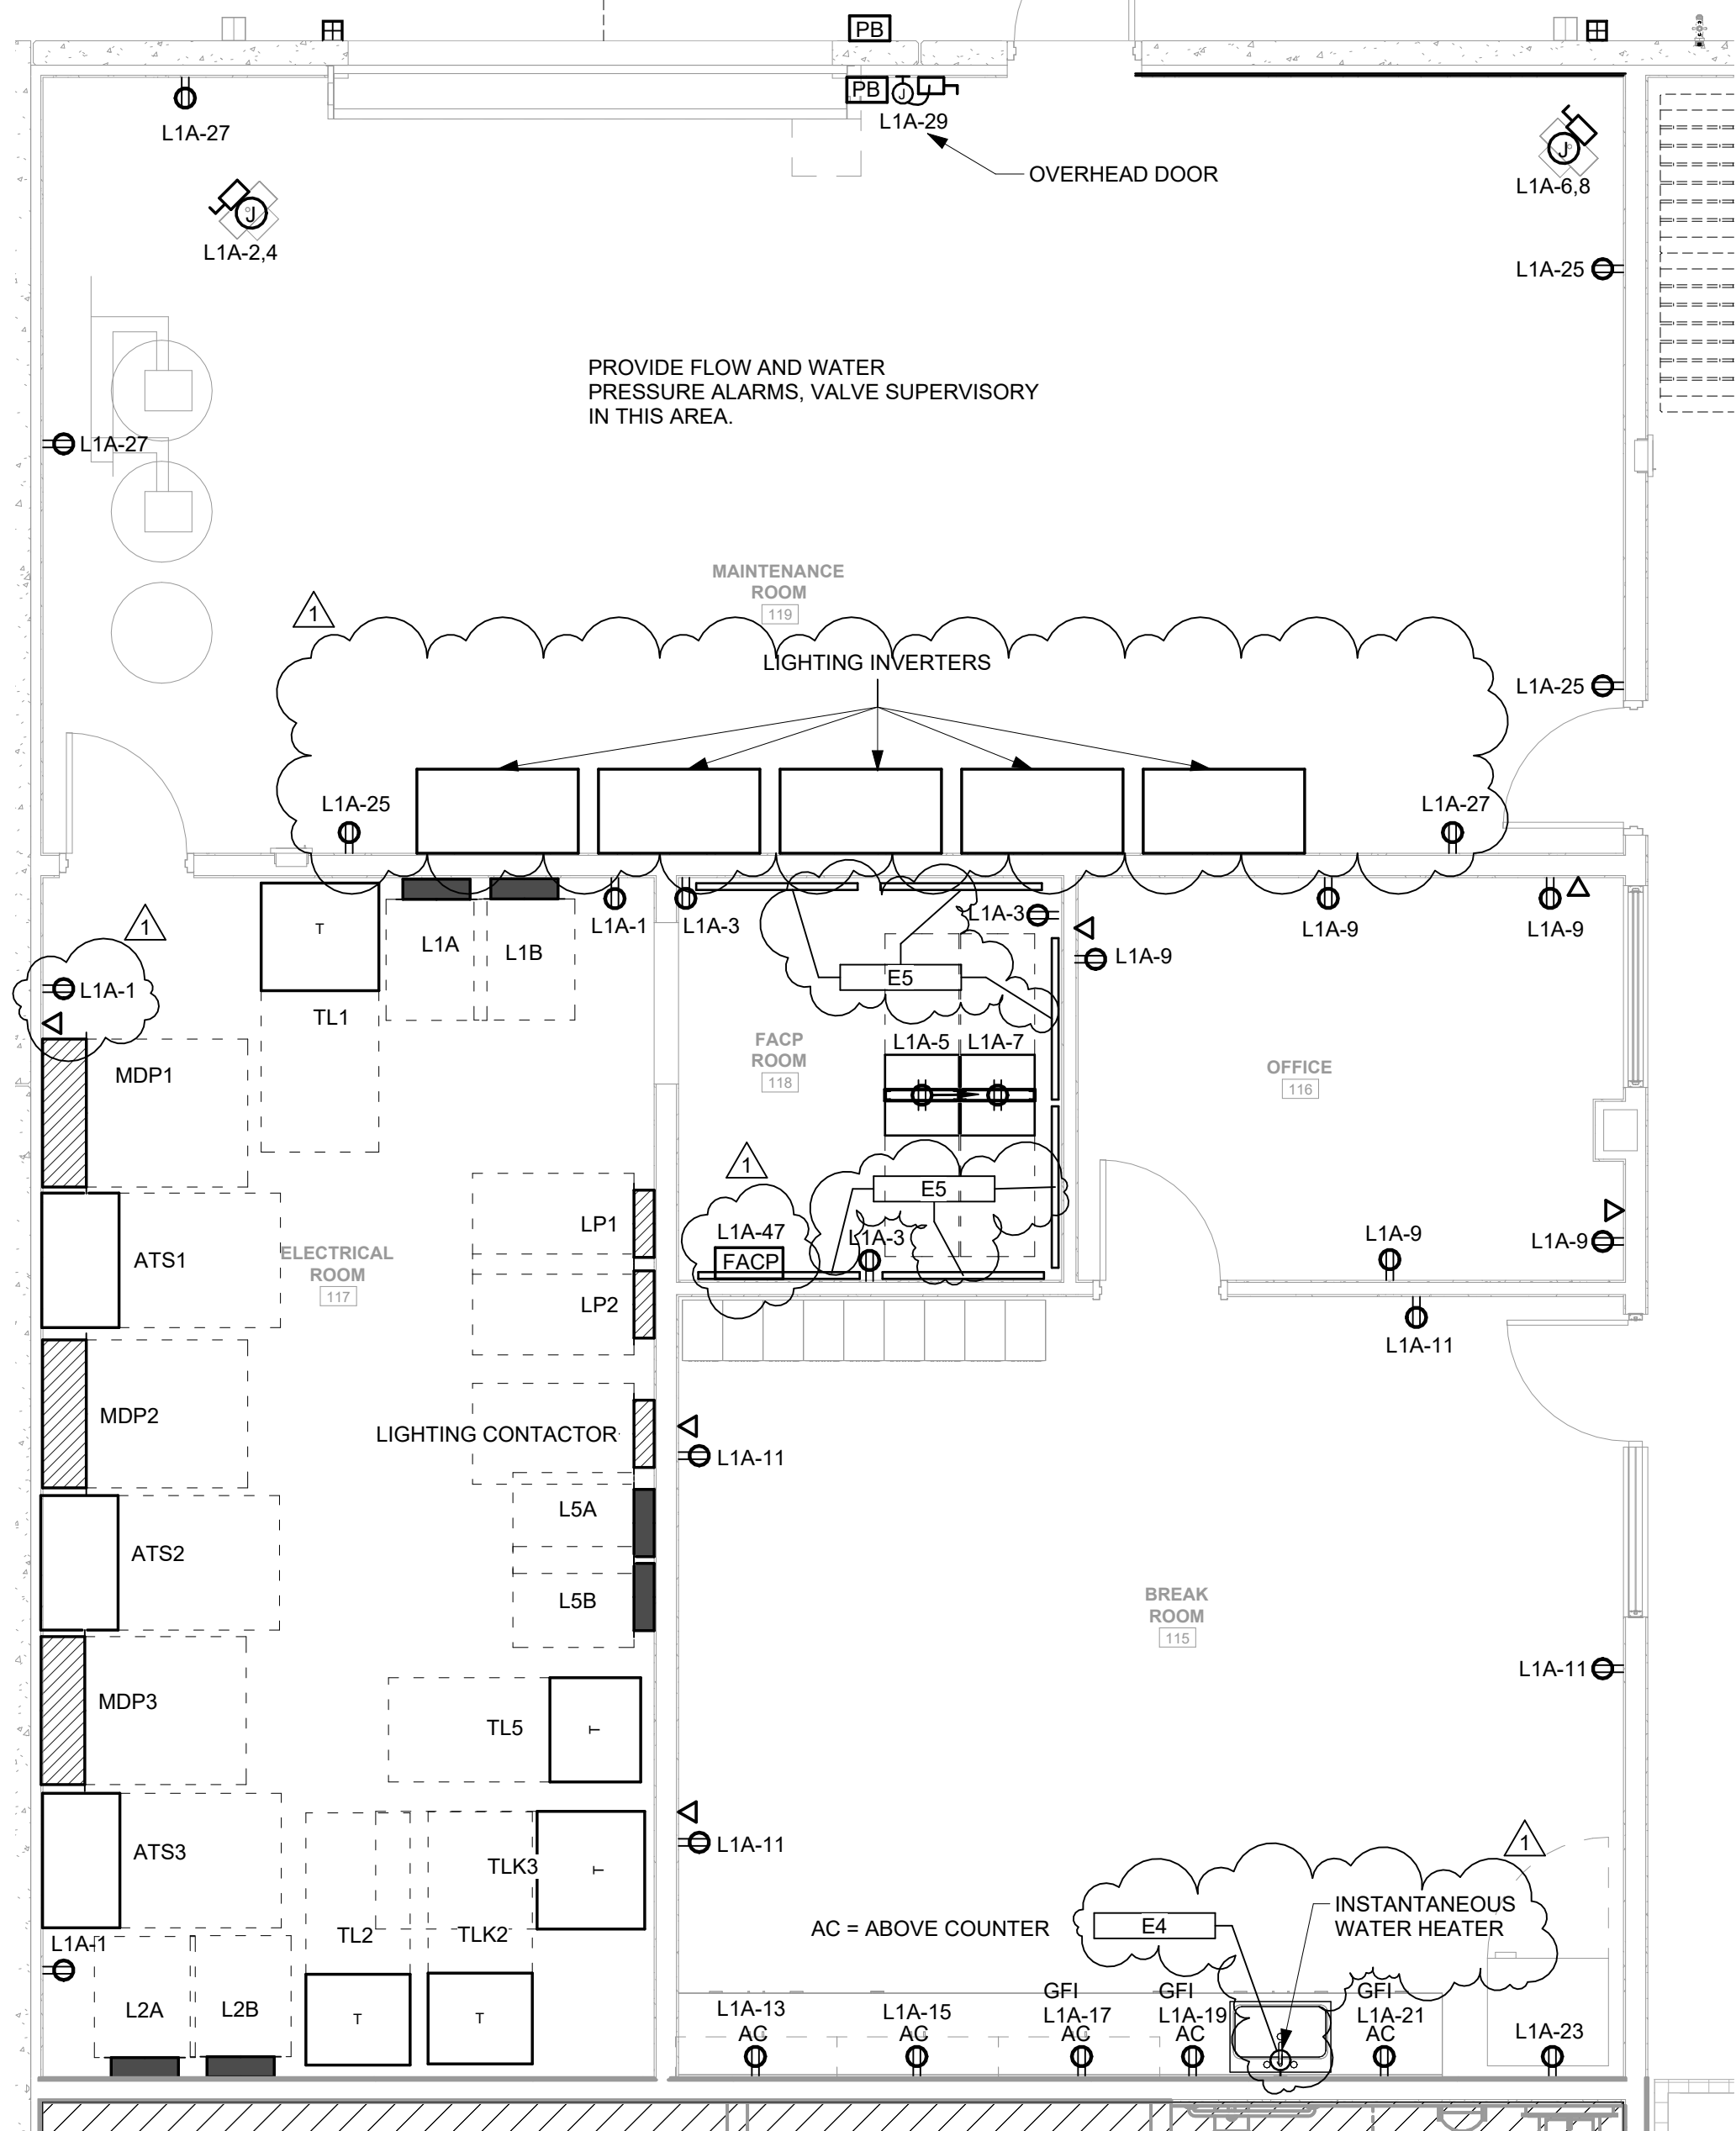

4 ENLARGED ELECTRICAL / MAINTENANCE ROOM

E5.1 SCALE: 1/4" = 1'-0"

**BUSY BEE
ELLISVILLE**

136 SW WEBBS GLN
LAKE CITY, FL 32024

PROJECT NO.: 22024

DATE: 06/02/2025

PRIOR ISSUES:

106/24/2025 JASB #1



**ENLARGED
PLANS**



E5.1

DRAWN BY: IMEG

CHECKED BY: IMEG


100%
CONSTRUCTION
DOCUMENTS

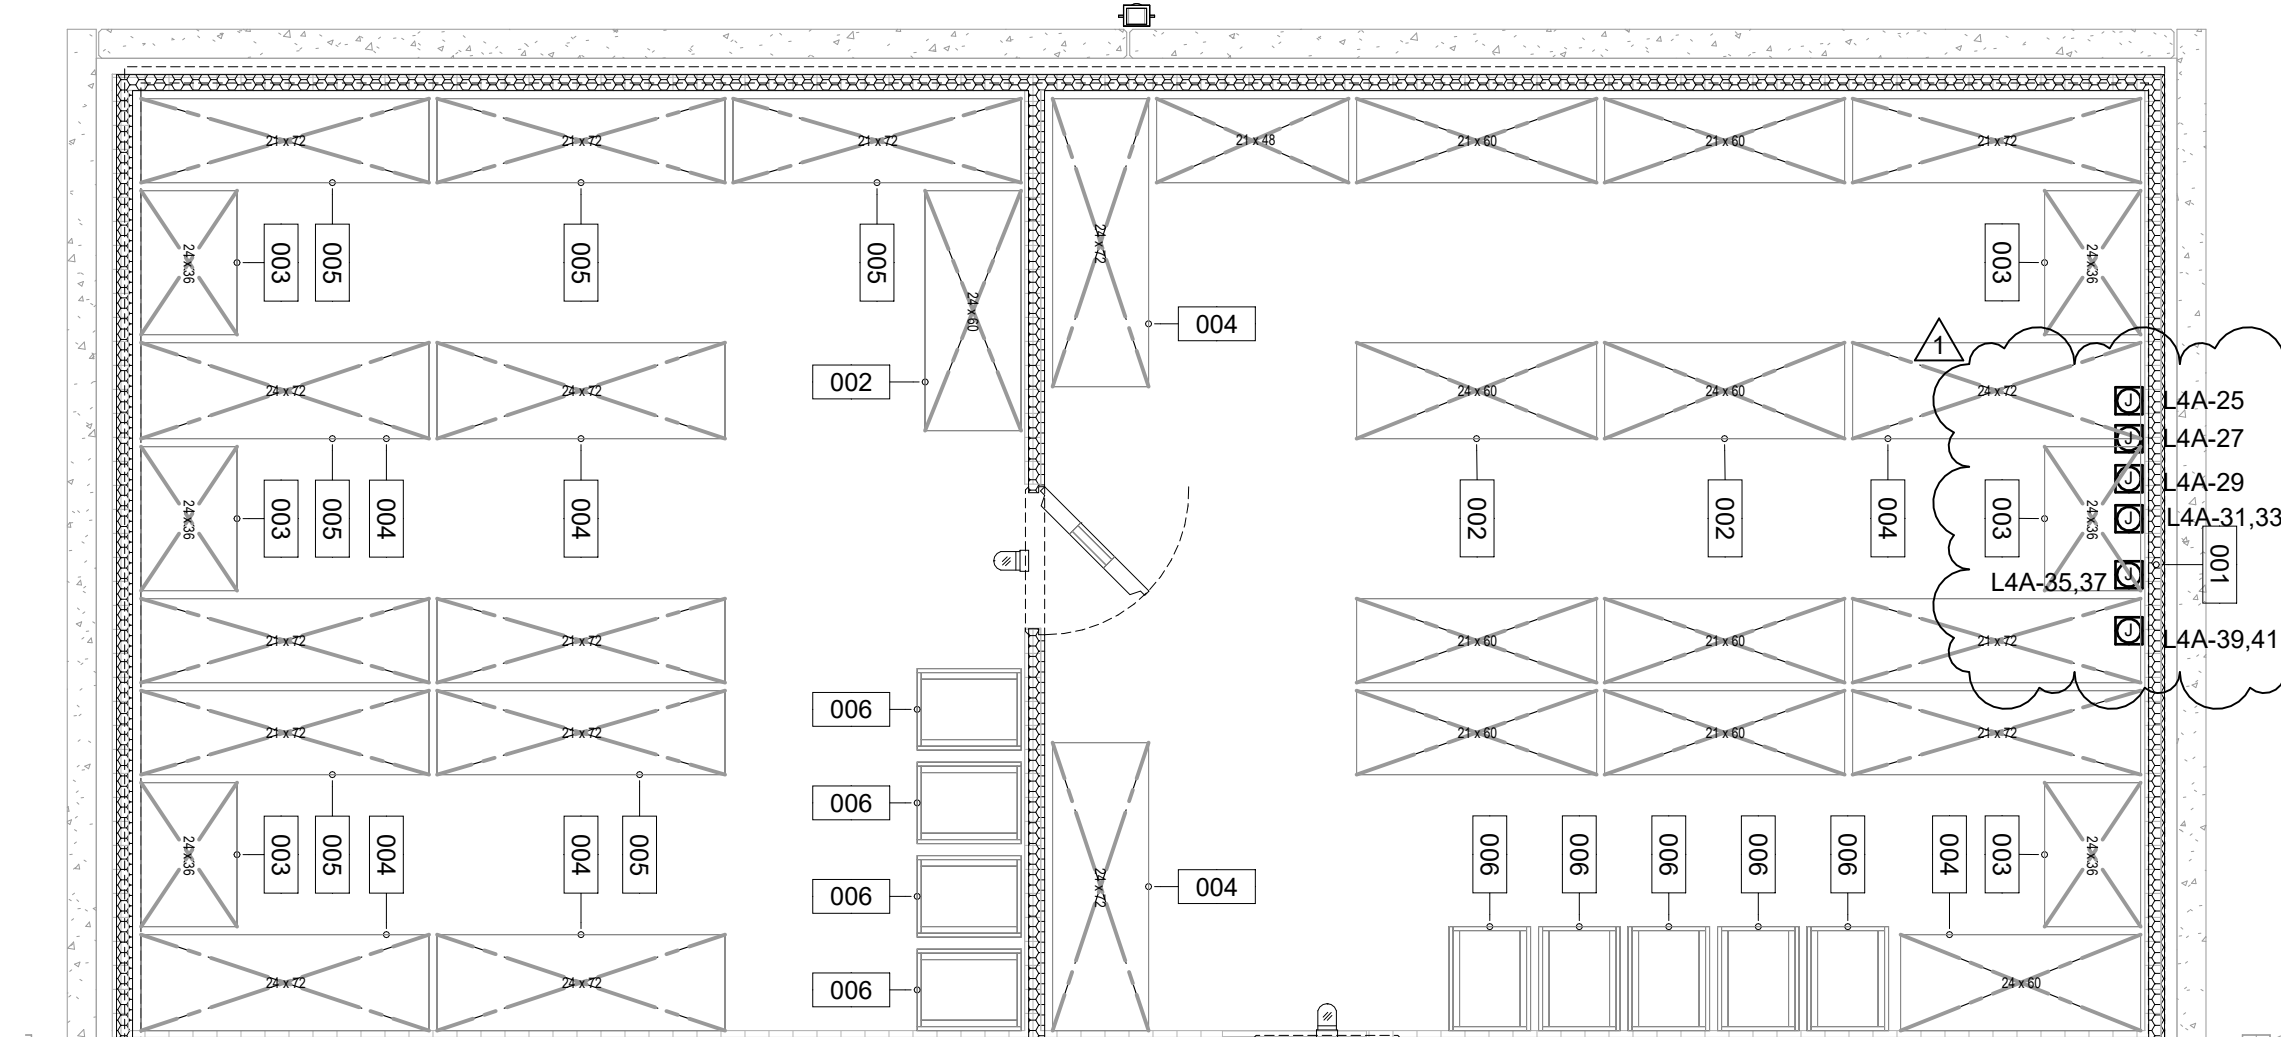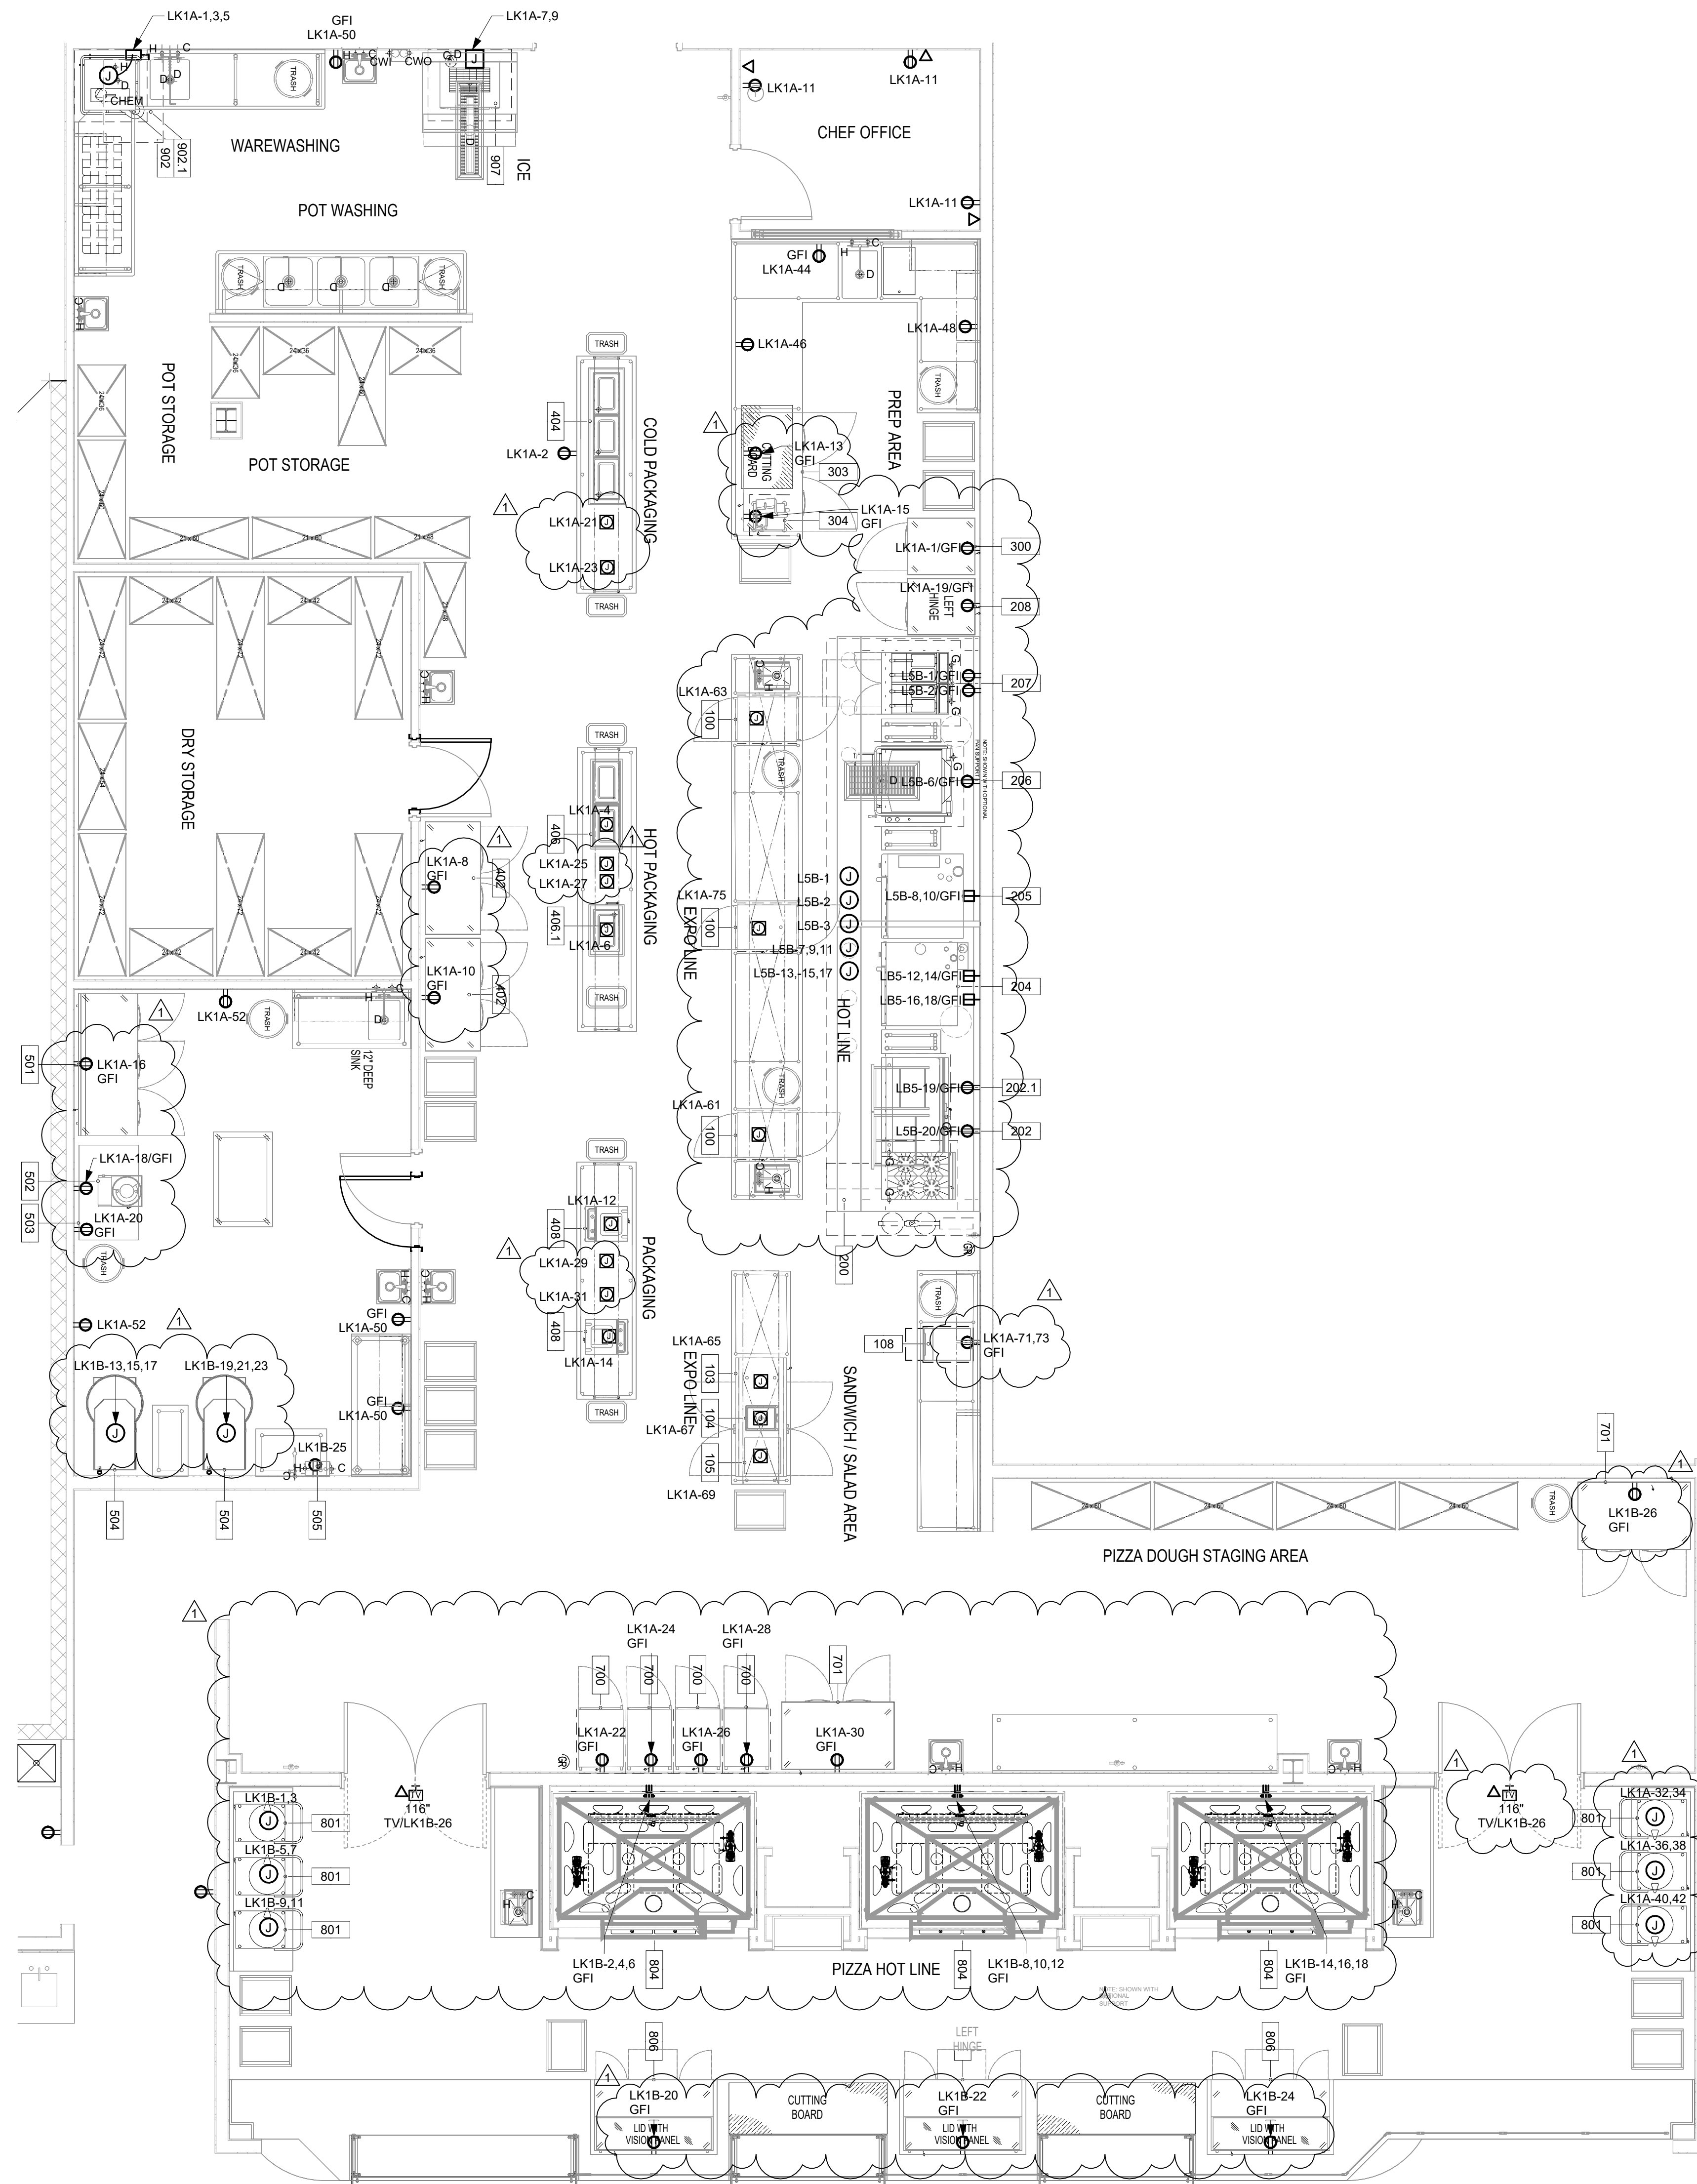

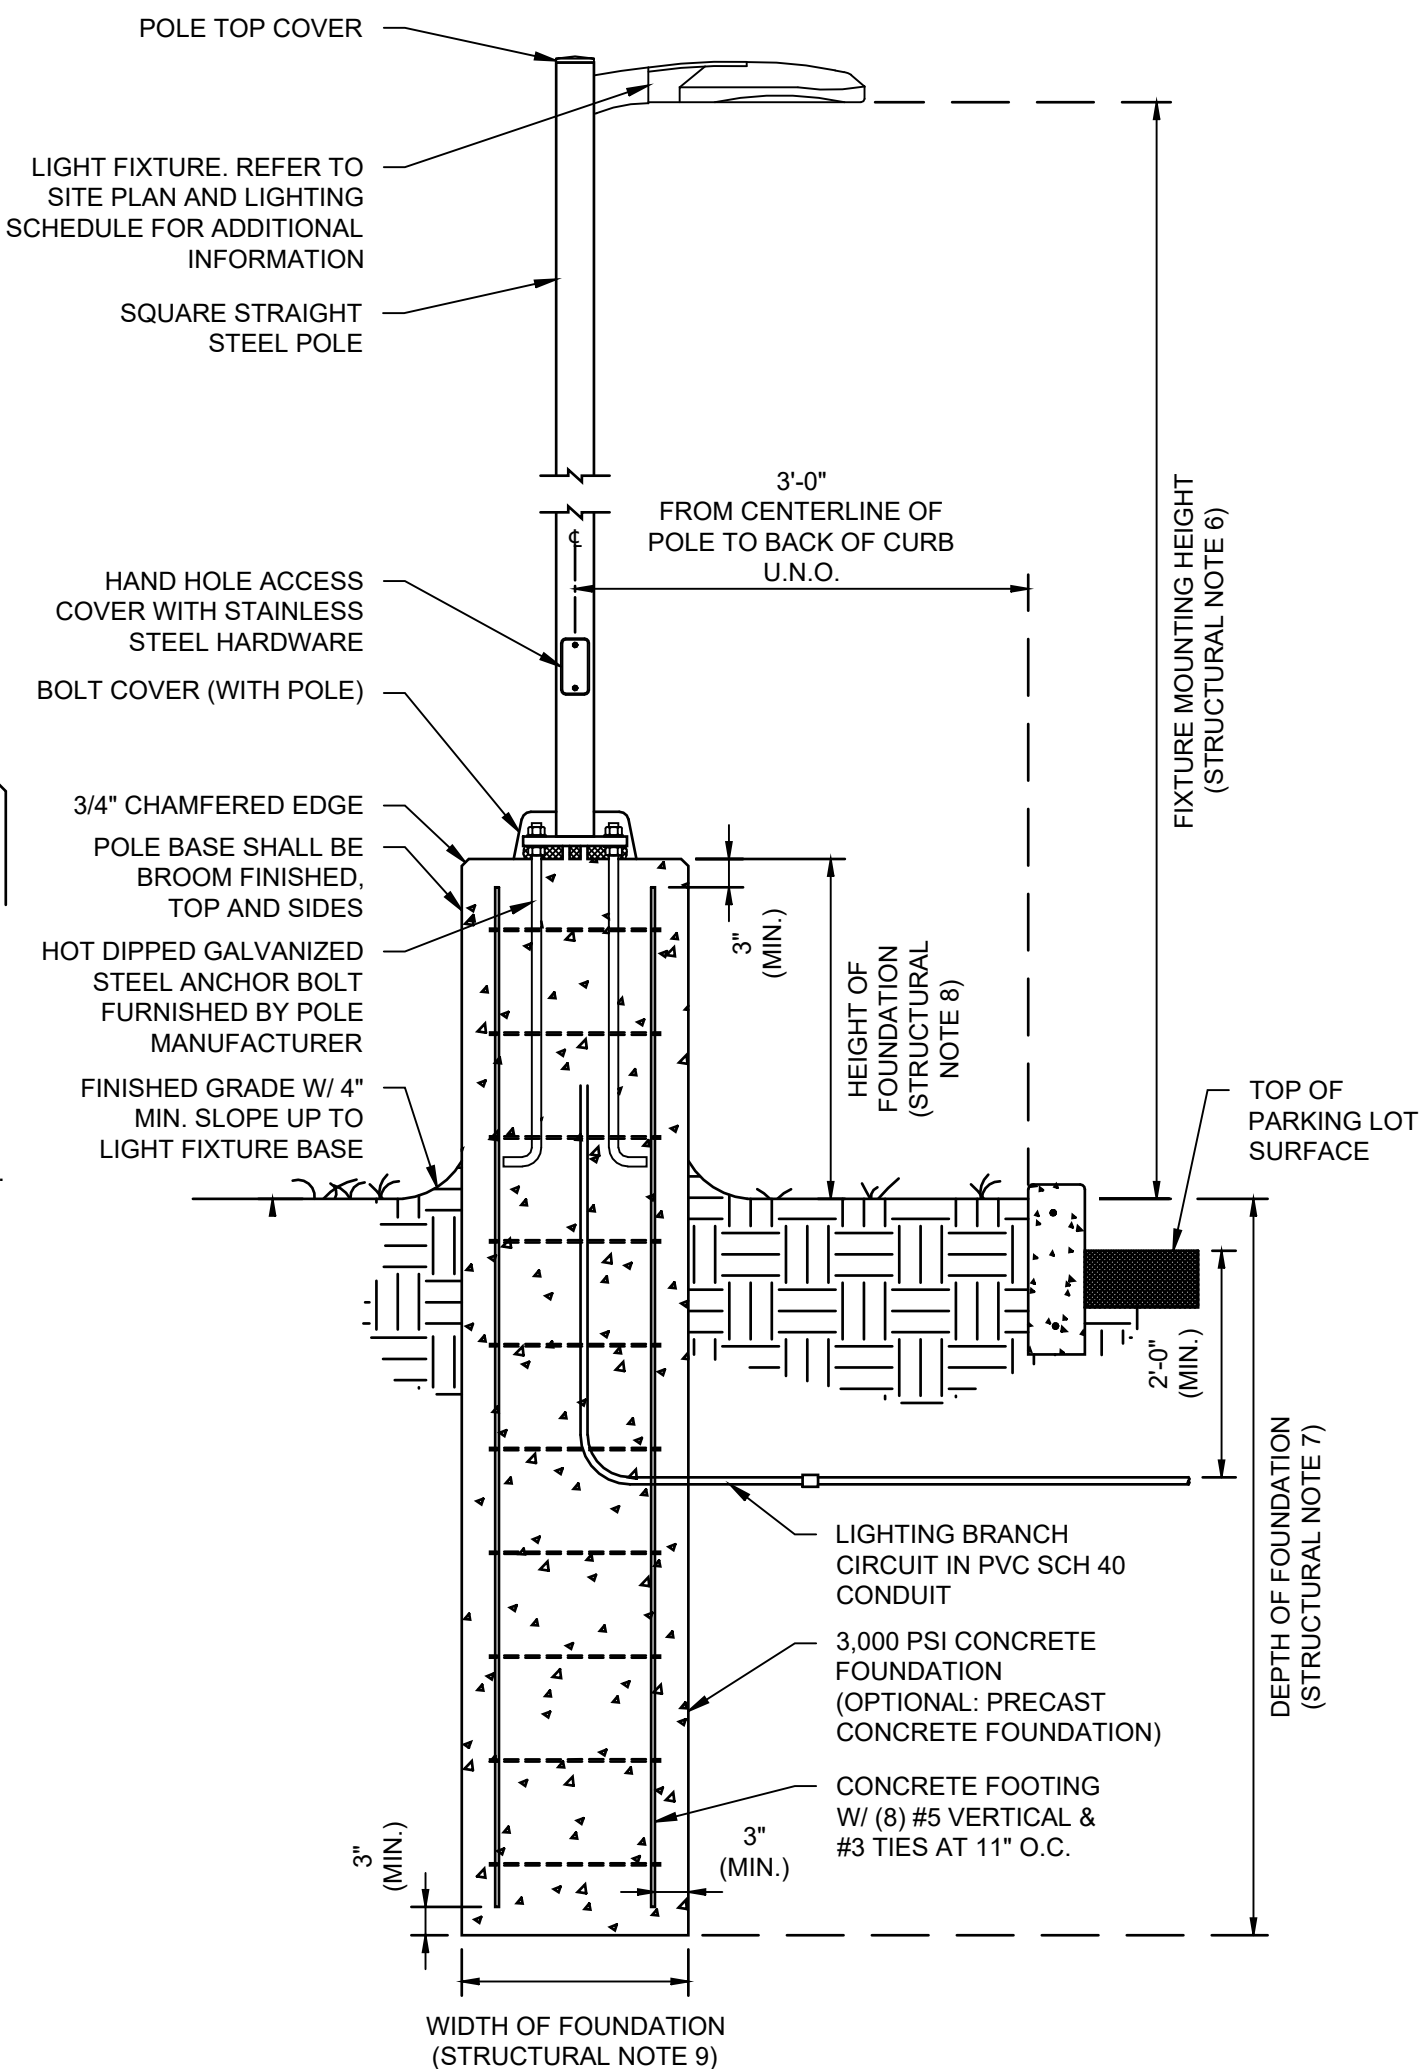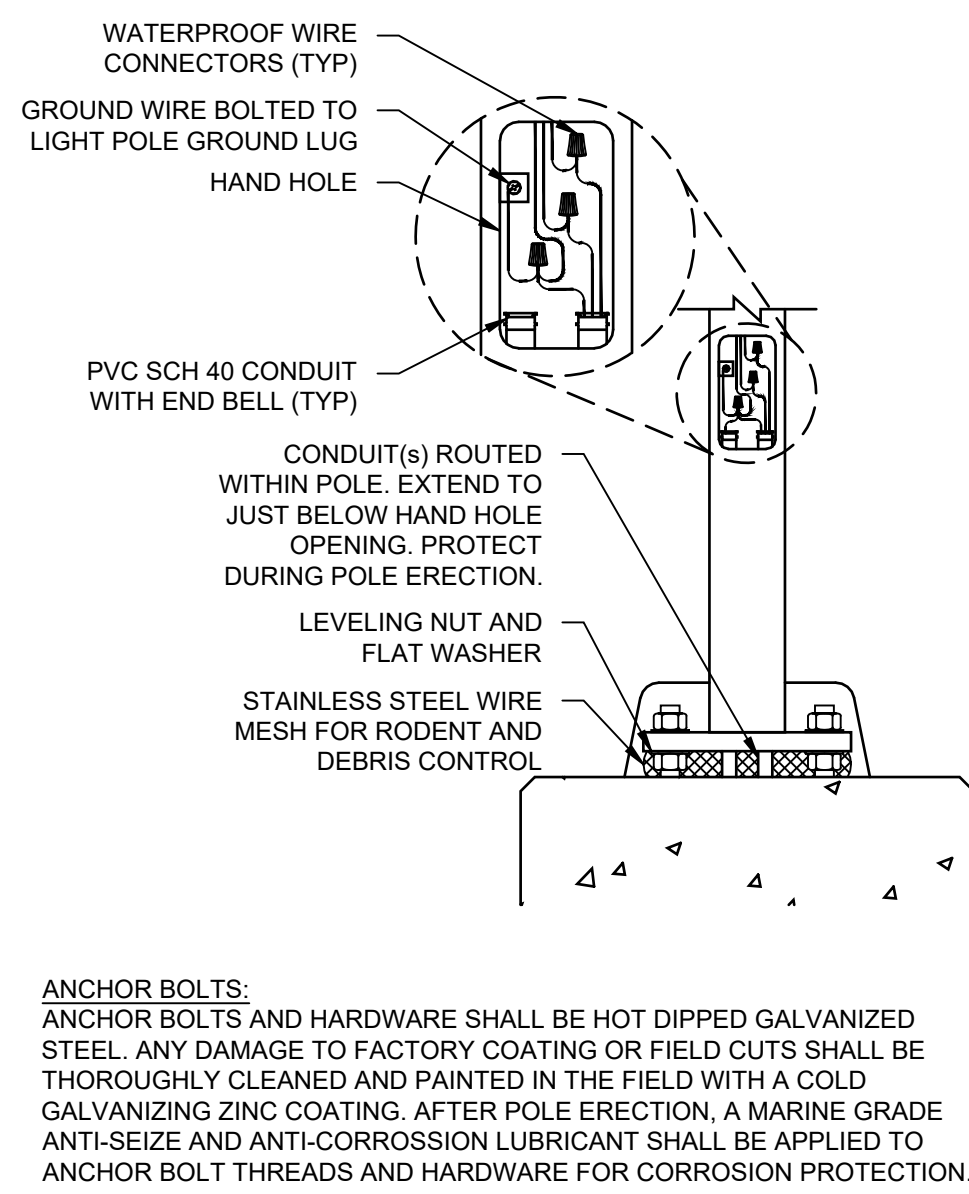


NOTE FOR THE CONTRACTOR:
CONTRACTOR HAS AN OPTION TO USE PRE-CAST POLE BASE THAT SATISFIES THE DESIGN CRITERIA AS LISTED IN THIS DETAIL. G.C. TO NOTIFY THE E.O.R. IN CASE OF ANY DISCREPANCY.

STRUCTURAL NOTES:	
THE COMPLETE LIGHT POLE ASSEMBLY INCLUDING POLE, CROSS ARM(S), LIGHT FIXTURES AND FOUNDATION MEET THE MINIMUM REQUIREMENTS OF IRC 2017 8th EDITION (INCLUDING HVHZ SECTION 1620 AND 1819.7 REQUIREMENTS), ASCE7-10 AND ACI318-14.	
2. WIND LOAD:	136 MPH
3. RISK CATEGORY:	II
4. EXPOSURE:	C
5. MINIMUM POLE EPA RATING:	3 SF
6. FIXTURE MOUNTING HEIGHT	20 FT
7. DEPTH OF FOUNDATION	7 FT
8. HEIGHT OF FOUNDATION	3 FT
9. WIDTH OF FOUNDATION (ROUND)	2 FT

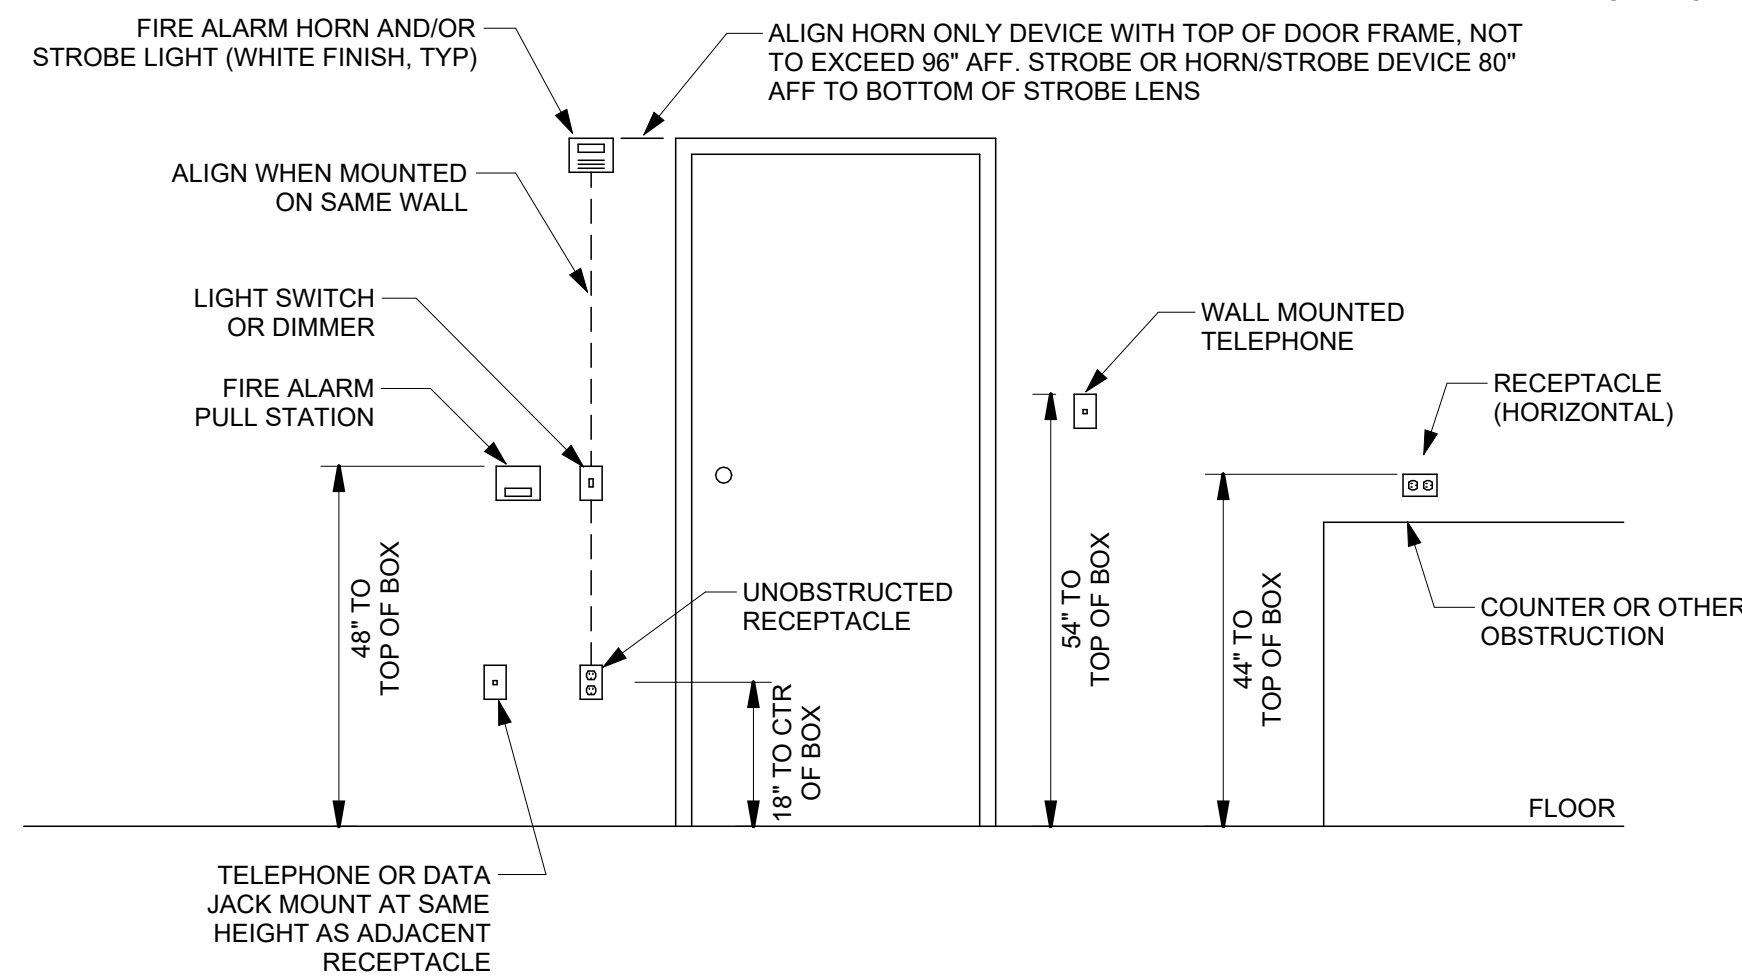


MOUNTING HEIGHT DIAGRAM

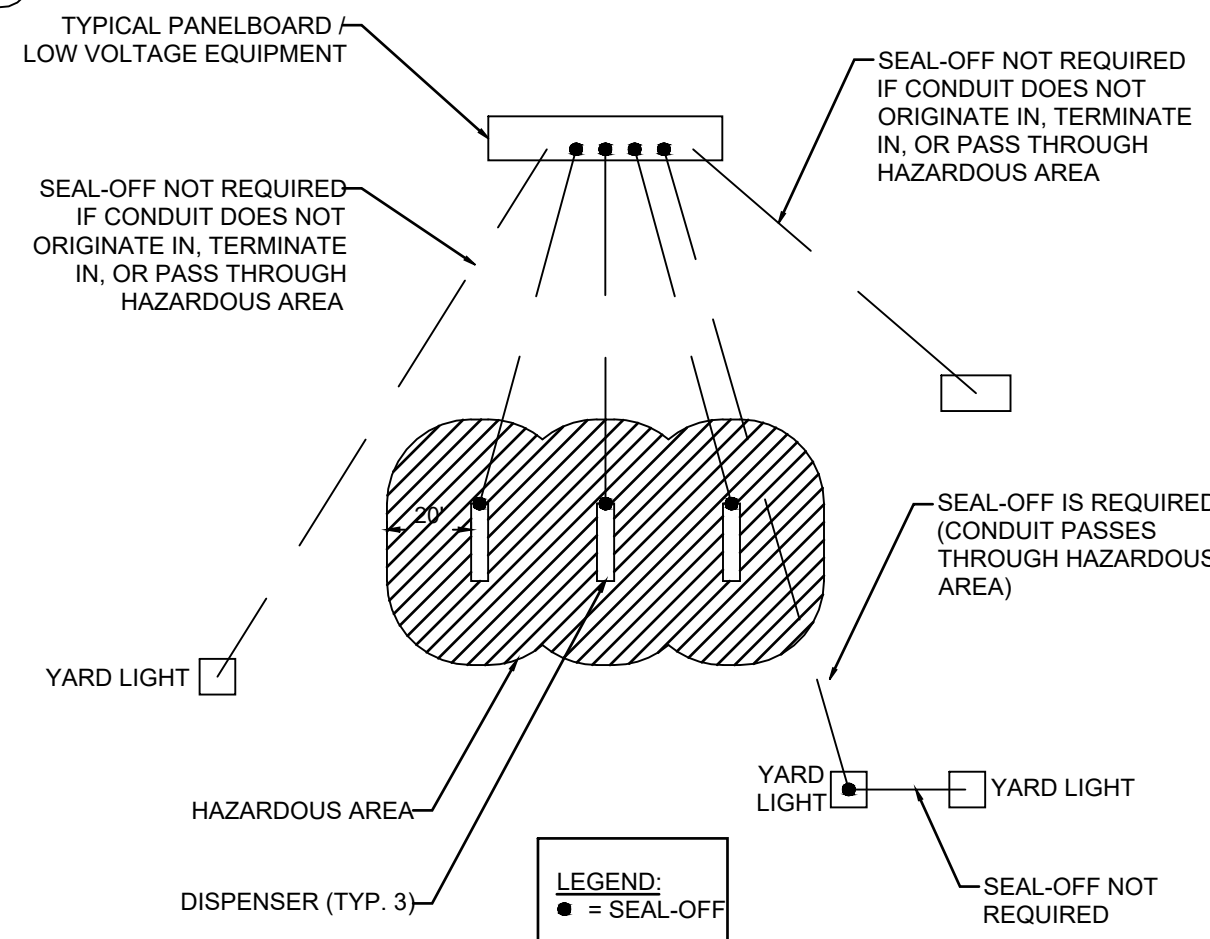


NOTES:
ELECTRICAL WIRING SHALL BE DONE IN ACCORDANCE WITH APPROVED LOCAL ELECTRICAL CODES AND BY A LICENSED ELECTRICIAN. THE PUMP SHALL BE PROPERLY GROUNDED. THE RGS CONDUIT SHALL BE USED WHEN INSTALLING ELECTRICAL WIRING.


SEAL OFF DETAIL

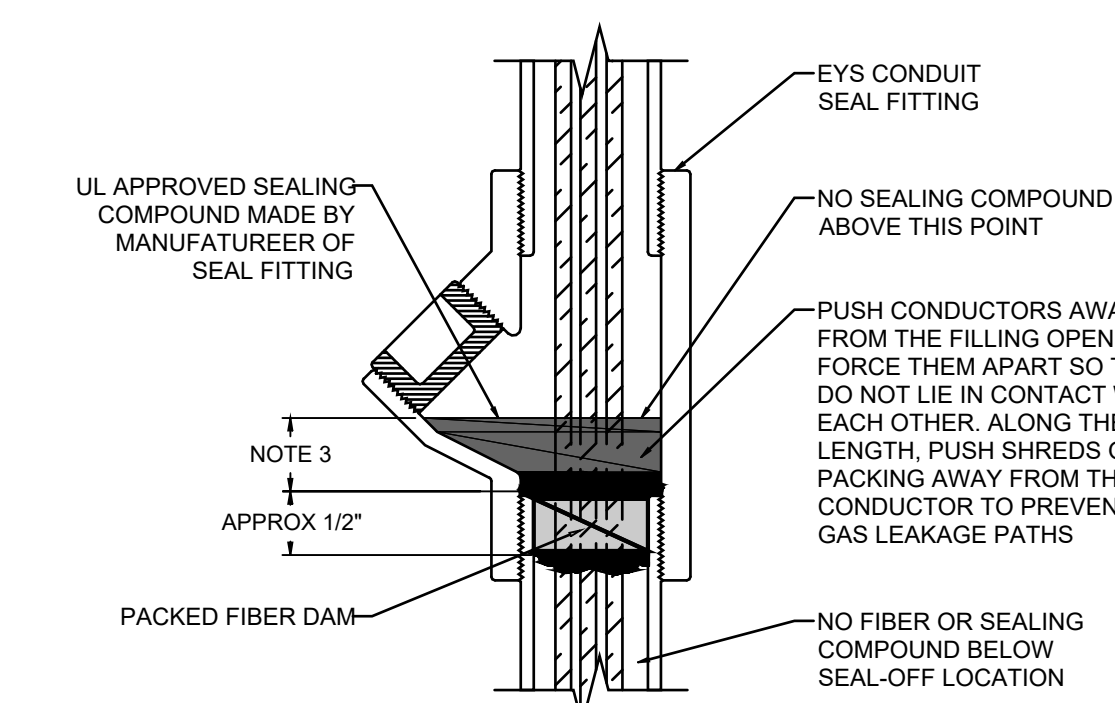

1. PROVIDE EXPLOSION PROOF SEALS-OFFS IN ACCORDANCE WITH ARTICLES 500, 501 AND 514 (CLASS 1, DIVISION 1 & 2) OF THE 2011 NEC. TYPICAL FOR ALL CONDUITS IN CLASS 1 LOCATIONS, INCLUDING LOW VOLTAGE CONDUITS.
2. CONDUIT FILL SHALL NOT EXCEED 25% OF SEAL-OFF AS PER NEC. 501.15(C)(6)
3. THE THICKNESS OF THE SEALING COMPOUND SHALL BE MINIMUM THE TRADE SIZE OF THE SEALING FITTING AND NO LESS THAN 5/8".

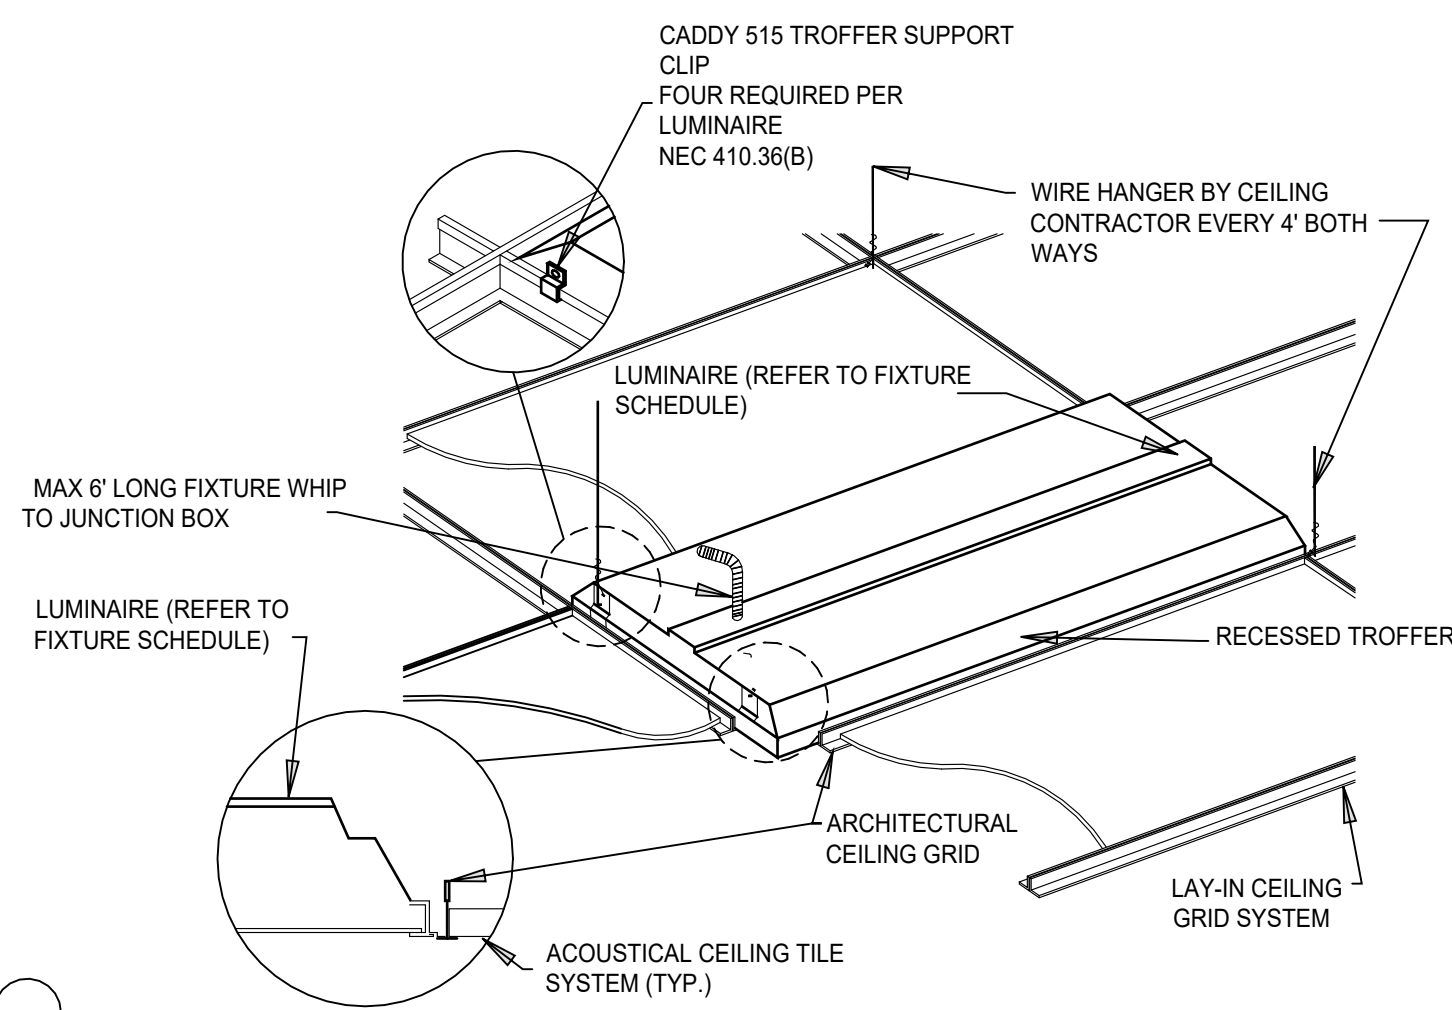

TROFFER

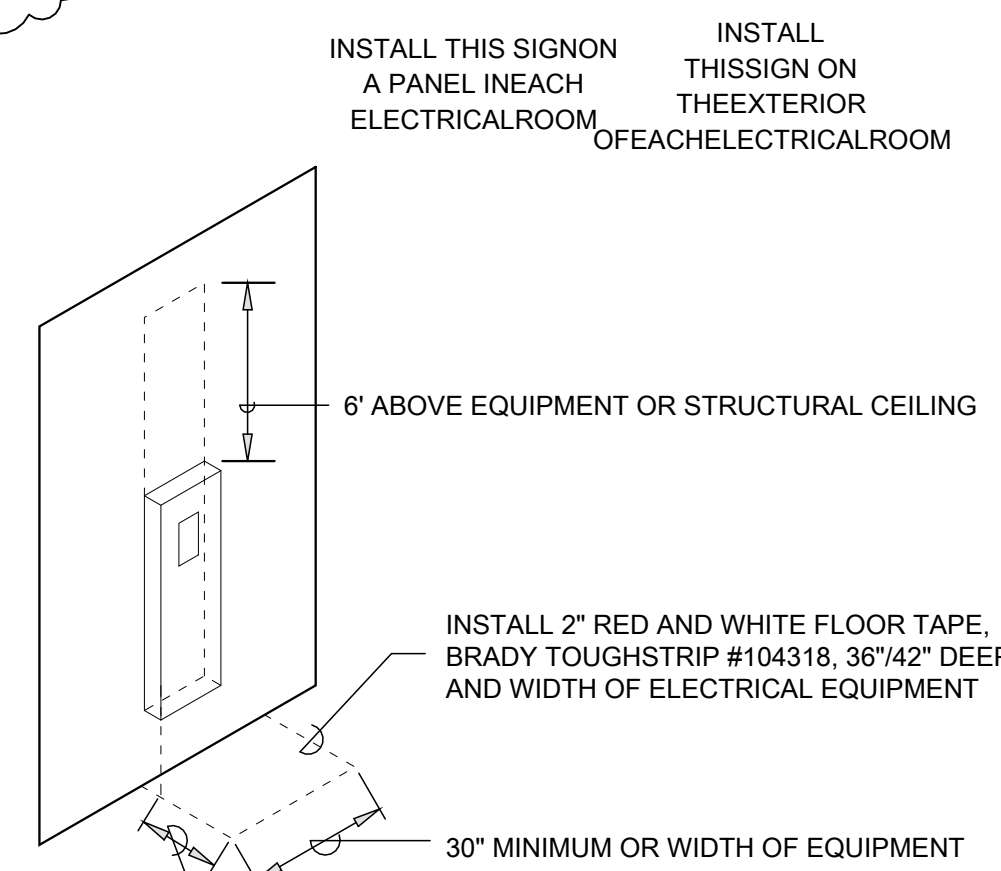

NEC 110.28(E)- THE SPACE EQUAL TO THE WIDTH AND DEPTH OF THE EQUIPMENT AND EXTENDING TO A HEIGHT OF 6" ABOVE THE EQUIPMENT SHALL BE DEDICATED TO THE ELECTRICAL INSTALLATION.


WORKING CLEARANCES

NORMAL BRANCH EQUIPMENT BRANCH	WHITE
LIFE SAFETY BRANCH	GREEN
CRITICAL BRANCH	YELLOW
FIRE ALARM	ORANGE
NURSE CALL	RED
DATA	PURPLE
ACCESS CONTROL	BLUE
CAMERAS & IPTV	GRAY
	BLACK


ALL CONDUIT AND MC CABLE SYSTEMS SHALL BE COLOR CODED AS INDICATED.

- 1 ALL EXTERNAL SIDES OF EACH BOX AND COVER
- 2 A THREE INCH WIDE BAND AT LEAST EVERY 10 FEET ON CONDUIT OR CABLE.
- 3 A THREE INCH WIDE BAND ON BOTH SIDES OF ALL WALL PENETRATIONS WITHIN 12".

COLOR CODING

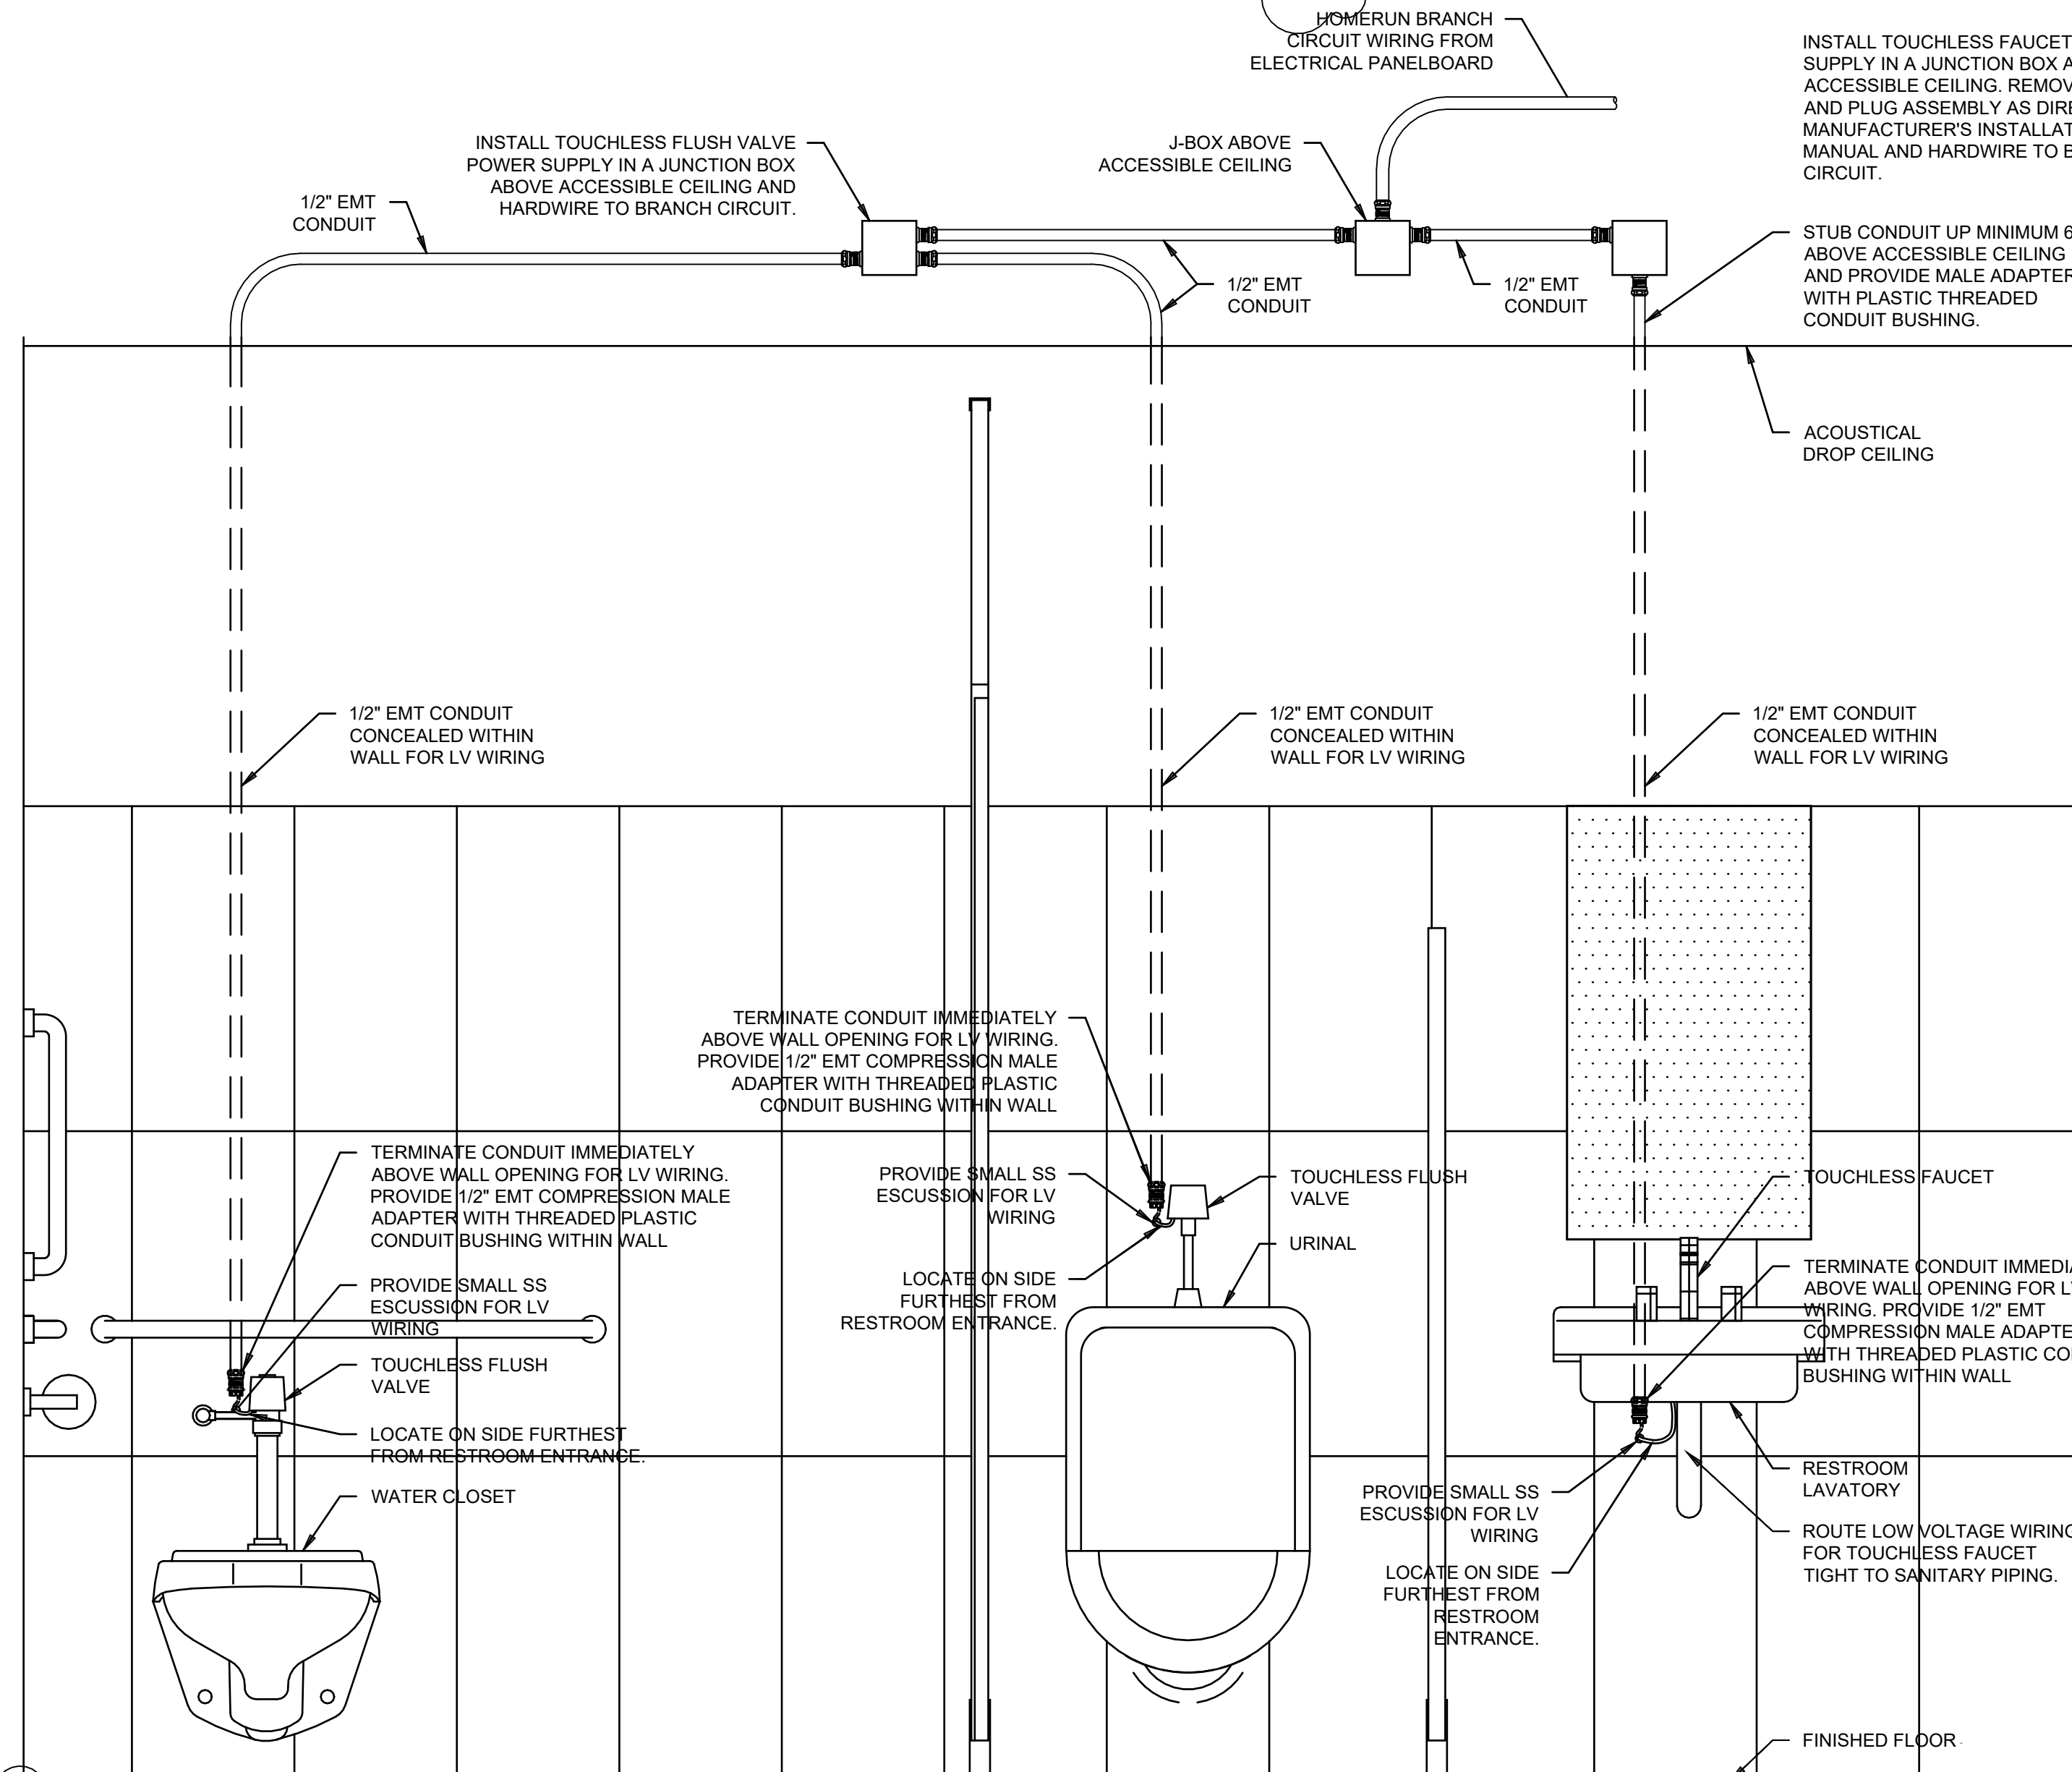

RESTROOM

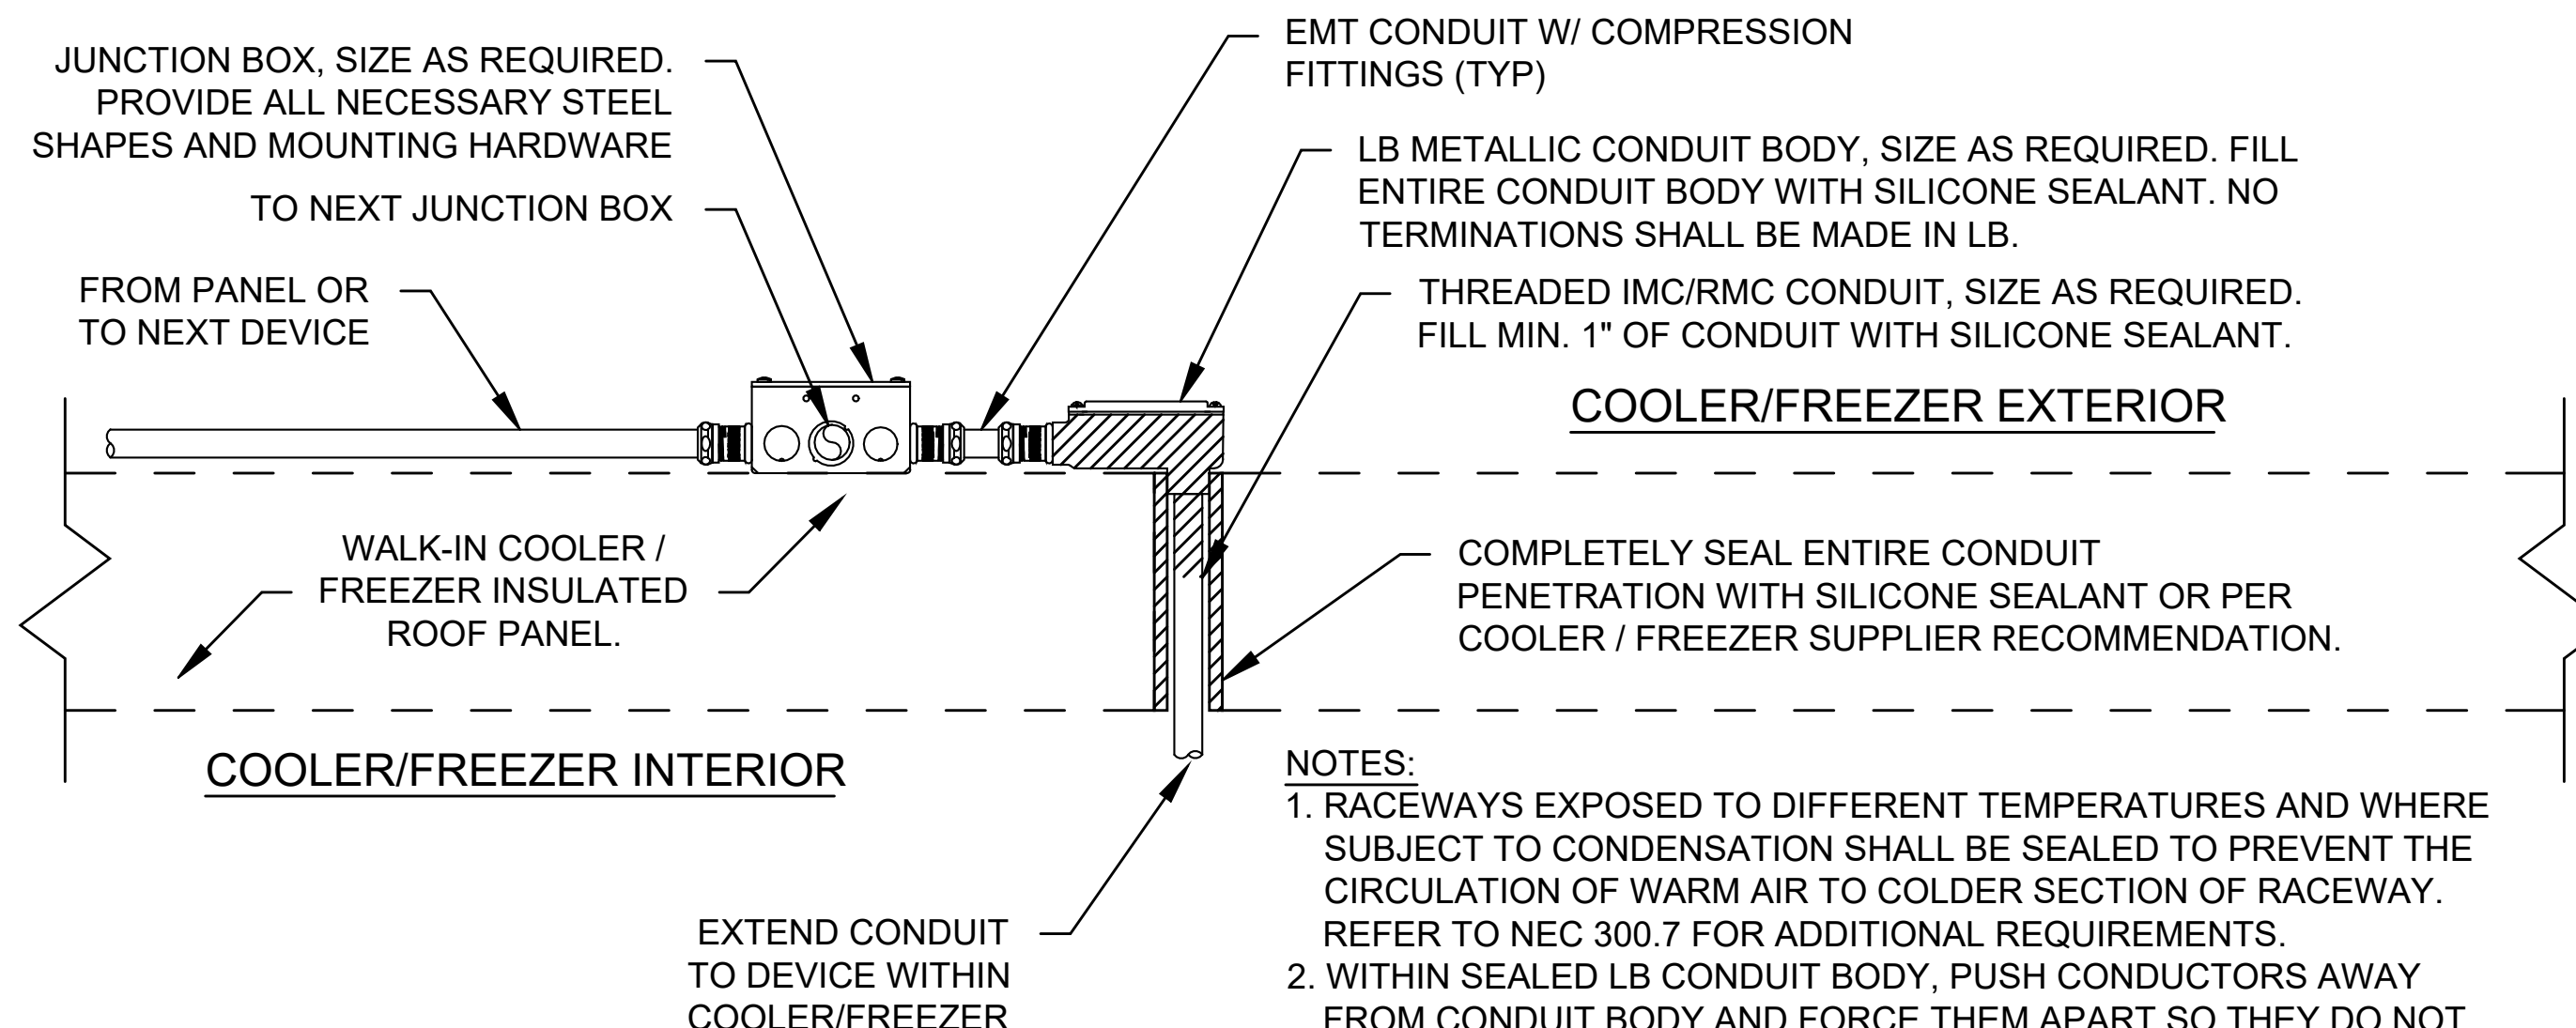

FREEZER COOLER

ALL DESIGN PRIOR TO 08/28/2025 WAS PERFORMED BY IMEG UNDER THE RESPONSIBLE CHARGE OF THOMAS C. NIELSEN, PE #53492. ALL SUBSEQUENT DESIGN BY IMEG IS UNDER THE RESPONSIBLE CHARGE OF BRIAN J. LEAVITT, PE #87733.

BUSY BEE ELLISVILLE

136 SW WEBBS GLN
LAKE CITY, FL 32024

PROJECT NO.: 22024
DATE: 06/02/2025
PRIOR ISSUES:
10/24/2025 JASL #1

ELECTRICAL DETAILS

E6.1

DRAWN BY: IMEG
CHECKED BY: IMEG

100%
CONSTRUCTION DOCUMENTS

\\files\active\projects\2023\23000902.00\Design\Electrical\20250606 Task Force Reference\Panel Schedules\Electrical Panels.xls

PANEL: L4B													
CONN. LOAD:				DEMAND LOAD:				18.1 KVA				NQOD TYPE	
56.3 AMPS				50.2 AMPS				SQUARE D					
MAIN: 250A MLO				VOLTAGE: 208 120 , 3PH, 4W.				AIC: 10,000					
MTG: SURFACE				LOCATION: KITCHEN NORTH				ACTUAL AIC: X					
LOAD TYPE	REMARKS	KW	BKR.	OPT	CIRCUIT NUMBER AND PHASE		OPT	BKR.	KW	REMARKS	LOAD TYPE		
R	RCPT U/C SAFE	0.20	20/1		1	A 2		20/1	0.36	J-BOX DOOR	R		
R	RCPT PRINTER	0.40	20/1		3	B 4		20/1	0.36	J-BOX DOOR	R		
R	MISC FUEL EQUIP	0.30	20/1		5	C 6		20/1	0.18	TV POS 139	R		
R	RCPT POS SYSTEM	0.40	20/1		7	A 8		20/1		SPARE			
R	RCPT POS SYSTEM	0.20	20/1		9	B 10		20/1		SPARE			
R	RCPT POS SYSTEM	0.20	20/1		11	C 12		20/1		SPARE			
R	RCPT POS SYSTEM	0.20	20/1		13	A 14		20/1	0.25	DWFEF-1	H		
R	RCPT POS SYSTEM	0.20	20/1		15	B 16		20/1	1.08	RCPT ROOF	R		
R	RCPT U/C SAFE	0.20	20/1		17	C 18		20/1	0.72	RCPT ROOF	R		
R	RCPT PRINTER	0.40	20/1		19	A 20		20/1	0.36	RCPT ROOF	R		
R	MISC FUEL EQUIP	0.30	20/1		21	B 22		20/1	0.90	RCPT ROOF	R		
H	DCU-1/DSS-1	1.00	20/2		23	C 24		20/1	0.72	RCPT ROOF	R		
H		1.00			25	A 26		20/1	0.72	RCPT ROOF	R		
R	RCPT CORR	0.72	20/1		27	B 28		20/1	1.50	ICE MACHINE	A		
R	RCPT RM 133	1.08	20/1		29	C 30		20/1	1.50	ICE MACHINE	A		
R	RCPT OFF 139A	0.72	20/1		31	A 32		20/1	1.50	ICE MACHINE	A		
R	RCPT OFF 134	0.72	20/1		33	B 34		20/1	1.00	J-BOX CORR	R		
R	RCPT RM 138	0.90	20/1		35	C 36		20/1		SPARE			
	SPARE		20/1		37	A 38		20/1		SPARE			
	SPARE		20/1		39	B 40		20/1		SPARE			
	SPARE		20/1		41	C 42		20/1		SPARE			
	SPARE		20/1		43	C 44		20/1		SPARE			
	SPARE		20/1		45	C 46		20/1		SPARE			
	SPARE		20/1		47	C 48		20/1		SPARE			
	SPARE		20/1		49	C 50		20/1		SPARE			
	SPARE		20/1		51	C 52		20/1		SPARE			
	SPARE		20/1		53	C 54		20/1		SPARE			
	SPARE		20/1		55	C 56		20/1		SPARE			
	SPARE		20/1		57	C 58		20/1		SPARE			
	SPARE		20/1		59	C 60		20/1		SPARE			
	SPARE		20/1		61	C 62		20/1		SPARE			
	SPARE		20/1		63	C 64		20/1		SPARE			
	SPARE		20/1		65	C 66		20/1		SPARE			

\\files\active\projects\2023\23000902.00\Design\Electrical\20250606 Task Force Reference\Panel Schedules\Electrical Panels.xls

PANEL: LK1B													
CONN. LOAD:				DEMAND LOAD:				68.9 KVA				NQOD TYPE	
285.7 AMPS				191.2 AMPS				SQUARE D					
MAIN: 400A MCB				VOLTAGE: 208 120 , 3PH, 4W.				AIC: 22,000					
MTG: SURFACE				LOCATION: KITCHEN NORTH				ACTUAL AIC: X					
LOAD TYPE	REMARKS	KW	BKR.	OPT	CIRCUIT NUMBER AND PHASE		OPT	BKR.	KW	REMARKS	LOAD TYPE		
R	ITEM 801	2.00	25/2		1	A 2			6.92		R		
R		2.00			3	B 4		30/3	6.92	ITEM 804	R		
R	ITEM 801	2.00	25/2		5	C 6			6.92		R		
R		2.00			7	A 8			6.92		R		
R	ITEM 801	2.00	25/2		9	B 10		30/3	6.92	ITEM 804	R		
R		2.00			11	C 12			6.92		R		
M		4.14			13	A 14			6.92		R		
M	ITEM 504	4.14	45/3		15	B 16		30/3	6.92	ITEM 804	R		
M		4.14			17	C 18			6.92		R		
M		4.14			19	A 20		20/1	1.11	ITEM 806	R		
M	ITEM 504	4.14	45/3		21	B 22		20/1	1.11	ITEM 806	R		
M		4.14			23	C 24		20/1	1.11	ITEM 806	R		
R	ITEM 505	0.12	20/1		25	A 26		20/1	0.36	RCPT TV 128	R		
	SPARE		20/1		27	B 28		20/1		SPARE			
	SPARE		20/1		29	C 30		20/1		SPARE			
	SPARE		20/1		31	A 32		20/1		SPARE			
	SPARE		20/1		33	B 34		20/1		SPARE			
	SPARE		20/1		35	C 36		20/1		SPARE			
	SPARE		20/1		37	A 38		20/1		SPARE			
	SPARE		20/1		39	B 40		20/1		SPARE			
	SPARE		20/1		41	C 42		20/1		SPARE			

\\files\active\projects\2023\23000902.00\Design\Electrical\20250606 Task Force Reference\Panel Schedules\Electrical Panels.xls

PANEL: LK3													
CONN. LOAD:				DEMAND LOAD:				48.2 KVA				NQOD TYPE	
220.4 AMPS				133.9 AMPS				SQUARE D					
MAIN: 400A MCB				VOLTAGE: 208 120 , 3PH, 4W.				AIC: 22,000					
MTG: SURFACE				LOCATION: KITCHEN SOUTH				ACTUAL AIC: X					
LOAD TYPE	REMARKS	KW	BKR.	OPT	CIRCUIT NUMBER AND PHASE		OPT	BKR.	KW	REMARKS	LOAD TYPE		
R	ITEM G103	1.00	20/1		1	A 2		20/1	1.38	ITEM G100	M		
R	ITEM G113	1.00	20/1		3	B 4		20/1	0.80	ITEM G111	R		
R	ITEM G100	1.38	20/1		5	C 6		20/1	0.48	ITEM D201	R		
R	ITEM G112	1.00	20/1		7	A 8		20/1	1.00	ITEM G110	R		
R	ITEM G100	1.00	20/1		9	B 10		20/1	1.38	ITEM G101	M		
R	ITEM G100	1.00	20/1		11	C 12		20/1	1.00	ITEM G109	R		
R	ITEM C251	0.48	20/1		13	A 14		20/1	1.38	ITEM G100	M		
R	ITEM A353	0.30	20/1		15	B 16		20/1	1.00	ITEM G108	R		
R	ITEM A355	0.30	20/1		17	C 18		20/1	3.40	ITEM B302	R		
R		0.89			19	A 20		20/1	0.36	ITEM B303	M		
R	ITEM A354	0.89	20/2		21	B 22		20/1	0.36	ITEM B302	M		
R	ITEM A356	3.80	20/1		23	C 24		20/1	2.16	ITEM 308	R		
R	ITEM A356	3.80	20/1		25	A 26		20/1	2.16	ITEM 308	R		
R		2.70			27	B 28		20/1	0.36	ITEM B303	M		
R	ITEM A358	2.70	30/2		29	C 30		20/1	0.36	ITEM B305	R		
R	ITEM E451	0.48	20/1		31	A 32		20/1	2.16	ITEM B301	R		
R	ITEM G107	1.00	20/1		33	B 34		20/1	2.16	ITEM B301	M		
R	TVS STORE 110	1.08	20/1		35	C 36		20/1	0.36	ITEM B303	M		
R		0.89			37	A 38		20/1	2.16	ITEM B301	R		
R	ITEM A354	0.89	20/2		39	B 40		20/1		SPARE			
A	ITEM G102	0.11	20/1		41	C 42		20/1		SPARE			
A	ITEM G106	0.90	20/1		43	A 44		20/1		SPARE			
A	ITEM G106	0.90	20/1		45	B 46		20/1	0.48	ITEM F401	R		
	SPARE		20/1		47	C 48		20/1	13.00	ITEM F402	R		
	SPARE		20/1		49	A 50		20/1	13.00	ITEM F402	R		
	SPARE		20/1		51	B 52		20/1		SPARE			
	SPARE		20/1		53	C 54		20/1		SPARE			
	SPARE		20/1		55	A 56		20/1		SPARE			
	SPARE		20/1		57	B 58		20/1		SPARE			
	SPARE		20/1		59	C 60		20/1		SPARE			
	SPARE		20/1		61	A 62		20/1		SPARE			
	SPARE		20/1		63	B 64		20/1		SPARE			
	SPARE		20/1		65	C 66		20/1		SPARE			

\\files\active\projects\2023\23000902.00\Design\Electrical\20250606 Task Force Reference\Panel Schedules\Electrical Panels.xls

PANEL: KE1				
------------	--	--	--	--




10175 Fortune Parkway, Suite 701
Jacksonville, FL 32254
p 904.683.9201 f 904.683.9702

www.kasperarch.com
FL License No.: AA26000802



www.IMEGcorp.com
9133 E. Shawnee Parkway
Jacksonville, Florida 32216
Ph: (904) 483-5200 Fax: (904) 483-6700
email: mail@McVighMangum.com
CA 6330
Eng. of Record: Thomas C. Nielsen
License No.: 53492

ALL DESIGN PRIOR TO 08/28/2025 WAS PERFORMED BY IMEG UNDER THE RESPONSIBLE CHARGE OF THOMAS C. NIELSEN, PE #53492. ALL SUBSEQUENT DESIGN BY IMEG IS UNDER THE RESPONSIBLE CHARGE OF BRIAN J. LEAVITT, PE #87733.

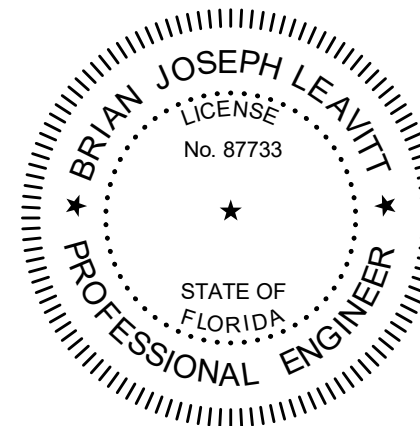

BUSY BEE
ELLISVILLE

136 SW WEBBS GLN
LAKE CITY, FL 32024

PROJECT NO.: 22024

DATE: 06/02/2025

PRIOR ISSUES:

10/24/2025 IASB #1

ELECTRICAL
SPECIFICATIONS

E8.3

DRAWN BY: IMEG
CHECKED BY: IMEG

100%
CONSTRUCTION
DOCUMENTS

© 2013

SECTION 26 28 13 - FUSES

PART 1 - GENERAL

PART 2 - PRODUCTS

2.1 MANUFACTURERS - FUSES

A. Bussman, Division of Eaton, Edison Fuse - Division of Cooper Industries, Mersen, Littelfuse Inc.

2.2 FUSES

A. Dimensions and Performance: NEMA FU-1 Class as specified or indicated.

B. Voltage: Provide fuses with voltage rating suitable for circuit phase-to-phase voltage.

C. Fuses with ratings larger than 600 amperes: Class L (time delay), unless otherwise noted on the drawings.

D. Fuses with ratings larger than 200 amperes but equal to or less than 600 amperes: Class RK-1 (time delay), unless otherwise noted on the drawings.

E. Fuses with ratings less than or equal to 200 amperes (not including control transformer fuses): Class RK-5, unless otherwise noted on the drawings.

F. Control transformer fuses: Class CC (time delay).

G. Fuses for packaged equipment: Size and type as recommended by equipment manufacturer.

END OF SECTION 26 28 13

SECTION 26 28 16 - DISCONNECT SWITCHES

PART 1 - GENERAL

1.1 SUBMITTALS

A. Submit product data under provisions of Section 26 05 00.

B. Product Data: For each type of enclosed switch, circuit breakers, accessory and component indicated, include dimensions, weights, and manufacturer's technical data on features, performance, and ratings.

C. For each type of enclosed switch, enclosure types, current and voltage ratings, short-circuit current ratings, UL listing for series rating of installed devices, features, characteristics, ratings, and factory settings of individual overcurrent protective devices and auxiliary components.

PART 2 - PRODUCTS

2.1 FUSIBLE AND NON-FUSIBLE SWITCHES

A. Acceptable Manufacturers:

1. Square D 3110 Series

2. Eaton DH Series

3. ABB TH Series

4. Siemens HNF / HF Series

B. FDB: Fusible Switch Assemblies: NEMA KS-1 Type heavy duty, quick-make, quick-break, load interrupter enclosed knife switch with externally operable handle interlocked to prevent opening front cover with switch in ON position without a tool. Handle lockable in OFF position. Fuse Clips: Class RF fuse clips only, unless indicated otherwise on the drawings.

C. DS: Non-Fusible Switch Assemblies: NEMA KS-1 Type heavy duty, quick-make, quick-break, load interrupter enclosed knife switch with externally operable handle interlocked to prevent opening front cover with switch in ON position without a tool. Handle lockable in OFF position.

D. Enclosures: Type as indicated on the disconnect schedule.

E. Accessories: Provide the following accessories. Refer to Disconnect Schedule for additional requirements for each application.

1. Lockable

2. Provide finger safe barriers for exposed line-side terminations and energized components when the switch is in the open position.

2.2 MOLDED CASE CIRCUIT BREAKERS AND SWITCHES

A. Acceptable Manufacturers:

1. Square D

2. Eaton

3. ABB

4. Siemens

B. Accessories: Provide the following accessories. Refer to Disconnect Schedule for additional requirements for each application.

1. Lockable

2. Provide finger safe barriers for exposed line-side terminations and energized components when the switch is in the open position.

2.3 MOTOR DISCONNECT SWITCH

A. Acceptable Manufacturers:

1. Square D 3110 Series

2. Eaton DS Series

3. ABB ML Series

4. Siemens LBR Series

B. MD: Rotary Switch Assemblies: Rated for making and breaking loads, rotary type enclosed switch with externally operable handle interlocked to prevent opening front cover with switch in ON position without a tool. Handle lockable in OFF position.

C. Enclosures: Type as indicated on the Disconnect Schedule.

D. Ground lug connection provided in enclosure.

E. Accessories: Provide the following accessories. Refer to Disconnect Schedule for additional requirements for each application.

1. Lockable

2. Provide finger safe barriers for exposed line-side terminations and energized components when the switch is in the open position.

F. Listed UL 508 suitable for motor control.

PART 3 - EXECUTION

END OF SECTION 26 28 16

SECTION 26 43 00 - SURGE PROTECTION DEVICES

PART 1 - GENERAL

1.1 SUBMITTALS

A. Shop Drawings: Should include device dimensions, mounting requirements including wire size and over-current protection device rating, nameplate information, electrical ratings, short-circuit current rating, and test results as indicated below under "Testing, Warranty and Life Expectancy" as provided by an independent test lab or a UL certified test lab for the category(ies) of suppression device(s) specified using the appropriate IEEE test wave. Product data sheets with installation instructions for each size and type of device are required. Shop drawings submitted without the testing data as required by section this section will be rejected.

1.2 TESTING, WARRANTY AND LIFE EXPECTANCY

A. Manufacturer must provide independent testing on repetitive capability and maximum surge current rating of service entrance suppressor units. This shall be performed at a nationally recognized lab not affiliated with the manufacturer.

1. Single pulse surge current capacity: Single pulse surge current tested in a mode at rated surge currents.

2. Single pulse surge current capacity test: An initial UL 1449 defined 1.2 x 50µs, 6000V open circuit voltage waveform and an 8 x 20µs, 500A and 3kA short circuit current waveform shall be applied to benchmark the unit's suppression voltage (VPR).

3. A single 8 x 20µs waveform pulse of maximum rated surge current per mode shall then be applied. To complete the test, another UL 1449 surge shall be applied to verify the unit's survival. Survival is achieved if the suppression voltage measured from the two UL 1449 surges does not vary by more than 10%.

B. Minimum Repetitive Surge Current Capacity:

1. Service entrance suppressor units shall be tested repetitively at an independent lab to verify repetitive capacity.

2. Minimum Repetitive Surge Current Capacity Test:

a. An initial UL 1449 surge defined as 1.2 x 50µs, 6000V open circuit voltage waveform and an 8 x 20µs, 500A and 3kA short circuit current waveform shall be applied to benchmark the unit's suppression voltage.

b. A repetitive number of ANSI/IEEE C62.41.2-2002 (Category C3) surges, defined as a 1.2 x 50µs 10kV or 20kV open circuit voltage waveform and an 8 x 20µs, 10,00A short circuit current waveform, shall then be applied at one-minute intervals.

c. To complete the test, another UL 1449 surge shall be applied to verify the unit's survival.

3. Survival is achieved if the suppression voltage (VPR) does not vary by more than 10%.

4. Proof of such testing shall be the test log generated by the surge generator.

C. Provide UL 1449 classification white sheet pages indicating the VPR (voltage protection rating) for each SPD unit submitted for this product using the BVV/3KA combination wave surge.

D. Warranty: Ten (10) years. Includes workmanship, installation and programming.

E. No scheduled parts replacement or preventative maintenance shall be required.

PART 2 - PRODUCTS

2.1 DESCRIPTION

A. General: The unit shall provide transient voltage suppression, surge current diversion and high frequency noise attenuation, when connected in parallel to the facilities distribution system. The unit MOV shall not be less than 115% of the nominal system voltage. Operating frequency shall be for a 60 Hz system. The unit shall provide protection in all normal modes for "surge" and "surge" systems.

B. Short Circuit Current Rating: Provide factory label for SCOCR rating. The short circuit current rating shall be the larger of the listed value on the drawings or as required by the equipment protected.

2.2 RATINGS

A. SPD/Secondary Distribution Suppressors:

1. For 277/480 and 120/208-volt, 3 phase, 4 wire, type 2 category B3C1 unit.

a. Surge current capacity: 60,000/120,000amps per protection mode/phase

b. Nominal Discharge Current (IN): 20 kA.

c. Mounting: Refer to the drawings.

d. Voltage Protection Rating: Refer to requirements below.

e. Components: Minimum component size of 20mm metal thermally protected oxide varistors (MOV).

2. Manufacturers:

a. Square D SurgeLogic EMA Series

b. Siemens TP54 Series

c. Eaton SPD Series

d. Current Technology Current Guard Plus

e. ASCO Power Technologies 400 Series

f. LEA International CFS Series

B. Voltage Protection Rating:

1. Protection modes and UL 1449 voltage protection rating for surge suppression units per each mode (L-L, L-G, L-G, and L-G as appropriate).

a. 277/480 Volt, 3 phase, 4 wire: 1200 Volt L-L, L-G, N-G and 1800 Volt L-L.

b. 480 Volt, 3 phase, 3 wire: 2000 Volt L-L, L-G.

c. 120/208 Volt, 3 phase, 4 wire: 700 Volt L-L, N-G, 800 Volt L-G and 1200 Volt L-L.

C. EMF/RF Noise Rejection or Filtering:

1. Each unit shall include a UL1283 first order, high-frequency filter for noise filtering between 10 kHz and 100 MHz.

2. Each unit shall include solid-state indicators with externally mounted LED visual status indicators that indicate on-line status of each protection mode of the unit.

3. Each unit shall include a visual indicator that indicates the unit is functioning properly and providing protection.

4. Each unit shall include an audible alarm with silencing switch to indicate when protection has failed.

5. Provide each service entrance type unit(s) with a transient counter.

E. Fuses:

1. Use fuses recommended by the manufacturer to satisfy repetitive UL 1449 operation of the surge suppression unit.

2. Fuses shall be rated 200, 000 AIC minimum interrupting capacity.

PART 3 - EXECUTION

3.1 INSTALLATION

A. Mounting Location:

1. The unit shall be installed as close as practical to the panel(s) in accordance with applicable national/Local Electrical Codes and the manufacturer's recommended installation instructions. Connect the unit to be replaced using a conduit nipple. Flush mount the unit in the front of the switchboard. Mount unit directly across from the breaker or disconnected service it.

2. Integral surge protection devices mount between the main and branch circuit breakers.

3. Internal surge protection devices shall be installed in a trench compartment isolated from other components.

B. Connections:

1. Contractor shall provide wire and circuit breakers sized per the approved manufacturer's requirements, but no greater than 5/0".

2. The surge protection unit shall be lockable from the electrical distribution system via 3 pole circuit breaker mounted in the switchboard/panelboard or equipped with a factory supplied integral fused switch or circuit breaker. Single phase 150 volt units shall be hardware without a disconnecting means.

3. Neutral and ground shall not be bonded together at secondary panelboard locations.

C. Additional Locations: Critical Load Protection - Fixed Equipment (120 Volts):

1. Install an A/Surge protection device between each of the following equipment items and its power supply conductors:

a. Fire alarm master panel

b. Phone switch

c. Intercom master

d. Building management system master

e. Security system master

f. Telephone switch

g. TV head

END OF SECTION 26 43 00

SECTION 26 51 19 - LED LIGHTING

PART 1 - GENERAL

1.1 RELATED SECTIONS

A. The lighting system design includes a combination of luminaire sources, lighting control components, programming sequence, and supplementary components for building and energy code compliance. The design uses performance-based specifications for portions of the lighting system to account for the limitation of comparable product information available by competitive manufacturers. The Contractor shall reference related specification sections, notes, schedules, and details for sequencing, pricing, submittals, and installation. The Contractor shall coordinate system component compatibility among various manufacturers and suppliers for a turnkey lighting system.

1.2 SUBMITTALS

A. Submit product data under provisions of Section 26 05 00.

B. Basic Requirements of Submittal:

1. Submit product data sheets for luminaires, LED light engines, drivers and poles. Include complete product model number with all options as specified. Submittal shall be arranged with luminaires listed in ascending order, and with each luminaire's LED light engine, driver, or pole information following luminaire's product data. Failure to organize submittal in this manner will result in the submittal being rejected.

2. Submit luminaire product data, dimensions and weights if not included in product data sheet submittal.

3. Include outline drawings, support points, weights, and accessory information for each luminaire.

C. LED Lighting - Control Compatibility Submittal:

1. Submit lighting control compatibility data for each LED luminaire. The submittal shall clearly identify device data proposed by the Contractor and approved by the luminaire manufacturer for dimming, switching, addressable, wireless, and similar control characteristics.

1.3 WARRANTY

A. LED Light Engines and Drivers:

1. LED Drivers and Dimming Drivers: Five (5) years

2. Light Emitting Diode (LED) Light Engines: Five (5) years

B. Emergency Lighting Units, drivers and Exit Signs:

1. Emergency Lighting Units and drivers: Three (3) year, non-prorated

2. Exit Signs: Three (3) year, non-prorated

3. Emergency Unit and Exit Sign Battery: Sealed lead acid or lead calcium cell, requiring no maintenance or replacement for ten (10) years under normal conditions.

C. Automatic Load Control Relay (ALCR): Five (5) year

PART 2 - PRODUCTS

2.1 INTERIOR LUMINAIRES AND ACCESSORIES - GENERAL

A. Lensed Troffers: Provide fringed frames with lathe and 0.125-inch thick virgin acrylic lenses. Prismatic lenses shall have depth of no less than 0.060", KSH12 or equal. Other lenses as scheduled.

B. Recessed Luminaires: Confirm ceiling and wall type and furnish type and accessories necessary to permit proper installation in each system. Where recessed ceiling or wall assemblies are specified, furnish and install listed enclosures around luminaires that maintain the system rating.

C. Luminaires: Louvers shall be anodized low reflective specular aluminum with reinforced corners and reinforcing construction.

D. Suspended Luminaires: Coordinate power feed and suspension components with ceiling type and architectural RCP for proper fit and location. Ensure finished installations are plumb and level at elevations specified. Verify suspension length prior to submittal.

E. Painted reflector surfaces shall have a minimum reflectance of 80%.

F. All painted components shall be painted after fabrication.

2.2 EXTERIOR LUMINAIRES AND ACCESSORIES - GENERAL

A. Listed for wet or damp location as scheduled. Provide ingress protection (IP) rating when scheduled.

B. Provide low temperature LED drivers, with reliable starting to -20°F.

C. In-grade luminaires shall have lamp(sic) separation to prevent surface temperature from exceeding 115°F. Compartment separation of wire entry and control gear(sic) chamber.

D. Exterior LED luminaires shall contain separate, easily accessible and replaceable Category C surge protection device.

2.3 LIGHT EMITTING DIODE (LED) LUMINAIRE SYSTEMS

A. Light emitting diodes used in interior applications shall have a minimum color rendering index (CRI) of 80 as indicated on drawings. Light emitting diodes used in exterior applications shall have a minimum color rendering index (CRI) of 70. Color temperature of the luminaires shall be as noted on the luminaire schedule. Provide light source color consistency by utilizing a binning tolerance with a maximum 3-step MacAdam ellipse unless noted otherwise.

B. Rated life shall be minimum of 50,000 hours at L70.

C. LED chips shall be wired so that failure of one chip does not prohibit operation of the remainder of the chip array.

D. Luminaire delivered lumens is defined as the absolute lumens per the manufacturers LM-79-08 test report.

E. LED luminaires shall be designed for ease of component replacement including modular replaceable boards or chips modules. Luminaires that are factory sealed and do not have field replaceable parts shall provide a 10-year warranty.

F. LED light engine shall have a maximum LLD of 0.85 at 50,000hours at 20°C ambient.

G. LED Driver:

1. Solid state driver with integral heat sink. Driver shall have over-heat, short-circuit and overload protection, power factor 0.98 or above and maximum total harmonic distortion <20%. Driver shall have a voltage fluctuation tolerance of +/- 10%.

2. Drivers shall have dimming capabilities as outlined in the luminaire schedule for each luminaire type. Dimming shall control light output in a continuous curve from 100% to 10% unless noted otherwise.

3. Driver shall have a minimum of 50,000 hours rated life.

4. Driver shall be tested to ANSI C82-16 for input current trough, total harmonic distortion (THD), and power factor. Driver start time shall be less than 0.5 seconds to 98% of initial light output. Flicker should be less than 30% throughout the operating range.

5. Driver shall be field replaceable without removal of the luminaire.

6. Class A sound rating; inaudible in a 27 dBA ambient.

7. Demonstrate no visible change in light output with a variation of plus or minus 10 percent change in the voltage input.

2.4 LED EMERGENCY LIGHTING UNITS

A. Self-Powered Emergency Lighting Units: One-piece, self-contained unit with sealed, maintenance-free nickel cadmium battery, automatic charger and electronic circuitry. Relay automatically energizes lamp from battery when circuit voltage drops to 80 percent of nominal voltage or below. When normal voltage is restored, relay deenergizes lamps from battery, and battery is automatically recharged and floated on charger.

B. Battery: Maintenance free lead calcium type, with 90 minute capacity to supply the connected lamp load.

C. Charger: Dual-rate solid state charger, capable of maintaining the battery in a full-charge state during normal conditions, and capable of recharging discharged battery to full charged within 168 hours. Low voltage disconnect to prevent deep discharge of battery.

D. Indicators: Provide lamps to indicate AC ON and RECHARGING.

E. Provide test switch to transfer unit from normal supply to battery supply.

F. Self-Diagnostics and Testing:

1. Unit shall be self-diagnostic with continuous monitoring of charger performance and battery voltage. Any malfunction of battery, charger, transfer circuit, or emergency lamps shall be detected and visually indicated.

2. Unit shall be programmed to exercise the battery and test emergency operation by performing a five-minute discharge/diagnostic cycle every six months. A manual test switch shall allow a five-minute discharge/diagnostic test at any time.

2.5 EMERGENCY EXIT SIGNS

A. Exit Signs: Stencil face, slash high letters, directional arrows as indicated, universal mounting type as indicated on the drawings.

B. Self-Powered Exit Signs: Stencil face, slash high letters, directional arrows as indicated, universal mounting type as indicated on the drawings. One-piece, self-contained unit with sealed, maintenance-free nickel cadmium battery, test switch, AC ON pilot light, automatic charger, and electronic circuitry. Power failure relay automatically energizes lamp from battery when circuit voltage drops to 80 percent of nominal voltage or below. When normal voltage is restored, relay deenergizes lamps from battery, and battery is automatically recharged and floated on charger.

C. Directional Indicators: The directional indicator for exit signage shall be of a chevron type meeting all requirements of NFPA 101.

D. Self-Diagnostics and Testing:

1. Unit shall be self-diagnostic with continuous monitoring of charger performance and battery voltage. Any malfunction of battery, charger, transfer circuit, or emergency lamps shall be detected and visually indicated.

2. Unit shall be programmed to exercise the battery and test emergency operation by performing a five-minute discharge/diagnostic cycle every six months. A manual test switch shall allow a five-minute discharge/diagnostic test at any time.

2.6 EMERGENCY INVERTER FOR LED LIGHT ENGINES (INDIVIDUAL LUMINAIRES - INTEGRAL)

A. Unit: Self-contained, with automatic transfer to battery supply on loss of normal power, UL 924 listed for factory or field installation, indoor and damp locations, 38° to 122°F (0°C to 50°C) operating temperature. Compatible with switches, dimmed, and unswitched lighting controls. Compatible with LED light engines. The inverter output shall be situated with solid-state low voltage disconnect circuit.

B. Battery: Sealed, high temperature, maintenance free, nickel cadmium battery with capacity to provide 90 minutes of emergency operation at full lumen and wattage output, with 24-hour recharge time. Refer to luminaire schedule for lumen and wattage requirements.

C. Features: Integral battery charger with LED charging indicator light, test switch, electronic circuitry for use with LED drivers. Test and monitor switch shall be integral to luminaire.

D. Factory and Field Installation: Listed for installation inside and adjacent to luminaire. Refer to Luminaire Schedule for individual luminaire requirements. Remote-mount units shall be located above finished ceiling, adjacent to luminaire, and accessible from below through luminaire opening.

E. Self-Test Diagnostics and Testing: Provide with listed automatic monthly self-test diagnostics.