



Mobile Home Permit Worksheet


Installer: Joseph Ash License # 1H/1153945
Address of home _____
being installed _____

Manufacturer Live Oak Length x width 16x60

NOTE: If home is a single wide fill out one half of the blocking plan
If home is a triple or quad wide sketch in remainder of home
I understand Lateral Arm Systems cannot be used on any home (new or used)
where the sidewall ties exceed 5 ft 4 in.

Installer's initials JA

Typical pier spacing

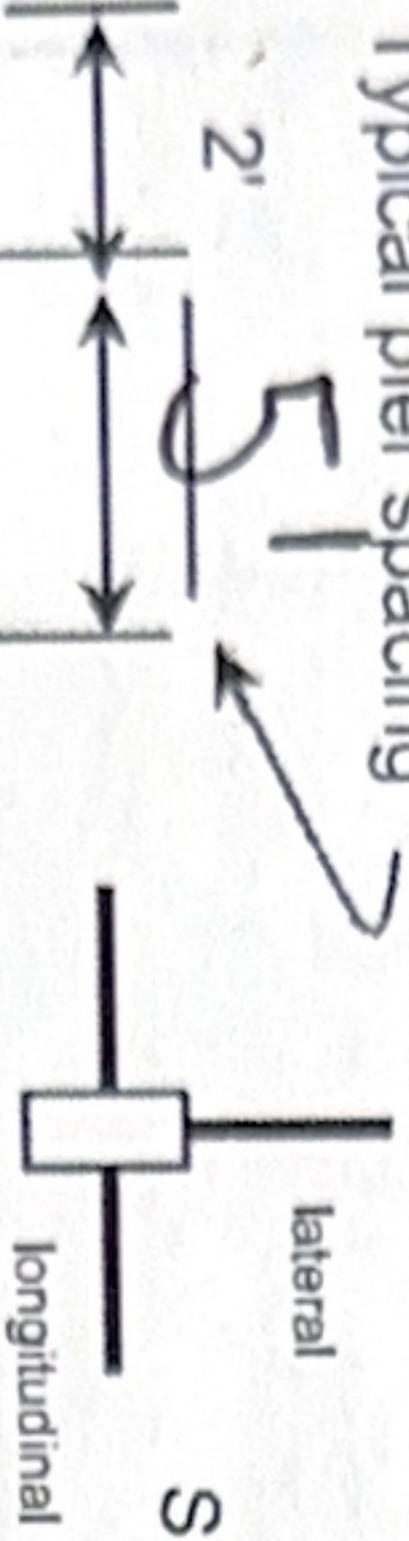

Show locations of Longitudinal and Lateral Systems
(use dark lines to show these locations)

marriage wall piers within 2' of end of home per Rule 15C

Permit Number: _____ Date: _____

New Home ☒ Used Home ☐

Home installed to the Manufacturer's Installation Manual
Home is installed in accordance with Rule 15-C

Single wide ☒ Wind Zone II ☐ Wind Zone III ☐

Double wide ☐ Installation Decal # 131095

Triple/Quad ☐ Serial # _____

PIER SPACING TABLE FOR USED HOMES

Load bearing capacity (sq in)	16" x 16" (256)	18 1/2" x 18 (342)	20" x 20" (400)	22" x 22" (484)*	24" x 24" (576)*	26" x 26" (676)
1000 psf	3'	4'	5'	6'	7'	8'
1500 psf	4'6"	6'	7'	8'	8'	8'
2000 psf	6'	8'	8'	8'	8'	8'
2500 psf	7'6"	8'	8'	8'	8'	8'
3000 psf	8'	8'	8'	8'	8'	8'
3500 psf	8'	8'	8'	8'	8'	8'

*Interpolated from Rule 15C-1 pier spacing table.

PIER PAD SIZES

I-beam pier pad size

15x25

Perimeter pier pad size

16x16

Other pier pad sizes
(required by the mfg.)

Draw the approximate locations of marriage wall openings 4 foot or greater. Use this symbol to show the piers.

List all marriage wall openings greater than 4 foot and their pier pad sizes below.

Opening _____ Pier pad size _____

4 ft _____ 5 ft _____

ANCHORS

FRAME TIES

within 2' of end of home -
spaced at 5' 4" oc

OTHER TIES

TIEDOWN COMPONENTS

Longitudinal Stabilizing Device (LSD)

Manufacturer _____

Longitudinal Stabilizing Device w/ Lateral Arms

Manufacturer Oliver Tech

Sidewall

Longitudinal

Marriage Wall

Shear Wall

Number

28

8

8



Mobile Home Permit Worksheet

POCKET PENETROMETER TEST

The pocket penetrometer tests are rounded down to _____ psf or check here to declare 1000 lb. soil ☒ without testing.

X _____ X _____ X _____

POCKET PENETROMETER TESTING METHOD

1. Test the perimeter of the home at 6 locations.
2. Take the reading at the depth of the footer.
3. Using 500 lb. increments, take the lowest reading and round down to that increment.

X _____ X _____ X _____

TORQUE PROBE TEST

The results of the torque probe test is 245 inch pounds or check here if you are declaring 5' anchors without testing _____. A test showing 275 inch pounds or less will require 5' anchors.

Note: A state approved lateral arm system is being used and 4 ft. anchors are allowed at the sidewall locations. 1 understand 5' anchors are required at all centerline tie points where the torque test reading is 275 or less and where the mobile home manufacturer may require anchors with 4000 lb. holding capacity.

Installer's initials JA

ALL TESTS MUST BE PERFORMED BY A LICENSED INSTALLER

Installer Name Joseph Ash

Date Tested 8/24/26

ELECTRICAL

Connect electrical conductors between multi-wide units, but not to the main power source. This includes the bonding wire between multi-wide units. Pg. _____

PLUMBING

Connect all sewer drains to an existing sewer tap or septic tank. Pg. _____

Connect all potable water supply piping to an existing water meter, water tap, or other independent water supply systems. Pg. _____

Permit Number: _____ Date: _____

Site Preparation

Debris and organic material removed ☒ Swale ☒ Pad ☒ Other _____

Water drainage: Natural _____

Fastening multi wide units

Floor- Type Fastener: _____ Length: _____ Spacing: N/A
Walls- Type Fastener: _____ Length: _____ Spacing: _____
Roof- Type Fastener: _____ Length: _____ Spacing: _____

For used homes a min. 30 gauge, 8" wide, galvanized metal strip will be centered over the peak of the roof and fastened with galv. roofing nails at 2' on center on both sides of the centerline.

Gasket (weatherproofing requirement)

I understand a properly installed gasket is a requirement of all new and used homes and that condensation, mold, mildew and buckled marriage walls are a result of a poorly installed or no gasket being installed. I understand a strip of tape will not serve as a gasket.

Installer's initials JA

Type gasket _____ Pg. _____

Installed: Between Floors _____ Yes JA
Between Walls _____ Yes _____
Bottom of ridge beam _____ Yes _____

Weatherproofing

The bottom board will be repaired and/or taped. _____ Yes JA Pg. _____
Siding on units is installed to manufacturer's specifications. _____ Yes JA
Fireplace chimney installed so as not to allow intrusion of rain water. _____ Yes _____


Miscellaneous

Skirting to be installed. _____ Yes JA No _____ N/A
Dryer vent installed outside of skirting. _____ Yes JA No _____ N/A
Range downflow vent installed outside of skirting. _____ Yes JA No _____ N/A
Drain lines supported at 4' intervals. _____ Yes JA No _____ N/A
Electrical crossovers protected. _____ Yes JA No _____ N/A
Other: _____

Installer verifies all information given with this permit worksheet is accurate and true based on the manufacturer's installation instructions and or Rule 15C-1 & 2

Installer's Signature JA

Date 8/24/26

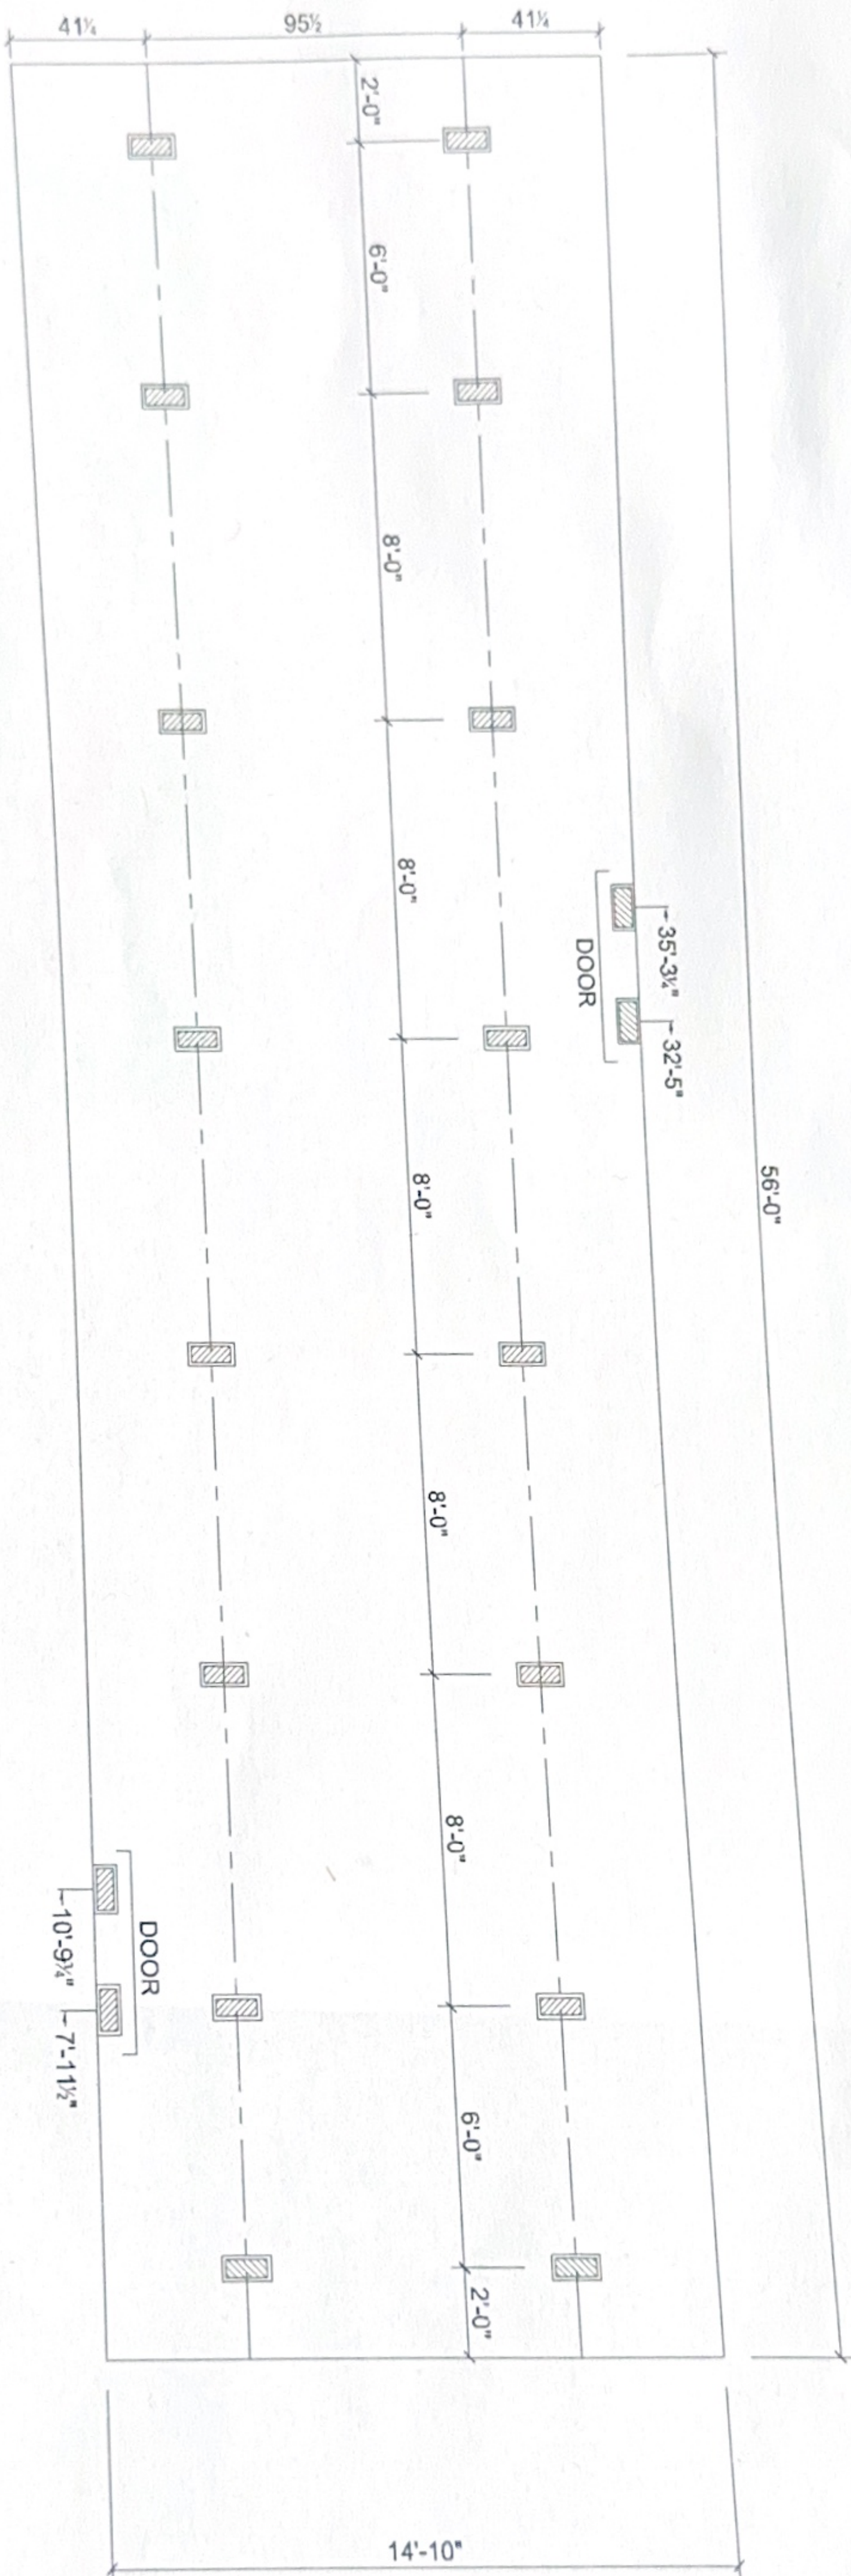

- ☒ MARRIAGE LINE OPENING SUPPORT PIER/TYP.
- ▨ SUPPORT PIER/TYP

FOUNDATION NOTES:

- THIS DRAWING IS DESIGNED FOR THE STANDARD WIND ZONE AND IS TO BE USED IN CONJUNCTION WITH THE INSTALLATION MANUAL AND ITS SUPPLEMENTS.
- FOOTINGS ARE SHOWN FOR EXAMPLE ONLY QUANTITY AND SPACING MAY VARY BASED ON PAD TYPE, SOIL CONDITION, ETC.
- FOOTINGS ARE REQUIRED AT SUPPORT POSTS, SEE INSTALLATION MANUAL FOR REQUIREMENTS.

Live Oak Homes
MODEL: S-5562B - 16 X 60
2-BEDROOM / 2-BATH

- | | |
|------------------------------|---|
| (A) MAIN ELECTRICAL | (G) DUCT CROSSOVER |
| (B) ELECTRICAL CROSSOVER | (H) SEWER DROPS |
| (C) WATER INLET | (I) RETURN AIR (W/OPT. HEAT PUMP OH DUCT) |
| (D) WATER CROSSOVER (IF ANY) | (J) SUPPLY AIR (W/OPT. HEAT PUMP OH DUCT) |
| (E) GAS INLET (IF ANY) | |
| (F) GAS CROSSOVER (IF ANY) | |

11/29/07

S-5562B

License Number: IH / 1153945 / 1 Name: JOSEPH ASH

Order #: 7081	Label #: 131095	Manufacturer:	(Check Size of Home)
Homeowner: Josh Anderson	Year Model:	Length & Width:	Single _____ Double _____ Triple _____
Address:	Type Longitudinal System:	HUD Label #:	
City/State/Zip: Lake City, FL	Type Lateral Arm System:	Soil Bearing / PSF:	
Phone #:	New Home: _____ Used Home: _____	Torque Probe / in.-lbs:	
Date Installed:	Data Plate Wind Zone:	Permit #:	
Installed Wind Zone:			
Note:			

STATE OF FLORIDA
INSTALLATION CERTIFICATION LABEL

131095

LABEL #

DATE OF INSTALLATION

JOSEPH ASH

NAME

IH / 1153945 / 1

7081

ORDER #

LICENSE #
CERTIFIES THAT THE INSTALLATION OF THIS MOBILE HOME IS
IN ACCORDANCE WITH FLORIDA STATUTES 320.8249, 320.8325
AND RULES OF THE HIGHWAY SAFETY AND MOTOR VEHICLES.

INSTRUCTIONS

PLEASE WRITE DATE OF
INSTALLATION AND AFFIX
LABEL NEXT TO HUD LABEL.
USE PERMANENT INK PEN
OR MARKER ONLY.
COMPLETE INFORMATION
ABOVE AND KEEP ON FILE
FOR A MINIMUM OF 2
YEARS. YOU ARE REQUIRED
TO PROVIDE COPIES WHEN
REQUESTED.