



Mobile Home Permit Worksheet

Installer: Jacob Trowell License # IH/1148380



Address of home being installed TBD NW Lake Jeffery Rd.
Lake City, FL 3024

Manufacturer Destiny Homes Length x width 56x28


NOTE: If home is a single wide fill out one half of the blocking plan
If home is a triple or quad wide sketch in remainder of home
I understand Lateral Arm Systems cannot be used on any home (new or used)
where the sidewall ties exceed 5 ft 4 in.

Installer's initials JT

Typical pier spacing

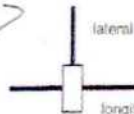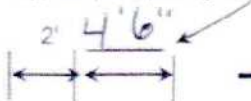

Show locations of Longitudinal and Lateral Systems
(use dark lines to show these locations)

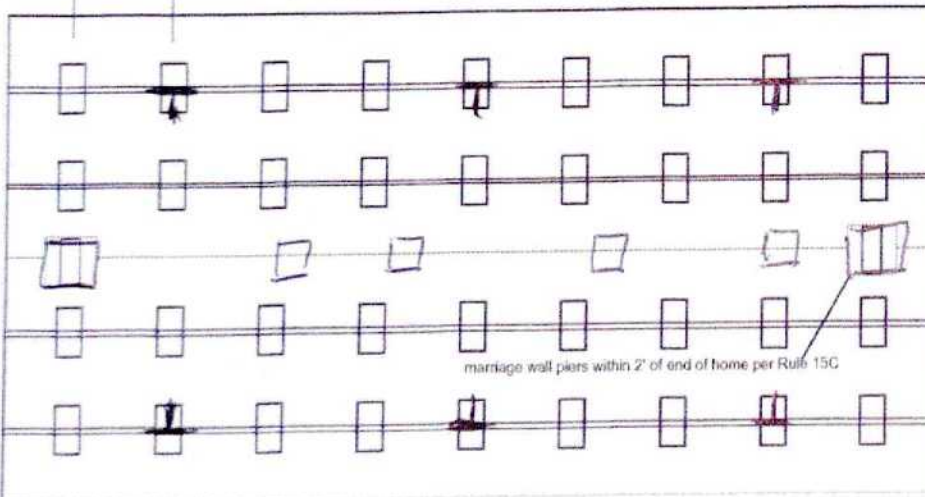

Permit Number: _____ Date: _____

New Home ☒ Used Home ☐

Home installed to the Manufacturer's Installation Manual ☒
Home is installed in accordance with Rule 15-C ☐

Single wide ☐ Wind Zone II ☒ Wind Zone III ☐

Double wide ☒ Installation Decal # 130320

Triple/Quad ☐ Serial # _____

PIER SPACING TABLE FOR USED HOMES

Load bearing capacity	Footer size (sq in)	16' x 16' (256)	18 1/2' x 18 1/2' (342)	20' x 20' (400)	22' x 22' (484)*	24' x 24' (576)*	26' x 26' (676)
1000 psf		3'	4'	5'	6'	7'	8'
1500 psf		4'6"	6'	7'	8'	9'	10'
2000 psf		6'	8'	9'	10'	11'	12'
2500 psf		7'6"	10'	11'	12'	13'	14'
3000 psf		9'	12'	13'	14'	15'	16'
3500 psf		10'	14'	15'	16'	17'	18'

*interpolated from Rule 15C-1 pier spacing table.

PIER PAD SIZES

I-beam pier pad size 17x25

Perimeter pier pad size 16x16

Other pier pad sizes (required by the mfg.) _____

Draw the approximate locations of marriage wall openings 4 foot or greater. Use this symbol to show the piers.

List all marriage wall openings greater than 4 foot and their pier pad sizes below.

Opening _____ Pier pad size _____

TIEDOWN COMPONENTS
Longitudinal Stabilizing Device (LSD)
Manufacturer _____
Longitudinal Stabilizing Device w/ Lateral Arms
Manufacturer O.T.F (6)

POPULAR PAD SIZES

Pad Size	Sq In
16 x 16	256
16 x 18	288
18.5 x 18.5	342
16 x 22.5	360
17 x 22	374
13 1/4 x 26 1/4	348
20 x 20	400
17 3/16 x 25 3/16	441
17 1/4 x 25 1/4	446
24 x 24	576
26 x 26	676

4 ft ☒ 5 ft _____

ANCHORS

FRAME TIES

within 2' of end of home
spaced at 5' 4" oc _____

OTHER TIES

Number
Sidewall TBD
Longitudinal N/A
Marriage Wall TBD
Shear Wall TBD



Mobile Home Permit Worksheet

POCKET PENETROMETER TEST

The pocket penetrometer tests are rounded down to _____ psf or check here to declare 1000 lb. soil ☒ without testing.

X _____ X _____ X _____

POCKET PENETROMETER TESTING METHOD

1. Test the perimeter of the home at 6 locations.
2. Take the reading at the depth of the footer.
3. Using 500 lb. increments, take the lowest reading and round down to that increment.

X _____ X _____ X _____

TORQUE PROBE TEST

The results of the torque probe test is 285 inch pounds or check here if you are declaring 5' anchors without testing _____. A test showing 275 inch pounds or less will require 5' anchors.

Note: A state approved lateral arm system is being used and 4 ft. anchors are allowed at the sidewall locations. I understand 5' anchors are required at all centerline tie points where the torque test reading is 275 or less and where the mobile home manufacturer may require anchors with 4000 lb. holding capacity.

Installer's initials JS

ALL TESTS MUST BE PERFORMED BY A LICENSED INSTALLER

Installer Name Jacob Trowell

Date Tested 7-10-26

ELECTRICAL

Connect electrical conductors between multi-wide units, but not to the main power source. This includes the bonding wire between multi-wide units. Pg. 7.0

PLUMBING

Connect all sewer drains to an existing sewer tap or septic tank. Pg. 7.3

Connect all potable water supply piping to an existing water meter, water tap, or other independent water supply systems. Pg. 7.1

Permit Number: _____

Date: _____

Site Preparation

Debris and organic material removed _____

Water drainage: Natural _____ Swale _____ Pad ☒ Other _____

Fastening multi wide units

Floor- Type Fastener: Log Length: 6" Spacing: 18"

Walls- Type Fastener: Screw Length: 4" Spacing: 18"

Roof- Type Fastener: Strip Length: 10" Spacing: 32"

For used homes a min. 30 gauge, 8" wide, galvanized metal strip will be centered over the peak of the roof and fastened with galv. roofing nails at 2" on center on both sides of the centerline.

Gasket (weatherproofing requirement)

I understand a properly installed gasket is a requirement of all new and used homes and that condensation, mold, mildew and buckled marriage walls are a result of a poorly installed or no gasket being installed. I understand a strip of tape will not serve as a gasket.

Installer's initials JS

Type gasket: Form

Pg. 4.3

Installed:

Between Floors: Yes ☒ No _____

Between Walls: Yes ☒ No _____

Bottom of ridge beam: Yes ☒ No _____

Weatherproofing

The bottom board will be repaired and/or taped. Yes _____ Pg. 4.9

Siding on units is installed to manufacturer's specifications. Yes ☒ No _____

Fireplace chimney installed so as not to allow intrusion of rain water. Yes ☒ No _____

Miscellaneous

Skirting to be installed. Yes ☒ No _____ N/A _____

Dryer vent installed outside of skirting. Yes _____ No _____ N/A ☒

Range downflow vent installed outside of skirting. Yes _____ No _____ N/A ☒

Drain lines supported at 4' intervals. Yes ☒ No _____ N/A _____

Electrical crossovers protected. Yes ☒ No _____ N/A _____

Other: _____

Installer verifies all information given with this permit worksheet is accurate and true based on the manufacturer's installation instructions and or Rule 15C-1 & 2

Installer's Signature Jacob Trowell

Date 7-10-26

License Number: IH / 1148380 / 1 Name: JACOB T. TROWELL

Order #: 7052	Label #: 130320	Manufacturer:	(Check Size of Home)
Homeowner: <i>Bedenbaugh</i>		Year Model:	Single _____
Address:		Length & Width:	Double _____
			Triple _____
City/State/Zip:		Type Longitudinal System:	HUD Label #:
Phone #:		Type Lateral Arm System:	Soil Bearing / PSF:
Date Installed:		New Home: _____ Used Home: _____	Torque Probe / in-lbs:
Installed Wind Zone:		Data Plate Wind Zone:	Permit #:

Note:

STATE OF FLORIDA
INSTALLATION CERTIFICATION LABEL

130320

LABEL #

DATE OF INSTALLATION

JACOB T. TROWELL

NAME

IH / 1148380 / 1

7052

LICENSE #

ORDER #


CERTIFIES THAT THE INSTALLATION OF THIS MOBILE HOME IS
IN ACCORDANCE WITH FLORIDA STATUTES 320.8249, 320.8325
AND RULES OF THE HIGHWAY SAFETY AND MOTOR VEHICLES.

INSTRUCTIONS

PLEASE WRITE DATE OF
INSTALLATION AND AFFIX
LABEL NEXT TO HUD LABEL.
USE PERMANENT INK PEN
OR MARKER ONLY.
COMPLETE INFORMATION
ABOVE AND KEEP ON FILE
FOR A MINIMUM OF 2
YEARS. YOU ARE REQUIRED
TO PROVIDE COPIES WHEN
REQUESTED.

Zachary Bedenbaugh
eSigned 05/19/26 12:23:46 EDT

Lindsey Thomas
eSigned 05/19/26 12:23:53 EDT

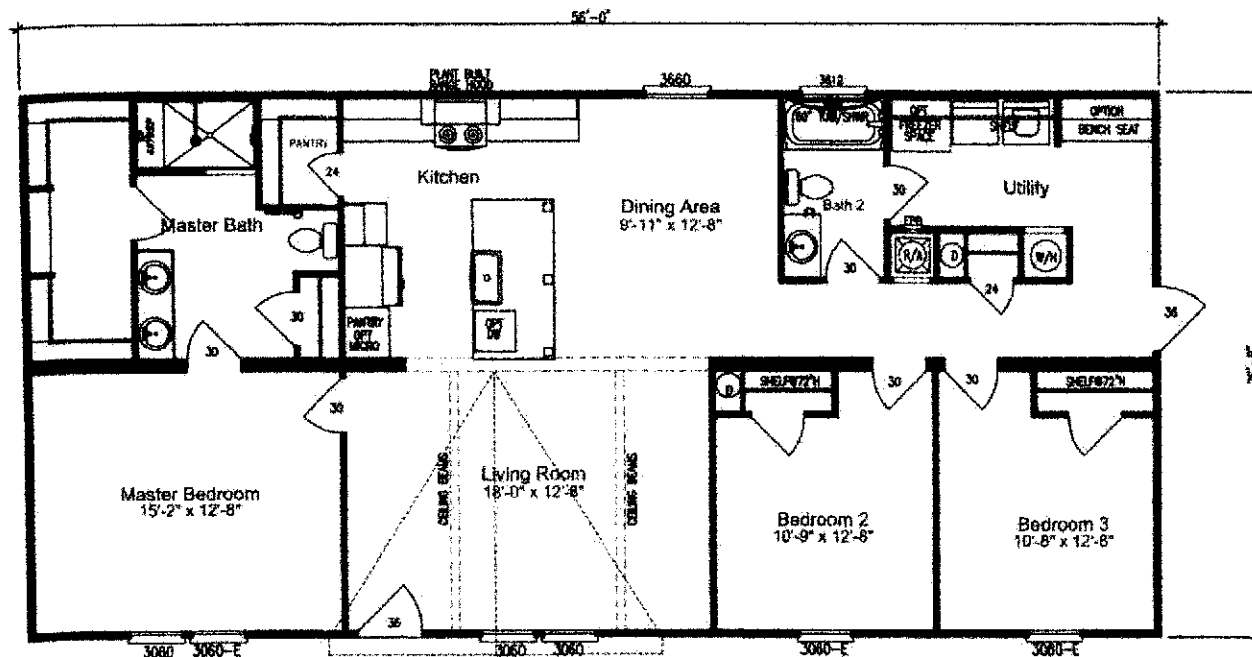

MODEL: 290LY28563A 3 BR. ~ 2 BA.
28'-0" X 56'-0" ~ 1493 SQ. FT.



REVISIONS

DRAWING TITLE	SALES PLAN	
DRAWING FILE INFORMATION	28X56 3BR-2BA	DRAWN BY: RYAN GOLDEN

PRODUCT	LIFESTYLE	SERIAL NO.	DES290GA23-13289AB
DATE	10/05/2023	MODEL NO.	290LY28563A
SHEET	1-A1	SQ. FT.	1493.33 SQ. FT.