

SOFTPIAN

ASMANIS

© WM DESIGN &
A550CIATES, NC.
426 SW COMMERCE DR. STE 130
LAKE CITY, FL 32025
(386) 758-8406
will@willmyers.net



JOB NUMBER 20250122

SHEET NUMBER

© WM DESIGN & A550CIATE.5, NC. 426 SW COMMERCE DR. STE 13 LAKE CITY, FL 32025 (386) 758-8406 will@willmyers.net



JOB NUMBER 20250122

> SHEET NUMBER A.2

1,826 S.F.

386 S.F.

88 S.F.

40 S.F.

2,340 S.F.

AREA SUMMARY


LIVING AREA

**GARAGE AREA** 

TOTAL AREA

COVERED PORCH AREA

**ENTRY PORCH AREA** 

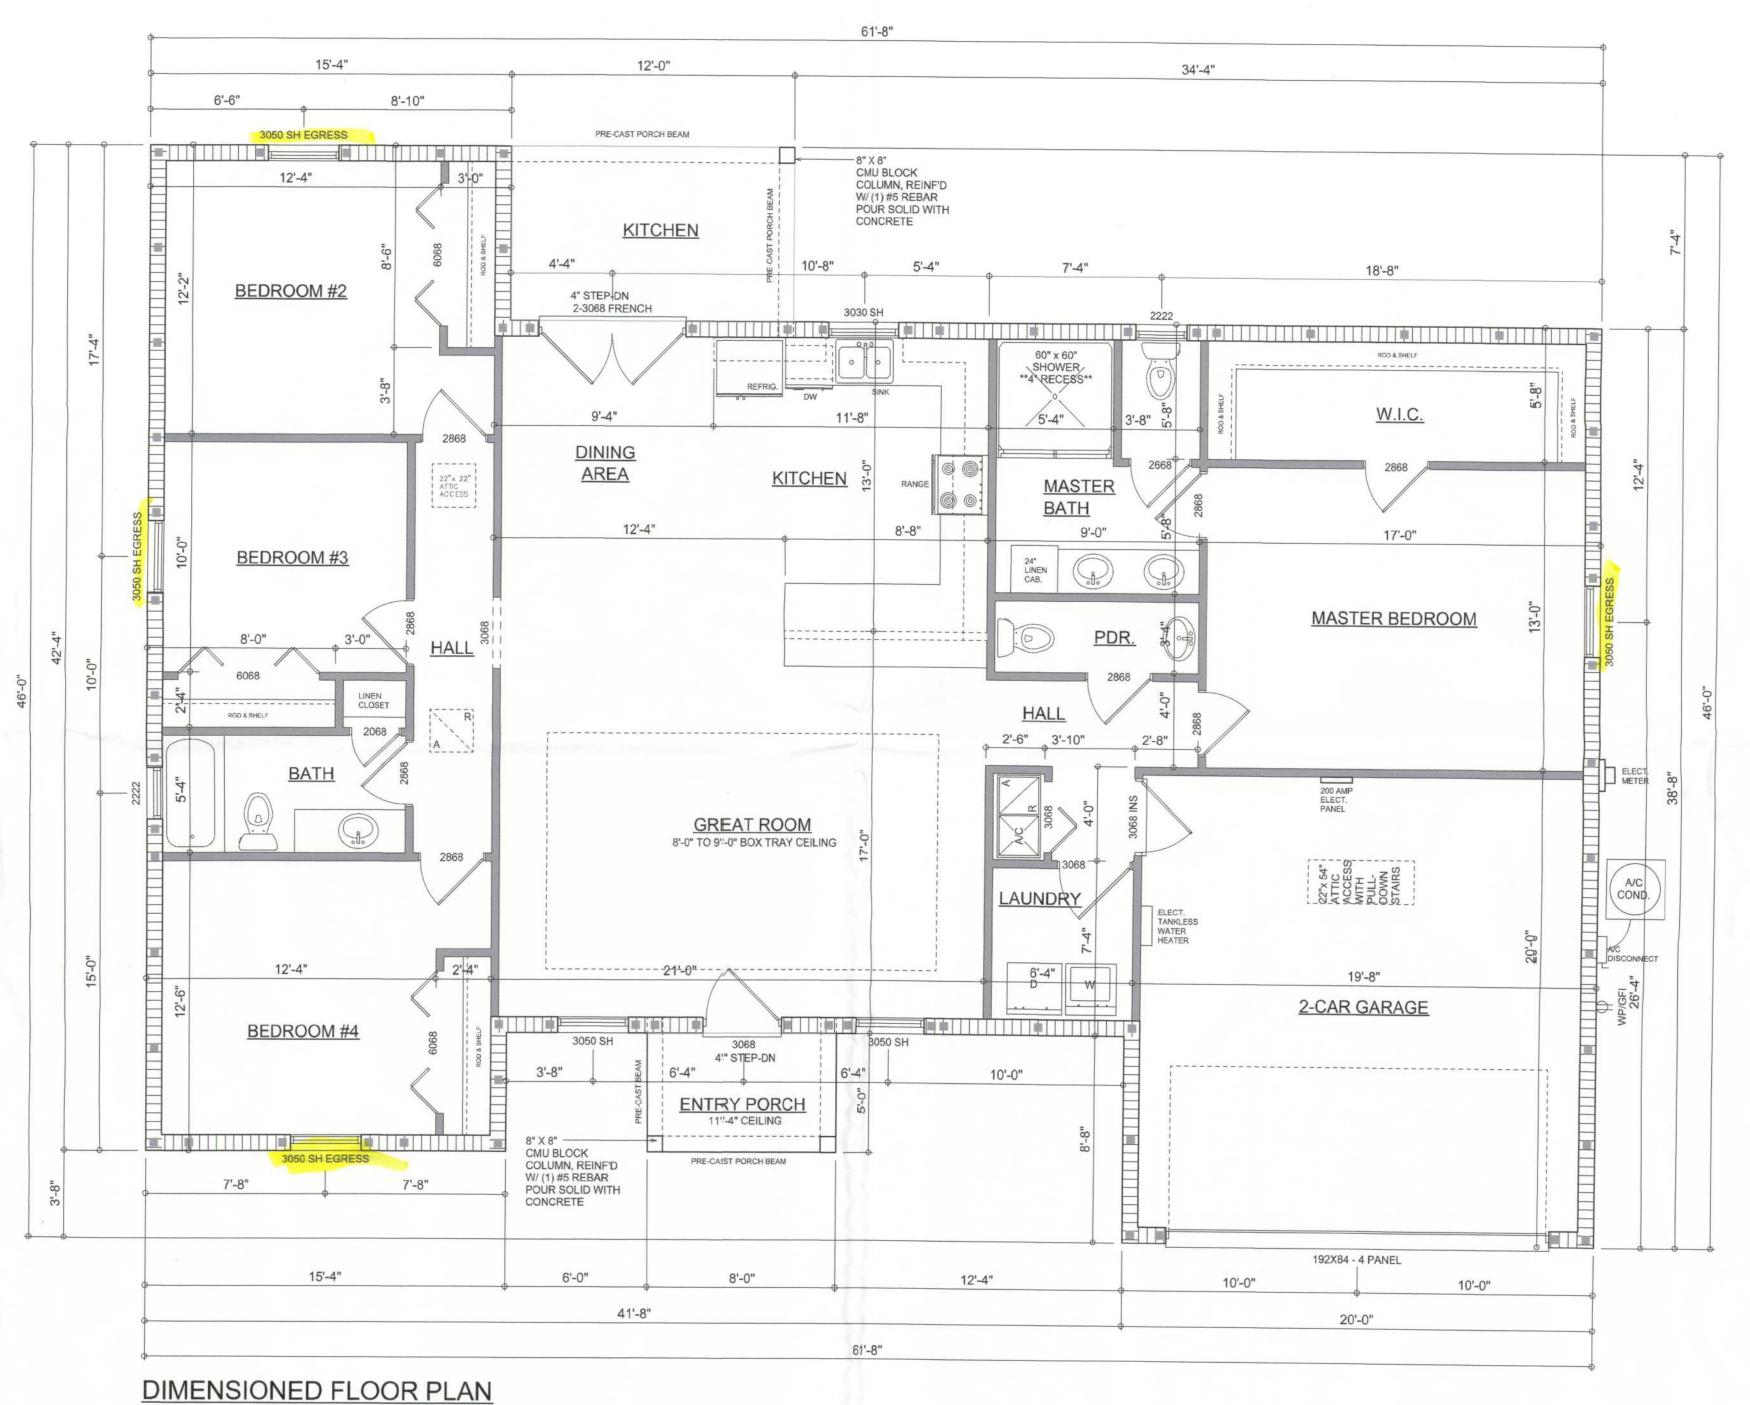

NOTE: ALL WALLS SHALL BE 8'-0" UNLESS OTHERWISE NOTED.

## Garage fire separations shall comply with the following:

- 1. The private garage shall be separated from the dwelling unit and its attic area by means of a minimum ½-inch (12.7 mm) gypsum board applied to the garage side. Garages beneath habitable rooms shall be separated from all habitable rooms above by not less than 5/8-inch Type X gypsum board or equivalent. Door openings between a private garage and the dwelling unit shall be equipped with either solid wood doors, or solid or honeycomb core steel doors not less than 1/3/8 inches (34.9 mm) thick, or doors in compliance with Section 715.3.3. Openings from a private garage directly into a room used for sleeping purposes shall not be permitted.
  - Ducts in a private garage and ducts penetrating the walls or ceilings separating the dwelling unit from the garage shall be constructed of a minimum 0.019-inch (0.48 mm) sheet steel and shall have no openings into the garage.
  - A separation is not required between a Group R-3 and U carport provided the carport is entirely open on two or more sides and there are not enclosed areas above.
  - 4. When installing an attic access and/or pull-down stair unit in the garage, devise shall have a minimum 20 min. fire rating.

	ELECTRICAL LEGEND
	CEILING FAN (PRE-WIRE FOR LIGHT KIT)
QD	DOUBLE SECURITY LIGHT
0	RECESSED CAN LIGHT
⊕	BATH EXHAUST FAN
- <b></b>	LIGHT FIXTURE
Ф	DUPLEX OUTLET (AFCI & TAMPER RESISTANT)
•	220v OUTLET
Фан	GFI DUPLEX OUTLET (PER NEC 406.8)
TV +	TELEVISION JACK
(N)	ETHERNET JACK
	CIRCUIT FOR MINI-SPLIT A/C UNIT
•	SMOKE / CARBON MONOXIDE DETECTOR (see note below)
\$	WALL SWITCH
\$3	3 WAY WALL SWITCH
₩P/GFI	WATER PROOF GFI OUTLET
48" FLOUR.	2 OR 4 TUB FLUORESCENT FIXTURE


ALL INTERIOR RECEPTACLES SHALL BE AFCI (ARC FAULT CIRCUIT INTERRUPT) PER NEC 210.12 & TAMPER RESISTANT PER

ALL INTERIOR & EXTERIOR LIGHTING SHALL MEET OR EXCEED THE MIN. 75% HIGH-EFFICIENCY LIGHTING PER FBC-ENERGY CONSERVATION R404.

ALL SMOKE DETECTORS BE A COMBO SMOKE & CARBON MONOXIDE DETECTOR AND SHALL HAVE BATTERY BACKUP POWER AND ALL WIRED TOGETHER SO IF ANY ONE UNIT IS ACTUATED THEY ALL ACTIVATE.

THE ELECTRICAL SERVICE OVERCURRENT PROTECTION DEVICE SHALL BE INSTALLED ON THE EXTERIOR OF STRUCTURES TO SERVE AS A DISCONNECT MEANS. CONDUCTORS USED FROM THE EXTERIOR DISCONNECTING MEANS TO A PANEL OR SUB PANEL SHALL HAVE FOUR-WIRE CONDUCTORS, OF WHICH ONE CONDUCTOR SHALL BE USED AS AN EQUIPMENT GROUND.


IT IS THE LICENSED ELECTRICAL CONTRACTORS RESPONSIBILITY TO INSURE THAT ALL WORK PERFORMED AND EQUIPMENT INSTALLED MEETS OR EXCEEDS THE 2020 (NFPA-70) NATIONAL ELECTRIC CODE AND ALL OTHER LOCAL CODES AND ORDINANCES.

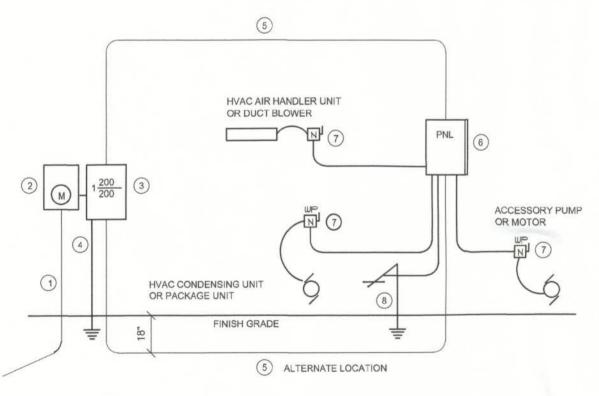

- Service/Feeder Entrance Conductors: 2" rigid conduit, min. 18" deep, w/ continuous Ground Bonding Conductor, Service/ Entrance Conductors shall not be spliced except that bolted connections at the Meter, Disconnecting Devices and Panel shall be allowed.
- 2 Meter Enclosure, weatherproof, U.L. Listed.
- 3 Main Disconnect Switch: fused or Main BRKR, weatherproof, U.L. Listed.
- Service entrance Ground: }" ~ iron/steel rod x 8'-0" long and/or concrete encased foundation steel rebar x 20'-0" long. Grounding Conductor shall be bonded to each piece of Service/ Entrance Equipment, and shall be sized per Item #5, below.
- 5) 200 AMPERE SERVICE: 3-#2/0-USE-Cu, 1-#4-Cu-GND, 2" Conduit.
- 6 House Panel (PNL), U.L. Lised, sized per schedule.
- 7 Equipment Disconnect Switch: non-fused, in weatherproof enclosure, size according to Panel Schedule loads.
- Provide Ground Bond Wire to metal piping, size in accordance with the Service Ground Conductor.

THE MINIMUM AIC RATING FOR PANEL BOARDS, BRKRS AND DISCONNECT SWITCHES SHALL BE 22,000 AIC.

ELECTRICAL RISER DIAGRAM: 200A

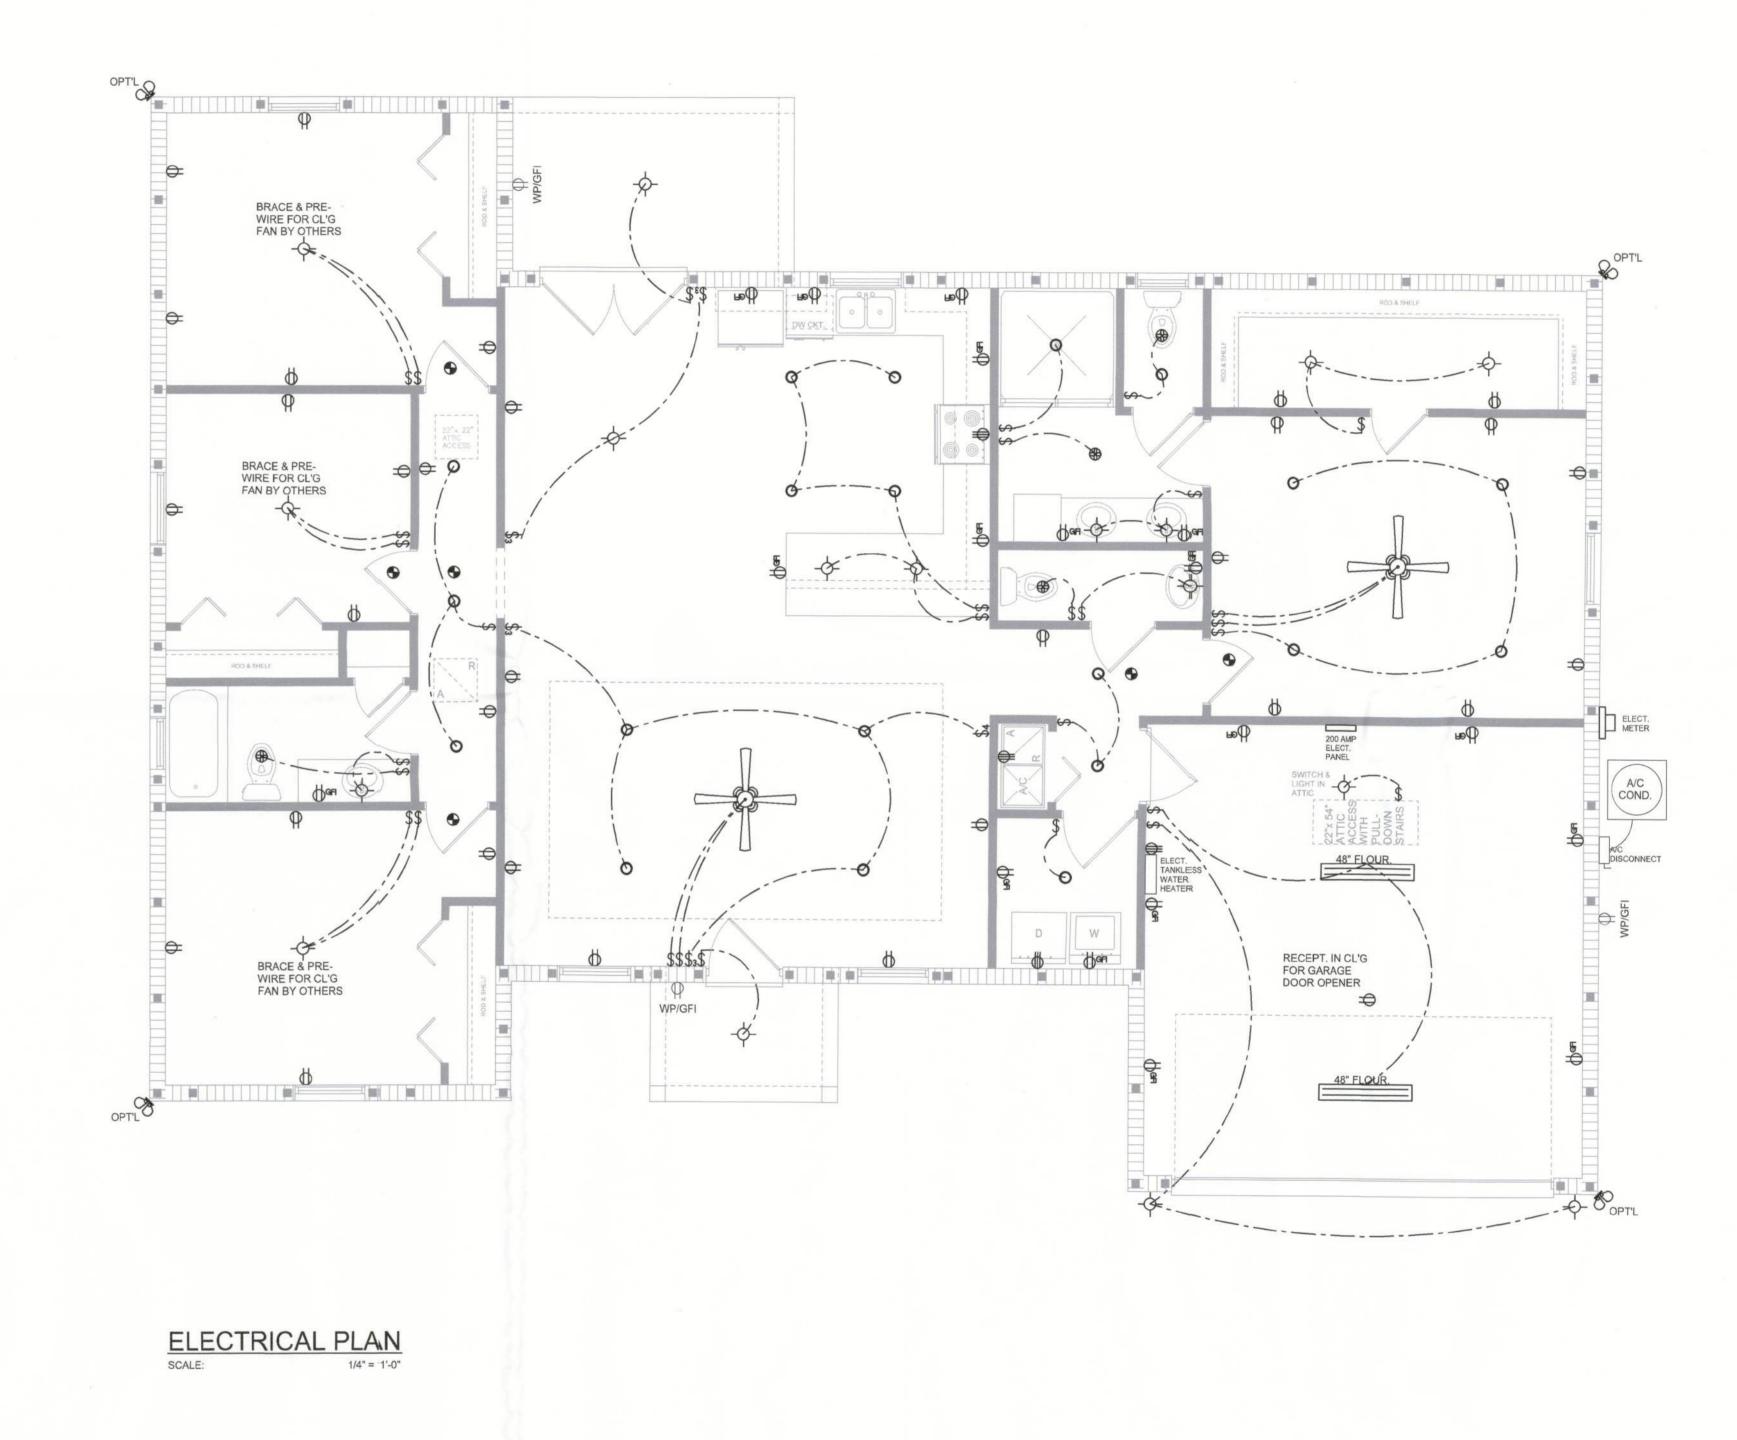

SOFTPIAN


LAKE CITY, FL 32025 (386) 758-8406 will@willmyers.net

© WM DEJGN &

ASSOCIATES, INC. 426 SW COMMERCE DR. STE 13

JOB NUMBER 20250122

SHEET NUMBER

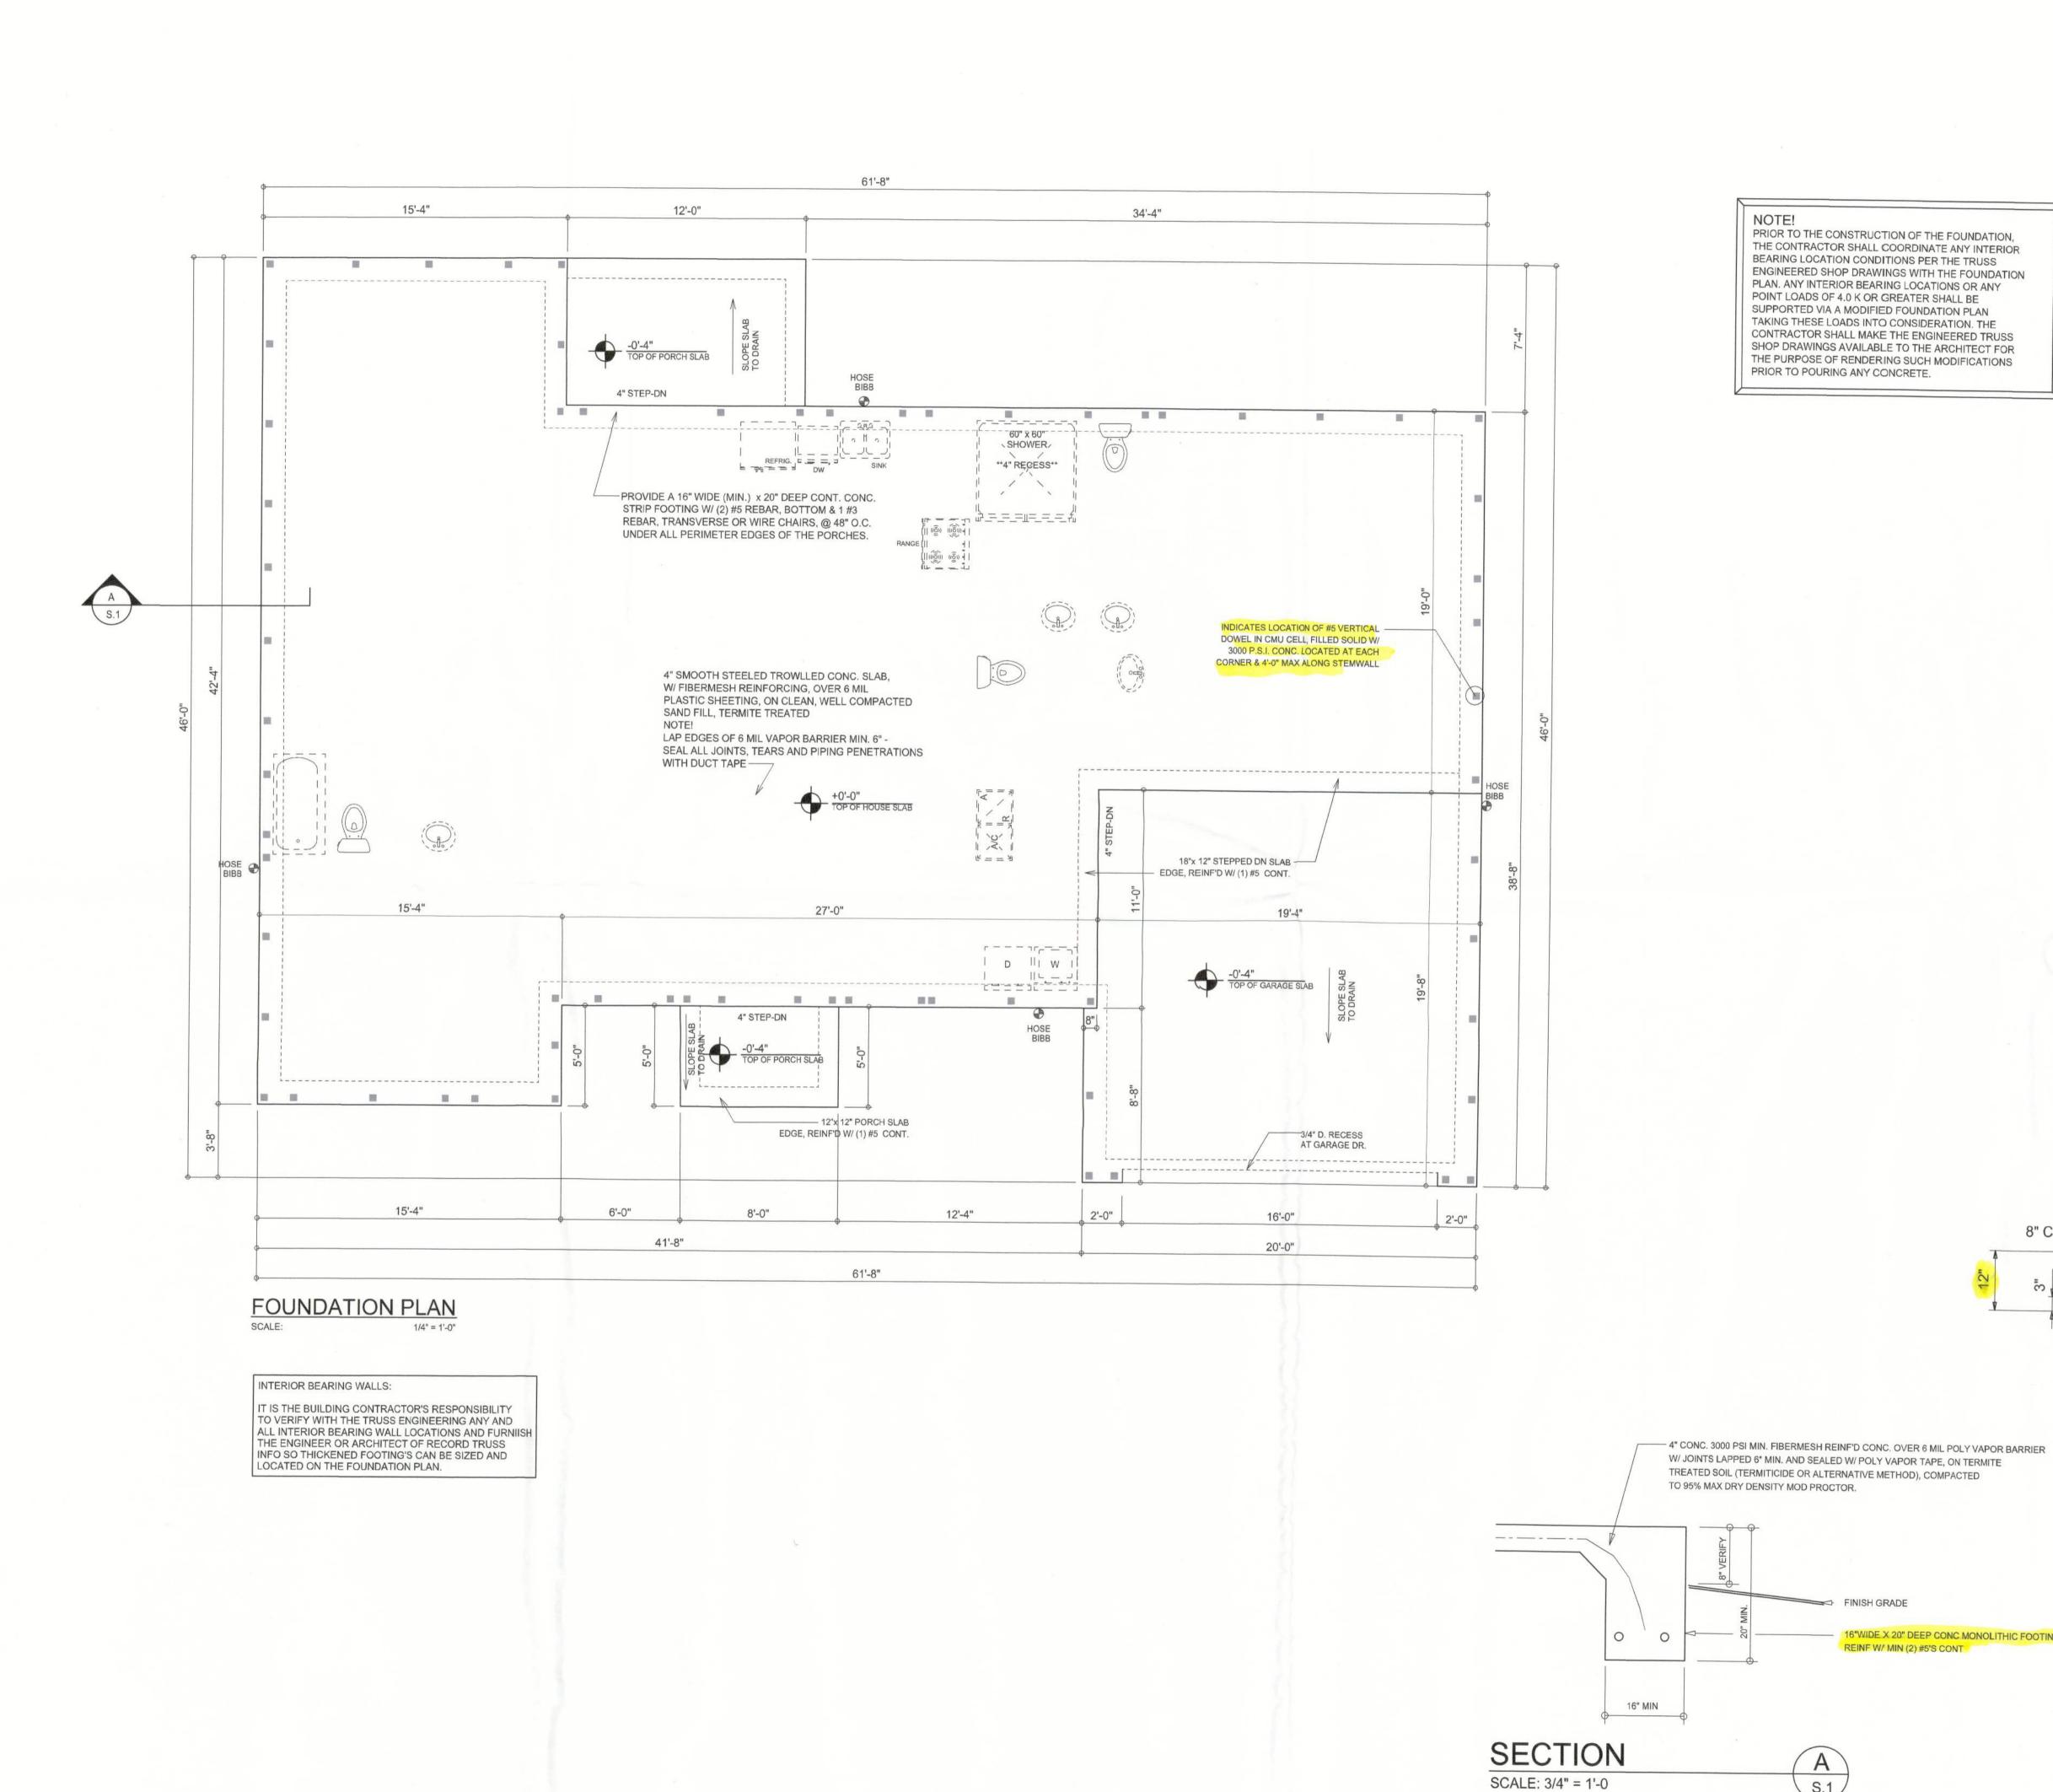

NOTE: ALL DRAWINGS NOT TO BE SCALED, WRITTEIN DIMENSIONS TAKE PRECEDENCE OVER SCALED DIMENSIONS

# CONCRETE / MASONRY / METALS GENERAL NOTES:

- DESIGN SOIL BEARING PRESSURE: 1000 PSF.
- 2. EXPANSIVE SOILS: WHERE DIRECTED BY THE SOILS ENGINEER, SOIL AUGMENTATION PER THE SOILS ENGINEER'S SPECIFICATIONS SHALL BE IMPLEMENTED PRIOR TO PLACING ANY FOUNDATIONS - TESTS AS SPECIFIED SHALL BE PREFORMED TO DETERMINE THE SUITABILITY OF THE SUB-GRADE TO SUPPORT THE DESIGN LOADS.
- CLEAN SAND FILL OVER STRIPPED AND COMPACTED EXISTING GD. SHALL BE PLACED IN 12" LIFTS. BOTH SUB-SOIL AND FILL COMPAC-TION SHALL BE NOT LESS THAN 98% AS MEASURED BY A MODIFIED PROCTOR TEST AT THE RATE OF ONE TEST FOR EACH 1500 SF OF BUILDING PAD AREA, OR FRACTION THEREOF, FOR EACH 12" LIFT.
- 4. REINFORCING STEEL SHALL BE GRADE 60 AND MEET THE REQUIRE-MENTS OF ASTM A615, ALL BENDS SHALL BE MADE COLD.
- 5. WELDED WIRE MESH SLAB REINFORCING SHALL MEET THE REQUIRE-MENTS OF ASTM A185 - MIN. YEILD STRESS = 85 KSI.
- 6. CONCRETE SHALL BE STANDARD MIX F'c = 3000 PSI FOR ALL FTGS, SLABS, COLUMNS AND BEAMS OR SHALL BE STANDARD PUMP MIX F'c = 3000 PSI. STRENGTH SHALL BE ATTAINED WITHIN 28 DAYS OF PLACE-MENT. MIXING, PLACING AND FINISHING SHALL BE AS PER ACI STANDARDS.
- CONCRETE BLOCK SHALL BE AS PER MANUFACTURER'S PRODUCT GUIDE FOR ASTM C-90 REQUIREMENTS WITH MEDIUM SURFACE FINISH -F'm = 1500 PSI.
- 8. MORTAR SHALL BE TYPE "M" OR "N" FOR ALL MASONRY UNITS.
- STRUCTURAL STEEL SHALL CONFORM TO ASTM A36 STANDARDS FOR STRENGTH, BOLTS SHALL BE ASTM A307 / GRADE 1 OR A325, AS PER PLAN REQUIREMENTS.
- 10. WELDS SHALL BE AS PER "AMERICAN WELDING SOCIETY" STANDARDS FOR STRUCTURAL STEEL APPLICATIONS.
- 11. 2X4 P/T WOOD SILL, CONT., ALL AROUND, W/ 5/8"~ A.B. W/ 3" SQ. X 1/4" PLATE WASHERS WITHIN 6" FROM EACH CORNER, EA. WAY, & WITHIN 6" FROM ALL WALL OPENINGS / ENDS - 1/2"~ A.B. W/ 2" SQ. WASHERS ALONG EACH RUN @ 48" O.C., MAX. - ALL ANCHOR BOLTS SHALL HAVE A MINIMUM OF 8" EMBEDMENT INTO THE CONCRETE.

— 4" THK. 3,000 PSI CONCRETE SLAB W/ FIBERMESH CONCRETE ADDITIVE, OVER TREATED, CLEAN COMPACTED FILL −#5 ELLS X 18" X 18" @ 48" O.C. MAX. -8" CMU BOND BEAM W/#5 BAR CONT/25" MIN. LAP -#5 DOWELS @ 48" O.C. MAX. 8" CMU #3 BARS HORIZ. OR CHAIRS @ 48" O.C. —3,000 PSI CONCRETE FOOTING (2) #5 BARS CONTINUOUS

SECTION (optional)

SCALE: 3/4" = 1'-0

FINISH GRADE

S.1

REINF W/ MIN (2) #5'S CONT

16"WIDE X 20" DEEP CONC MONOLITHIC FOOTING

THE DESIGN WIND SPEED FOR THIS PROJECT IS 140 MPH PER 2023 FBC (8TH EDITION) AND LOCAL JURISDICTION REQUIREMENTS

NOTE: ADDED FILL SHALL BE APPLIED IN 8" LIFTS -EA. LIFT SHALL BE CONPACTED TO 98% DRY COMPACTION PER THE "MODIFIED PROCTOR" METHOD.

PLUMBING CONTRACTOR SHALL PREPARE "AS-BUILT" SHOP DRAWINGS INDICATING ALL PLUMBING WORK, INCLUDING ALL PLUMBING LINE LOCATIONS AND RISER DIAGRAM - CONT'R SHALL PROVIDE 1 COPY OF AS-BUILT DWGS TO OWNER AND 1 COPY TO THE PERMIT ISSUING AUTHORITY.

H.V.A.C. CONTRACTOR SHALL PREPARE "AS-BUILT" SHOP DRAWINGS INDICATING ALL H.V.A.C. WORK, INCLUDING ALL DUCTWORK LOC., SIZES, LINES, EQUIPMENT SCH. & BALANCING REPORT - CONT'R SHALL PROVIDE 1 COPY OF AS-BUILT DWGS TO OWNER & 1 COPY TO THE PERMIT ISSUING AUTHORITY.

SOFTPLAN

Z N 100

JOB NUMBER 20250122

SHEET NUMBER OF 4 SHEETS

# GENERAL TRUSS NOTES:

- TRUSSES SHALL BE DESIGNED BY A LICENSED ENGINEER, AND IN ACCORDANCE WITH THE REQUIREMENTS OF THE "NATIONAL FOREST PRODUCTS ASSOCIATION" MANUAL FOR "STRESS RATED LUMBER AND IT'S CONNECTIONS", LATEST Ed., ALONG W/ THE "TRUSS PLATE INSTITUTE" SUGGESTED GUIDELINES FOR TEMPORARY AND PERMANENT BRACING, AND HANDLING OF TRUSSES, TRUSS SHOP DRAWINGS SHALL INCLUDE TRUSS DESIGN, PLACEMENT PLANS, DETS, & TRUSS TO TRUSS CONNECTIONS.
- 2. TRUSS SHOP DRAWINGS SHALL BE SIGNED & SEALED BY THE DESIGNING ENGINEER.
- 3. FOLLOWING DEVELOPMENT OF TRUSS SHOP DRAWINGS, ADJUSTMENTS TO THE ANCHOR REQUIRMENTS MAY BE REQUIRED DEPENDING ON THE ENGINEERED GRAVITY AND WIND UPLIFT REQUIREMENTS OF TRUSSES OR GIRDERS. THE CONTRACTOR SHALL MAKE AVAILABLE A COMPLETE SET OF TRUSS SHOP DRAWINGS TO THE ARCHITECT FOR THE PURPOSE OF REVIEW OF LOADS IMPOSED ON THE BALANCE OF THE STRUCTURE, ANY SUCH REQUIRED CHANGE SHALL BE INCORPORATED INTO THE CONSTRUCTION OF THIS STRUCTURE.

(L17)

#### ROOF PLAN NOTES

R-I SEE EXTERIOR ELEVATIONS FOR ROOF PITCH

ALL OVERHANG 18" UNLESS OTHERWISE NOTED

PROVIDE ATTIC VENTILATION IN AC-CORDANCE WITH SCHEDULE ON SD.3


SEE EXTERIOR ELEVATIONS AND FLOOR PLANS TO VERIFY PLATE AND HEEL HEIGHTS

MOVE ALL VENTS AND OTHER ROOF PENETRATIONS TO REAR

SHEATH ROOF W/ 1/2" CDX PLYWOOD PLACED W/ LONG DIMENSION PERPENDICULAR TO THE ROOF TRUSSES, SECURE TO FRAMING W/ 10d RING-SHANK NAILS - AS PER DETAIL ON SHEET 5.4


THE DESIGN WIND SPEED FOR THIS PROJECT IS 130 MPH PER 2023 FBC (8TH EDITION) AND LOCAL JURISDICTION REQUIREMENTS

ATTIC	REQ'D L.F.	NET FRE
1600 SF	20 LF	410 SQ.IN
1900 SF	24 LF	490 SQ.I
2200 SF	28 LF	570 SQ.11
2500 SF	32 LF	650 SQ.I
2800 SF	36 LF	730 SQ.11
3100 SF	40 LF	820 SQ.II
3600 SF	44 LF	900 50.

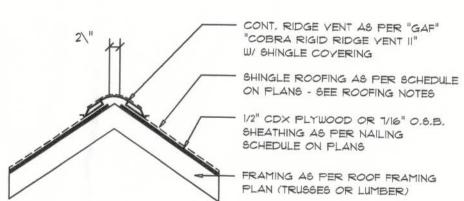

MIAMI/DADE PRODUCT APPROVAL REPORT: #98-0113.05

# Ridge Vent DETAIL

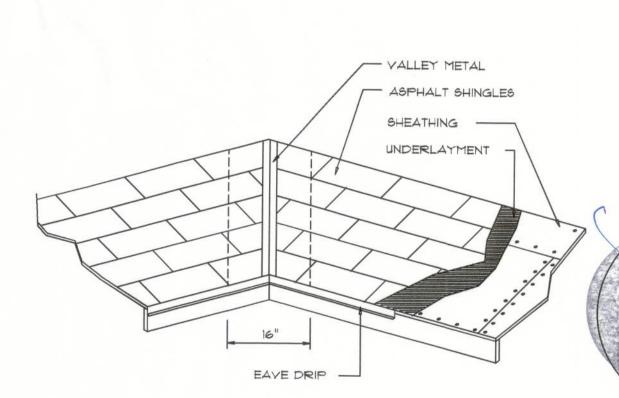

VALLEY FLASHING

# ANCHOR ALL TRUSSES WITH "SIMPSON" HETEL 16 W/ TSS

| 国際

(L13)

CMU BLOCK COLUMN, REINF'D W/#5 REBAR, POUR SOLID WITH CONCRETE.

#### 8" PRECAST W/ 2" RECESS DOOR U-LINTELS

| 22'-0" (264") PRESTRESSED | N.R. | 160 | 300 | 510 | 810 | 1250 | 1660 | 1910 | 1910 
TYPE DESIGNATION

8F16-1B/1T

8" PRECAST & PRESTRESSED U-LINTELS

2'-10" (34") PRECAST

4'-6" (54") PRECAST

5'-4" (64") PRECAST

5'-10" (10") PRECAST

6'-6" (18") PRECAST

1'-6" (90") PRECAST

9'-4" (112") PRECAST

10'-6" (126") PRECAST

11'-4" (136") PRECAST

12'-O" (144") PRECAST

13'-4" (160") PRECAST

14'-0" (168") PRECAST

LIB 14'-8" (176") PRESTRESSED

LIS 19'-4" (232") PRESTRESSED

15'-4" (184") PRESTRESSED

NOMINAL WIDTH

F . FILLED WITH GROUT / U . UNFILLED

- QUANTITY OF \*5 REBAR AT

BOTTOM OF LINTEL CAVITY

REBAR AT TOP

- \*5 REBAR AT TOP

MIN. (1) REQ'D

- #5 REBAR AT BOTTOM

- BOTTOM REINFORCING

OF LINTEL CAVITY

7-5/8"ACTUAL PROVIDED IN LINTEL

DETAIL A/3

8F8-0B 8F12-0B 8F16-0B 8F20-0B 8F24-0B 8F28-0B 8F32-0B 8F812-0B 8F

2646 4473 6039 7526 9004 10472 11936 1913 2657 3403 4149 4896 5644

 2170
 4021
 6039
 1526
 9004
 10472
 9668

 1223
 1301
 1809
 2317
 2826
 3336
 3846

 1665
 2889
 5057
 6096
 5400
 6424
 7450

 1000
 1059
 1474
 1889
 2304
 2721
 3137

 1450
 2464
 4444
 5459
 4477
 5390
 6123

 1459
 2464
 4144
 5458
 4437
 5280
 6122

 1255
 2101
 3263
 2746
 3358
 3971
 4585

 1255
 2101
 3396
 5260
 7134
 8995
 6890

 1029
 1675
 2385
 1994
 2439
 2886
 3333

 1039
 1675
 2410
 3839
 5594
 4613
 5047

 1029
 1675
 2610
 3839
 5596
 6613
 5047

 632
 1049
 1469
 1210
 1482
 1754
 2027

 768
 1212
 1818
 2544
 3469
 4030
 3127

482 802 1125 915 1122 1328 1535

381 648 919 1190 1462 1087 1260

310 530 950 1400 1800 2200 2600

 NR
 NR
 240
 400
 750
 1090
 1400
 1720
 2030

 658
 IO25
 I5I4
 2081
 27T4
 3130

 598
 935
 I365
 1854
 2355
 I793

 598
 935
 I365
 1854
 2441
 3155

GRAVITY

PRE-CAST LINTEL OVER GARAGE DOOR

PRE-CAST LINTELS & LANA! COLUMNS

(VARIES)

						GR	AVITY	-			
			TYPE		SRF6-OB	BRFIO-OB	SRFI4-OB	SRFIS-OB	8RF22-(OB	SRF26-OB	SRF30-0E
MARK	LENGT	Н		8RU6	8RF6-IB	SRFIO-IB	8R=14-1B	8RFI8-IB	8RF22-11B	8RF26-IB	8RF30-1B
Line	4'-4"	(52°)			1591	3053	2982	3954	4929	5904	6880
L22	4-4	(52)	PRECAST	1489	1827	3412	4982	6472	7947	9416	10878
77.22	4'-6"	(54")	PRECA6T		1449	2782	2714	3600	44871	5375	6264
L23	4-0	(54)	PRECASI	1357	1702	3412	4982	6472	7947	9416	10878
2010 N 00 00 00 00 00 00 00 00 00 00 00 00			832	1602	1550	2058	2566	3075	3585		
L24	5'-9"	(68")	PRECAST	785	1153	2162	4074	6472	6516	5814	6839
000000	have the w	(00000 W 1000	SASTRAL POLICES		err	1500	1449	1924	24007	2876	3352
L25	B'-10"	(10")	PRECAST	735	1103	2051	3811	6472	6516	5450	6411
	the triangle	7 II -			907	1677	2933	2576	3223	3872	4522
L26	6 6'-8" (80")	PRECAST	822	907	1677	2933	4100	6730>	SITT	6707	
			The state of the s		761	1377	2252	1958	2451	2944	3439
L27	T'-6"	(90")	PRECAST	665	764	1377	2323	3609	5492	6624	B132
	-1 -1				420	834	1253	IFOI	1342	1614	1886
L28	9'-8"	(116")	PRECAST	371	535	928	1497	2179	2618	3595	2875

SHOP DWG COORDINATION: THE TRUSS ANCHOR STRAPS AS INDICATED IN THE CONSTRUCTION DOCUMENTS ARE SUGGESTED STRAPS AND THAT THE TRU66 ENGINEERED SHOP DRAWING LOADS TAKE PRECEDENCE OVER THAT INDICATED IN THE CONSTRUCTION DOCUMENTS. THE UPLIFT LOADS INDICATED FOR EACH TRUSS IN THE ENGINEERED TRUSS SHOP DRAWINGS MAY BE MATCHED TO STANDARD PRODUCT UPLIFT RAITINGS FOR COMPARABLE UPLIFT CONNECTORS, AND THAT THE PRODUCTS THAT PROVIDE EQUAL OR GREATER UPLIFT RESISTANCE FOR THE LISTED LOAIDS MAY BE USED IN LIEU OF THOSE INDICATED IN THE CONSTRUCTION DOCUMENTS

OR AS APPROVED BY THE BUILDING OFFICIAL.

THE CONTRACTOR SHALL COORDINATE THE TRUSS TO TRUSS ANCHOR REQUIREMENTS WITH THE TRUSS ENGINEERING SHOP DRAWINGS, SOME OF THE TRUSS TO TRUSS CONNECTIONS WILL REQUIRE ANCHOR STRAPS IN ADDITION TO TYPICAL NAILING, ANCHOR DEVICES SHALL BE REQUIRED FOR ALL JOINTS WITH AN UPLIFT OR GRAVITY LOAD OF 100 LBS OR GREATEIR.


TRUSSES BEARING ON INTERIOR PARTITIONS WHERE UPLIFT LOADS ARE PRESENT SHALL REQUIRE ANCHORS OF EQUAL OR GREATER LOAD CAPACITY THAN THAT INDICATED BY THE TRUSS SHOP DRAWINGS, THE UPLIFT ANCHOR SYSTEM SHALL BE CONTINUOUS TO THE FOUNDATION.

# Roof Framing PLAN

SCALE: 1/4" = 1'-0"

ALL PENETRATIONS OF THE TOP PLATE OF ALL LOAD BEARING WALLS SHALL BE SEALED WITH FIRE RETARDANT CAULKING, INCLUDING WIRING, PLUMBING OR OTHER SUCH PENETRATIONS. WALLS OVER 8'-0" TALL SHALL HAVE CONTINUOUS BLOCKING TO LIMIT CAYITY HEIGHT TO 8'-O". PENETRATIONS THROUGH SUCH BLOCKING SHALL BE TREATED IN THE SAME MANNER AS TOP PLATES, NOTED ABOVE

L4

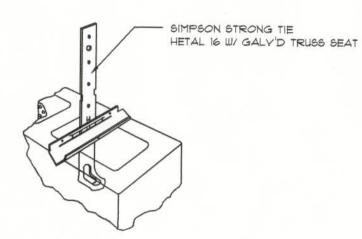

Truss Anchor DETAIL SCALE: 1/2" = 1'-0"

ROOFING MI	ETALS for FLAS	SHING/ROO	FING
MATERIAL	MINIMUM	6.165	

MATERIAL	THICKNESS (in)	GAGE	WEIGHT
COPPER			16
ALUMINUM	0.024		
STAINLESS STEEL		28	
GALYANIZED STEEL	er10.0	26 (ZINC COATED G90)	
ZINC ALLOY LEAD PAINTED TERNE	0.027		40 20

## PROJECT COORDINATION REQUIREMENTS

THESE PLANS ARE DRAWN FOR AVERAGE SITE CONDITIONS AND COMPLIANCE WITH APPLICABLE CODES AT THE TIME THEY ARE DRAWN. DUE TO VARYING STATE, LOCAL, AND NIATIONAL CODES RULES AND REGULATIONS, N.P.GEISLER, ARCHITCT CANNOT WARRANT COMPLIANCE WITH ALL APPLICABLE STATE, LOCAL, AND NATIONAL CODES IN YOUR AREA OR WITH YOUR PAIRTICULAR SITE CONDITIONS. IT IS THE RESPONSIBILITY OF THE PURCHASER AND/OR BUILDER TO SEE THAT THE STRUCTURE IS BUILT IN STRICT COMPLIANCE WITH ALL GOVERNING MUNICIPAL CODES (CITY, COUNTY, STATE, AND FEDERAL), IF YOUR CITY OR STATE REQUIRES AN ENGINEER'S SEAL FOR THE SITE/CIVIL PORTIONS OF THE WORK,, YOU WILL NEED TO HAVE THAT DONE LOCALLY BY A QUALIFIED, LICENCED PROFESSIONAL ENGINEER.

NOTE: ALL DRAWINGS NOT TO BE SCALED, WRITTEN DIMENSIONS TAKE PRECEDENCE OVER SCALED DIMENSIONS

N 80

ZIZ

SOFTPLAN

JOB NUMBER 20250122

SHEET NUMBER OF 4 SHEETS

Compliance Summary

#### TYPE OF CONSTRUCTION

Gable / Hip Construction, Wood Trusses @ 24" O.C. Walls: 8" CMU W/ (1) #5 VERTICAL @ 48" O.C. MAX 4" Thk. Concrete Slab W/ Fibermesh Concrete Additive Foundation: Continuous monolithic footing or /Stem Wall foundation system

#### ROOF DECKING

1/2" CDX Plywood or 7/16" O.S.B. Sheet Size: 48"x96" Sheets Perpendicular to Roof Framing 10d Ring-Shank Nails per schedule on sheet S.4 Fasteners:

#### SHEARWALLS

Material: 8" CMU W/ (1) #5 VERTICAL @ 48" O.C. MAX AND BESIDE EACH OPENING

#### HURRICANE UPLIFT CONNECTORS

SIMPSON HETEL 16 W/ TSS Truss Anchors:

Truss Anchors (FRAME): SIMPSON H2.5A (OR EQUIVALENT), W/ 6 - 10d NAILS

Porch Column Base Connector: Simpson ABU44/ABU66 @ each column Porch Column to Beam Connector: Simpson EPC44 or 66 /PC44 or 66 @ each column

#### FOOTINGS AND FOUNDATIONS

House walls: 20"D x 16"W Cont. W/ (2) #5 Bars Cont. on chairs or (1) #3 Transverse @ 24" O.C. Optional Stemwall: 8" C.M.U. W/1-#5 Vertical Dowel @ 48" O.C.

#### STRUCTURAL DESIGN CRITERIA:

. THE DESIGN COMPLIES WITH THE REQUIREMENTS OF THE 2023 FLORIDA BUILDING CODE (8TH EDITION) AND OTHER REFERENCED CODES AND SPECIFICATIONS. ALL CODES AND SPECIFICATIONS SHALL BE LATEST EDITION AT TIME OF PERMIT.

2. WIND LOAD CRITERIA: RISK CATAGORY: 2, EXPOSURE: "C"

..... 60 PSF

BASED ON ANSI/ASCE 7-22, 2023 FBC 1609-A WIND VELOCITY: YULT = 140 MPH YASD = 108 MPH

3. ROOF DESIGN LOADS: SUPERIMPOSED DEAD LOADS: ..... 20 PSF

SUPERIMPOSED LIVE LOADS: ..... 20 PSF

4. FLOOR DESIGN LOADS: SUPERIMPOSED DEAD LOADS: . . . . . . 25 PSF SUPERIMPOSED LIVE LOADS: ..... 40 PSF RESIDENTIAL

5. WIND NET UPLIFT: ARE AS INDICATED ON PLANS

#### **TERMITE PROTECTION NOTES:**

#### SOIL CHEMICAL BARRIER METHOD:

BALCONIES

1. A PERMANENT SIGN WHICH IDENTIFIES THE TERMITE TREATMENT PROVIDER AND NEED FOR REINSPECTION AND TREATMENT CONTRACT RENEWAL SHALL BE PROVIDED. THE SIGN SHALL BE POSTED NEAR THE WATER HEATER OR ELECTRIC PANEL. FBC 104.2.6

2. CONDENSATE AND ROOF DOWNSPOUTS SHALL DISCHARGE AT LEAST 1'-0" AWAY FROM BUILDING SIDE WALLS. FBC 1503.4.4

3. IRRIGATION/SPRINKLER SYSTEMS INCLUDING ALL RISERS AND SPRAY HEADS SHALL NOT BE INSTALLED WITHIN 1'-0" FROM BUILDING SIDE WALLS.. FBC 1503.4.4

4. TO PROVIDE FOR INSPECTION FOR TERMITE INFESTATION, BETWEEN WALL COVERINGS AND FINAL EARTH GRADE SHALL NOT BE LESS THAN 6". EXCEPTION: PAINT AND DECORATIVE CEMENTIOUS FINISH LESS THAN 5/8" THICK ADHERED DIRECTLY TO THE FOUNDATION WALL. FBC 1403.1.6

5. INITIAL TREATMENT SHALL BE DONE AFTER ALL EXCAVATION AND BACKFILL IS COMPLETE. FBC 1816.1.1

6. SOIL DISTURBED AFTER THE INITIAL TREATMENT SHALL BE RETREATED INCLUDING SPACES BOXED OR FORMED. FBC 1816.1.2

7. BOXED AREAS IN CONCRETE FLOOR FOR SUBSEQUENT INSTALLATION OF TRAPS, ETC., SHALL BE MADE WITH PERMANENT METAL OR PLASTIC FORMS. PERMANENT FORMS MUST BE OF A SIZE AND DEPTH THAT WILL ELIMINATE THE DISTURBANCE OF SOIL AFTER THE INITIAL TREATMENT.

8. MINIMUM 6 MIL VAPOR RETARDER MUST BE INSTALLED TO PROTECT

AGAINST RAINFALL DILUTION. IF RAINFALL OCCURS BEFORE VAPOR RET-ARDER PLACEMENT, RETREATMENT IS REQUIRED. FBC 1816.1.4 9. CONCRETE OVERPOUR AND MORTAR ALONG THE FOUNDATION PERIMETER MUST BE REMOVED BEFORE EXTERIOR SOIL TREATMENT. FBC 1816.1.5 10. SOIL TREATMENT MUST BE APPLIED UNDER ALL EXTERIOR CONCRETE OR GRADE WITHIN 1'-0" OF THE STRUCTURE SIDEWALLS. FBC 1816.1.6 11. AN EXTERIOR VERTICAL CHEMICAL BARRIER MUST BE INSTALLED AFTER: CONSTRUCTION IS COMPLETE INCLUDING LANDSCAPING AND IRRIGATION. ANY SOIL DISTURBED AFTER THE VERTICAL BARRIER IS APPLIED, SHALL BE RETREATED. FBC 1816.1.6

12. ALL BUILDINGS ARE REQUIRED TO HAVE PER-CONSTRUCTION TREATMENT.

13. A CERTIFICATE OF COMPLIANCE MUST BE ISSUED TO THE BUILDING DEPART-MENT BY # LICENSED PEST CONTROL COMPANY BEFORE A CERTIFICATE OF: OCCUPANCY WILL BE ISSUED. THE CERTIFICATE OF COMPLIANCE SHALL STATE: "THE BUILDING HAS RECEIVED A COMPLETE TREATMENT FOR THE PREVENTION OF SUBTERRANEAN TERMITES. THE TREATMENT IS IN ACCORDANCE WITH THE RULES AND LAWS OF THE FLORIDA DEPARTMENT OF AGRICULTURE AND COINS-UMER SERVICES". FBC 1816.1.7

14. AFTER ALL WORK IS COMPLETED, LOOSE WOOD AND FILL MUST BE REMOVED FROM BELOW AND WITHIN 1'-0" OF THE BUILDING. THIS INCLUDES ALL GRADE STAKES, TUB TRAP BOXES, FORMS, SHORING OR OTHER CELLULOSE CONTAINING MATERIAL, FBC 2303.1.3

15. NO WOOD, VEGETATION, STUMPS, CARDBOARD, TRASH, ETC., SHALL BE BURIED WITHIN 15'-0" OF ANY BUILDING OR PROPOSED BUILDING. FBC 2303.1.4

#### FRAMING ANCHOR SCHEDULE

APPLICATION MANUF'R/MODEL CAP. TRUSS TO WALL: "SIMPSON" HETEL 16 W/ TSS 1410# PORCH BEAM TO POST (4x 4): SIMPSON PC44/EPC44 1700# PORCH BEAM TO POST (6x 6): SIMPSON PC66/EPC66 1700# PORCH POST TO FND.: SIMPSON ABU44 or ABU 66 2200# MISC. JOINTS SIMPSON A34 315#/240#

ALL ANCHORS SHALL BE SECURED W/ NAILS AS PRESCRIBED BY THE MANUFACTURER FOR MAXIMUM JOINT STRENGTH, UNLESS NOTED OTHERWISE.


REFER TO THE INCLUDED STRUCTURAL DETAILS FOR ADDITIONAL ANCHORS/ JOINT REINFORCEMENT AND FASTENERS.


ALL UNLISTED JOINTS IN THE LOAD PATH SHALL BE REINFORCED WITH SIMPSON A34 FRAMING ANCHORS, TYPICAL T.O.

MIAMI/DADE COUNTY REPORT #95-0818.15 NOTE: "SIMPSON" PRODUCT APPROVALS:

"SEMCO" PRODUCT APPROVAL:

MIAMI/DADE COUNTY REPORT #97-0107.05, #96-1126.11, #99-0623.04 SBCC1 NER-443, NER-393

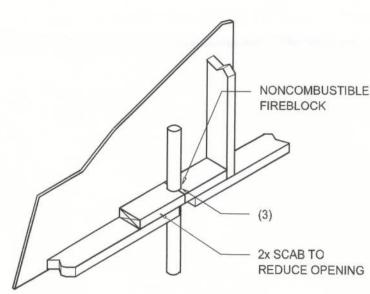

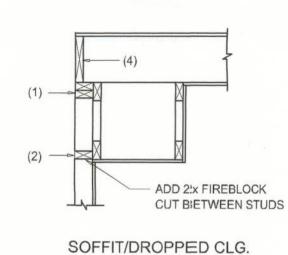

# **PENETRATIONS**

FIREBLOCKING NOTES:

FIREBLOCKING SHALL BE INSTALLED IN WOOD FRAME CONSTRUCTION IN THE FOLLOWING LOCATIONS:

1. IN CONCEALED SPACES OF STUD WALLS AND PARTITIONS INCLUDING FURRED SPACES AT CEILING AND FLOOR LEVELS.

2. AT ALL INTERCONNECTIONS BETWEEN CONCEALED VERTICAL AND HORIZONTAL SPACES SUCH AS OCCUR AT SOFFITS, DROP CEILINGS, COVE CEILINGS, ETC.

3. AT OPENINGS AROUND VENTS, PIPES, DUCTS, CHIMNEYS AND FIREPLACES AT CEILING AND FLOOR LEVELS WITH "PYROPANEL MULTIFLEX SEALANT"

AT ALL INTERCONNECTIONS BETWEEN CONCEALED VERTICAL STUD WALL OR PARTITION SPACES AND CONCEALED SPACES CREATED BY AN ASSEMBLY OF FLOOR JOISTS, FIREBLOCKING SHALL BE PROVIDED FOR THE FULL DEPTH OF THE JOISTS AT THE ENDS AND OVER THE SUPPORTS.

# Fire Stopping DETAILS

SCALE: NONE



_						
4		22	BUILDING MEAN BUIL		6 ¢ CLADDING [ = 30.0', EXF	
	ZONE	AREA	Yult 110 MPH	Yult 120 MPH	Yult 130 MPH	Yult 140 MPH
27	1 1 1	10 20 50	12.0 / -19.9 11.4 / -19.4 10.0 / -18.6	14.9 / -23.7 13.6 / -23.0 11.9 / -22.2	17.5 / -27.8 16.0 / -27.0 13.9 / -26.0	20.3 / -32.3 18.5 / -31.4 16.1 / -30.2
T T0	2 2 2	10 20 50	12.5 / -34.7 11.4 / -31.9 10.0 / -28.2	14.9 / -41.3 13.6 / -38.0 11.9 / -33.6	17.5 / -48.4 16.0 / -44.6 13.9 / -39.4	20.3 / -56.2 18.5 / -51.7 16.1 / -45.7
ROOF	3 3 3	10 20 50	12.5 / -51.3 11.4 /-47.9 10.0 / -43.5	14.9 / -61.0 13.6 / -57.1 11.9 / -51.8	17.5 / -71.6 16.0 / -67.0 13.9 / -60.8	20.3 / -83.1 18.5 / -TT.T 16.1 / -T0.5
MALL	4 4 4	10 20 50	21.8 / -23.6 20.8 / -22.6 19.5 / -21.3	25.9 / -34.7 24.7 / -26.9 23.2 / -25.4	30.4 / -33.0 29.0 / -31.6 27.2 / -29.8	35.3 / -36.2 33.7 / -36.7 31.6 / -34.6
m	10 10 10	10 20 50	21.8 / -29.1 20.8 / -27.2 19.5 / -24.6	25.9 / -34.7 24.7 / -32.4 23.2 / -29.3	30.4 /-40.7 29.0 / -38.0 27.2 / -34.3	35.3 / -47.2 33.7 / -44.0 31.6 / -39.8

	EXPOSURE AIL		
BLDG HEIGHT	EXPOSURE "B"	EXPOSURE	EXPOSURE
15	1.00	1.21	1.47
20	1.00	1.29	1.55
25	1.00	1.35	1.61
30	1.00	1.40	1.66

L				GLE 2T TO 4	T = 30.0', EX <del>1</del> 5^	POSURE "E
	ZONE	AREA	Vult 110 MPH	Vult 120 MPH	Vult 130 MPH	Vult 140 MPH
45,	1 1	10 20 50	19.9 / -21.8 19.4 / -20.7 18.6 / -19.2	23.7 / -25.9 23.0 / -24.6 22.2 / -22.8	27.8 / -30.4 27.0 / -28.9 26.0 / -26.8	32.3 / -35.3 31.4 / -33.5 30.2 / -31.1
F 2T TO	2 2 2	10 20 50	19.9 / -25.5 19.4 / -24.3 18.6 / -22.9	23.7 / -30.3 23.0 / -29.0 22.2 / -27.2	27.8 / -35.6 27.0 / -34.0 26.0 / -32.0	32.3 / -41.2 31.4 / -39.4 30.2 / -37.1
ROOF	3 3 3	10 20 50	19.9 / -25.5 19.4 / -24.3 18.6 / -22.9	23.7 / -30.3 23.0 / -29.0 22.2 / -27.2	27.8 / -35.6 27.0 / -34.0 26.0 / -32.0	32.3 / -41.2 31.4 / -39.4 30.2 / -37.1
WALL	4 4 4	10 20 50	21.8 / -23.6 20.8 / -22.6 19.5 / -21.3	25.9 / -34.7 24.7 / -26.9 23.2 / -25.4	30.4 / -33.0 29.0 / -31.6 27.2 / -29.8	35.3 / -38.2 33.7 / -36.7 31.6 / -34.6
	10 10 10	10 20 50	21.8 / -29.1 20.8 / -27.2 19.5 / -24.6	25.9 / -34.7 24.7 / -32.4 23.2 / -29.3	30.4 /-40.7 29.0 / -38.0 27.2 / -34.3	35.3 / -47.2 33.7 / -44.0 31.6 / -39.8

HEIGHT & EXPOSURE ADJUSTMENT COEFFICIENTS FOR BUILDING COMPONENTS & CLADDING					
BLDG HEIGHT	EXPOSURE	EXPOSURE	EXPOSURE "D"		
15 20	1.00	1.21	1,47		
25	1.00	1.29	1.55		
30	1.00	1.35	1.61		

### General Roofing NOTES:

DECK REQUIREMENTS:

ASPHALT SHINGLES SHALL BE FASTENED TO SOLIDLY SHEATHED DECKS.

ASPHALT SHINGLES SHALL BE USED ONLY ON ROOF SLOPES OF 2:12 OR GREATER. FOR ROOF SLOPES FROM 2:12 TO 4:12, DBL. UNDERLAYMENT IS REQUIRED.

UNLESS OTHERWISE NOTED, UNDERLAYMENT SHALL CONFORM W/ ASTM D 226,

SELF-ADHERING POLYMER MODIFIED BITUMEN SHEET:

ASPHALT SHINGLES: ASPHALT SHINGLES SHALL HAVE SELF SEAL STRIPS OR BE INTERLOCKING,

FASTENERS FOR ASPHALT SHINGLES SHALL BE GALVANIZED, STAINLESS STEEL, ALUMINUM OR COPPER ROOFING NAILS, MINIMUM 12 GAUGE SHANK WITH A MINIMUM 3/8 INCH DIAMETER HEAD, OF A LENGTH TO PENETRATE THROUGH THE ROOFING MATERIAL AND A MINIMUM 3/4" INTO THE ROOF SHEATHING. WHERE THE SHEATHING IS LESS THAN 3/4" THICK, THE NAILS SHALL PENETRATE THROUGH THE SHEATHING.

ATTACHMENT: ASPHALT SHINGLES SHALL BE SECURED TO THE ROOF WITH NOT LESS THAN FOUR FASTENERS PER STRIP SHINGLE OR TWO FASTENERS PER INDIVIDUAL SHINGLE. WHERE ROOFS LOCATED IN BASIC WIND SPEED OF 110 MPH OR GREATER, SPECIAL METHODS OF FASTENING ARE REQUIRED. UNLESS

UNDERLAYMENT APPLICATION: FOR ROOF SLOPES FORM 2:12 TO 4:12, UNDERLAYMENT SHALL BE A MINIMUM OF TWO LAYERS APPLIED AS FOLLOWS: 1. STARTING AT THE EAVE, A 19 INCH STRIP OF UNDERLAYMENT SHALL BE

2. STARTING AT THE EAVE, 36 INCH WIDE STRIPS OF UNDERLAYMENT FELT SHALL BE APPLIED OVERLAPPING SUCCESSIVE SHEETS 19 INCHES AND FASTENED SUFFICIENTLY TO STAY IN PLACE.

FOR ROOF SLOPED 4:12 AND GREATER, UNDERLAYMENT SHALL BE A MINIMUM OF ONE LAYER OF UNDERLAYMENT FELT APPLIED AS FOLLOWS: STARTING AT THE EAVE, UNDERLAYMENT SHALL BE APPLIED SHINGLE FASHION PARALLEL TO THE EAVE, LAPPED 2 INCHES, AND FASTENED SUFFICIENTLY TO STAY IN PLACE.

BASE AND CAP FLASHINGS: BASE AND CAP FLASHING SHALL BE INSTALLED IN ACCORDANCE W/ MFGR'S INSTALLATION INSTRUCTIONS. BASE FLASHING SHALL BE OF EITHER CORROSION RESISTANT METAL OF MINIMUM NOMINAL THICKNESS 0.019 INCH OR MINERAL SURFACE ROLL ROOFING WEIGHING A MINIMUM OF 77 LBS PER 100 SQUARE FEET. CAP FLASHING SHALL BE CORROSION RESISTANT METAL OF MINIMUM NOMINAL THICKNESS OF 0.019 INCH.

VALLEYS: VALLEY LININGS SHALL BE INSTALLED IN ACCORDANCE W/ MANUFACTURER'S INSTALLATION INSTRUCTIONS BEFORE APPLYING ASPHALT SHINGLES. VALLEY LININGS OF THE FOLLOWING TYPES SHALL BE PERMITTED. 1. FOR OPEN VALLEYS LINED WITH METAL, THE VALLEY LINING SHALL BE AT LEAST 16" WIDE AND OF ANY OF THE CORROSION RESISTANT METALS IN FBC TABLE 1507.3.9.2.

2. FOR OPEN VALLEYS, VALLEY LINING OF TWO PLIES OF MINERAL SURFACE ROLL ROOFING SHALL BE PERMITTED. THE BOTTOM LAYER SHALL BE 18 INCHES AND THE TOP LAYER A MINIMUM OF 36 INCHES WIDE. 3. FOR CLOSED VALLEYS VALLEY LINING SHALL BE ONE OF THE FOLLOWING: 1. BOTH TYPES 1 AND 2 ABOVE, COMBINED. 2. ONE PLY OF SMOOTH ROLL ROOFING AT LEAST 36 INCHES WIDE AND COMPLYING WITH ASTM D 224.

NOTE!!! ROOFSHINGLES SHALL BE AS MANUFACTURED BY "TAMKO ROOFING PRODUCTS" OF THE FOLLOWING MODELS:

> GLASS-SEAL AR ELITE GLASS-SEAL AR HERITAGE 30 AR HERITAGE 40 AR HERITAGE 50 AR

WITH ASTM D 1970.

THESE SHINGLES MEET THE REQUIREMENTS OF ASTM D-3161 TYPE 1 MODIFIED TO 110 MPH WINDS & FBC TAS 100, USING 4 NAILS/SHINGLE

AND COMPLY WITH ASTM D 225 OR ASTM D 3462.

TYPE 1, OR ASTM D 4869, TYPE 1.

SELF ADHERING POLYMER MODIFIED BITUMEN SHALL COMPLY W/ ASTM D 1970.

OTHERWISE NOTED, ATTACHMENT OF ASPHALT SHINGLES SHALL CONFORM WITH ASTM D 3161 OR M-DC PA 107-95.

APPLIED PARALLEL WITH THE EAVE AND FASTENED SUFFICIENTLY TO STAY IN PLACE

3. SPECIALTY UNDERLAYMENT AT LEAST 36 INCHES WIDE AND COMPLYING

5

Z


SOFTPLAN


JOB NUMBER 20250122

SHEET NUMBER

OF 4 SHEETS


# Masonry Opn'g DET'S SCALE: 1" = 1'-0"

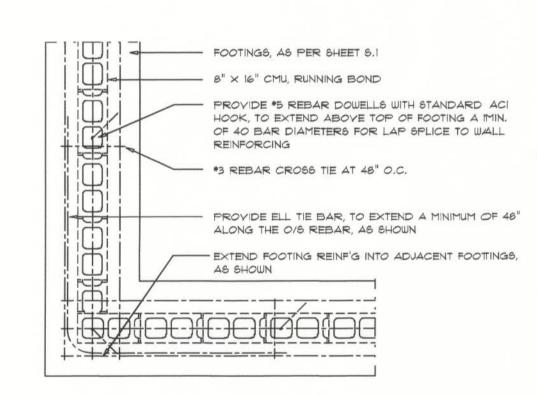


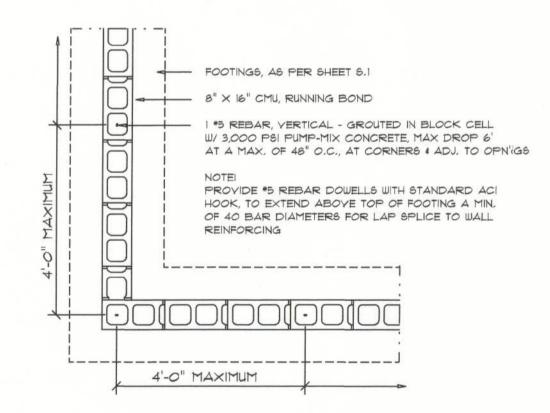

# Wall/Foundation Reinf'g DETAIL

SCALE: 1/2" = 1'-0"

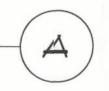

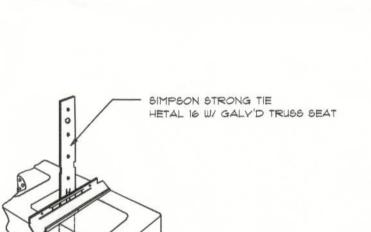

# Truss Anchor DETAIL

SCALE: 1/2" = 1'-0"

# CONCRETE / MASONRY / METALS GENERAL NOTES:

1. DESIGN SOIL BEARING PRESSURE: 1,000 PSF.

2. EXPANSIVE SOILS: WHERE DIRECTED BY THE SOILS ENGINEER, SOIL AUGMENTATION PER THE SOILS ENGINEER'S SPECIFICATIONS SHALL BE IMPLEMENTED PRIOR TO PLACING ANY FOUNDATIONS - TESTS AS SPECIFIED SHALL BE PREFORMED TO DETERMINE THE SUITABILITY OF THE SUB-GRADE TO SUPPORT THE DESIGN LOADS.

E

- 3. CLEAN SAND FILL OVER STRIPPED AND COMPACTED EXISTING GD. SHALL BE PLACED IN 12" LIFTS, BOTH SUB-SOIL AND FILL COMPAC-TION SHALL BE NOT LESS THAN 98% AS MEASURED BY A MODIFIED PROCTOR TEST AT THE RATE OF ONE TEST FOR EACH 1500 SF OF BUILDING PAD AREA, OR FRACTION THEREOF, FOR EACH 12" LIFT.
- 4. REINFORCING STEEL SHALL BE GRADE 60 AND MEET THE REQUIRE-MENTS OF ASTM AGIS, ALL BENDS SHALL BE MADE COLD.
- 5. WELDED WIRE MESH SLAB REINFORCING SHALL MEET THE REQUIRE-MENTS OF ASTM A185 - MIN, YEILD STRESS = 85 KSI.
- 6. CONCRETE SHALL BE STANDARD MIX F'c = 3000 PSI FOR ALL FTGS, SLABS, COLUMNS AND BEAMS OR SHALL BE STANDARD PUMP MIX F'c = 3000 PSI, STRENGTH SHALL BE ATTAINED WITHIN 28 DAYS OF PLACE-MENT, MIXING, PLACING AND FINISHING SHALL BE AS PER ACI
- CONCRETE BLOCK SHALL BE AS PER MANUFACTURER'S PRODUCT GUIDE FOR ASTM C-90 REQUIREMENTS WITH MEDIUM SURFACE FINISH -
- 8. MORTAR SHALL BE TYPE "M" OR "N" FOR ALL MASONRY UNITS,
- STRUCTURAL STEEL SHALL CONFORM TO ASTM A36 STANDARDS FOR STRENGTH, BOLTS SHALL BE ASTM A307 / GRADE | OR A325, AS PER PLAN REQUIREMENTS.
- 10. WELDS SHALL BE AS PER "AMERICAN WELDING SOCIETY" STANDARDS FOR STRUCTURAL STEEL APPLICATIONS.

## TERMITE PROTECTION NOTES:

SOIL CHEMICAL BARRIER METHOD:

I. A PERMANENT SIGN WHICH IDENTIFIES THE TERMITE TREATMENT PROVIDER AND NEED FOR REINSPECTION AND TREATMENT CONTRACT RENEWAL SHALL BE PROVIDED. THE SIGN SHALL BE POSTED NEAR THE WATER HEATER OR ELECTRIC PANEL, FBC 104.2.6

2. CONDENSATE AND ROOF DOWNSPOUTS SHALL DISCHARGE AT LEAST 1'-O" AWAY FROM BUILDING SIDE WALLS, FBC 1503,4,4

3. IRRIGATION/SPRINKLER SYSTEMS INCLUDING ALL RISERS AND SPRAY HEADS SHALL NOT BE INSTALLED WITHIN 1'-O" FROM BUILDING SIDE WALLS. FBC 1503.4.4

4. TO PROVIDE FOR INSPECTION FOR TERMITE INFESTATION, BETWEEN WALL COYERINGS AND FINAL EARTH GRADE SHALL NOT BE LESS THAN 6". EXCEPTION: PAINT AND DECORATIVE CEMENTIOUS FINISH LESS THAN 5/8" THICK ADHERED DIRECTLY TO THE FOUNDATION WALL, FBC 1403.1.6

BACKFILL IS COMPLETE. FBC 1816.1.1 6. SOIL DISTURBED AFTER THE INITIAL TREATMENT SHALL BE RETREATED INCLUDING SPACES BOXED OR FORMED, FBC 1816.1.2

7. BOXED AREAS IN CONCRETE FLOOR FOR SUBSEQUENT INSTALLATION OF TRAPS, ETC., SHALL BE MADE WITH PERMANENT METAL OR PLASTIC FORMS, PERMANENT FORMS MUST BE OF A SIZE AND DEPTH THAT WILL ELIMINATE THE DISTURBANCE OF SOIL AFTER THE INITIAL TREATMENT. FBC 1816.1.3

5. INITIAL TREATMENT SHALL BE DONE AFTER ALL EXCAYATION AND

8. MINIMUM 6 MIL VAPOR RETARDER MUST BE INSTALLED TO PROTECT AGAINST RAINFALL DILUTION, IF RAINFALL OCCURS BEFORE VAPOR RET-ARDER PLACEMENT, RETREATMENT IS REQUIRED. FBC 1816.1.4 9. CONCRETE OVERPOUR AND MORTAR ALONG THE FOUNDATION PERIMETER MUST BE REMOVED BEFORE EXTERIOR SOIL TREATMENT. FBC 1816,1,5 10. SOIL TREATMENT IMUST BE APPLIED UNDER ALL EXTERIOR CONCRETE OR GRADE WITHIN I'-O" OF THE STRUCTURE SIDEWALLS, FBC 1816.1.6 11. AN EXTERIOR YER:TICAL CHEMICAL BARRIER MUST BE INSTALLED AFTER CONSTRUCTION IS COMPLETE INCLUDING LANDSCAPING AND IRRIGATION.

BE RETREATED. FBC 1816.1.6 12. ALL BUILDINGS ARE REQUIRED TO HAVE PER-CONSTRUCTION TREATMENT.

ANY SOIL DISTURBED AFTER THE VERTICAL BARRIER IS APPLIED, SHALL

13. A CERTIFICATE OF COMPLIANCE MUST BE ISSUED TO THE BUILDING DEPART-MENT BY \* LICENSED PEST CONTROL COMPANY BEFORE A CERTIFICATE OF OCCUPANCY WILL BE: ISSUED, THE CERTIFICATE OF COMPLIANCE SHALL STATE: THE BUILDING HAS RIECEIVED A COMPLETE TREATMENT FOR THE PREVENTION OF SUBTERRANEAN TERMITES, THE TREATMENT IS IN ACCORDANCE WITH THE RULES AND LAWS OF THE FLORIDA DEPARTMENT OF AGRICULTURE AND CONS-UMER SERVICES". FBC 1816.1.7

14. AFTER ALL WORK IS COMPLETED, LOOSE WOOD AND FILL MUST BE REMOVED FROM BELOW AND WITHIN 1'-O" OF THE BUILDING, THIS INCLUDES ALL GRADE STAKES, TUB TRAP BOXES, FORMS, SHORING OR OTHER CELLULOSE CONTAINING MATERIAL. FBC 2303.1.3

15. NO WOOD, YEGETATION, STUMPS, CARDBOARD, TRASH, ETC., SHALL BE BURIED WITHIN 15'-O" OF ANY BUILDING OR PROPOSED BUILDING. FBC 2303.1.4

# WOOD STRUCTURAL NOTES

- TEMPORARY BRACING OF THE STRUCTURE DURING ERECTION REQUIRED FOR SAFE AND SITABLE CONSTRUCTION, SHALL BE THE SOLE RESPON-SIBILITY OF THE CONTRACTOR SO ENGAGED, TEMPORARY & PERMANENT BRACING OF ROOF TRUSSES SHALL BE AS PER THE STANDARD GUIDE-LINES OF THE "TR:USS PLATE INSTITUTE",
- 2. ALL TRUSSES SHALL BE DESIGNED BY A LICENSED PROFESSIONAL ENGINEER & SHALL BE SIGNED AND SEALED BY SAME, TRUSS DESIGN SHALL INCLUDE PLACEMENT PLANS, TRUSS DETAILS, TRUSS TO TRUSS CONNECTIONS & THE STANDARD SPECIFICATIONS & RECOMMENDATIONS OF INSTALLATION OF THE "TRUSS PLATE INSTITUTE".
- 3. WOOD STUDS IN EXTERIOR WALLS & INTERIOR BEARING WALLS SHALL BE NOT LESS THAN Nr.2 HEM-FIR OR BETTER,
- 4. CONNECTORS FOR WOOD FRAMING SHALL BE GALVANIZED METAL OR BLACK METAL AS MANUFACTURED OR AS CALLED FOR IN THE PLANS AND BE OF A DESIGN SUITABLE FOR THE LOADS AND USE INTENDED. REFER TO THE JONINT REINFORCEMENT SCHEDULE FOR PRINCIPLE CON-

	ZONE	AREA	Vult 110 MPH	Vult 120 MPH	Vult 130 MPH	Vult 140 MPH
_	1 1 1	10 20 50	12.0 / -1/9.9 11.4 / -1/9.4 10.0 / -1/8.6	14.9 / -23.7 13.6 / -23.0 11.9 / -22.2	17.5 / -27.8 16.0 / -27.0 13.9 / -26.0	20.3 / -32.3 18.5 / -31.4 16.1 / -30.2
F 7^ TO 27^	2	10	12.5 / -344.7	14.9 / -41.3	17.5 / -48.4	20.3 / -56.2
	2	20	11.4 / -311.9	13.6 / -38.0	16.0 / -44.6	18.5 / -51.7
	2	50	10.0 / -218.2	11.9 / -33.6	13.9 / -39.4	16.1 / -45.7
ROOF	3	10	12.5 / -5\1.3	14.9 / -61.0	17.5 / -71.6	20.3 / -83.1
	3	20	11.4 /-4\7.9	13.6 / -57.1	16.0 / -67.0	18.5 / -77.7
	3	50	10.0 / -4\3.5	11.9 / -51.8	13.9 / -60.8	16.1 / -70.5
/LL	4	10	21.8 / -2:3.6	25.9 / -34.7	30.4 / -33.0	35.3 / -38.2
	4	20	20.8 / -2:2.6	24.7 / -26.9	29.0 / -31.6	33.7 / -36.7
	4	50	19.5 / -2:1.3	23.2 / -25.4	27.2 / -29.8	31.6 / -34.6
WALL	5	10	21.8 / -2\sqrt{9.1}	25.9 / -34.7	30.4 /-40.7	35.3 / -47.2
	5	20	20.8 / -2\tau{7.2}	24.7 / -32.4	29.0 / -38.0	33.7 / -44.0
	5	50	19.5 / -2\d2.6	23.2 / -29.3	27.2 / -34.3	31.6 / -39.8

#### CANTILEVER "E" BAR (END) - "E" BAR TOP BAR - BOTT, BAR BOTT, BAR MIN. - #3 STIRRUPS (TYPICAL) - #3 HOOPS OR OR #3 HOOPS #3 STIRRUPS SPACED FROM SPACED FROM SUPPORT FACE SUPPORT FACE AS SCHEDULED AS SCHEDULED

BOTTOM BARS - TOP BARS - "E" BARS BENDING DIA .: CAST-IN-PLACE CONCRETE BEAMS & SLABS


SCALE: NONE

ZONE

SCALE: NONE

NAILING SHEATHING

TYPE

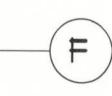


#### GENERAL BEAM SCHEDULE NOTE:

- 1. SCHEDULED HOOPS OR STIRRUPS SHALL BE PLACED AT EACH END OF BEAM UNLESS NOTED OTHERWISE. STIRRUPS SHALL BE TYPE 5-6 \$ HOOPS SHALLBE TYPE T-2 TYPICAL CRSI BAR BENDS UNLESS NOTED OTHERWISE,
- 2. BUNDLE ALL STRUCTURAL BEAM TOP BARS IN PAIRS OVER SUPPORTS WITH TOP BARS FROM ADJACENT BEAMS,
- 3. ALL CONCRETE BEAMS OTHER THAN THOSE WITH THE PREFIX TB SHALL BE POURED PRIOR TO PLACING OF BLOCK BELOW.
- 4. ALL TIE BEAM REINFORCING SHALL BE CONTINUOUS THROUGH TIE BEAMS ONLY, ALL SPLICES SHALL BE A MINIMUM OF 30 BAR DIAMETERS,
- 5. ALL TIE BEAM TOP REINFORCING SHALL EXTEND INTO SPAN OF ANY
- ADJACENT STRUCTURAL BEAM AS PER BENDING DIAGRAM.
- 6. DROP BOTTOM OF TIE BEAMS AS REQUIRED AT WINDOW AND DOOR HEADS (28" MAXIMUM) AND ADD 2 \*5 BOTTOM IF DROP EXCEEDS 8".
- 7. TIE BEAM SCHEDULED DEPTHS ARE MINIMUM AND MAY BE INCREASED (8" MAXIMUM) TO FIT BLOCK WORK.
- 8. ALL ADDED LONGITUDINAL BEAM REINFORCING SHALL EXTEND A MINIMUM OF 6" INTO SUPPORT UNLESS NOTED OTHERWISE.
- 9. MARK "C" IN REINFORCING COLUMN BETWEEN TWO BEAMS INDICATES THAT REINFORCING SHALL BE CONTINUOUS THROUGH THESE TWO BEAMS.

HEIGHT 8	& EXPOSURE AD	JUSTMENT COE	EFFICIENTS
FOR BUIL	DING COMPONE		NG
BLDG HEIGHT	EXPOSURE "B"	EXPOSURE "C"	EXPOSURE
15	1.00	1.21	1.47
20	1.00	1.29	1.55
25	1.00	1.35	1.61
30	1.00	1.40	1.66

#### 6 in. o.c. EDGE 7/16 " O.S.B. 10d Ring-Shank 6 in. o.c. FIELD OR 19/32 CDX 1. O.C. . GABILE ENDWALL OR GABLE TRUSS 6 In. o.c. EDGE 6 In. o.c. FIELD

ROOF SHEATHING FASTENINGS

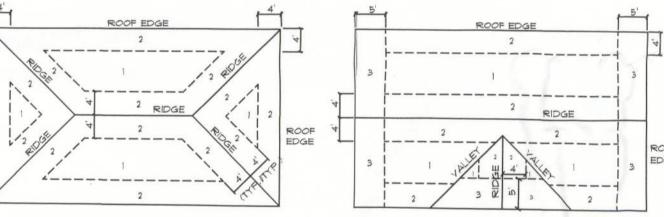

SPACING


6 In. o.c. EDGE

ROOF SHEATHING NAILING ZONES (HIP ROOF)

ROOF SHEATHING NAILING ZONES (GABLE ROOF)



B

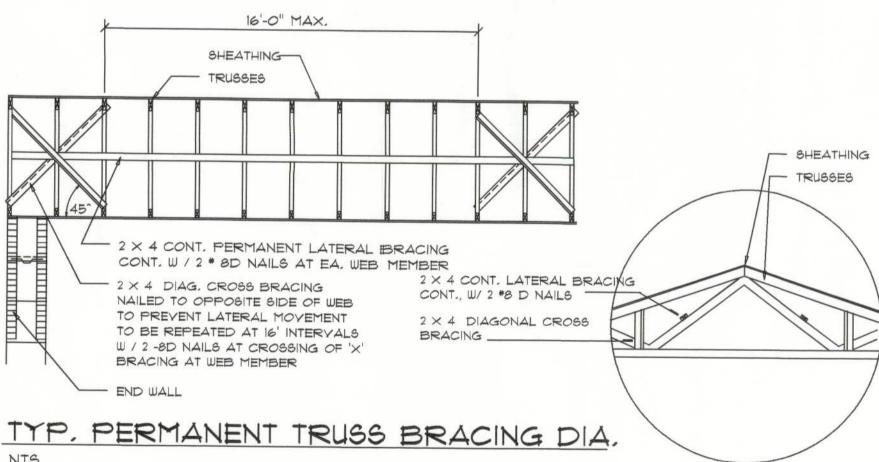

TYP, PERMANENT TRUSS BRACING DIA.

NOTE: ALL WOOD TO BE NUMBER 2 GRADE SOUTHERN YELLOW PINE

Truss Bracing DETAILS

SCALE: AS NOTED



5

7

S

SOFTPLAN

JOB NUMBER 20250122

SHEET NUMBER

OF 4 SHEETS

NOTE: ALL DRAWINGS NOT TO BE SCALED, WRITTEN DIMENSIONS TAKE PRECEDENCE OVER SCALED DIMENSIONS