
SITE PLAN CHECKLIST

- Property Dimensions
- Footprint of proposed and existing structures (including decks), label these with existing addresses
 - Distance from structures to all property lines
 - Location and size of easements 64
- Driveway path and distance at the entrance to the nearest property line (2)
 - Location and distance from any waters; sink holes; wetlands; and etc.
 - Show slopes and or drainage paths 2 7 7 7
 - Arrow showing North direction


SITE PLAN EXAMPLE

Revised 7/1/15

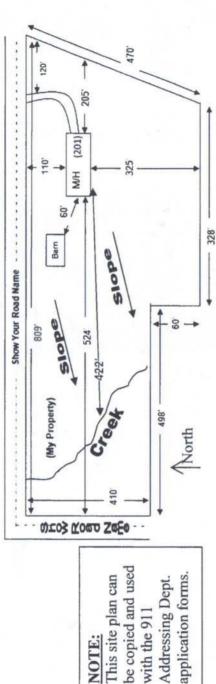

NOTE:

application forms.

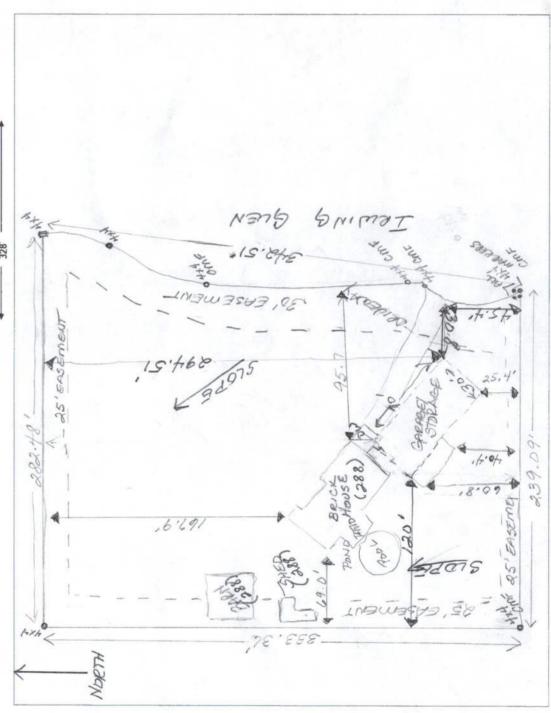

SPECIFIC PURPOSE SURVEY LEGEND P.S.M.=PROFESSIONAL SURVEYOR & MAPPER AT LOT 3, SHERROD SUBDIVISION (AN UNRECORDED SUBDIVISION) LB=LICENSED BUSINESS LS=LICENSED SURVEYOR IN SECTION 2, TOWNSHIP 5 SOUTH, RANGE 16 EAST CMF=CONCRETE MONUMENT FOUND R/W=RIGHT-OF-WAY COLUMBIA COUNTY, FLORIDA Δ=DELTA ANGLE, CENTRAL ANGLE R=RADIUS OF CURVE L=LENGTH OF CURVE CB=CHORD BEARING 4"x4"CMF CD=CHORD DISTANCE NO ID. NO ID=NO IDENTIFICATION (F)=FIELD MEASUREMENT (D)=DEED MEASUREMENT NOTES: 1.) Found monumentation is as shown and designated on the face of the plat. (60'R/W) 2.) The purpose of this survey was to layout a proposed building, and ensure that it is outside of the building setbacks provided to this company. A boundary survey was not done. Only the monumentation needed to provide the building setback lines were located. Said lines based on monumentation found in place, and prior survey by Exacta Land 3.) Bearings based on State Plane Coordinates. IRWING 4.) Interior improvements, pertinent to survey, are shown and were located by field ties. 5.) Date of field survey completion: November 27, 2023 1-STORY BRICK RESIDENCE MS 4"x4"CMF LS 1079 FIELD DATA DEED DATA L=18.69'L=18.69' 4"x4"CMF R=25.00'R=25.00' N 01° 22' 41" W (F) LS 1079 $\Delta = 042^{\circ}50'00''$ Δ=042°49'36" 0.58° (F) 0.4'E, 0.1'S CB=N 19°54'54" E CB=N 21°10'41" E N 00° 14' 19" W (D) CD=18.26' CD = 18.25'0.58' (D) 4"x4"CMF **PROPOSED** FIELD DATA DEED DATA 4"x4"CMF BUILDING -LS 1079 L=83.74 30.8 L=83.38' 0.2'E, 0.3'S R = 50.00'-R=50.00'DETAIL (1''=1')Δ=095°57'48" Δ=095°33'01" CB=N 05°23'13" W CB=N 06°19'47" W CD = 74.29'CD=74.05' NOT VALID WITHOUT THE SIGNATURE AND ORIGINAL RAISED SEAL OF A FLORIDA REGISTERED PROFESSIONAL 25'BUILDING SETBACK LINE 4"x4"CMF LS 1079 N 01° 22' 41" W (F) 0.4'E, 0.1'5 0.58' (F) N 00° 14' 19" W (D) N 88° 04' 08" E (F) 60.21' (F) N 89° 12' 30" E (D) 239.09' (D) 0.58' (D) N 88° 04' 08" E (F) 239.09' (F) 4"x4"CMF LS 1079 LS 1079 0.2'E, 0.3'S James B. Smith, P.S.M. 4"x4"CMF LS 1079 DATE: 11 / 27/2023 REVISIONS SHEET DESCRIPTION DESCRIPTION NORTH FLORIDA PROFESSIONAL SERVICES, INC. JOB NO. L231116G00 CA# 29011 P.O. BOX 3823 2551 BLAIRSTONE PINES DR. KELLY GOODFELLOW LAKE CITY, FL 32056 TALLAHASSEE, FL 32301 PH. 386-752-4675 WWW.NFPS.NFT LIC NO. LB8356