

B. H. H. H.

Mobile Home Permit Worksheet


Installer: ROY M. HARVEY License # 1H11223.97

Address of home being installed: FT. WAVER FL

Manufacturer: DEER VALLEY Length x width: 30' X 76'

NOTE: if home is a single wide fill out one half of the blocking plan
if home is a triple or quad wide sketch in remainder of home
I understand Lateral Arm Systems cannot be used on any home (new or used)
where the sidewall ties exceed 5 ft 4 in.

Installer's initials: RMH

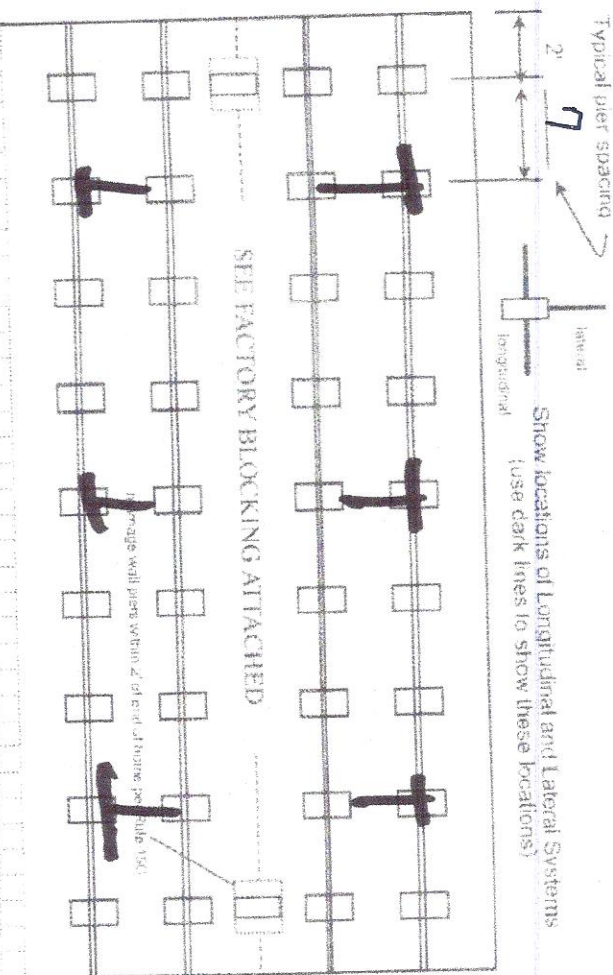

Permit Number: _____ Date: _____

New Home ☒ Used Home ☐

Home installed to the Manufacturer's Installation Manual
Home is installed in accordance with Rule 15-C

Single wide ☐ Wind Zone II ☒ Wind Zone III ☐

Double wide ☒ Installation Decal # _____

Triple/Quad ☐ Serial # _____

PIER SPACING TABLE FOR USED HOMES

Load bearing capacity (sq ft)	Footer size (256)	18 1/2" x 18 1/2" (342)	20" x 20" (400)	22" x 22" (484)	24" x 24" (576)	26" x 26" (676)
1000 psi	3'	4'	5'	6'	7'	8'
1500 psi	4' 6"	6'	7'	8'	9'	10'
2000 psi	6'	8'	9'	10'	11'	12'
2500 psi	7' 6"	9'	10'	11'	12'	13'
3000 psi	8'	10'	11'	12'	13'	14'
3500 psi	8'	10'	11'	12'	13'	14'

Interpolated from Rule 15C-1 pier spacing table.

PIER PAD SIZES

H-beam pier pad size: 17" X 25"
Perimeter pier pad size: 12" X 15"

Other pier pad sizes (required by the mfg.): _____

Draw the approximate locations of marriage wall openings 4 foot or greater. Use this symbol to show the piers.

List all marriage wall openings greater than 4 foot and their pier pad sizes below.

Opening: _____ Pier pad size: _____

POPULAR PAD SIZES

Pad Size	Sq ft
16 x 16	256
16 x 18	288
18.5 x 18.5	342
16 x 22.5	360
17 x 22	374
13 1/4 x 26 1/4	348
20 x 20	400
17 3/16 x 25 3/16	441
17 1/2 x 25 1/2	446
24 x 24	576
26 x 26	676

ANCHORS

4 ft X 5 ft

FRAME TIES

within 2' of end of home spaced at 5' 4" oc

TIEDOWN COMPONENTS

Longitudinal Stabilizing Device (LSD)
Manufacturer: OLIVER TECH
Longitudinal Stabilizing Device w/ Lateral Arms
Manufacturer: OLIVER TECH

Sidewall _____
Longitudinal _____
Marriage wall _____
Shearwall _____

OTHER TIES

Number _____

Mobile Home Permit Worksheet

POCKET PENETROMETER TEST

The pocket penetrometer tests are rounded down to 1500 psi or check here to declare 1000 lb. soil without testing.

☒ 1700 ☒ 1700 ☒ 1700

POCKET PENETROMETER TESTING METHOD

1. Test the perimeter of the home at 6 locations.
2. Take the reading at the depth of the footer.
3. Using 500 lb. increments, take the lowest reading and round down to that increment.

☒ 1700 ☒ 1700 ☒ 1700

TORQUE PROBE TEST

The results of the torque probe test is 285 inch pounds or check here if you are declaring 5' anchors without testing. A test showing 275 inch pounds or less will require 5 foot anchors.

Note: A state approved lateral arm system is being used and 4 ft. anchors are allowed at the sidewall locations. I understand 5 ft. anchors are required at all centerline tie points where the torque test reading is 275 or less and where the mobile home manufacturer may require anchors with 4000 lb. holding capacity.

Installer's initials

ALL TESTS MUST BE PERFORMED BY A LICENSED INSTALLER

Installer Name

ROY M. HARVEY

Date Tested

2-12-21

Electrical

Connect electrical conductors between multi-wide units, but not to the main power source. This includes the bonding wire between multi-wide units. Pg. 7.9

Plumbing

Connect all sewer drains to an existing sewer tap or septic tank. Pg. 7.9

Connect all potable water supply piping to an existing water meter, water tap, or other independent water supply systems. Pg. 7.9

Department of Growth Management
Building Division

Permit Number:

Date: 2-17-21

Site Preparation

Debris and organic material removed ☒ YES
Water drainage: Natural Swale ☒ Pad Other

Fastening multi wide units

Floor: Type Fastener: LAGS Length: 6" Spacing: 16" o/c
Walls: Type Fastener: NAILS Length: 3" Spacing: 6" o/c
Roof: Type Fastener: Length: Spacing: FULL ROOF CAP
For used homes a min. 30 gauge, 8" wide, galvanized metal strip will be centered over the peak of the roof and fastened with galv. roofing nails at 2" on center on both sides of the centerline.

Gasket (weatherproofing requirement)

I understand a properly installed gasket is a requirement of all new and used homes and that condensation, mold, mildew and buckled mamage walls are a result of a poorly installed or no gasket being installed. I understand a strip of tape will not serve as a gasket.

Installer's initials

RMH

Type gasket: FOAM
Pg. FACTORY INSTALLED

Installed:
Between Floors: Yes ☒
Between Walls: Yes ☒
Bottom of ridgebeam: Yes ☒

Weatherproofing

The bottomboard will be repaired and/or taped. Yes ☒ Pg. 9.8
Siding on units is installed to manufacturer's specifications. Yes
Fireplace chimney installed so as not to allow intrusion of rain water. Yes

Miscellaneous

Skirting to be installed. Yes ☒ No ☒
Dryer vent installed outside of skirting. Yes ☒ N/A
Range downflow vent installed outside of skirting. Yes ☒ N/A
Drain lines supported at 4 foot intervals. Yes ☒
Electrical crossovers protected. Yes ☒
Other:

Installer verifies all information given with this permit worksheet is accurate and true based on the manufacturer's installation instructions and or Rule 15C-1 & 2


Installer Signature

Date 2-17-21

[illegible]


WOOLBLENDED HOSENESS
A HUGOBOS CLOTHING COMPANY, INC.
RODINEE, WVL. 4870 SP²
SERIAL: L-4-80038

1

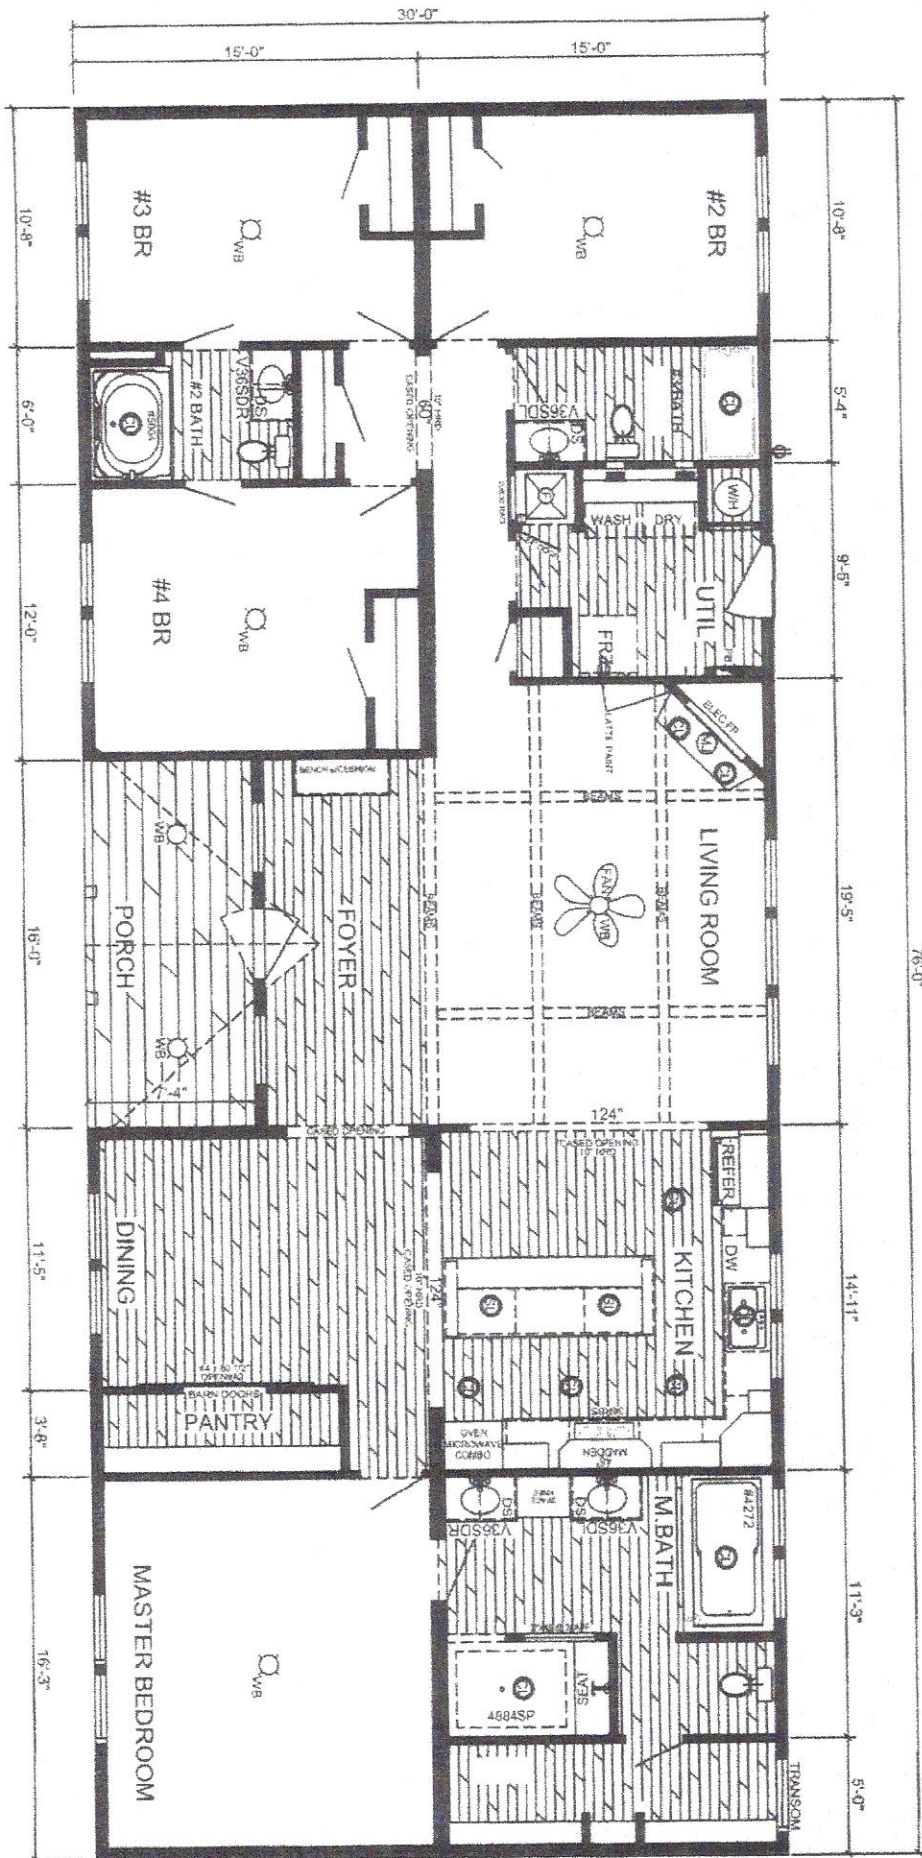

2260

MODEL: ELVIS756(WL-8410)
4-BEDROOM / 3-BATH
 32 x 80 - Approx. 2280 Sq. Ft.



DEER VALLEY HOMEBUILDERS, INC.
 Woodland Homes Series

For more information visit us at
www.deervalleyhb.com

DATE:
 01/30/2020

All room dimensions include closets and square footage are approximate. Drawing layout subject to change if required by engineering review.

Drawn By:

B. CROW