

20w

PERMIT NUMBER

PERMIT WORKSHEET

Installer Ernest S. Johnson License # 1H1625249
Installer Mobile Phone # 352.494.8099
Address of home being installed 335 SE Graham Cr
Lakeview Pl 3




Manufacturer Clayton Length x width 48 x 28

NOTE: If home is a single wide fill out one half of the blocking plan
If home is a triple or quad wide sketch in remainder of home

I understand Lateral Arm Systems cannot be used on any home (new or used)
where the sidewall ties exceed 5 ft 4 in.

Installer's initials

[Signature]

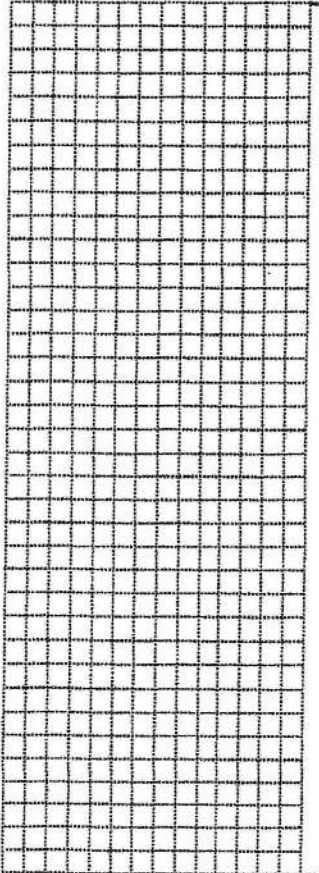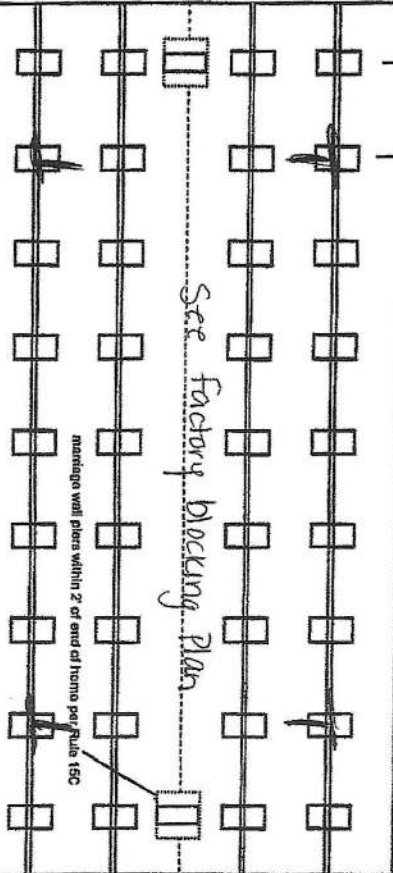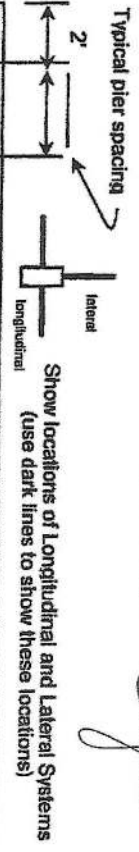

New Home ☒ Used Home ☐
Home installed to the Manufacturer's Installation Manual ☒
Home is installed in accordance with Rule 15-C ☐
Single wide ☐ Wind Zone II ☒ Wind Zone III ☐
Double wide ☒ Installation Decal # 108826
Triple/Quad ☐ Serial # F261-000-41-A105749AB

PIER SPACING TABLE FOR USED HOMES

Load bearing capacity (sq in)	16' x 16' (256)	18 1/2" x 18 (342)	20' x 20" (400)	22' x 22" (484)	24' x 24" (576)	26' x 26" (676)
1000 dsf	3'	4'	5'	6'	7'	8'
1500 dsf	4'	5'	6'	7'	8'	9'
2000 dsf	5'	6'	7'	8'	9'	10'
2500 dsf	6'	7'	8'	9'	10'	11'
3000 dsf	7'	8'	9'	10'	11'	12'
3500 dsf	8'	9'	10'	11'	12'	13'

PIER PAD SIZES

I-beam pier pad size 23x31
Olive 1055-11 adustable
Perimeter pier pad size or 17.5 x 25.5
Other pier pad sizes OUT 4.78" bars
(required by the mfg.)

Draw the approximate locations of marriage wall openings 4 foot or greater. Use this symbol to show the piers.

List all marriage wall openings greater than 4 foot and their pier pad sizes below.

Opening Sec Pier pad size

factory blocking
Plan

TIEDOWN COMPONENTS

Longitudinal Stabilizing Device (LSD)
Manufacturer Oliver 1101 v
Longitudinal Stabilizing Device w/ Lateral Arms
Manufacturer

OTHER TIES

Number
Sidewall 24
Longitudinal 8
Marriage wall 8
Shearwall 2

FRAME TIES

within 2' of end of home spaced at 5' 4" oc

ANCHORS

Pad Size	Sq In
16 x 16	256
16 x 18	288
18.5 x 18.5	342
16 x 22.5	360
17 x 22	374
13 1/4 x 26 1/4	348
20 x 20	400
17 3/16 x 25 3/16	441
17 1/2 x 25 1/2	446
24 x 24	576
26 x 26	676

PERMIT WORKSHEET

Page 2 of 2

The pocket penetrometer tests are rounded down to or check here to declare 1000 lb. soil ☒ without testing

with your facility.

POCKET PENETROMETER TESTING METHOD

1. Test the perimeter of the home at 6 locations.
2. Take the reading at the depth of the footer.
3. Using 500 lb. increments, take the lowest reading and round down to that increment.

TORQUE PROBE TEST

The results of the torque probe test is _____ inch pounds or check here if you are declaring 5" anchors without testing _____. A test showing 275 inch pounds or less will require 5 fofl anchors.

A state approved lateral arm system is being used and 4 ft. anchors are allowed at the sidewall locations. I understand 5 ft anchors are required at all centerline tie points where the torque test reading is 275 or less and where the mobile home manufacturer may require anchors with 4000 lb. pulling capacity.

Installer's initials

ALL TESTS MUST BE PERFORMED BY A LICENSED INSTALLER

Installer Name

Ernest S Johnson

Date Tested

Assumed under 161V 1.525 4.5'

Authors

Electrical

Connect electrical conductors between multi-wide units, but not to the main power source. This includes the bonding wire between multi-wide units. Pa

Purmbino

Connect all sewer drains to an existing sewer tap or septic tank. Pg.

Connect all potable water supply piping to an existing water meter, water tap, or other independent water supply systems. Pg.

Silo Preparation

Debris and organic material removed	Swale	Pad	Other
Water drainage: Natural			

Fastening multi wide units

Floor:	Type Fastener:	Length:	Spacing:
Walls:	Type Fastener:	Length:	Spacing:
Roof:	Type Fastener:	Length:	Spacing:

For used homes a mid-30 gauge, 8" wide, galvanized metal strip will be centered over the peak of the roof and fastened with galv. roofing nails at 2" on center on both sides of the centerline.

Gasket (weatherproofing requirement)

I understand a properly installed gasket is a requirement of all new and used homes and that condensation, mold, mildew and buckled marriage walls are a result of a poorly installed or no gasket being installed. I understand a strip of tape will not serve as a gasket.

Installer's initials

Installed:

Type gasket 211
Pg. ~~10~~ 62

Between Floors Yes ☒
Between Walls Yes ☒
Bottom of ridgebeam Yes ☒

Weatherproofing

The bottomboard will be repaired and/or taped. Yes ☒ Pg. 1
Siding on units is installed to manufacturer's specifications. Yes ☒
Eireplace chimney installed so as not to allow intrusion of rain water. Yes ☒

Miscellaneous

Skirting to be installed. Yes ☒ No ☐

Dryer vent installed outside of skirting. Yes ☒ N/A ☐

Drain lines supported at 4 foot intervals. Yes ☒ N/A

Electrical crossovers protected. Yes

Other:

installer verifies all information given with this permit worksheet is accurate and true based on the manufacturer's installation instructions and or Rule 15C-1.2.3

Installer Signature *C. J. M. T. X. N.* Date *2/2*

Installer Signature Justin A. Van Date 2/28/2024

[illegible]

SIDEWALL OPENING PIER LOAD 26' BOX WIDTH	SIDEWALL OPENING (FT) RATED (N/A) (N/A) (N/A)				
	3	4	5	6	8
1175	1330	1485	1640	1950	2260

 
GENERAL NOTES:
1. PIER LOADS SHOWN ARE TO BE USED TO SIZE THE FOOTINGS BELOW
2. ALL MAJOR STRUCTURAL LOADS SHALL BE SUPPORTED BY PIER. REFER TO TABLES

2. REFER TO TABLE 9 FOR PIER CONFIGURATION AND MAXIMUM ALLOWABLE HEIGHTS. CROSS REFERENCE THE PIER HEIGHT WITH THE MAXIMUM ALLOWABLE FLOOR HEIGHT LISTED IN THE FRAME TIEOWN.
3. 1.1 W/TS (TABLE 18, 19, AND 20).
4. FLOOR WIDTH SPACING IS FOR STANDARD PRODUCT ONLY. CONTACT THE MFG. PLAC FOR CALCULATIONS FOR OPTIONS OR HIEAT.
5. SERVICE DRIP LOCATIONS IDENTIFIED ARE APPROXIMATE.
6. THE MAXIMUM SPACING FOR FRAME SUPPORT PIERS IS 10'-0" BEHINDS.
7. 15'-0" FEET TO 4'-0" FEET FOR 455-A, 456-A, 457-A.

- ☐ E = ELECTRICAL DROP
- ☐ W = WATER INLET
- ☐ D = DRY PLUMBING DROPS
- ☐ G = GAS INLET

20 ml Root-Less Seed				30 ml Root-Less Seed				40 ml Root-Less Seed			
Column	Distance	Pier-Land		Column	Distance	Pier-Land		Column	Distance	Pier-Land	
Pier #	From Hatch	(lbs)		Pier #	From Hatch	(lbs)		Pier #	From Hatch	(lbs)	
1	12.313	3700		1	12.313	3853		1	12.313	7217	
2	29.042	3700		2	29.042	3853		2	29.042	7217	

[illegible]

ORDER NO. DESOTO PROJECT NO. CEJ28483AH ORDER DATE 8/19/2021 ORDERED BY Alex Vintaley ORDER DATE 4/15/2020 ORDERED BY 3/16=1 ORDERED BY CEJ-ABD-048-3 ORDERED BY PIERS 55.5 ORDER NO. SU-1	SUPPLIER DATE ORDER NO. ORDER DATE 1 264	
--	--	---