

COLUMBIA COUNTY PERMIT WORKSHEET

These worksheets must be completed and signed by the installer. Submit the originals with the packet.

Installer RONNIE NORRIS License # ZH1025145/1


911 Address where home is being installed _____

Manufacturer Live On It Length x width 36x70 72x32

NOTE: if home is a single wide fill out one half of the blocking plan if home is a triple or quad wide sketch in remainder of home

I understand Lateral Arm Systems cannot be used on any home (new or used) where the sidewall ties exceed 5 ft 4 in.

Installer's initials RN

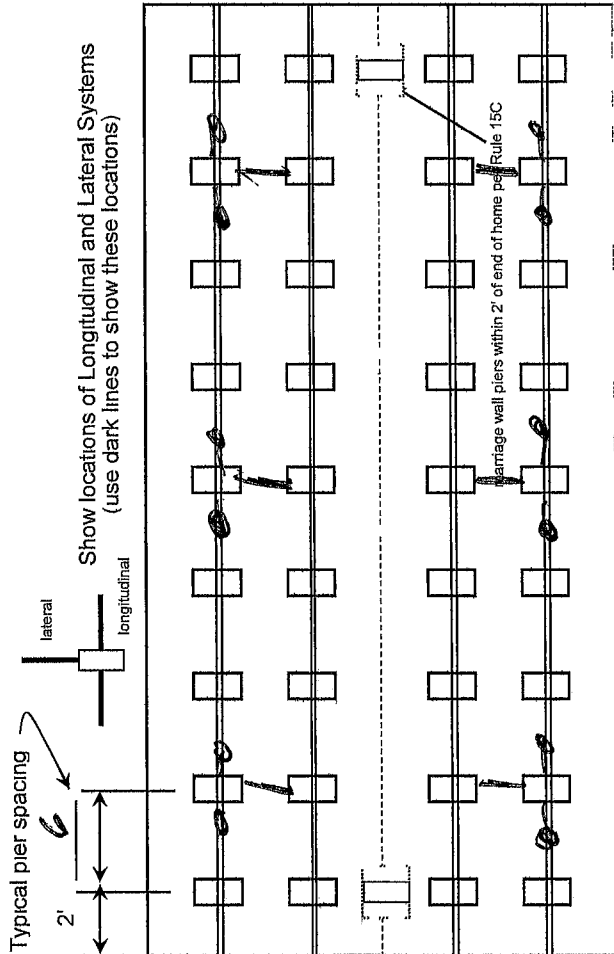

New Home Used Home

Home installed to the Manufacturer's Installation Manual

Home is installed in accordance with Rule 15-C

Single wide Wind Zone II Wind Zone III

Double wide Installation Decal # 19707

Triple/Quad Serial # _____

PIER SPACING TABLE FOR USED HOMES

Load bearing capacity	Footer size (sq in)	16" x 16" (256)	18 1/2" x 18 1/2" (342)	20" x 20" (400)	22" x 22" (484)*	24" X 24" (576)*	26" x 26" (676)
1000 dsf	3'		4'	5'	6'	7'	8'
1500 dsf	4.6"		6'	7'	8'	8'	8'
2000 dsf	6"		8'	8'	8'	8'	8'
2500 dsf	7.6"		8'	8'	8'	8'	8'
3000 dsf	8'		8'	8'	8'	8'	8'
3500 dsf	8'		8'	8'	8'	8'	8'

* interpolated from Rule 15C-1 pier spacing table.

PIER PAD SIZES

I-beam pier pad size 17x25

Perimeter pier pad size NA

Other pier pad sizes (required by the mfg) 6x16

POPULAR PAD SIZES

Pad Size	Sq In
16" X 16"	256
18.5" X 18.5"	288
16" X 22.5"	360
17" X 22"	374
13 1/4" X 26 1/4"	348
20" X 20"	400
17 3/16" X 25 3/16"	441
17 1/2" X 25 1/2"	446
24" X 24"	576
26" X 26"	676

Draw the approximate locations of marriage wall openings 4 foot or greater. Use this symbol to show the piers.

List all marriage wall openings greater than 4 foot and their pier pad sizes below.

Opening Pier pad size

8 17x25

4 6x16

4 6x16

TIEDOWN COMPONENTS

Longitudinal Stabilizing Device (LSD)
 Manufacturer _____
 Longitudinal Stabilizing Device w/ Lateral Arms
 Manufacturer _____

43

ANCHORS

4 ft 5 ft

FRAME TIES

within 2' of end of home spaced at 5' 4" oc

OTHER TIES

Number
 Sidewall 2
 Longitudinal 2
 Marriage wall 2
 Shearwall 2

43

POCKET PENETROMETER TEST

The pocket penetrometer tests are rounded down to 1500 psf or check here to declare 1000 lb soil without testing.

x 1500 x 1500 x 1500

POCKET PENETROMETER TESTING METHOD

- Test the penmeter of the home at 6 locations
- Take the reading at the depth of the footer.
- Using 500 lb. increments, take the lowest reading and round down to that increment.

x 1500 x 1500 x 1500

TORQUE PROBE TEST

The results of the torque probe test is 275 inch pounds or check here if you are declaring 5' anchors without testing 275. A test showing 275 inch pounds or less will require 5 foot anchors.

Note: A state approved lateral arm system is being used and 4 ft. anchors are allowed at the sidewall locations. I understand 5 ft anchors are required at all centerline tie points where the torque test reading is 275 or less and where the mobile home manufacturer may require anchors with 4000 lb. holding capacity.

AW Installer's initials

ALL TESTS MUST BE PERFORMED BY A LICENSED INSTALLER

Installer Name James [Signature]

Date Tested 2-27-019

Site Preparation

Debris and organic material removed Swale Pad Other

Water drainage Natural Swale Pad Other

Fastening multi wide units

Floor	Type Fastener	Length	Spacing
Walls	Type Fastener	Length	Spacing
Roof	Type Fastener	Length	Spacing

For used homes a min. 30 gauge, 8" wide, galvanized metal strip will be centered over the peak of the roof and fastened with galv. roofing nails at 2" on center on both sides of the centerline

Gasket (weatherproofing requirements)

I understand a properly installed gasket is a requirement of all new and used homes and that condensation, mold, mildew and buckled marriage walls are a result of a poorly installed or no gasket being installed. I understand a strip of tape will not serve as a gasket.

Installer's initials AW

Type gasket AW Installed.

Between Floors Yes No

Between Walls Yes No

Bottom of ridgebeam Yes No

Weatherproofing

The bottomboard will be repaired and/or taped Yes No

Siding on units is installed to manufacturer's specifications. Yes No

Fireplace chimney installed so as not to allow intrusion of rain water Yes No

Miscellaneous

Skirting to be installed. Yes No

Dryer vent installed outside of skirting Yes No N/A

Range downflow vent installed outside of skirting Yes No N/A

Drain lines supported at 4 foot intervals. Yes No

Electrical crossovers protected. Yes No

Other _____

Electrical

Connect electrical conductors between multi-wide units, but not to the main power source. This includes the bonding wire between multi-wide units. Pg. _____

Plumbing

Connect all sewer drains to an existing sewer tap or septic tank. Pg. _____

Connect all potable water supply piping to an existing water meter, water tap, or other independent water supply systems Pg. _____

Installer verifies all information given with this permit worksheet is accurate and true based on the

Installer Signature [Signature] Date _____