


14 HEAVY 1 FLOOR
 194 SW CLINT WAY
 LAKE CITY FL
 Parcel # 29-58-17-09449-215

32x60

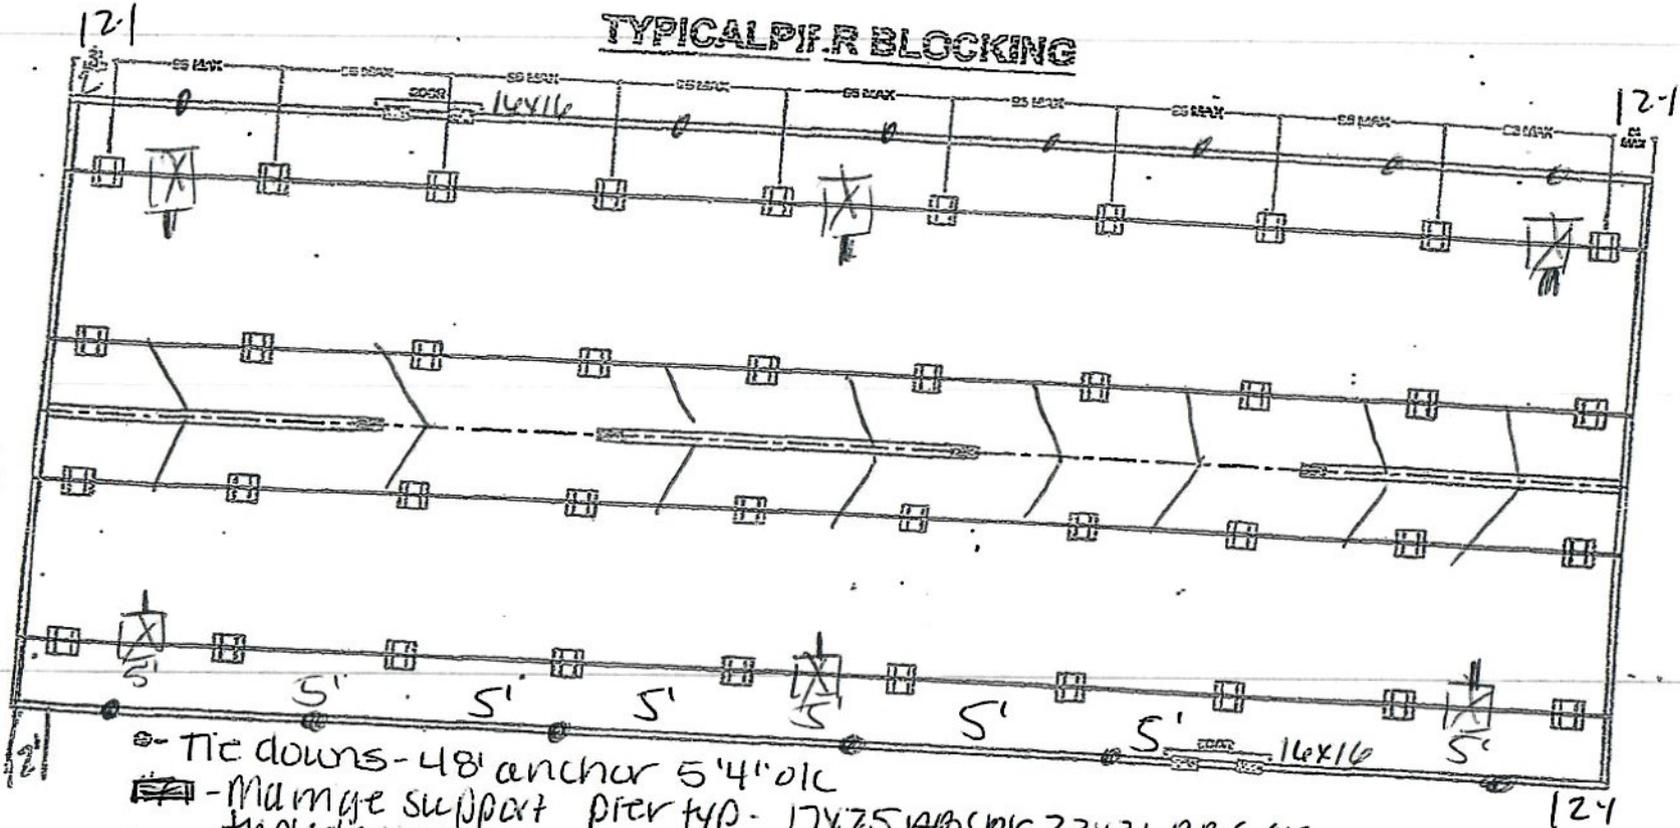

- Tie downs - 48" anchor 5'4" o/c
- ▣ - Main support pier typ - 17x25 ABS or 23x31 ABS or triple stacked 17x25 ABS
- ▢ - Support Pier typ - 17x25 ABS w/ 6x6x16 5' o/c
- ⊠ - Oliver System
- ⋈ - Double Frame Tie - 48" anchor 5' from end then 12' o/c
- ⋈ - Perimeter doors 16x16
- * All centerline / shearwall anchors 60'



Mobile Home Permit Worksheet

POCKET PENETROMETER TEST

The pocket penetrometer tests are rounded down to _____ psf or check here to declare 1000 lb. soil X without testing.

x 1000 x 1000 x 1000

POCKET PENETROMETER TESTING METHOD

1. Test the perimeter of the home at 6 locations.
2. Take the reading at the depth of the footer.
3. Using 500 lb. increments, take the lowest reading and round down to that increment.

x 1000 x 1000 x 1000

TORQUE PROBE TEST

The results of the torque probe test is N/A inch pounds or check here if you are declaring 5' anchors without testing _____. A test showing 275 inch pounds or less will require 5' anchors.

Note: A state approved lateral arm system is being used and 4 ft. anchors are allowed at the sidewall locations. I understand 5' anchors are required at all centerline tie points where the torque test reading is 275 or less and where the mobile home manufacturer may require anchors with 4000 lb. holding capacity.

Installer's initials WRT

ALL TESTS MUST BE PERFORMED BY A LICENSED INSTALLER

Installer Name N/A

Date Tested N/A

ELECTRICAL

Connect electrical conductors between multi-wide units, but not to the main power source. This includes the bonding wire between multi-wide units. Pg. 15a

PLUMBING

Connect all sewer drains to an existing sewer tap or septic tank. Pg. 15b

Connect all potable water supply piping to an existing water meter, water tap, or other independent water supply systems. Pg. 15c

Permit Number: _____

Date: _____

Site Preparation

Debris and organic material removed 90% to 4/25
Water drainage: Natural _____ Swale _____ Pad X Other _____

Fastening multi wide units

Floor- Type Fastener: LAGS Length: _____ Spacing: 2'-18" cont
Walls- Type Fastener: LAGS Length: _____ Spacing: 2'-18" cont
Roof- Type Fastener: 1/2" GALV NAILS Length: _____ Spacing: 12" - cont'

For used homes a min. 30 gauge, 8" wide, galvanized metal strip will be centered over the peak of the roof and fastened with galv. roofing nails at 2" on center on both sides of the centerline.

Gasket (weatherproofing requirement)

I understand a properly installed gasket is a requirement of all new and used homes and that condensation, mold, mildew and buckled marriage walls are a result of a poorly installed or no gasket being installed. I understand a strip of tape will not serve as a gasket.

Installer's initials WRT

Type gasket EDAM
Pg. #3

Installed:
Between Floors ----- Yes
Between Walls ----- Yes
Bottom of ridge beam ----- Yes

Weatherproofing

The bottom board will be repaired and/or taped. ----- Yes Pg. N/A
Siding on units is installed to manufacturer's specifications. ----- Yes
Fireplace chimney installed so as not to allow intrusion of rain water. ----- Yes

Miscellaneous

Skirting to be installed. ----- Yes No _____ N/A _____
Dryer vent installed outside of skirting. ----- Yes No _____ N/A _____
Range downflow vent installed outside of skirting. ----- Yes No _____ N/A _____
Drain lines supported at 4' intervals. ----- Yes No _____ N/A _____
Electrical crossovers protected. ----- Yes No _____ N/A _____
Other: _____

Installer verifies all information given with this permit worksheet is accurate and true based on the manufacturer's installation instructions and or Rule 15C-1 & 2

Installer's Signature WRT

Date 11/1/25





Mobile Home Permit Worksheet


Installer: William Price License # 117-1041936
 Address of home being installed: 194 SW Clint + 1000
Lake City FL
 Manufacturer: Champ. Length x width: 60x32

NOTE: If home is a single wide fill out one half of the blocking plan
 If home is a triple or quad wide sketch in remainder of home
 I understand Lateral Arm Systems cannot be used on any home (new or used)
 where the sidewall ties exceed 5 ft 4 in.

Installer's initials: WPA

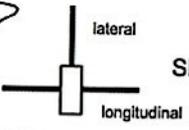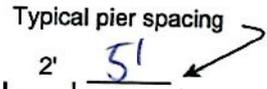

Show locations of Longitudinal and Lateral Systems (use dark lines to show these locations)

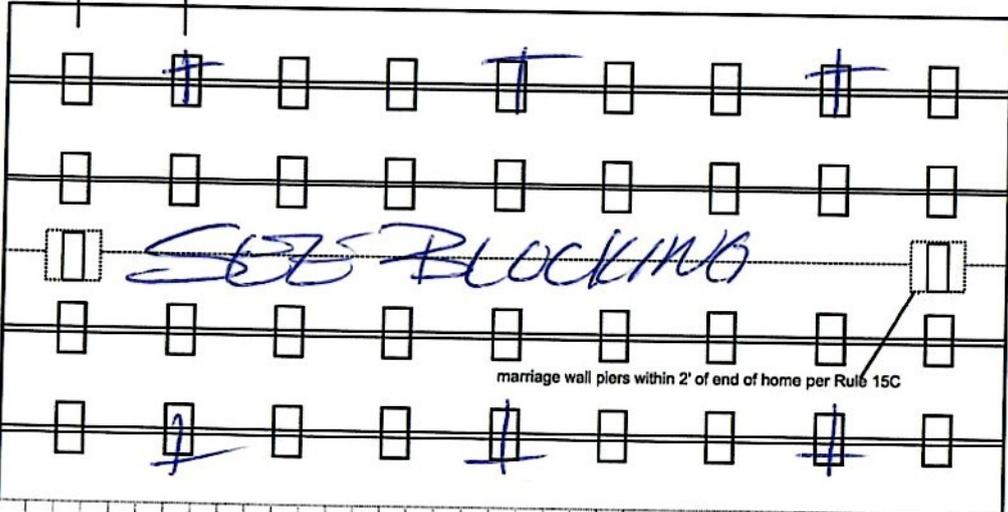

marriage wall piers within 2' of end of home per Rule 15C



Permit Number: _____ Date: _____
 New Home Used Home
 Home installed to the Manufacturer's Installation Manual
 Home is installed in accordance with Rule 15-C
 Single wide Wind Zone II Wind Zone III
 Double wide Installation Decal # 110254
 Triple/Quad Serial # FL26100PH13200815AB

PIER SPACING TABLE FOR USED HOMES

Load bearing capacity	Footer size (sq in)	16" x 16" (256)	18 1/2" x 18 1/2" (342)	20" x 20" (400)	22" x 22" (484)*	24" X 24" (576)*	26" x 26" (676)
1000 psf		3'	4'	5'	6'	7'	8'
1500 psf		4'6"	6'	7'	8'	8'	8'
2000 psf		6'	8'	8'	8'	8'	8'
2500 psf		7'6"	8'	8'	8'	8'	8'
3000 psf		8'	8'	8'	8'	8'	8'
3500 psf		8'	8'	8'	8'	8'	8'

*interpolated from Rule 15C-1 pier spacing table.

PIER PAD SIZES

I-beam pier pad size: 17x25
 Perimeter pier pad size: 16x16
 Other pier pad sizes (required by the mfg.): _____

Draw the approximate locations of marriage wall openings 4 foot or greater. Use this symbol to show the piers.

List all marriage wall openings greater than 4 foot and their pier pad sizes below.

Opening	Pier pad size
<u>large</u>	<u>73x31</u>

POPULAR PAD SIZES

Pad Size	Sq In
16 x 16	256
16 x 18	288
18.5 x 18.5	342
16 x 22.5	360
17 x 22	374
13 1/4 x 26 1/4	348
20 x 20	400
17 3/16 x 25 3/16	441
17 1/2 x 25 1/2	446
24 x 24	576
26 x 26	676

4 ft 25 5 ft _____

ANCHORS

FRAME TIES

within 2' of end of home spaced at 5' 4" oc

OTHER TIES

TIEDOWN COMPONENTS

Longitudinal Stabilizing Device (LSD)
 Manufacturer: _____
 Longitudinal Stabilizing Device w/ Lateral Arms
 Manufacturer: _____

	Number
Sidewall	<u>17</u>
Longitudinal	<u>16</u>
Marriage Wall	<u>2</u>
Shear Wall	<u>2</u>