

DATE 10/28/2005

Columbia County Building Permit

PERMIT

This Permit Expires One Year From the Date of Issue

000023793

APPLICANT RANDY BURNHAM PHONE 752-6299
ADDRESS 155 NW ORBISON DR LAKE CITY FL 32055
OWNER RANDY BURNHAM PHONE 752-6299
ADDRESS 361 NW WHITLEY GLEN LAKE CITY FL 32055
CONTRACTOR BERNIE THRIFT PHONE 623-0046
LOCATION OF PROPERTY 441N, TL ON WHITLEY GLEN, AT THE DEAD END,STRAIGHT IN

TYPE DEVELOPMENT MH,UTILITY ESTIMATED COST OF CONSTRUCTION .00
HEATED FLOOR AREA TOTAL AREA HEIGHT .00 STORIES
FOUNDATION WALLS ROOF PITCH FLOOR
LAND USE & ZONING RSF/MH2 MAX. HEIGHT
Minimum Set Back Requirments: STREET-FRONT 25.00 REAR 15.00 SIDE 10.00
NO. EX.D.U. 0 FLOOD ZONE X SP DEVELOPMENT PERMIT NO.

PARCEL ID 05-3S-17-04853-109 SUBDIVISION ANDERSON ACRES
LOT 9 BLOCK PHASE UNIT TOTAL ACRES

IH0000075
Culvert Permit No. Culvert Waiver Contractor's License Number Applicant/Owner/Contractor
EXISTING 05-1112EX BK JH Y
Driveway Connection Septic Tank Number LU & Zoning checked by Approved for Issuance New Resident

COMMENTS: 1ST FLOOR ELEVATION TO BE 181',ELEVATION LETTER NEEDED BEFORE POWER

Check # or Cash 1674

FOR BUILDING & ZONING DEPARTMENT ONLY

(footer/Slab)

Temporary Power Foundation Monolithic
date/app. by date/app. by date/app. by
Under slab rough-in plumbing Slab Sheathing/Nailing
date/app. by date/app. by date/app. by
Framing Rough-in plumbing above slab and below wood floor
date/app. by date/app. by
Electrical rough-in Heat & Air Duct Peri. beam (Lintel)
date/app. by date/app. by date/app. by
Permanent power C.O. Final Culvert
date/app. by date/app. by date/app. by
M/H tie downs, blocking, electricity and plumbing Pool
date/app. by date/app. by
Reconnection Pump pole Utility Pole
date/app. by date/app. by date/app. by
M/H Pole Travel Trailer Re-roof
date/app. by date/app. by date/app. by

BUILDING PERMIT FEE \$.00 CERTIFICATION FEE \$.00 SURCHARGE FEE \$.00
MISC. FEES \$ 200.00 ZONING CERT. FEE \$ 50.00 FIRE FEE \$.00 WASTE FEE \$
FLOOD DEVELOPMENT FEE \$ FLOOD ZONE FEE \$ 25.00 CULVERT FEE \$ TOTAL FEE 275.00
INSPECTORS OFFICE CLERKS OFFICE

NOTICE: IN ADDITION TO THE REQUIREMENTS OF THIS PERMIT, THERE MAY BE ADDITIONAL RESTRICTIONS APPLICABLE TO THIS PROPERTY THAT MAY BE FOUND IN THE PUBLIC RECORDS OF THIS COUNTY. AND THERE MAY BE ADDITIONAL PERMITS REQUIRED FROM OTHER GOVERNMENTAL ENTITIES SUCH AS WATER MANAGEMENT DISTRICTS, STATE AGENCIES, OR FEDERAL AGENCIES.

"WARNING TO OWNER: YOUR FAILURE TO RECORD A NOTICE OF COMMENCEMENT MAY RESULT IN YOUR PAYING TWICE FOR IMPROVEMENTS TO YOUR PROPERTY. IF YOU INTEND TO OBTAIN FINANCING, CONSULT WITH YOUR LENDER OR AN ATTORNEY BEFORE RECORDING YOUR NOTICE OF COMMENCEMENT."

This Permit Must Be Prominently Posted on Premises During Construction

PLEASE NOTIFY THE COLUMBIA COUNTY BUILDING DEPARTMENT AT LEAST 24 HOURS IN ADVANCE OF EACH INSPECTION, IN ORDER THAT IT MAY BE MADE WITHOUT DELAY OR INCONVIENCE, PHONE 758-1008. THIS PERMIT IS NOT VALID UNLESS THE WORK AUTHORIZED BY IT IS COMMENCED WITHIN 6 MONTHS AFTER ISSUANCE.


The Issuance of this Permit Does Not Waive Compliance by Permittee with Deed Restrictions.

PERMIT APPLICATION / MANUFACTURED HOME INSTALLATION APPLICATION CK# 1674


For Office Use Only		Zoning Official <u>RLK 28.10.15</u>		Building Official <u>OK JTH 10-28</u>	
AP# <u>0510-87</u>	Date Received <u>10-28-05</u>	By <u>G</u>	Permit # <u>23793</u>		
Flood Zone <u>X 5P</u>	Development Permit _____	Zoning <u>RSMH2</u>	Land Use Plan Map Category _____		
Comments <u>1st Floor to be 181' Det Plat, Elevation letter before power</u>					
FEMA Map # _____	Elevation _____	Finished Floor _____	River _____	In Floodway _____	
☒ Site Plan with Setbacks shown ☒ Environmental Health Signed Site Plan ☐ Env. Health Release ☐ Well letter provided ☒ Existing Well					
Revised 9-23-04					

- Property ID 05-35-17-04853-109 Must have a copy of the property deed
- New Mobile Home _____ Used Mobile Home ☒ Year 1998
- Subdivision Information ANDERSON ACRES LOT #9
- Applicant RANDY BURNHAM Phone # (386) 752-6299
- Address 155 NW ORBISON DR.
- Name of Property Owner RANDY BURNHAM Phone# 386-752-6299
- 911 Address 361 NW Whitley Glen, LAKE CITY FL 32055
- Circle the correct power company - FL Power & Light - Clay Electric
 (Circle One) - Suwannee Valley Electric - Progressive Energy
- Name of Owner of Mobile Home RANDY BURNHAM Phone # 752-6299
- Address 155 NW ORBISON DR.
- Relationship to Property Owner Same
- Current Number of Dwellings on Property 0
- Lot Size _____ Total Acreage .69
- Do you : Have an Existing Drive or need a Culvert Permit or a Culvert Waiver Permit
- Driving Directions 441 N. 1/2 mile North of I-10 TURN Left on whitley Glen. AT The Dead End - straight in.
- Is this Mobile Home Replacing an Existing Mobile Home No
- Name of Licensed Dealer/Installer Bernie Thrift Phone # 623 0046
- Installers Address 212 NW NYE Hunterdr Lake City 32055
- License Number JH0000075 Installation Decal # 257809

SITE PLAN EXAMPLE / WORKSHEET

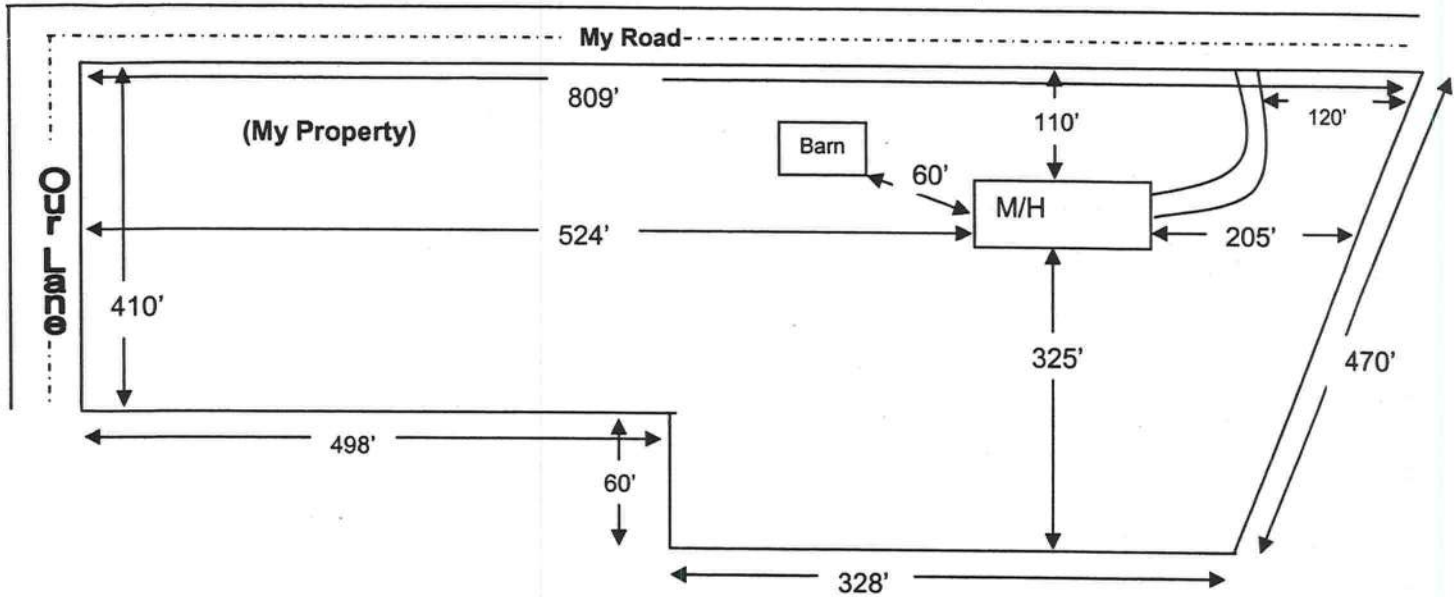

Use this example to draw your own site plan. Show all existing buildings and any other homes on this property and show the distances between them, Also show where the roads or roads are around the property. This site plan can also be used for the 911 Addressing department if you include the distance from the driveway to the nearest property line.

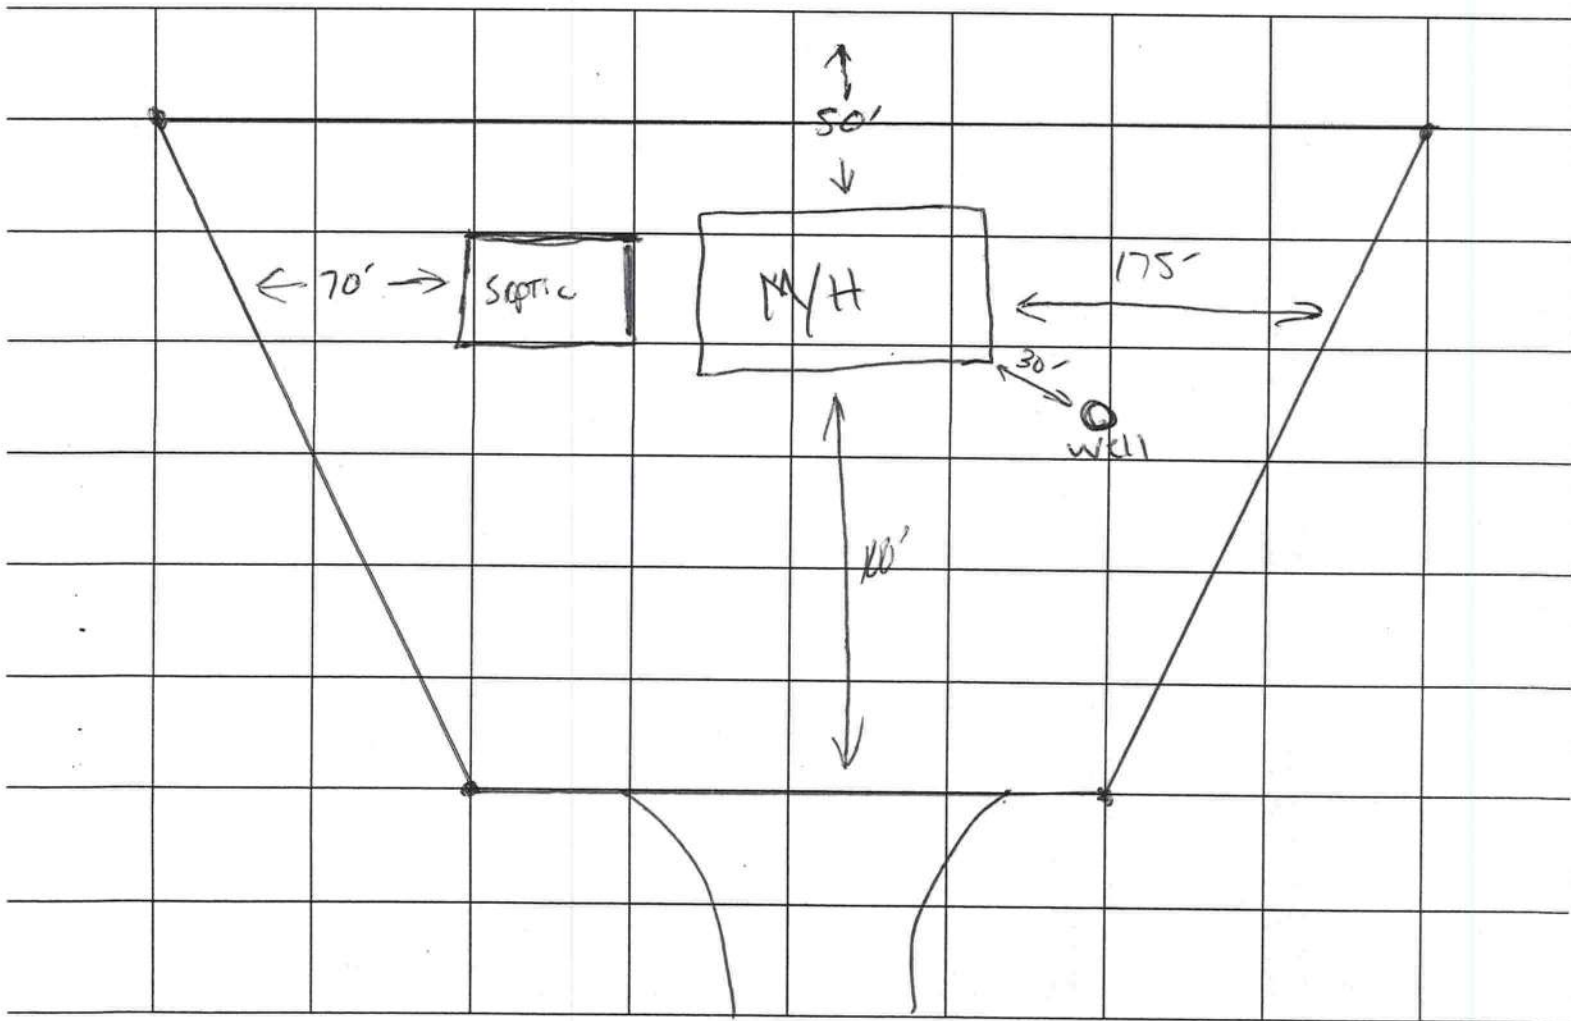

STATE OF FLORIDA
COUNTY OF COLUMBIA

AFFIDAVIT

This is to certify that I, (We), SUBRANDY LIMITED PARTNERSHIP as the
seller, by an Agreement for Deed, of the below described property:

Tax Parcel No. R04853-10ASubdivision (Name, lot, Block, Phase) ANDERSON ACRES LOT 9Give my permission for RANDALL BURNHAM to place a
(Mobile Home / Travel Trailer / Single Family Home)

I (We) understand that this could result in an assessment for solid waste and fire
protection services levied on this property.

[Signature]
(1) Seller Signature
LIMITED PARTNER
SUBRANDY LTD

(2) Seller Signature

Sworn to and subscribed before me this 18 day of OCTOBER, 2005. This(These) person (s) are personally known to me or produced ID

(Type)

Amy E. Lee
Notary Public Signature
State of Florida
My commission expires August 21, 2009

Amy E. Lee
Notary Printed Name



LUSKART WENDMARK

MOBILE HOME INSTALLER AFFIDAVIT

As per Florida Statutes Section 320.8249 Mobile Home Installers License:

Any person who engages in mobile home installation shall obtain a mobile home installer's license from the Bureau of Mobile Home and Recreational Vehicle Construction of the Department of Highway Safety and Motor Vehicles pursuant to this section. Said license shall be renewed annually, and each licensee shall pay a fee of \$150.

I, Bernard Thrift, license number IH 0000075
Please Print
do hereby state that the installation of the manufactured home for Randy Burnham
Applicant
at 361 NW Whitley Glen
911 Address
will be done under my supervision.

Bernard Thrift
Signature

Sworn to and subscribed before me this 28 day of OCT.
2005

Notary Public

Sherrie Thomas
Signature

My Commission Expires: _____

Date



Sherrie G. Thomas

MY COMMISSION # DD069156 EXPIRES

November 15, 2005

BONDED THRU TROY FAIR INSURANCE, INC.

LIMITED POWER OF ATTORNEY

I, Bernard Thrift, license # JH0000075 hereby
authorize Randy Burnham to be my representative and act on my behalf
in all aspects of applying for a mobile home permit to be placed on the following
described property located in _____ Florida.

Property owner: RANDY BURNHAM

Sec 05 Twp. 3 S Rge 17 E

Tax Parcel No. 04853-109

Bernard Thrift
Mobile Home Installer

10-11-05
(Date)

Sworn to and subscribed before me this 28 day of Oct, 2005.

Sherrie Thomas
Notary Public

My Commission expires: _____
Commission No. _____
Personally known: ☒
Produced ID (Type) _____



Sherrie G. Thomas
MY COMMISSION # DD069156 EXPIRES
November 15, 2005
BONDED THRU TROY FAIR INSURANCE, INC.

PERMIT NUMBER

Installer Bernard Thrift License # JH0000075

Address of home being installed _____




Manufacturer Redman Length x width 60 X 24

NOTE: *if home is a single wide fill out one half of the blocking plan*
if home is a triple or quad wide sketch in remainder of home

I understand Lateral Arm Systems cannot be used on any home (new or used) where the sidewall ties exceed 5 ft 4 in.

Installer's initials BT

Typical pier spacing 6'

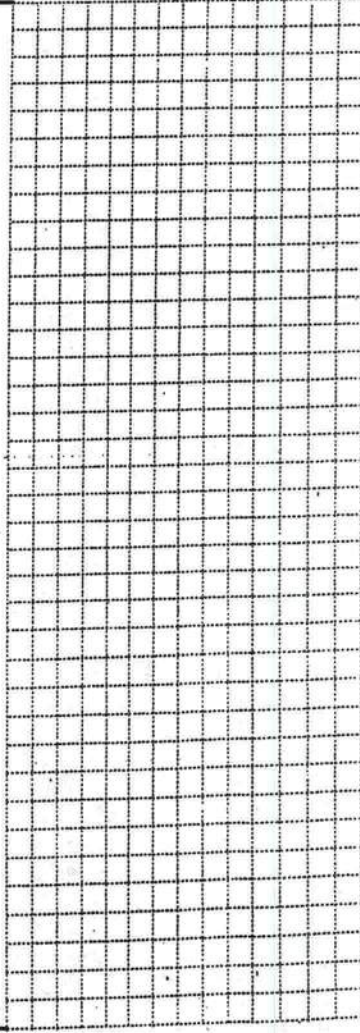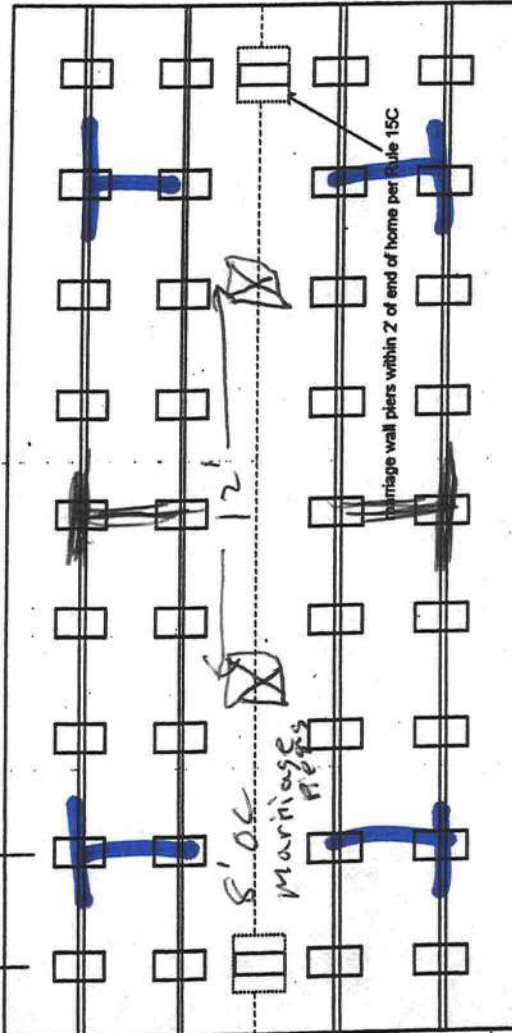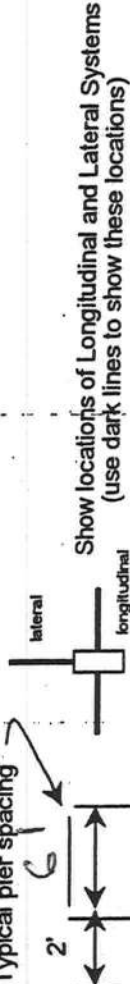

New Home ☐ Used Home ☒

Home installed to the Manufacturer's Installation Manual ☐

Home is installed in accordance with Rule 15-C ☒

Single wide ☐ Wind Zone II ☒ Wind Zone III ☐

Double wide ☒ Installation Decal # 257809

Triple/Quad ☐ Serial # 2

PIER SPACING TABLE FOR USED HOMES

Load bearing capacity	Footer size (sq in)	16" x 16" (256)	18 1/2" x 18 1/2" (342)	20" x 20" (400)	22" x 22" (484)*	24" x 24" (576)*	26" x 26" (676)
1000 psf	3'		4'	5'	6'	7'	8'
1500 psf	4' 6"		6'	7'	8'	8'	8'
2000 psf	6'		8'	8'	8'	8'	8'
2500 psf	7' 6"		8'	8'	8'	8'	8'
3000 psf	8'		8'	8'	8'	8'	8'
3500 psf	8'		8'	8'	8'	8'	8'

* Interpolated from Rule 15C-1 pier spacing table.

PIER PAD SIZES

I-beam pier pad size 17 X 22

Perimeter pier pad size 16 X 16

Other pier pad sizes (required by the mfg.) _____

Draw the approximate locations of marriage wall openings 4 foot or greater. Use this symbol to show the piers.



List all marriage wall openings greater than 4 foot and their pier pad sizes below.

Opening 12'

Pier pad size 17 X 22

4 ft 5 ft

FRAME TIES

within 2' of end of home spaced at 5' 4" oc

TIEDOWN COMPONENTS

OTHER TIES

Longitudinal Stabilizing Device (LSD)

Manufacturer _____

Longitudinal Stabilizing Device w/ Lateral Arms

Manufacturer Model 1101K Oliver-Truck

Sidewall _____

Longitudinal _____

Marriage wall _____

Shearwall _____

Number 24

6

4

2

PERMIT NUMBER

POCKET PENETROMETER TEST

The pocket penetrometer tests are rounded down to 2000 psf or check here to declare 1000 lb. soil without testing.

x 2000 x 2500 x 2000

POCKET PENETROMETER TESTING METHOD

1. Test the perimeter of the home at 8 locations.
2. Take the reading at the depth of the footer.
3. Using 500 lb. increments, take the lowest reading and round down to that increment.

x 2000 x 2000 x 2000

TORQUE PROBE TEST

The results of the torque probe test is 290 inch pounds or check here if you are declaring 5' anchors without testing. A test showing 275 inch pounds or less will require 4 foot anchors.

Note: A state approved lateral arm system is being used and 4 ft. anchors are allowed at the sidewall locations. I understand 5 ft anchors are required at all centerline tie points where the torque test reading is 275 or less and where the mobile home manufacturer may require anchors with 4000 lb. holding capacity.

Installer's initials

ALL TESTS MUST BE PERFORMED BY A LICENSED INSTALLER

Installer Name

Date Tested

10-11-05

Electrical

Connect electrical conductors between multi-wide units, but not to the main power source. This includes the bonding wire between multi-wide units. Pg. 2

Plumbing

Connect all sewer drains to an existing sewer tap or septic tank. Pg. 3
Connect all potable water supply piping to an existing water meter, water tap, or other independent water supply systems. Pg. 5

Site Preparation

Debris and organic material removed ☒
Water drainage: Natural ☒ Swale ☐ Pad ☐ Other ☐

Fastening multi-wide units

Floor: Type Fastener: 3/8 x 5" Length: 10" Spacing: 24"
Walls: Type Fastener: Straps Length: 10" Spacing: 32"
Roof: Type Fastener: Flashed Length: 10" Spacing: 24"
For used homes a min. 30 gauge, 8" wide, galvanized metal strip will be centered over the peak of the roof and fastened with galv. roofing nails at 2' on center on both sides of the centerline.

Gasket (weatherproofing requirement)

I understand a properly installed gasket is a requirement of all new and used homes and that condensation, mold, mildew and buckled marriage walls are a result of a poorly installed or no gasket being installed. I understand a strip of tape will not serve as a gasket.

Installer's initials

Installed:

Between Floors Yes ☒
Between Walls Yes ☒
Bottom of ridgebeam Yes ☒

Type gasket

Factory Installed

Weatherproofing

The bottomboard will be repaired and/or taped. Yes ☒ Pg. 5
Siding on units is installed to manufacturer's specifications. Yes ☒
Fireplace chimney installed so as not to allow intrusion of rain water. Yes ☒

Miscellaneous

Skirting to be installed. Yes ☒ No ☐
Dryer vent installed outside of skirting. Yes ☒ N/A ☐
Range downflow vent installed outside of skirting. Yes ☒
Drain lines supported at 4 foot intervals. Yes ☒
Electrical crossovers protected. Yes ☒
Other: ☐

Installer verifies all information given with this permit worksheet is accurate and true based on the manufacturer's installation instructions and or Rule 15C-1 & 2

Installer Signature

Date 10-11-05

CODE ENFORCEMENT
PRELIMINARY MOBILE HOME INSPECTION REPORT

DATE RECEIVED 10-18-05 BY G IS THE M/H ON THE PROPERTY WHERE THE PERMIT WILL BE ISSUED? Yes
OWNERS NAME Randy Burnham PHONE 752-6299 CELL _____
ADDRESS 155 NW Orbison Dr.
MOBILE HOME PARK N/A SUBDIVISION Anderson Acres, Lot 9
DRIVING DIRECTIONS TO MOBILE HOME 441 N, TL on Whitley, to end of cul-de-sac

MOBILE HOME INSTALLER ✓ PHONE _____ CELL _____

MOBILE HOME INFORMATION

MAKE Redman YEAR 1998 SIZE 24 x 60 COLOR White
SERIAL No. FLA 14612732AB
WIND ZONE II Must be wind zone II or higher NO WIND ZONE I ALLOWED

INTERIOR:

INSPECTION STANDARDS

(P or F) - P=PASS F=FAILED

✓ SMOKE DETECTOR () OPERATIONAL () MISSING
✓ FLOORS () SOLID () WEAK () HOLES DAMAGED LOCATION _____
✓ DOORS () OPERABLE () DAMAGED
✓ WALLS () SOLID () STRUCTURALLY UNSOUND
✓ WINDOWS () OPERABLE () INOPERABLE
✓ PLUMBING FIXTURES () OPERABLE () INOPERABLE () MISSING
✓ CEILING () SOLID () HOLES () LEAKS APPARENT
✓ ELECTRICAL (FIXTURES/OUTLETS) () OPERABLE () EXPOSED WIRING () OUTLET COVERS MISSING () LIGHT FIXTURES MISSING

EXTERIOR:

✓ WALLS / SIDING () LOOSE SIDING () STRUCTURALLY UNSOUND () NOT WEATHERTIGHT () NEEDS CLEANING
✓ WINDOWS () CRACKED/ BROKEN GLASS () SCREENS MISSING () WEATHERTIGHT
✓ ROOF () APPEARS SOLID () DAMAGED


STATUS:

APPROVED ✓ WITH CONDITIONS: _____
NOT APPROVED _____ NEED REINSPECTION FOR FOLLOWING CONDITIONS _____

SIGNATURE Dan ID NUMBER 306 DATE 10-20-05

Permit Application Number: 05-1112EX

ALL CHANGES MUST BE APPROVED BY THE COUNTY HEALTH UNIT

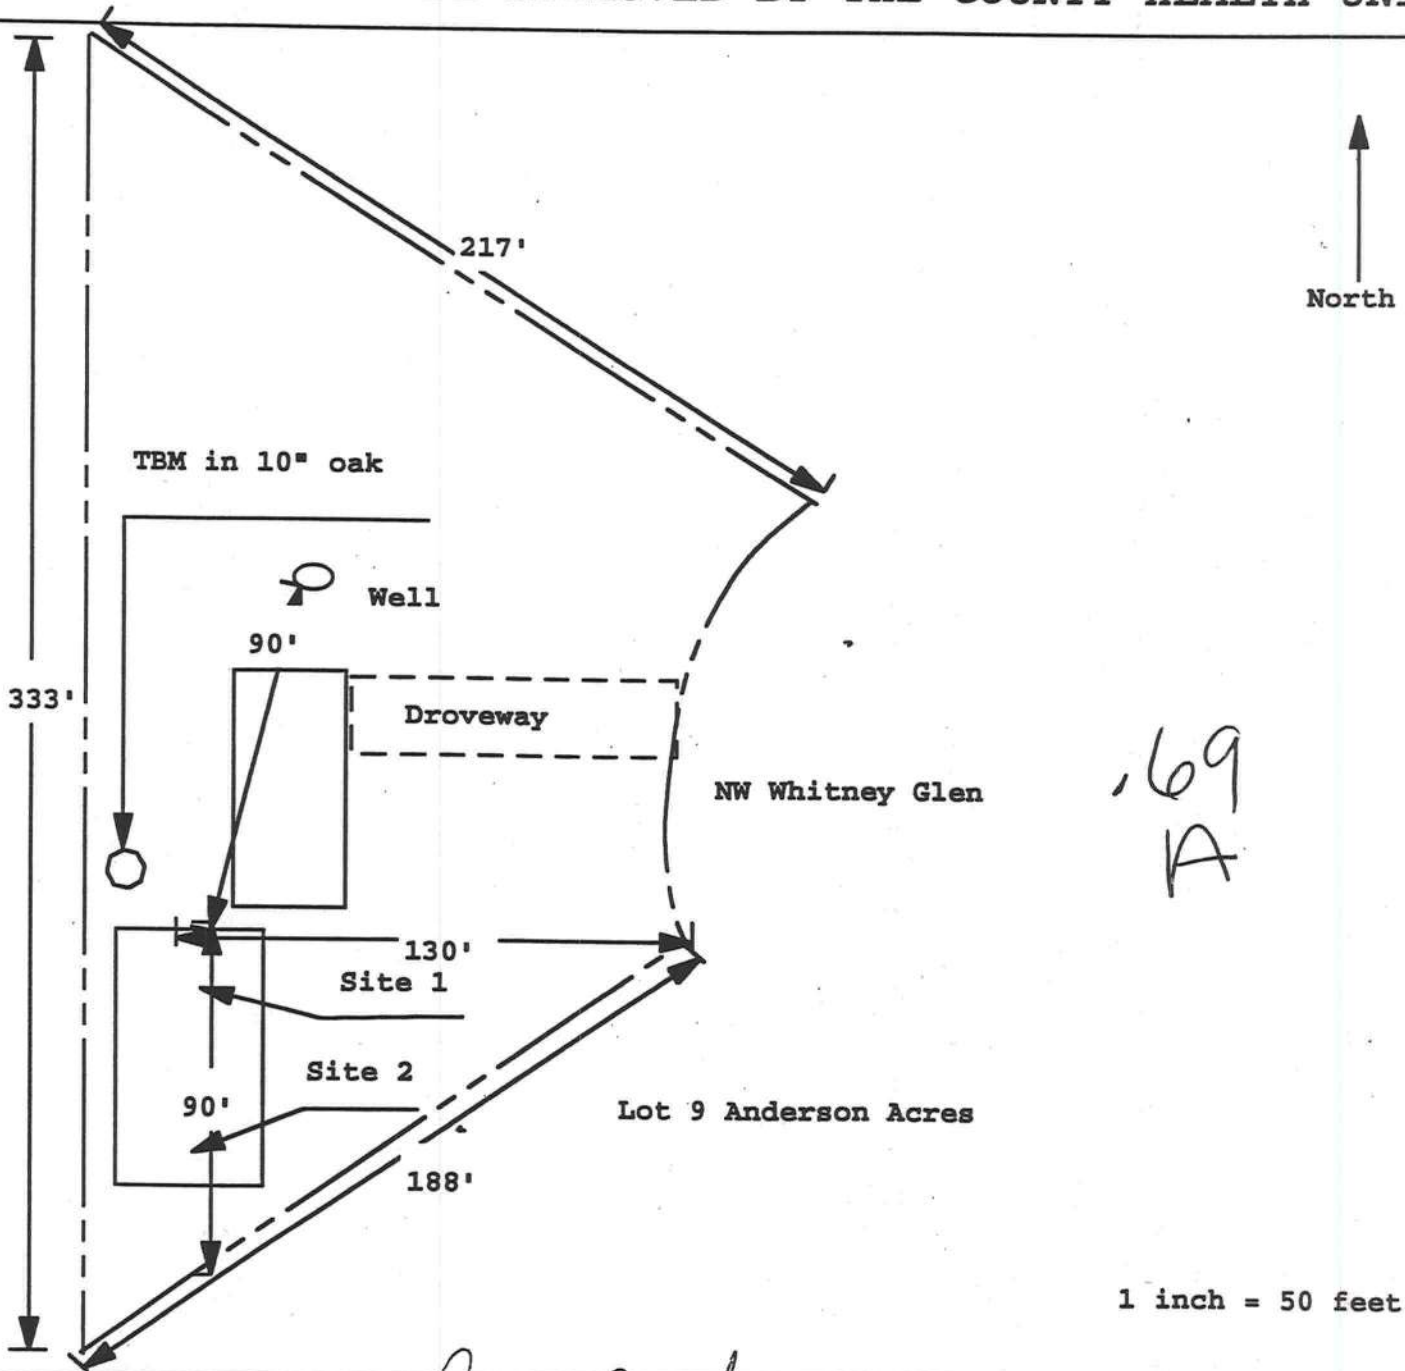

Site Plan Submitted By Randy Burnham Date 10-28-05
Plan Approved X Not Approved Date

By Salvo Graddy - Est -
COLUMBIA

Notes:

COLUMBIA COUNTY CPHU
HEALTH DEPT
249 E. FRANKLIN ST
LAKE CITY FL 32055

authorized in the State aforesaid and in the County aforesaid to take
acknowledgments, personally appeared SHARON DENISE WEICHART

BK 00