

COLUMBIA COUNTY PERMIT WORKSHEET

page 1 of 2


These worksheets must be completed and signed by the installer.
Submit the originals with the packet.

Installer [Signature] License # 2H1025239
911 Address where home is being installed 282 NW Breeze Glen Lake City, FL
Manufacturer Fleetwood Length x width 32x76

NOTE: if home is a single wide fill out one half of the blocking plan
if home is a triple or quad wide sketch in remainder of home

I understand Lateral Arm Systems cannot be used on any home (new or used) where the sidewall ties exceed 5 ft 4 in.

Installer's initials [Signature]

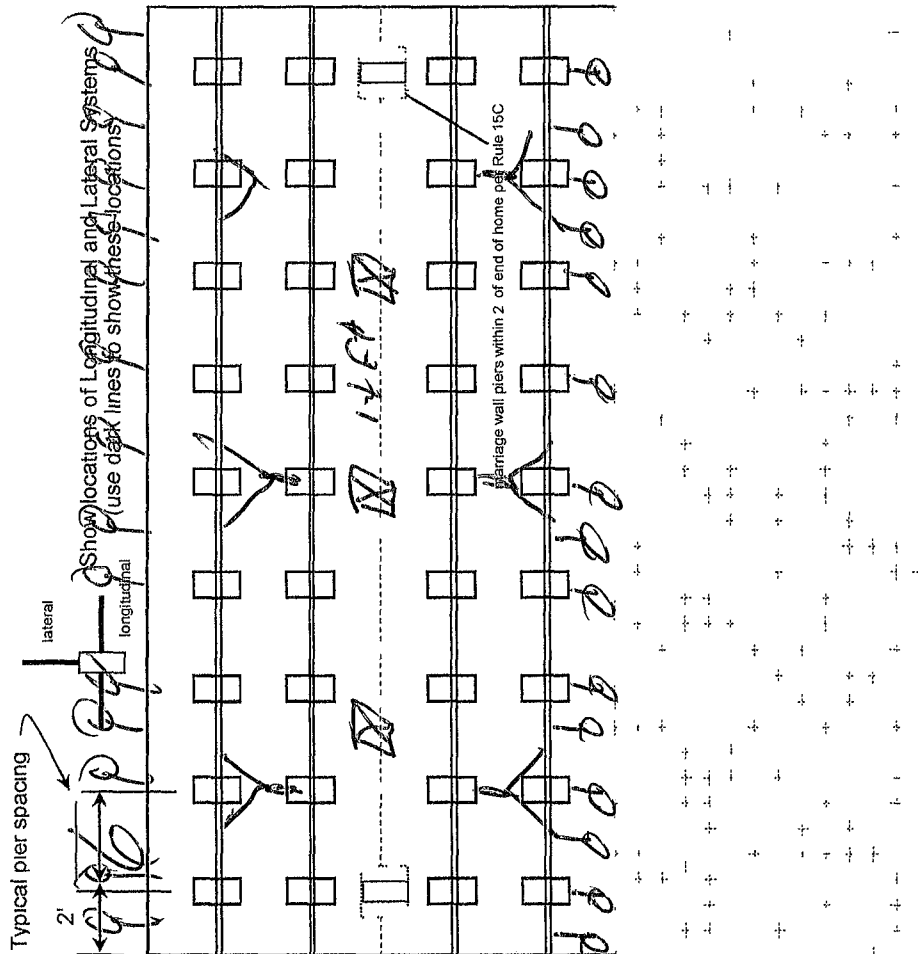

New Home ☐ Used Home ☒
Home installed to the Manufacturer's Installation Manual ☐
Home is installed in accordance with Rule 15-C ☒
Single wide ☐ Wind Zone II ☐ Wind Zone III ☐
Double wide ☒ Installation Decal # 18520
Triple/Quad ☐ Serial # 5053

PIER SPACING TABLE FOR USED HOMES

Load bearing capacity	Footer size (sq in)	16" x 16" (256)	18 1/2" x 18 1/2" (342)	20" x 20" (400)	22" x 22" (484)*	24" x 24" (576)*	26" x 26" (676)
1000 bsf	3'		4'	5'	6'	7'	8'
1500 bsf	4' 6"		6'	7'	8'	8'	8'
2000 bsf	6'		8'	8'	8'	8'	8'
2500 bsf	7' 6"		8'	8'	8'	8'	8'
3000 bsf	8'		8'	8'	8'	8'	8'
3500 bsf	8'		8'	8'	8'	8'	8'

* interpolated from Rule 15C-1 pier spacing table

PIER PAD SIZES

I-beam pier pad size 12x22
Perimeter pier pad size 17x25
Other pier pad sizes (required by the mfg) 16x16

Draw the approximate locations of marriage wall openings 4 foot or greater Use this symbol to show the piers

List all marriage wall openings greater than 4 foot and their pier pad sizes below

Opening 14 Pier pad size 24x24

ANCHORS

4 ft ☒ 5 ft Center

FRAME TIES

within 2' of end of home spaced at 5' 4" oc

TIEDOWN COMPONENTS

Longitudinal Stabilizing Device (LSD)

Manufacturer

Longitudinal Stabilizing Device w/ Lateral Arms

Manufacturer

OTHER TIES

Number

Sidewall 12x14
Longitudinal 1
Marriage wall 6
Shearwall 6

COLUMBIA COUNTY PERMIT WORKSHEET

page 2 of 2

POCKET PENETROMETER TEST

The pocket penetrometer tests are rounded down to _____ psf
or check here to declare 1000 lb soil _____ without testing

X 1300 X 1300 X 1300

POCKET PENETROMETER TESTING METHOD

- 1 Test the perimeter of the home at 6 locations
- 2 Take the reading at the depth of the footer
- 3 Using 500 lb increments, take the lowest reading and round down to that increment

X 1300 X 1300 X 1300

TORQUE PROBE TEST

The results of the torque probe test is 285 inch pounds or check here if you are declaring 5' anchors without testing _____ A test showing 275 inch pounds or less will require 5 foot anchors

Note: A state approved lateral arm system is being used and 4 ft anchors are allowed at the sidewall locations. I understand 5 ft anchors are required at all centerline tie points where the torque test reading is 275 or less and where the mobile home manufacturer may require anchors with 4000 lb holding capacity

ALL TESTS MUST BE PERFORMED BY A LICENSED INSTALLER

Installer Name _____

Date Tested 4-1-14

Electrical

Connect electrical conductors between multi-wide units, but not to the main power source This includes the bonding wire between multi-wide units Pg _____

Plumbing

Connect all sewer drains to an existing sewer tap or septic tank. Pg 1004
Connect all potable water supply piping to an existing water meter, water tap, or other independent water supply systems Pg 1004

Site Preparation

Debris and organic material removed C
Water drainage Natural _____ Swale _____ Pad _____ Other _____

Fastening multi wide units

Floor/Walls/Roof	Type Fastener	Length	Spacing
Floor	<u>400's</u>	<u>6"</u>	<u>24"</u>
Walls	<u>400's</u>	<u>6"</u>	<u>24"</u>
Roof	<u>400's</u>	<u>6"</u>	<u>24"</u>

For used homes a min 30 gauge, 8" wide, galvanized metal strip will be centered over the peak of the roof and fastened with galv roofing nails at 2" on center on both sides of the centerline

Gasket (weatherproofing requirement)

I understand a properly installed gasket is a requirement of all new and used homes and that condensation, mold, mildew and buckled mamage walls are a result of a poorly installed or no gasket being installed I understand a strip of tape will not serve as a gasket.

Type gasket 70AM Installer's initials FOH
Pg 017 Installed Between Floors Yes _____
Between Walls Yes _____
Bottom of ridgebeam Yes _____

Weatherproofing

The bottomboard will be repaired and/or taped Yes _____ Pg _____
Siding on units is installed to manufacturer's specifications. Yes _____
Fireplace chimney installed so as not to allow intrusion of rain water Yes _____

Miscellaneous

Skirting to be installed Yes _____ No _____
Dryer vent installed outside of skirting Yes _____ N/A _____
Range downflow vent installed outside of skirting Yes _____ N/A _____
Drain lines supported at 4 foot intervals. Yes _____
Electrical crossovers protected Yes _____
Other _____

Installer verifies all information given with this permit worksheet is accurate and true based on the

Installer Signature [Signature] Date 4-1-14