

# Mobile Home Permit Worksheet

Installer : Jacob Trowell License # IH/1148380


Address of home being installed 172 SW Trenton Terrace Fort White, FL 32038

Manufacturer Town Homes Length x width 52X28

**NOTE:** if home is a single wide fill out one half of the blocking plan  
if home is a triple or quad wide sketch in remainder of home  
I understand Lateral Arm Systems cannot be used on any home (new or used)  
where the sidewall ties exceed 5 ft 4 in.

Installer's initials JT

Typical pier spacing  
2' 5'  
lateral  
longitudinal  
Show locations of Longitudinal and Lateral Systems  
(use dark lines to show these locations)

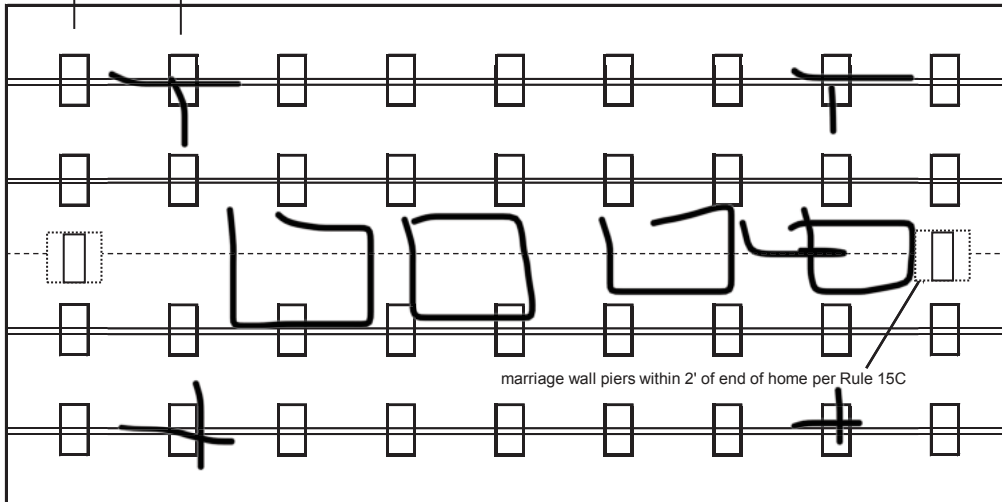

Application Number: # 71743 Date: 07/17/2025

New Home ☐ Used Home ☒  
Home installed to the Manufacturer's Installation Manual ☒  
Home is installed in accordance with Rule 15-C ☒  
Single wide ☐ Wind Zone II ☒ Wind Zone III ☐  
Double wide ☒ Installation Decal # 48039  
Triple/Quad ☐ Serial # FLTHLCT2863G - 3523A&B

## PIER SPACING TABLE FOR USED HOMES

| Load bearing capacity | Footer size (sq in) | 16" x 16" (256) | 18 1/2" x 18 1/2" (342) | 20" x 20" (400) | 22" x 22" (484)* | 24" X 24" (576)* | 26" x 26" (676) |
|-----------------------|---------------------|-----------------|-------------------------|-----------------|------------------|------------------|-----------------|
| 1000 psf              |                     | 3'              | 4'                      | 5'              | 6'               | 7'               | 8'              |
| 1500 psf              |                     | 4' 6"           | 6'                      | 7'              | 8'               | 8'               | 8'              |
| 2000 psf              |                     | 6'              | 8'                      | 8'              | 8'               | 8'               | 8'              |
| 2500 psf              |                     | 7' 6"           | 8'                      | 8'              | 8'               | 8'               | 8'              |
| 3000 psf              |                     | 8'              | 8'                      | 8'              | 8'               | 8'               | 8'              |
| 3500 psf              |                     | 8'              | 8'                      | 8'              | 8'               | 8'               | 8'              |

\* interpolated from Rule 15C-1 pier spacing table.

## PIER PAD SIZES

I-beam pier pad size 17x25  
Perimeter pier pad size 16x16  
Other pier pad sizes (required by the mfg.) \_\_\_\_\_

Draw the approximate locations of marriage wall openings 4 foot or greater. Use this symbol to show the piers.

List all marriage wall openings greater than 4 foot and their pier pad sizes below.

| Opening | Pier pad size |
|---------|---------------|
| _____   | _____         |
| _____   | _____         |
| _____   | _____         |

## TIEDOWN COMPONENTS

**Longitudinal Stabilizing Device (LSD)**  
Manufacturer Oliver Technologies (4)  
**Longitudinal Stabilizing Device w/ Lateral Arms**  
Manufacturer Oliver Technologies (4)

## POPULAR PAD SIZES

| Pad Size          | Sq In |
|-------------------|-------|
| 16 x 16           | 256   |
| 16 x 18           | 288   |
| 18.5 x 18.5       | 342   |
| 16 x 22.5         | 360   |
| 17 x 22           | 374   |
| 13 1/4 x 26 1/4   | 348   |
| 20 x 20           | 400   |
| 17 3/16 x 25 3/16 | 441   |
| 17 1/2 x 25 1/2   | 446   |
| 24 x 24           | 576   |
| 26 x 26           | 676   |

## ANCHORS

4 ft sidewall 5 ft marriage

## FRAME TIES

within 2' of end of home  
spaced at 5' 4" oc

## OTHER TIES

|               | Number     |
|---------------|------------|
| Sidewall      | <u>TBD</u> |
| Longitudinal  | <u>N/A</u> |
| Marriage wall | <u>TBD</u> |
| Shearwall     | <u>TBD</u> |

## Mobile Home Permit Worksheet

Application Number: Application# 71743

Date: 07/17/2025

### POCKET PENETROMETER TEST

The pocket penetrometer tests are rounded down to 1500 psf  
or check here to declare 1000 lb. soil without testing.

X \_\_\_\_\_ X \_\_\_\_\_ X \_\_\_\_\_

### POCKET PENETROMETER TESTING METHOD

1. Test the perimeter of the home at 6 locations.
2. Take the reading at the depth of the footer.
3. Using 500 lb. increments, take the lowest reading and round down to that increment.

X \_\_\_\_\_ X \_\_\_\_\_ X \_\_\_\_\_

### TORQUE PROBE TEST

The results of the torque probe test is 285 inch pounds or check  
here if you are declaring 5' anchors without testing. A test  
showing 275 inch pounds or less will require 5 foot anchors.

**Note:** A state approved lateral arm system is being used and 4 ft.  
anchors are allowed at the sidewall locations. I understand 5 ft  
anchors are required at all centerline tie points where the torque test  
reading is 275 or less and where the mobile home manufacturer may  
requires anchors with 4000 lb holding capacity.

JT Installer's initials

### ALL TESTS MUST BE PERFORMED BY A LICENSED INSTALLER

Installer Name Jacob Trowell

Date Tested 05/19/2025

### Electrical

Connect electrical conductors between multi-wide units, but not to the main power  
source. This includes the bonding wire between multi-wide units. Pg. 53

### Plumbing

Connect all sewer drains to an existing sewer tap or septic tank. Pg. 57

Connect all potable water supply piping to an existing water meter, water tap, or other  
independent water supply systems. Pg. 76

### Site Preparation

Debris and organic material removed X  
Water drainage: Natural Swale Pad X Other

### Fastening multi wide units

Floor: Type Fastener: lag Length: 6" Spacing: 18"  
Walls: Type Fastener: screw Length: 4" Spacing: 18"  
Roof: Type Fastener: strap Length: 10" Spacing: 32"  
For used homes a min. 30 gauge, 8" wide, galvanized metal strip  
will be centered over the peak of the roof and fastened with galv.  
roofing nails at 2" on center on both sides of the centerline.

### Gasket (weatherproofing requirement)

I understand a properly installed gasket is a requirement of all new and used  
homes and that condensation, mold, mildew and buckled marriage walls are  
a result of a poorly installed or no gasket being installed. I understand a strip  
of tape will not serve as a gasket.

Installer's initials

Type gasket foam Pg. 38  
Installed:  
Between Floors Yes X  
Between Walls Yes X  
Bottom of ridgebeam Yes X

### Weatherproofing

The bottomboard will be repaired and/or taped. Yes X Pg.  
Siding on units is installed to manufacturer's specifications. Yes  
Fireplace chimney installed so as not to allow intrusion of rain water. Yes

### Miscellaneous

Skirting to be installed. Yes X No  
Dryer vent installed outside of skirting. Yes N/A X  
Range downflow vent installed outside of skirting. Yes N/A X  
Drain lines supported at 4 foot intervals. Yes X  
Electrical crossovers protected. Yes X  
Other : \_\_\_\_\_

**Installer verifies all information given with this permit worksheet  
is accurate and true based on the  
manufacturer's installation instructions and or Rule 15C-1 & 2**

Installer Signature Jacob Trowell Date \_\_\_\_\_