

# Mobile Home Permit Worksheet

Application Number: \_\_\_\_\_


Date: \_\_\_\_\_

Installer: Ernest S Johnson License # 1025249  
 Address of home being installed: SW Kentucky St

Manufacturer: Scobolt Length x width: 56 x 28

**NOTE:** If home is a single wide fill out one half of the blocking plan. If home is a triple or quad wide sketch in remainder of home. Understand Lateral Arm Systems cannot be used on any home (new or used) where the sidewall ties exceed 5 ft 4 in.

Installer's initials: [Signature]

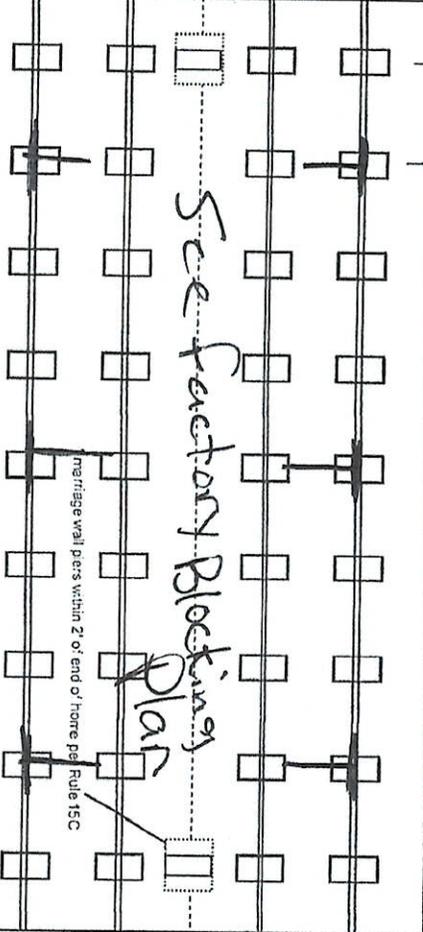

New Home  Used Home

Home installed to the Manufacturer's Installation Manual   
 Home is installed in accordance with Rule 15-C

Single wide  Wind Zone II  Wind Zone III

Double wide  Installation Decal # 87516

Triple/Quad  Serial # \_\_\_\_\_

### PIER SPACING TABLE FOR USED HOMES

Load bearing capacity (psf)	Footer size (sq in)	16" x 16" (256)	18 1/2" x 18 (342)	20" x 20" (400)	22" x 22" (484)	24" x 24" (576)	26" x 26" (676)
1000 psf	3'		4'	5'	6'	7'	8'
1500 psf	4' 6"	6'	7'	8'	8'	8'	8'
2000 psf	6'	8'	8'	8'	8'	8'	8'
2500 psf	7' 6"	8'	8'	8'	8'	8'	8'
3000 psf	8'	8'	8'	8'	8'	8'	8'
3500 psf	8'	8'	8'	8'	8'	8'	8'

\*Interpolated from Rule 15C-1 pier spacing table.

### PIER PAD SIZES

I-beam pier pad size 23X31 70c  
 Perimeter pier pad size Oliver 1055-11 OR 175X255  
 Other pier pad sizes (required by the mfg.) \_\_\_\_\_

### POPULAR PAD SIZES

Pad Size	Sq In
16 x 16	256
16 x 18	288
18.5 x 18.5	342
16 x 22.5	360
17 x 22	374
13 1/4 x 26 1/4	378
20 x 20	400
17 3/16 x 25 3/16	441
17 1/2 x 25 1/2	446
24 x 24	576
26 x 26	676

Draw the approximate locations of marriage wall openings 4 foot or greater. Use this symbol to show the piers.

List all marriage wall openings greater than 4 foot and their pier pad sizes below.

Opening \_\_\_\_\_ Pier pad size \_\_\_\_\_

**ANCHORS** 4ft 5ft

**FRAME TIES**

within 2' of end of home spaced at 5' 4" oc

### TIEDOWN COMPONENTS

Longitudinal Stabilizing Device (LSD) \_\_\_\_\_  
 Manufacturer \_\_\_\_\_  
 Longitudinal Stabilizing Device w/ Lateral Arms \_\_\_\_\_  
 Manufacturer Oliver 1101 V

**OTHER TIES**

Sidewall \_\_\_\_\_ Number 20  
 Longitudinal \_\_\_\_\_ 2  
 Marriage wall \_\_\_\_\_ 2  
 Shearwall \_\_\_\_\_

# Mobile Home Permit Worksheet

## POCKET PENETROMETER TEST

The pocket penetrometer tests are rounded down to \_\_\_\_\_ psf or check here to declare 1000 lb. soil without testing.

x 1000      x 1000      x 1000

### POCKET PENETROMETER TESTING METHOD

1. Test the perimeter of the home at 6 locations.
2. Take the reading at the depth of the footer.
3. Using 500 lb. increments, take the lowest reading and round down to that increment.

x 1000      x 1000      x 1000

## TORQUE PROBE TEST

The results of the torque probe test is \_\_\_\_\_ inch pounds or check here if you are declaring 5' anchors without testing \_\_\_\_\_. A test showing 275 inch pounds or less will require 5 foot anchors.

**Note:** A state approved lateral arm system is being used and 4 ft anchors are allowed at the sidewall locations. I understand 5 ft anchors are required at all centerline tie points where the torque test reading is 275 or less and where the mobile home manufacturer may require anchors with 4000 lb holding capacity.

\_\_\_\_\_  
Installer's Initials

### ALL TESTS MUST BE PERFORMED BY A LICENSED INSTALLER

Installer Name Ernest S John Sr

Date Tested Assumed Oliver 101 v USS 455 Foot Anchors

Electrical

Plumbing

Connect all sewer drains to an existing sewer tap or septic tank. Pg. \_\_\_\_\_

Connect all potable water supply piping to an existing water meter, water tap, or other independent water supply systems. Pg. \_\_\_\_\_

Application Number: \_\_\_\_\_

Date: \_\_\_\_\_

### Site Preparation

Debris and organic material removed \_\_\_\_\_  
Water drainage: Natural Swale Pad Other \_\_\_\_\_

### Fastening multi wide units

Floor:	Type Fastener:	Length:	Spacing:
Walls:	Type Fastener:	Length:	Spacing:
Roof:	Type Fastener:	Length:	Spacing:

For used homes a min. 30 gauge, 8" wide, galvanized metal strip will be centered over the peak of the roof and fastened with galv. roofing nails at 2" on center on both sides of the centerline.

### Gasket (weatherproofing requirement)

I understand a properly installed gasket is a requirement of all new and used homes and that condensation, mold, mildew and buckled marriage walls are a result of a poorly installed or no gasket being installed. I understand a strip of tape will not serve as a gasket.

\_\_\_\_\_  
Installer's Initials

Type gasket Pg. R11

Installed:	Between Floors	Yes
	Between Walls	Yes
	Bottom of ridgebeam	Yes

### Weatherproofing

The bottomboard will be repaired and/or taped. Yes \_\_\_\_\_ Pg. \_\_\_\_\_  
Siding on units is installed to manufacturer's specifications. Yes \_\_\_\_\_  
Fireplace chimney installed so as not to allow intrusion of rain water. Yes \_\_\_\_\_

### Miscellaneous


Skirting to be installed.	Yes	NO
Dryer vent installed outside of skirting.	Yes	N/A
Range downflow vent installed outside of skirting.	Yes	N/A
Drain lines supported at 4 foot intervals.	Yes	N/A
Electrical crossovers protected.	Yes	

Installer verifies all information given with this permit worksheet is accurate and true based on the manufacturer's installation instructions and or Rule 15C-1 & 2

Installer Signature

Ernest S John Sr

Date

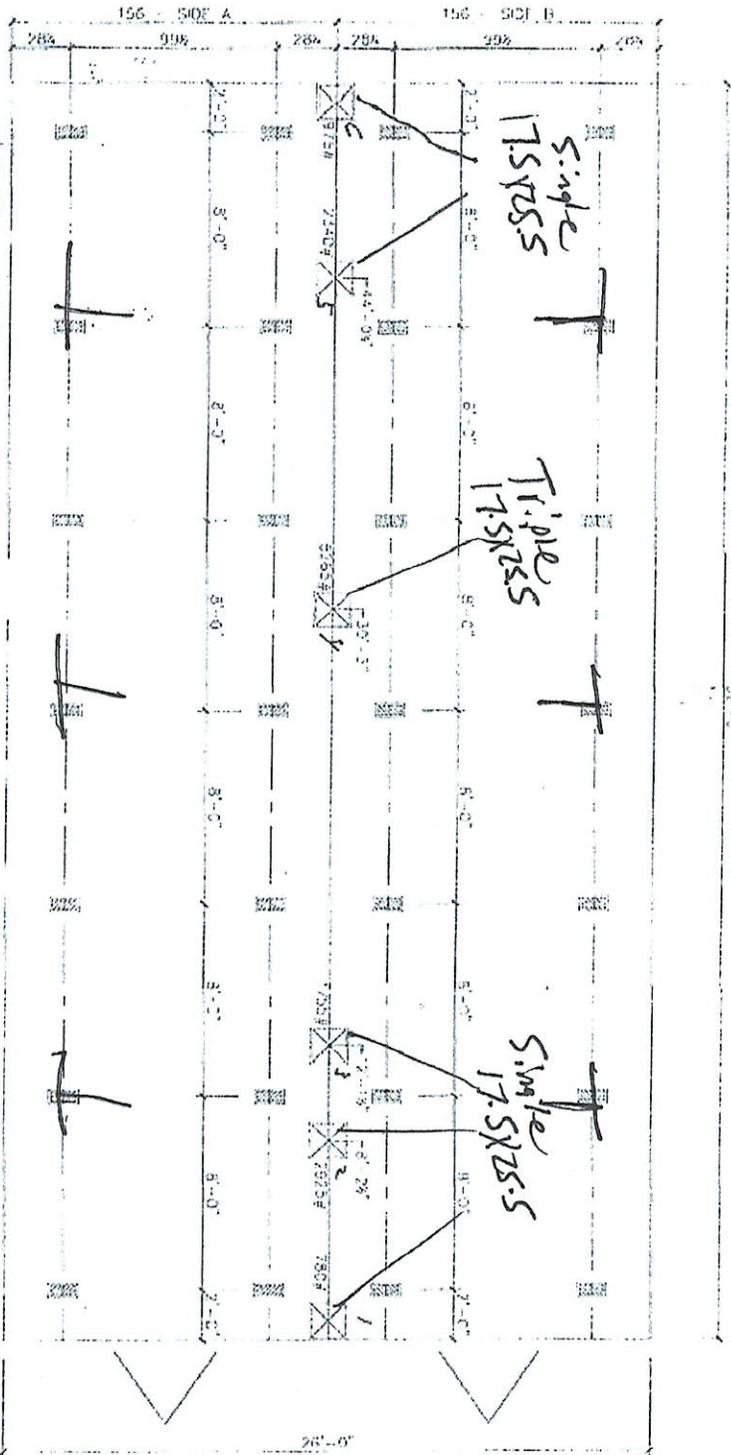

5-3-2019

THIS DRAWING IS DESIGNED FOR THE STANDARD AND CODE AND IS TO BE USED IN CONFORMANCE WITH THE REGULATIONS OF VANDAL AND ITS SUBSEQUENTS. PROVISIONS ARE MADE FOR STAIRS AND SERVICE AREAS. ALL DIMENSIONS ARE BASED ON THE NET AREA OF THE FLOOR. ALL DIMENSIONS ARE SUBJECT TO CHANGE WITHOUT NOTICE.

DATE: 5-3-2019

VERSION: A 10-29-2018

AREA

TOTAL: 1,352 ft<sup>2</sup>

LIVING SPACE: 1,352 ft<sup>2</sup>

UNIT SPECIFICATIONS:

GRAND SLAM

28' X 50'


DRAWING/MODEL NUMBER:

2852321GSM



- District No. 1 - Ronald Williams
- District No. 2 - Rocky Ford
- District No. 3 - Robby Hollingsworth
- District No. 4 - Toby Witt
- District No. 5 - Tim Murphy

**BUILDING AND ZONING  
DEPARTMENT**

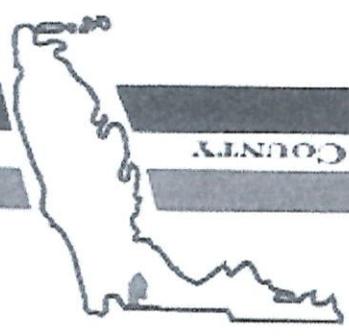

**BOARD OF COUNTY COMMISSIONERS • COLUMBIA COUNTY**

**MOBILE HOME INSTALLER  
OBLIGATION LETTER**

I, Ernest S. Johnson, of Dependable MHS, license number 1H 1025249, do hereby agree to affix the installation decal onto this manufactured home as required by law and provide a copy of this decal to the permitting authority. I further understand that once these decals become available I must provide them to obtain any further permits in Columbia County, Florida.

Signature: [Handwritten Signature]  
 License Number: 11000  
 Date: 2/8/02

**Job Information**

Job Name: Sims  
 Location: Kentucky St. Fort White  
 Application or Permit #: 53414