

Mobile Home Permit Worksheet

Installer: SAVING HOME SERVICE, LLC

Address of home being installed: 725 SW Mount Hope Dr

Manufacturer: Townhome

Length x width: 32 x 76


NOTE: if home is a single wide fill out one half of the blocking plan
if home is a triple or quad wide sketch in remainder of home
where the sidewall ties exceed 5 ft 4 in.

Installer's initials: RA

Typical pier spacing: 6'

lateral

Show locations of Longitudinal and Lateral Systems
(use dark lines to show these locations)

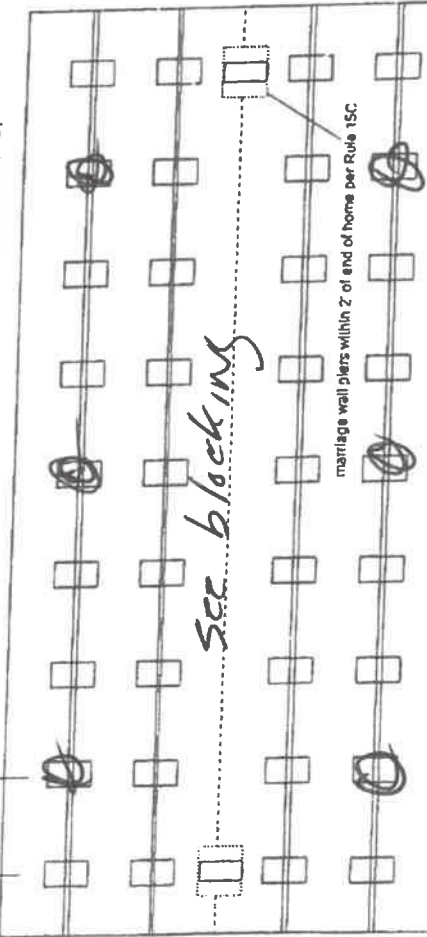

Permit Number:

New Home ☒

Used Home ☐

Date:

Home installed to the Manufacturer's Installation Manual
Home is installed in accordance with Rule 15-C

Single wide ☐

Double wide ☒

Triple/Quad ☐

Wind Zone II ☒

Wind Zone III ☐

Installation Decal # 78A

Serial # 78A

PIER SPACING TABLE FOR USED HOMES

Load bearing capacity	Footer size (sq in)	16" x 16" (256)	18 1/2" x 18 1/2" (342)	20" x 20" (400)	22" x 22" (484)*	24" x 24" (576)*	26" x 26" (676)
1000 PSI	3'	4'	4'	5'	6'	7'	8'
1500 PSI	4'	5'	5'	6'	7'	8'	8'
2000 PSI	5'	6'	6'	7'	8'	8'	8'
2500 PSI	6'	7'	7'	8'	8'	8'	8'
3000 PSI	7'	8'	8'	8'	8'	8'	8'
3500 PSI	8'	8'	8'	8'	8'	8'	8'

* interpolated from Rule 15C-1 pier spacing table.

PIER PAD SIZES

I-beam pier pad size 17x25

Perimeter pier pad size 16x16

Other pier pad sizes (required by the mfg.)

Draw the approximate locations of marriage wall openings 4 foot or greater. Use this symbol to show the piers.

List all marriage wall openings greater than 4 foot and their pier pad sizes below.

Opening

Pier pad size

Doors

16x16

ANCHORS

4 ft 5 ft

FRAME TIES

within 2' of end of home spaced at 5' 4" oc

TIEDOWN COMPONENTS

Longitudinal Stabilizing Device (LSD)

Longitudinal Stabilizing Device w/ Lateral Arms

OTHER TIES

Sidewall

Longitudinal

Marriage wall

Shearwall

Department of Growth Management
Building Division

Page 1 of 2

BF27 MH Permit Worksheet
Revised November 04, 2010

Mobile Home Permit Worksheet

POCKET PENETROMETER TEST

The pocket penetrometer tests are rounded down to 1500 psf or check here to declare 1000 lb. soil _____ without testing.

x 1500 x 1500 x 1500

POCKET PENETROMETER TESTING METHOD

1. Test the perimeter of the home at 6 locations.
2. Take the reading at the depth of the footer.
3. Using 500 lb. increments, take the lowest reading and round down to that increment.

x 1500 x 1500 x 1500

TORQUE PROBE TEST

The results of the torque probe test is 285 inch pounds or check here if you are declaring 5' anchors without testing _____ A test showing 275 inch pounds or less will require 5 foot anchors.

Note: A state approved lateral arm system is being used and 4 ft. anchors are allowed at the sidewall locations. I understand 5 ft. anchors are required at all remaining tie points where the torque test reading is 275 or less and where the mobile home manufacturer may require anchors with 4000 lb. holding capacity.

Installer's initials

ALL TESTS MUST BE PERFORMED BY A LICENSED INSTALLER

Installer Name

Date Tested

Richard Kay Boman
10-20-25

Electrical

Connect electrical conductors between multi-wide units, but not to the main power source. This includes the bonding wire between multi-wide units. Pg. 3

Plumbing

Connect all sewer drains to an existing sewer tap or septic tank. Pg. 3
Connect all potable water supply piping to an existing water meter, water tap, or other independent water supply systems. Pg. 3

Department of Growth Management
Building Division

Permit Number: _____

Date: _____

Site Preparation

Debris and organic material removed _____
Water drainage: Natural ✓ Swale _____ Pad _____ Other _____

Fastening multi wide units

Floor: _____
Walls: _____
Roof: _____
Type Fastener: 105 Length: 4 Spacing: 16
Type Fastener: 105 Length: 6 Spacing: 16
For used homes a min. 30 gauge, 8" wide, galvanized metal strip will be centered over the peak of the roof and fastened with galv. roofing nails at 2" on center on both sides of the centerline.

Gasket (weatherproofing requirement)

I understand a properly installed gasket is a requirement of all new and used homes and that condensation, mold, mildew and buckled marriage walls are a result of a poorly installed or no gasket being installed. I understand a strip of tape will not serve as a gasket.

Type gasket Factory Installer's initials [Signature]
Pg. 3
Installed:
Between Floors Yes _____
Between Walls Yes _____
Bottom of ridgebeam Yes _____

Weatherproofing

The bottomboard will be repaired and/or taped. Yes _____
Siding on units is installed to manufacturer's specifications. Yes _____
Fireplace chimney installed so as not to allow intrusion of rain water. Yes _____

Miscellaneous

Skirting to be installed. Yes _____ No _____
Dryer vent installed outside of skirting. Yes _____ No _____
Range downflow vent installed outside of skirting. Yes _____ No _____
Drain lines supported at 4 foot intervals. Yes _____ No _____
Electrical crossovers protected. Yes _____ No _____
Other: _____

Installer verifies all information given with this permit worksheet is accurate and true based on the manufacturer's installation instructions and or Rule 15C-1 & 2


Installer Signature

Date

10-20-25

30'-4" WIDE HOME
SIDEWALL HEIGHT 8'-0"
OPT. SIDEWALL HEIGHT 8'-10"

76'

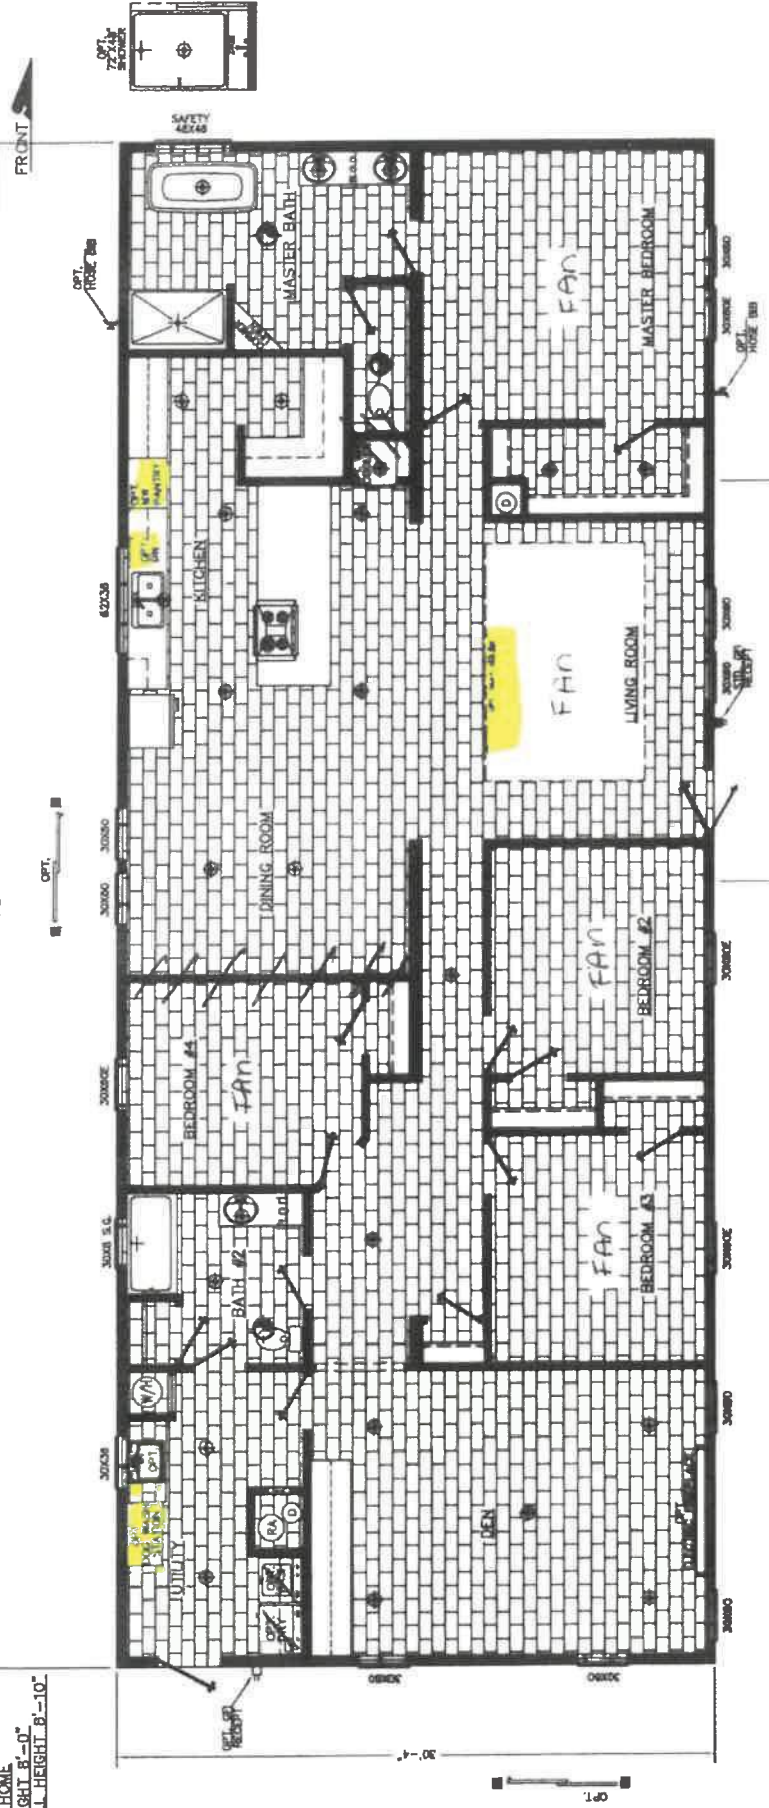


/// = Accent Wall
20' DORMER



TownHomes
P.O. BOX 10650
LAKE CITY, FLORIDA
32056

Decor: 5-15-24	Revisions:	Code#:
Dr'n: HLC		
Parent: NEW		
Code: T (10)		
Scale: 1/8" = 1'-0"	Model: WINDLEY 32282-678	Price: 2505 SQ. FT. SALES
123		

UPDATED: 1/2/25

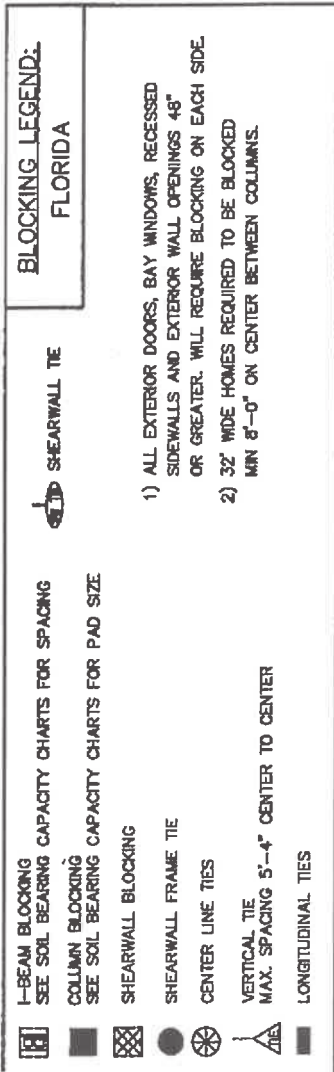

		TownHomes P.O. BOX 1688 LAKE CITY, FLORIDA 32066	
SPECIAL: 10% DISCOUNT - 10% OFF - 10% OFF - 10% OFF - 10% OFF		Revisions	Code/s
Dates: 5-15-24	Dr'n: HLC		
	Parents: NEW		
Codes: T (10)			
Model: WINDLEY 32262-678	Print: FLORIDA BLOCKING PLAN		