

These worksheets must be completed and signed by the installer.
Submit the originals with the packet.


OLYMPIA L-3764P

Installer DAVID ALBRIGHT License # JH/1129420
911 Address where home is being installed 2133 NW TURNER AVE
LAKE CITY, FL 32055
Manufacturer LIVE OAK HOMES Length x width 32 x 76/80

NOTE: If home is a single wide fill out one half of the blocking plan
if home is a triple or quad wide sketch in remainder of home

I Understand Lateral Arm Systems cannot be used on any home (new or used)
where the sidewall lies exceed 5 ft 4 in.

Installer's initials DA

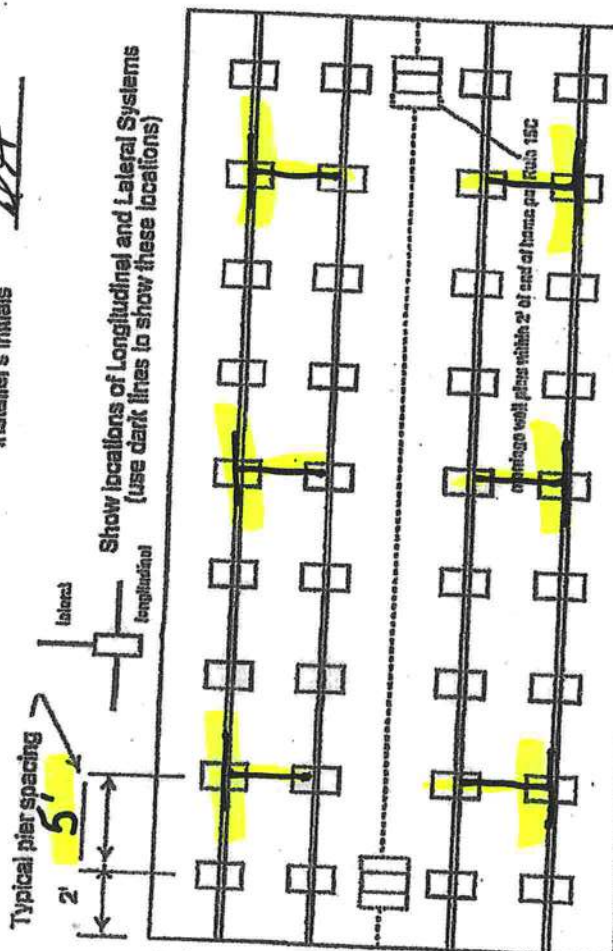

opening wall place within 2' of end of home per Rule 15C

Seal of the State of Florida
Department of Building
Professional Engineer
Date of Review
10/30/2020

New Home ☒ Used Home ☐
Home installed to the Manufacturer's Installation Manual
Home is installed in accordance with Rule 15-C ☒
Single wide ☐ Wind Zone II ☒ Wind Zone III ☐
Double wide ☒ Installation Decal # 71607
Triple/Quad ☐ Serial # LOHGA21833634 AB

PIER SPACING TABLE FOR USED HOMES

Load bearing capacity	Footer size (sq in)	16" x 18" (256)	18 1/2" x 18 1/2" (342)	20" x 20" (400)	22" x 22" (484)	24" x 24" (576)	26" x 26" (676)
1000 psf	3'	3'	4'	5'	6'	7'	8'
1500 psf	4'	4'	5'	6'	7'	8'	9'
2000 psf	5'	5'	6'	7'	8'	9'	10'
2500 psf	6'	6'	7'	8'	9'	10'	11'
3000 psf	7'	7'	8'	9'	10'	11'	12'
3500 psf	8'	8'	9'	10'	11'	12'	13'

* Interpolated from Rule 15C-1 pier spacing table.

PIER PAD SIZES

I-beam pier pad size 17 x 25
Perimeter pier pad size 16 x 16
Other pier pad sizes (required by the mfg.) 23 x 32

Draw the approximate locations of marriage wall openings 4 foot or greater. Use this symbol to show the piers.

List all marriage wall openings greater than 4 foot and their pier pad sizes below.

POP-IT AR PAD SIZES

Pad Size	Sq In
16 x 16	256
16 x 18	288
18.5 x 18.5	342
16 x 22.5	360
17 x 22	374
13 1/4 x 26 1/4	348
20 x 20	400
17 3/16 x 25 3/16	441
17 1/2 x 26 1/2	446
24 x 24	576
26 x 26	676

ANCHORS

4 ft ☒ 5 ft ☐

FRAME TIES

within 2' of end of home spaced at 5' 4" oc

TIEDOWN COMPONENTS

Longitudinal Stabilizing Device (LSD) OT1
Manufacturer OTI
Longitudinal Stabilizing Device w/ Lateral Arms OT1
Manufacturer OTI

OTHER TIES

Number 18
Sidewall 1
Longitudinal 1
Marriage wall 1
Shearwall 1

Mobile Home Permit Worksheet

Application Number: _____

Date: _____

POCKET PENETROMETER TEST

The pocket penetrometer tests are rounded down to 1500 psf or check here to declare 1000 lb. soil _____ without testing.

X 1500 X 1500 X 1500

POCKET PENETROMETER TESTING METHOD

1. Test the perimeter of the home at 6 locations.
2. Take the reading at the depth of the footer.
3. Using 500 lb. increments, take the lowest reading and round down to that increment.

X 1500 X 1500 X 1500

TORQUE PROBE TEST

The results of the torque probe test is 285 inch pounds or check here if you are declaring 5' anchors without testing _____. A test showing 275 inch pounds or less will require 5 foot anchors.

Note: A state approved lateral arm system is being used and 4 ft. anchors are allowed at the sidewall locations. I understand 5 ft anchors are required at all centerline tie points where the torque test reading is 275 or less and where the mobile home manufacturer may require anchors with 4000 lb. holding capacity.

Installer's initials _____

ALL TESTS MUST BE PERFORMED BY A LICENSED INSTALLER

Installer Name DAVID ALBRIGHT MOBILE HOME SVC

Date Tested _____

Electrical

Connect electrical conductors between multi-wide units, but not to the main power source. This includes the bonding wire between multi-wide units. Pg. 73-77

Plumbing

Connect all sewer drains to an existing sewer tap or septic tank. Pg. 79-80

Connect all potable water supply piping to an existing water meter, water tap, or other independent water supply systems. Pg. 78-110

Site Preparation

Debris and organic material removed X

Water drainage: Natural _____ Swale _____ Pad X _____ Other _____

Fastening multi wide units

Floor: Type Fastener: LAGS Length: 6" Spacing: 2"
Walls: Type Fastener: SCREWS Length: 3" Spacing: 18"
Roof: Type Fastener: LAGS Length: 6" Spacing: 2"
For used homes a min. 30 gauge, 8" wide, galvanized metal strip will be centered over the peak of the roof and fastened with galv. roofing nails at 2" on center on both sides of the centerline.

Gasket (weatherproofing requirement)

I understand a properly installed gasket is a requirement of all new and used homes and that condensation, mold, mildew and buckled marriage walls are a result of a poorly installed or no gasket being installed. I understand a strip of tape will not serve as a gasket.

Installer's initials DA

Type gasket FACTORY

Pg. 41

Installed:

Between Floors Yes X

Between Walls Yes END WALLS

Bottom of ridgebeam Yes X

Weatherproofing


The bottomboard will be repaired and/or taped. Yes X Pg. 124
Siding on units is installed to manufacturer's specifications. Yes X
Fireplace chimney installed so as not to allow intrusion of rain water. Yes X

Miscellaneous

Skirting to be installed. Yes _____ No X
Dryer vent installed outside of skirting. Yes _____ N/A X
Range downflow vent installed outside of skirting. Yes _____ N/A X
Drain lines supported at 4 foot intervals. Yes X
Electrical crossovers protected. Yes X
Other: _____

Installer verifies all information given with this permit worksheet is accurate and true based on the manufacturer's installation instructions and or Rule 15C-1 & 2

Installer Signature David Albright Date _____

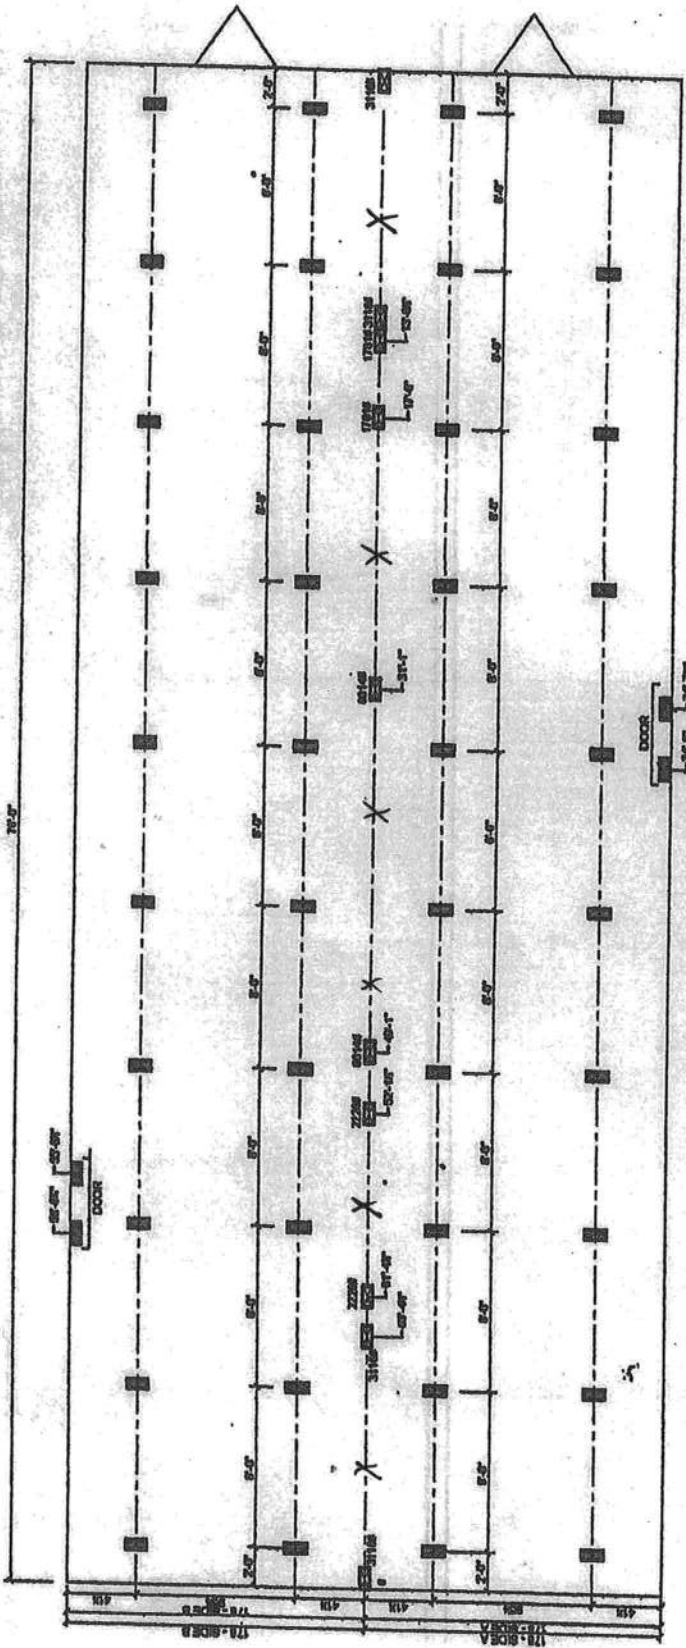



TIEDOWN LOCATIONS
 (X) MARKING LINE OPENING SUPPORT PIER/TYP.
 (X) SUPPORT PIER/TYP.

FOUNDATION NOTES:
 - THIS DRAWING IS DESIGNED FOR THE STANDARD WIND ZONE AND IS TO BE USED IN CONJUNCTION WITH THE INSTALLATION MANUAL AND ITS SUPPLEMENTS.
 - FOOTINGS ARE SHOWN FOR EXAMPLE ONLY CLARITY AND SPACING MAY VARY BASED ON PWD TYPE, WIND CONDITION, ETC.
 - FOOTINGS ARE REQUIRED AT SUPPORT POSTS. SEE INSTALLATION MANUAL FOR REQUIREMENTS.

Live Oak Homes
MODEL: L-3764P - 32 X 80
4-BEDROOM / 2-BATH

- (A) MAIN ELECTRICAL
- (B) ELECTRICAL CROSSOVER
- (C) WATER INLET
- (D) WATER CROSSOVER (IF ANY)
- (E) GAS INLET (IF ANY)
- (F) GAS CROSSOVER (IF ANY)
- (G) DUCT CROSSOVER
- (H) GEMER DUCTS
- (I) RETURN AIR (MOPT. HEAT PUMP ON DUCT)
- (J) SUPPLY AIR (MOPT. HEAT PUMP ON DUCT)

OLYMPIA **L-3764P**

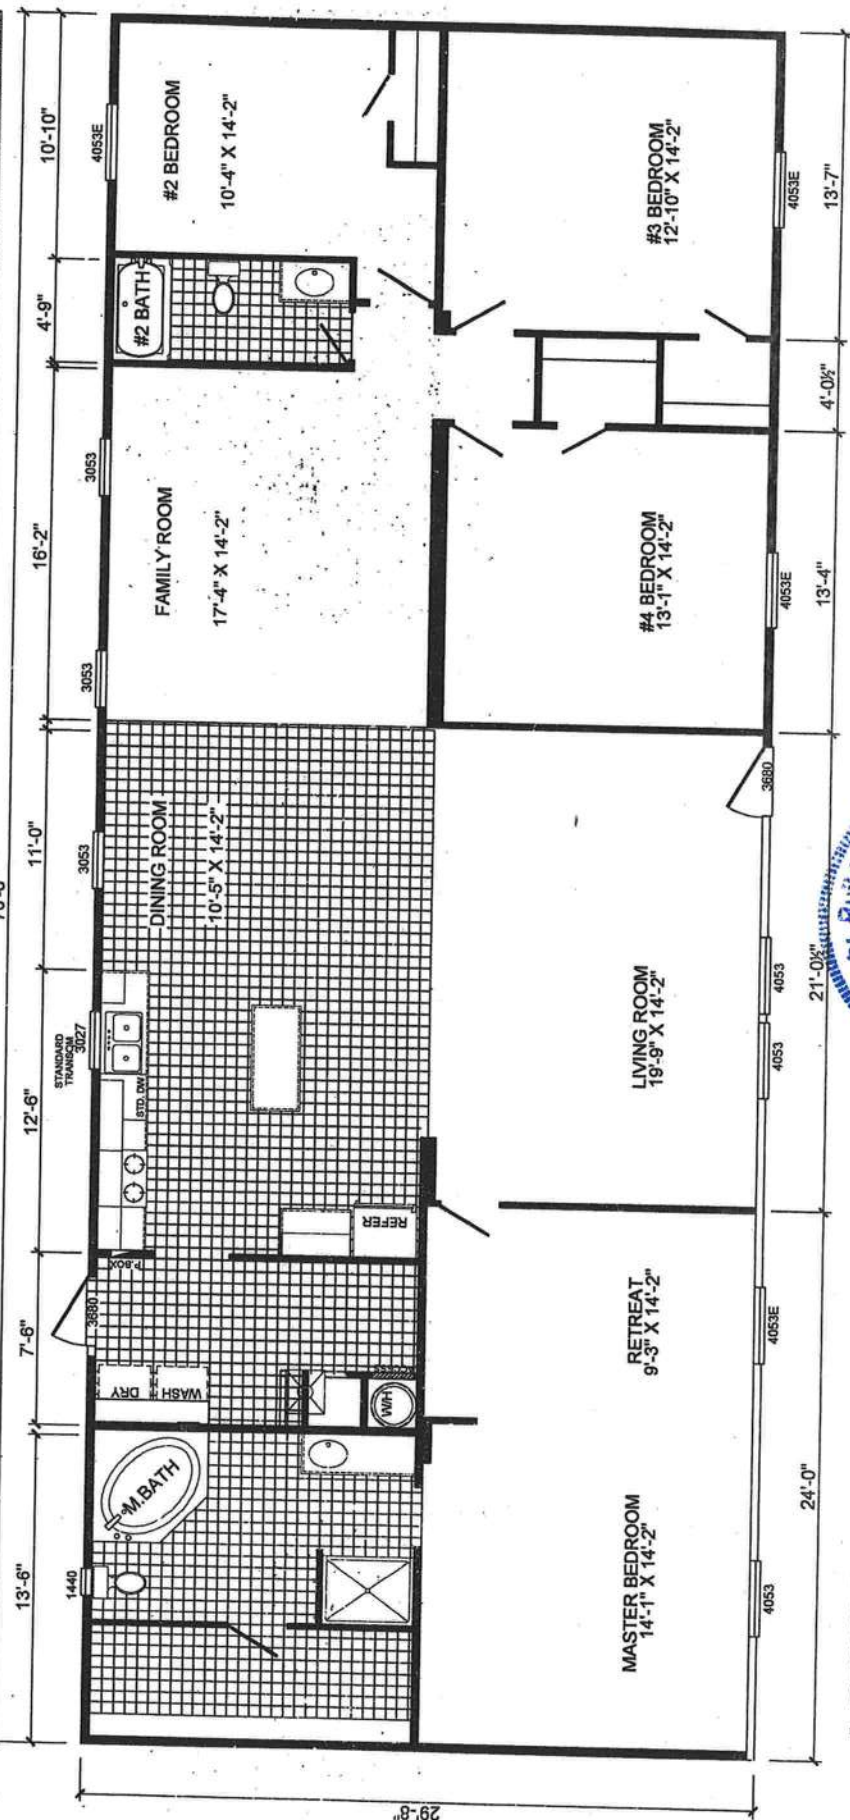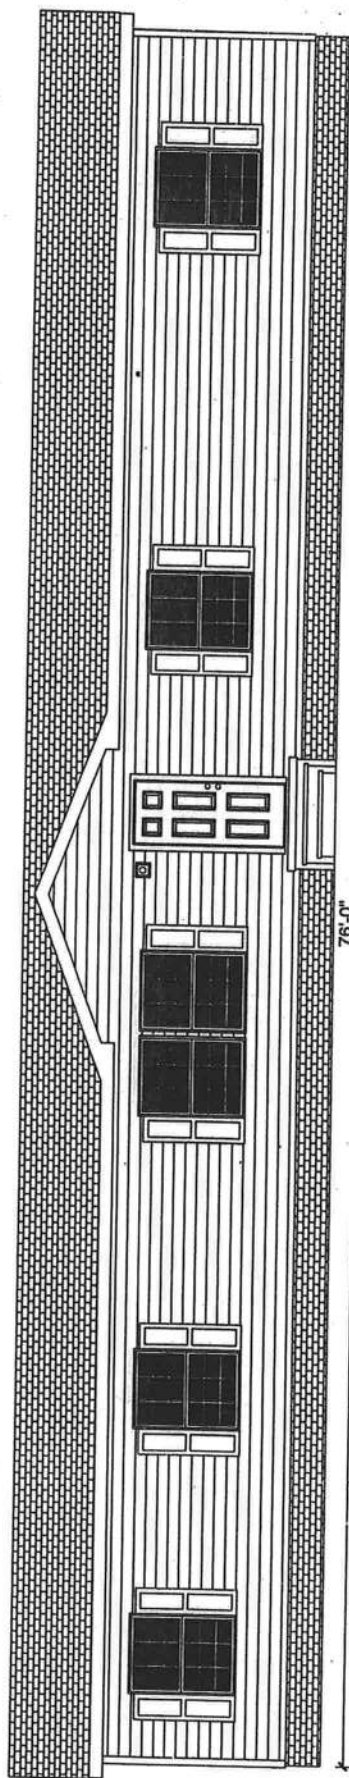

L-3764P-RUNNER
4-BEDROOM / 2-BATH
32 X 80 - Approx. 2254 Sq. Ft.

11-11-2014

* All room dimensions include closets and square footage figures are approximate.
 * Transom windows are available on optional 9'-0" sidewall houses only.
 * Underpinning shown is optional.

OLYMPIA