




Mobile Home Permit Worksheet

Installer: John Harden License # 1H1150540
 Address of home being installed: 2 BD Boundary Way
Fort White, FL 32038
 Manufacturer: Clayton Tru Length x width 76 x 16



NOTE: If home is a single wide fill out one half of the blocking plan
 If home is a tripla or quad wide sketch in remainder of home
 I understand Lateral Arm Systems cannot be used on any home (new or used)
 where the sidewall ties exceed 5 ft 4 in.

Installer's initials JA

Typical pier spacing

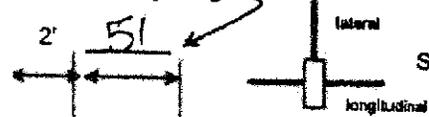

Show locations of Longitudinal and Lateral Systems
 (use dark lines to show these locations)

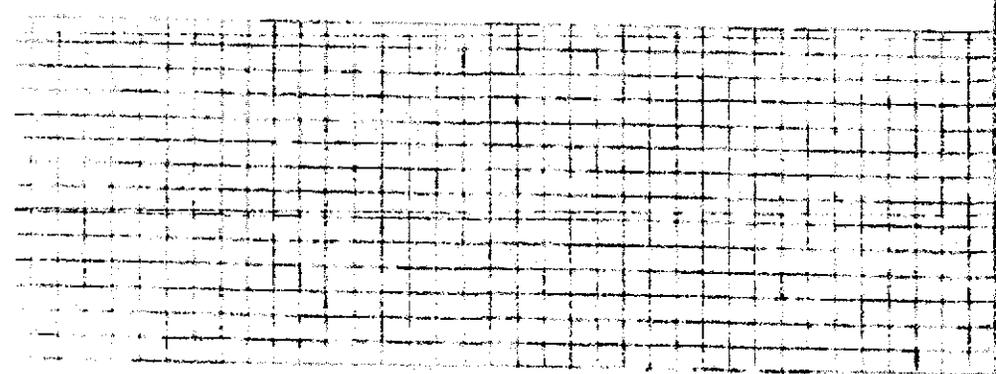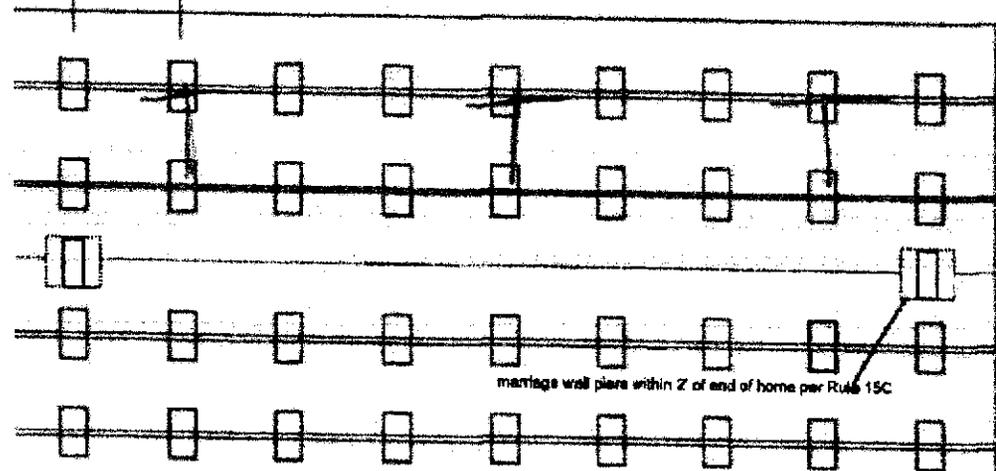

Permit Number: _____ Date: _____

New Home Used Home

Home installed to the Manufacturer's Installation Manual
 Home is installed in accordance with Rule 15-C

Single wide Wind Zone II Wind Zone III

Double wide Installation Decal # 125978

Triple/Quad Serial # _____

PIER SPACING TABLE FOR USED HOMES

Load bearing capacity	Footer size (sq in)	16" x 16" (256)	18 1/2" x 18 1/2" (342)	20" x 20" (400)	22" x 22" (484)*	24" x 24" (576)*	26" x 26" (676)
1000 pcf		3'	4'	5'	6'	7'	8'
1500 pcf		4'	6'	7'	8'	8'	8'
2000 pcf		6'	6'	8'	8'	8'	8'
2500 pcf		7'	6'	8'	8'	8'	8'
3000 pcf		8'	8'	8'	8'	8'	8'
3500 pcf		8'	8'	8'	8'	8'	8'

*Interpolated from Rule 15C-1 pier spacing table.

PIER PAD SIZES

I-beam pier pad size 17 x 25

Perimeter pier pad size 16 x 16

Other pier pad sizes (required by the mfg.) _____

Draw the approximate locations of marriage wall openings 4 foot or greater. Use this symbol to show the piers.

List all marriage wall openings greater than 4 foot and their pier pad sizes below.

Opening	Pier pad size

POPULAR PAD SIZES

Pad Size	Sq In
16 x 16	256
16 x 18	288
18.5 x 18.5	342
18 x 22.5	360
17 x 22	374
19 1/2 x 26 1/2	348
20 x 20	400
17 3/16 x 25 3/16	441
17 1/2 x 25 1/2	446
24 x 24	576
26 x 26	676

4 ft 5 ft

ANCHORS

FRAME TIES

within 2' of end of home spaced at 5' 4" oc

OTHER TIES

Sidewall	Number <u>160</u>
Longitudinal	<u>6</u>
Marriage Wall	<u>1</u>
Shear Wall	<u>160</u>

TIEDOWN COMPONENTS

Longitudinal Stabilizing Device (LSD)
 Manufacturer OTI
Longitudinal Stabilizing Device w/ Lateral Arms
 Manufacturer OTI



Mobile Home Permit Worksheet

POCKET PENETROMETER TEST

The pocket penetrometer tests are rounded down to _____ psf or check here to declare 1000 lb. soil without testing.

X _____ X _____ X _____

POCKET PENETROMETER TESTING METHOD

1. Test the perimeter of the home at 6 locations.
2. Take the reading at the depth of the footer.
3. Using 500 lb. increments, take the lowest reading and round down to that increment.

X _____ X _____ X _____

TORQUE PROBE TEST

The results of the torque probe test is _____ inch pounds or check here if you are declaring 5' anchors without testing . A test showing 275 inch pounds or less will require 5' anchors.

Note: A state approved lateral arm system is being used and 4 ft. anchors are allowed at the sidewall locations. I understand 5' anchors are required at all centerline tie points where the torque test reading is 275 or less and where the mobile home manufacturer may require anchors with 4000 lb. holding capacity.

Installer's initials JA

ALL TESTS MUST BE PERFORMED BY A LICENSED INSTALLER

Installer Name John Hardin

Date Tested _____

ELECTRICAL

Connect electrical conductors between multi-wide units, but not to the main power source. This includes the bonding wire between multi-wide units. Pg. _____

PLUMBING

Connect all sewer drains to an existing sewer tap or septic tank. Pg. _____

Connect all potable water supply piping to an existing water meter, water tap, or other independent water supply systems. Pg. _____

Permit Number: _____

Date: _____

Site Preparation

Debris and organic material removed
Water drainage: Natural _____ Swale _____ Pad Other _____

Fastening multi wide units

Floor- Type Fastener: lag Length: 7" Spacing: None
Walls- Type Fastener: SCREW Length: 6" Spacing: 16oc
Roof- Type Fastener: lag Length: 7" Spacing: 16oc

For used homes a min. 30 gauge, 8" wide, galvanized metal strip will be centered over the peak of the roof and fastened with galv. roofing nails at 2" on center on both sides of the centerline.

Gasket (weatherproofing requirement)

I understand a properly installed gasket is a requirement of all new and used homes and that condensation, mold, mildew and buckled marriage walls are a result of a poorly installed or no gasket being installed. I understand a strip of tape will not serve as a gasket.

Installer's initials JA

Type gasket foam
Pg. _____

Installed:
Between Floors _____ Yes
Between Walls _____ Yes
Bottom of ridge beam _____ Yes

Weatherproofing

The bottom board will be repaired and/or taped. _____ Yes Pg. _____
Siding on units is installed to manufacturer's specifications. _____ Yes
Fireplace chimney installed so as not to allow intrusion of rain water. _____ Yes

Miscellaneous

Skirting to be installed. _____ Yes _____ No _____ N/A
Dryer vent installed outside of skirting. _____ Yes _____ No _____ N/A
Range downflow vent installed outside of skirting. _____ Yes _____ No _____ N/A
Drain lines supported at 4' intervals. _____ Yes No _____ N/A _____
Electrical crossovers protected. _____ Yes No _____ N/A _____
Other: _____

Installer verifies all information given with this permit worksheet is accurate and true based on the manufacturer's installation instructions and or Rule 15C-1 & 2

Installer's Signature JA

Date 12/2/25

Clayton90: Foundation Plan Summary



Use this QR Code to access DAPPA approved plans referenced within this design. Hover your phone camera over the code. For Android and other devices, download a QR Code reader. Questions? Email info@claytonbuilt.com

Order Number: N/A
 Model Number: 926-TR716763A ASPEN
 Home Building Facility: NSB

Home Width: 45 FT 0 IN
 Home Length: 78 FT 0 IN
 Outside Length (O.R.): 40.25 IN
 Chassis Spacing: 89.5 IN

Roof Load: 20 PSF
 Soil Bearing Cap: 1500 PSF
 Min. I-Beam Size: 12 IN
 Calculated Eave Overhang: 6 IN

TABLE 1: FRAME PIERS


Pier Spacing	Pier Configuration	Footer Size
TYP. 8 FT 0 IN	Single stacked	24 IN x 24 IN x 8 IN
MAX. 8 FT 0 IN	Single stacked	24 IN x 24 IN x 8 IN

(Table 1)

TABLE 2: EXTERIOR PIERS

Pier ID	Pier Configuration	Footer Size
L1, L2	Single attached	8 IN x 16 IN x 8 IN
R1, R2	Single stacked	18 IN x 16 IN x 6 IN

(Table 2)

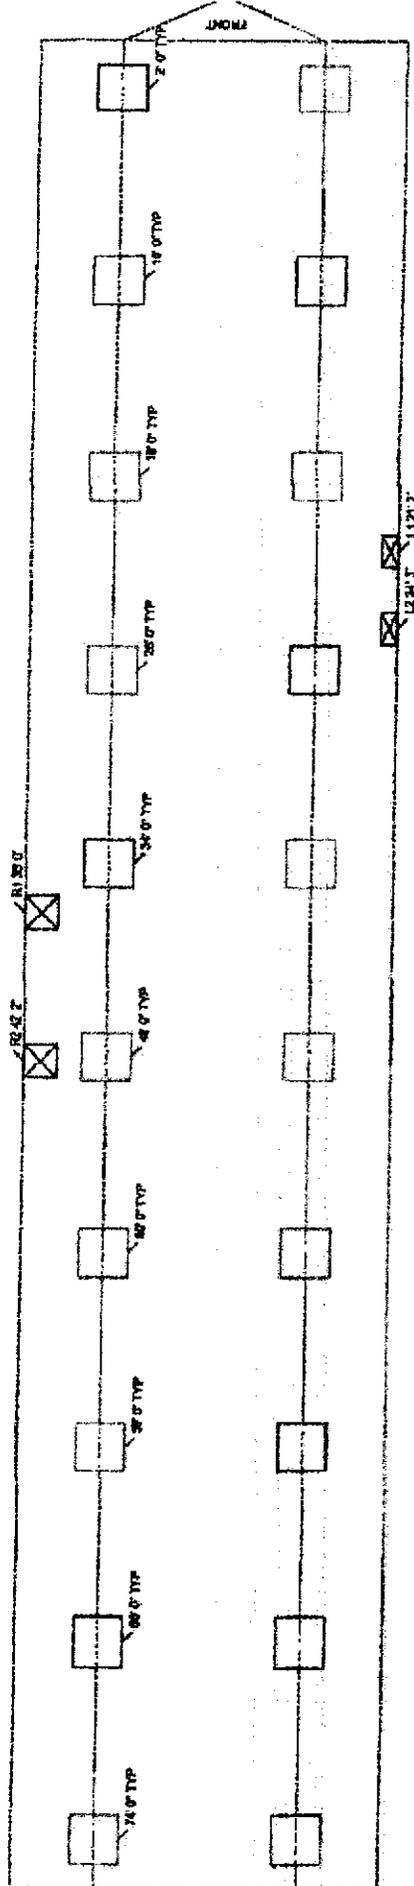

License Number: IH / 1150540 / 1 Name: JOHN P. HARDEN

Order #: 6866

Label #: 125978

Manufacturer: Clayton Tru

(Check Size of Home)

Homeowner: Sacha Mulua

Year Model: 2026

Single

Address: SW Boundary Way

Length & Width: 76x16

Double

Triple

City/State/Zip: FW, FL

Type Longitudinal System: OTI

HUD Label #:

Phone #:

Type Lateral Arm System: OTI

Soil Bearing / PSF:

Date Installed:

New Home: Used Home:

Torque Probe / in-lbs:

Installed Wind Zone: 2

Data Plate Wind Zone: 2

Permit #:

Note:

**STATE OF FLORIDA
INSTALLATION CERTIFICATION LABEL**

125978

LABEL #	DATE OF INSTALLATION
JOHN P. HARDEN	
NAME	
IH / 1150540 / 1	6866
LICENSE #	ORDER #

CERTIFIES THAT THE INSTALLATION OF THIS MOBILE HOME IS IN ACCORDANCE WITH FLORIDA STATUTES 320.8249, 320.8325 AND RULES OF THE HIGHWAY SAFETY AND MOTOR VEHICLES.

INSTRUCTIONS

PLEASE WRITE DATE OF INSTALLATION AND AFFIX LABEL NEXT TO HUD LABEL. USE PERMANENT INK PEN OR MARKER ONLY. COMPLETE INFORMATION ABOVE AND KEEP ON FILE FOR A MINIMUM OF 2 YEARS. YOU ARE REQUIRED TO PROVIDE COPIES WHEN REQUESTED.