

License Number: IH / 1129420 / 1 Name: DAVID E ALBRIGHT

Order #: 6744	Label #: 123587	Manufacturer: <i>LIVE OAK</i>	(Check Size of Home)
Homeowner: <i>DUDLEY</i>		Year Model: <i>2023</i>	Single <input type="checkbox"/>
Address: <i>430 SE MARINO WAY</i>		Length & Width: <i>56/60 x 32</i>	Double <input checked="" type="checkbox"/>
City/State/Zip: <i>HIGHSPRING FL 32643</i>		Type Longitudinal System: <i>OTI 6</i>	Triple <input type="checkbox"/>
Phone #:		Type Lateral Arm System: <i>OTI 6</i>	HUD Label #:
Date Installed:		New Home: <input checked="" type="checkbox"/> Used Home: <input type="checkbox"/>	Soil Bearing / PSF:
Installed Wind Zone: <i>EF</i>		Data Plate Wind Zone: <i>EF</i>	Torque Probe / in-lbs:
Note:			

STATE OF FLORIDA  
INSTALLATION CERTIFICATION LABEL  
123587

LABEL #	DATE OF INSTALLATION
DAVID E ALBRIGHT	
NAME	
IH / 1129420 / 1	6744
LICENSE #	ORDER #
CERTIFIES THAT THE INSTALLATION OF THIS MOBILE HOME IS IN ACCORDANCE WITH FLORIDA STATUTES 320.8249, 320.8325 AND RULES OF THE HIGHWAY SAFETY AND MOTOR VEHICLES.	

#### INSTRUCTIONS


PLEASE WRITE DATE OF  
INSTALLATION AND AFFIX  
LABEL NEXT TO HUD LABEL.  
USE PERMANENT INK PEN  
OR MARKER ONLY.  
COMPLETE INFORMATION  
ABOVE AND KEEP ON FILE  
FOR A MINIMUM OF 2 YEARS.  
YOU ARE REQUIRED TO  
PROVIDE COPIES WHEN  
REQUESTED.

# Mobile Home Permit Worksheet DW

Installer: DAVID AIBRIGHT License # 14-1129420  
 Address of home being installed 430 SE Marino Way High Springs FL 32643  
10-7s-17-09984-005  
 Manufacturer Live Oak Length x width 32x56/60

**NOTE:** if home is a single wide fill out one half of the blocking plan  
 if home is a triple or quad wide sketch in remainder of home  
 I understand Lateral Arm Systems cannot be used on any home (new or used)  
 where the sidewall ties exceed 5 ft 4 in.

Typical pier spacing

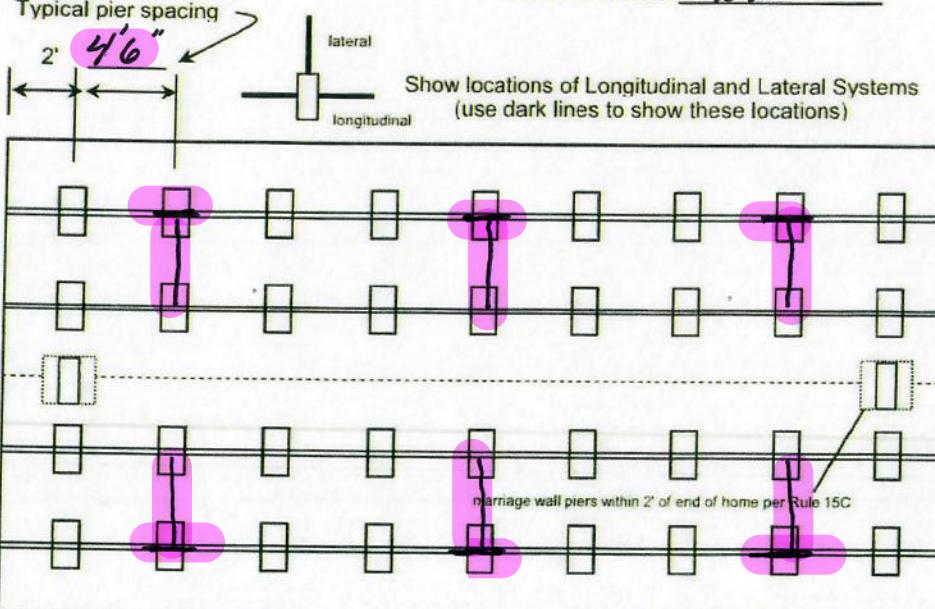

Installer's initials elt

Application Number: \_\_\_\_\_

Date: \_\_\_\_\_

New Home  Used Home

Home installed to the Manufacturer's Installation Manual   
 Home is installed in accordance with Rule 15-C

Single wide  Wind Zone II  Wind Zone III

Double wide  Installation Decal # 123587  
 Triple/Quad  Serial # LOHGA10023588AB

## PIER SPACING TABLE FOR USED HOMES

Load bearing capacity	Footer size (sq in)	16" x 16" (256)	18 1/2" x 18 1/2" (342)	20" x 20" (400)	22" x 22" (484)*	24" X 24" (576)*	26" x 26" (676)
1000 psf	3'	4'	5'	6'	7'	8'	
1500 psf	4' 6"	6'	7'	8'	8'	8'	
2000 psf	6'	8'	8'	8'	8'	8'	
2500 psf	7' 6"	8'	8'	8'	8'	8'	
3000 psf	8'	8'	8'	8'	8'	8'	
3500 psf	8'	8'	8'	8'	8'	8'	

\* interpolated from Rule 15C-1 pier spacing table.

## PIER PAD SIZES

I-beam pier pad size 17x25

Perimeter pier pad size 16x16

Other pier pad sizes (required by the mfg.) 17x22, 34x22

Draw the approximate locations of marriage wall openings 4 foot or greater. Use this symbol to show the piers.

List all marriage wall openings greater than 4 foot and their pier pad sizes below.

Opening

Pier pad size

FACTORY

DIAGRAM

+ ft 5 ft

## FRAME TIES

within 2' of end of home spaced at 5' 4" oc

## OTHER TIES

Number 29  
 Sidewall 6  
 Longitudinal 6  
 Marriage wall 6-3' 5-4'  
 Shearwall 4

## TIEDOWN COMPONENTS

Longitudinal Stabilizing Device (LSD) OLIVER TECHNOLOGIES 6  
 Manufacturer OLIVER TECHNOLOGIES  
 Longitudinal Stabilizing Device w/ Lateral Arms OLIVER TECHNOLOGIES 6  
 Manufacturer OLIVER TECHNOLOGIES

# Mobile Home Permit Worksheet

Application Number: \_\_\_\_\_ Date: \_\_\_\_\_

## POCKET PENETROMETER TEST

The pocket penetrometer tests are rounded down to \_\_\_\_\_ psf or check here to declare 1000 lb. soil  without testing.

## POCKET PENETROMETER TESTING METHOD

1. Test the perimeter of the home at 6 locations.
2. Take the reading at the depth of the footer.
3. Using 500 lb. increments, take the lowest reading and round down to that increment.

## TORQUE PROBE TEST

The results of the torque probe test is **250** inch pounds or check here if you are declaring 5' anchors without testing. A test showing 275 inch pounds or less will require 5 foot anchors.

**Note:** A state approved lateral arm system is being used and 4 ft. anchors are allowed at the sidewall locations. I understand 5 ft anchors are required at all centerline tie points where the torque test reading is 275 or less and where the mobile home manufacturer may requires anchors with 4000 lb holding capacity.

*NOT*

Installer's initials

## ALL TESTS MUST BE PERFORMED BY A LICENSED INSTALLER

Installer Name

DAVID ABBRIGHT MOBILE HOME SVC

Date Tested

## Electrical

Connect electrical conductors between multi-wide units, but not to the main power source. This includes the bonding wire between multi-wide units. Pg. **64-68**

## Plumbing

Connect all sewer drains to an existing sewer tap or septic tank. Pg. **70**

Connect all potable water supply piping to an existing water meter, water tap, or other independent water supply systems. Pg. **107**



## Site Preparation

Debris and organic material removed   
Water drainage: Natural  Swale  Pad  Other

## Fastening multi wide units

Floor: Type Fastener: **LAG** Length: **6"** Spacing: **2'**  
Walls: Type Fastener: **SCREW** Length: **4"** Spacing: **18"**  
Roof: Type Fastener: **LAG** Length: **6"** Spacing: **2'**  
For used homes a min. 30 gauge, 8" wide, galvanized metal strip will be centered over the peak of the roof and fastened with galv. roofing nails at 2" on center on both sides of the centerline.

## Gasket (weatherproofing requirement)

I understand a properly installed gasket is a requirement of all new and used homes and that condensation, mold, mildew and buckled marriage walls are a result of a poorly installed or no gasket being installed. I understand a strip of tape will not serve as a gasket.

Installer's initials

Type gasket  
Pg. **36**

Installed:  
Between Floors Yes   
Between Walls Yes **END WALLS**   
Bottom of ridgebeam Yes

## Weatherproofing

The bottomboard will be repaired and/or taped. Yes  Pg. **119**  
Siding on units is installed to manufacturer's specifications Yes  
Fireplace chimney installed so as not to allow intrusion of rain water. Yes

## Miscellaneous


Skirting to be installed. Yes  No   
Dryer vent installed outside of skirting. Yes  N/A   
Range downflow vent installed outside of skirting. Yes  N/A   
Drain lines supported at 4 foot intervals. Yes   
Electrical crossovers protected. Yes   
Other: \_\_\_\_\_

Installer verifies all information given with this permit worksheet is accurate and true based on the manufacturer's installation instructions and or Rule 15C-1 & 2


Installer Signature

Date

# HOR.ZON

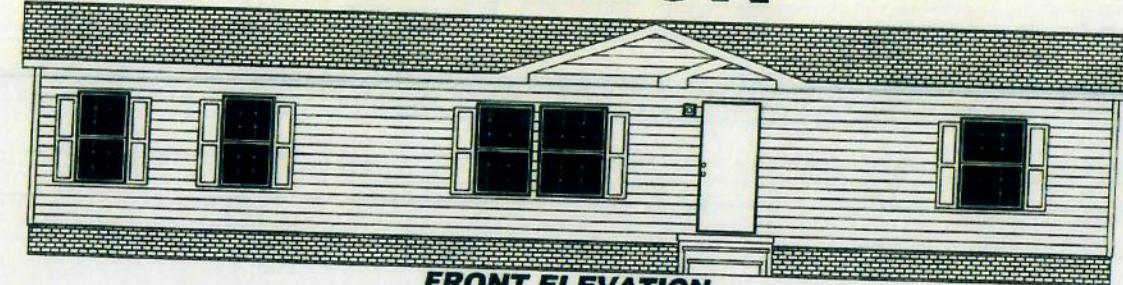

FRONT ELEVATION

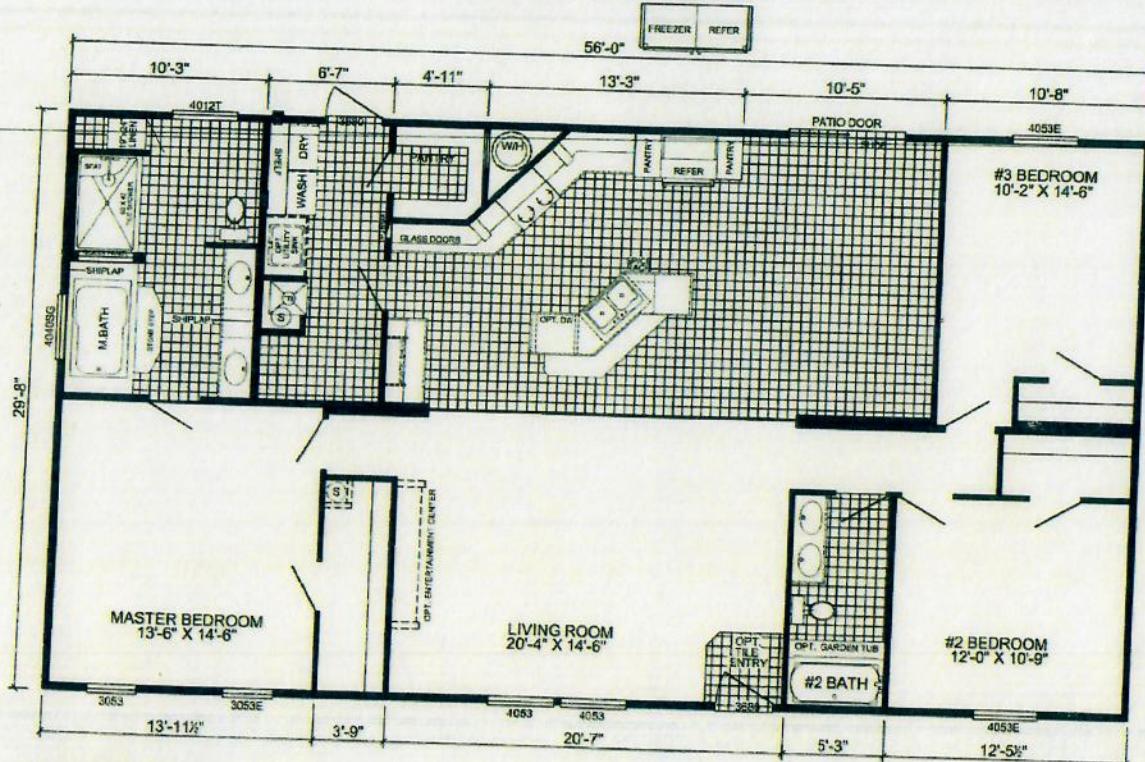


**U-3563E-OAK**  
**3-BEDROOM / 2-BATH**  
**32 X 60 - Approx. 1661 Sq. Ft.**

Date: 06/04/19

- \* All room dimensions include closets and square footage figures are approximate.
- \* Transom windows are available on optional 9'-0" sidewall houses only.
- \* Live Oak Homes reserves the right to modify product offering at any time.
- \* Skirting shown is optional.
- \* Small dormer is optional only.

6/19/2019 4:54:01 PM


**OAKS**  
*Signature*  
 Series

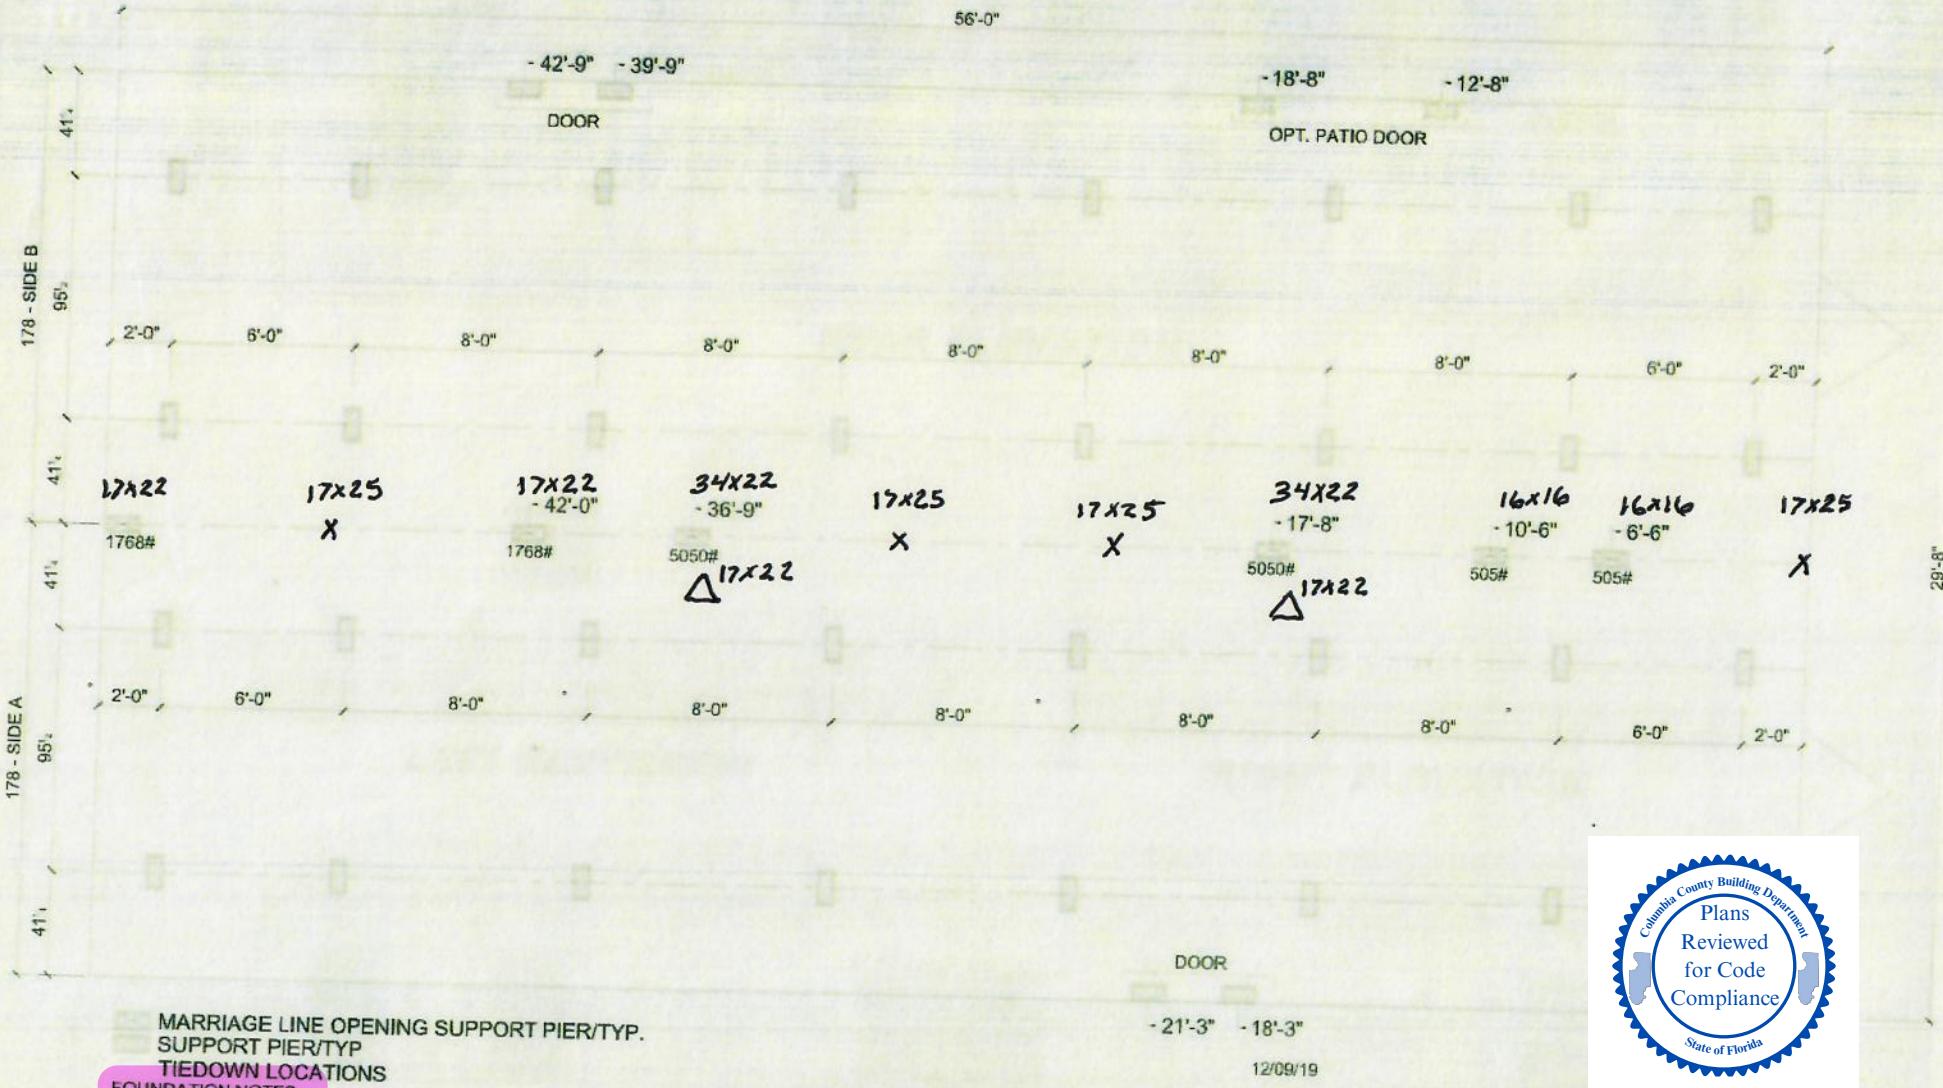

**Live Oak Homes**  
**MODEL: U-3563E-SIG - 32 X 60**  
**3-BEDROOM / 2-BATH**

HORIZON

**U-3563E-SIG**

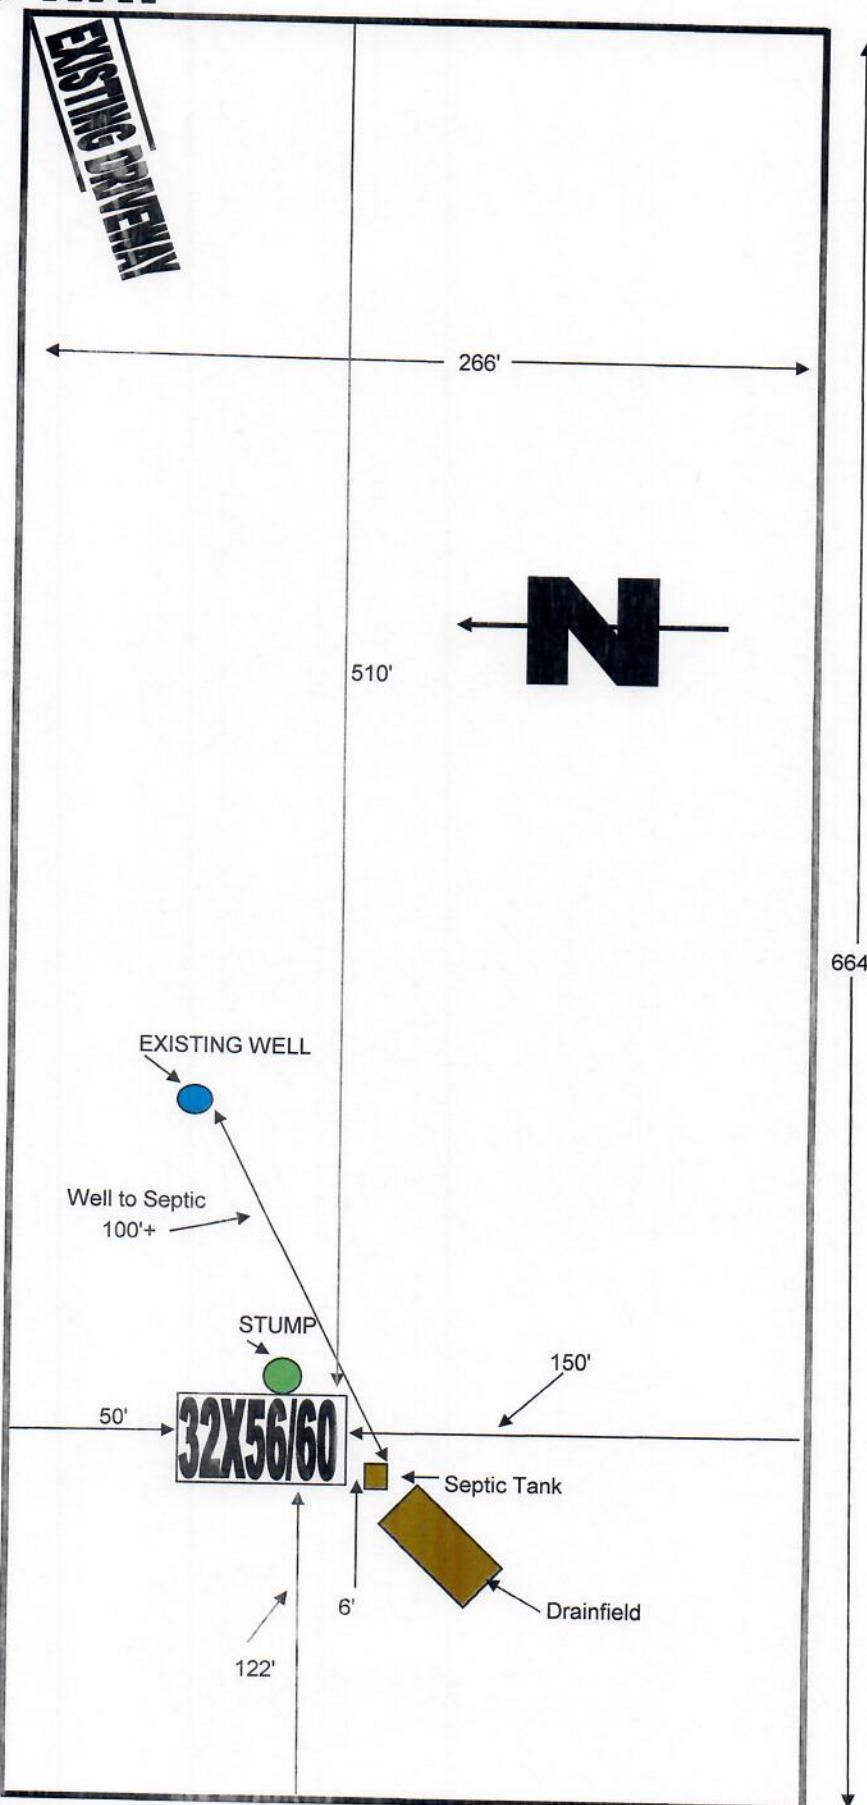1 SE MARINO WAY  
2

BUYER

DUDLEY, WILLIAM

ACREAGE

4.06

PARCEL ID#

10-7S-17-09984-005

DATE DRAWN

9/13/2025

DEALER: STARS &amp; STRIPES 386-365-8549