




Mobile Home Permit Worksheet

Installer Malik Williams License # Th1163066
 Address of home being installed 237 NE Tomlin Dr
 Manufacturer Westfield Homes Length x width 16 x 80

NOTE: If home is a single wide fill out one half of the blocking plan
 If home is a triple or quad wide sketch in remainder of home
 I understand Lateral Arm Systems cannot be used on any home (new or used)
 where the sidewall ties exceed 5 ft 4 in.

Installer's initials MW

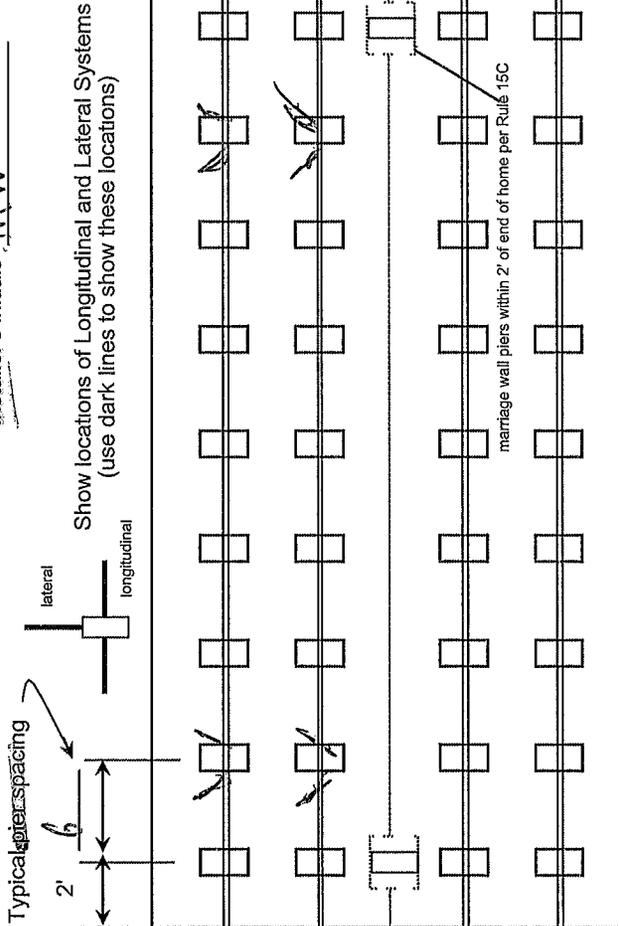

Permit Number: _____ Date: _____

New Home Used Home

Home installed to the Manufacturer's Installation Manual
 Home is installed in accordance with Rule 15-C

Single wide Wind Zone II Wind Zone III
 Double wide Installation Decal # _____
 Triple/Quad Serial # CALL507A34024

PIER SPACING TABLE FOR USED HOMES

Load bearing capacity	Footer size (sq m)	16" x 16" (256)	18 1/2" x 18 1/2" (342)	20" x 20" (400)	22" x 22" (484)*	24" x 24" (576)*	26" x 26" (676)
1000 psf	3'	3'	4'	5'	6'	7'	8'
1500 psf	4'6"	4'6"	6'	7'	8'	8'	8'
2000 psf	6'	6'	8'	8'	8'	8'	8'
2500 psf	7'6"	7'6"	8'	8'	8'	8'	8'
3000 psf	8'	8'	8'	8'	8'	8'	8'
3500 psf	8'	8'	8'	8'	8'	8'	8'

*interpolated from Rule 15C-1 pier spacing table.

POPULAR PAD SIZES

Pad Size	Sq In
16 x 16	256
16 x 18	288
18.5 x 18.5	342
16 x 22.5	360
17 x 22	374
13 1/2 x 26 1/2	348
20 x 20	400
17 3/16 x 25 3/16	441
17 1/2 x 25 1/2	446
24 x 24	576
26 x 26	676

I-beam pier pad size 24 x 24
 Perimeter pier pad size 16 x 16
 Other pier pad sizes (required by the mfg.) _____

Draw the approximate locations of marriage wall openings 4 foot or greater. Use this symbol to show the piers.

List all marriage wall openings greater than 4 foot and their pier pad sizes below.

Opening _____ Pier pad size 24x24

_____ Pier pad size _____

_____ Pier pad size _____

_____ Pier pad size _____

ANCHORS

FRAME TIES

within 2' of end of home spaced at 5' 4" oc _____

DOWN-COMPONENTS

Longitudinal Stabilizing Device (LSD)

Manufacturer _____

Longitudinal Stabilizing Device w/ Lateral Arms

Manufacturer LSD LSO

OTHER TIES

Number _____

Sidewall _____

Longitudinal _____

Marriage Wall _____

Shear Wall _____



Mobile Home Permit Worksheet

POCKET PENETROMETER TEST

The pocket penetrometer tests are rounded down to _____ psf or check here to declare 1000 lb. soil _____ without testing.

x/500 x/500 x/500

POCKET PENETROMETER TESTING METHOD

1. Test the perimeter of the home at 6 locations.
2. Take the reading at the depth of the footer.
3. Using 500 lb. increments, take the lowest reading and round down to that increment.

x/500 x/500 x/500

TORQUE PROBE TEST

The results of the torque probe test is 2500 inch pounds or check here if you are declaring 5' anchors without testing _____. A test showing 275 inch pounds or less will require 5' anchors.

Note: A state approved lateral arm system is being used and 4 ft. anchors are allowed at the sidewall locations. I understand 5' anchors are required at all centerline tie points where the torque test reading is 275 or less and where the mobile home manufacturer may require anchors with 4000 lb. holding capacity.

Installer's initials MW

ALL TESTS MUST BE PERFORMED BY A LICENSED INSTALLER

Installer Name Maikr Williams

Date Tested 2/20/26

ELECTRICAL

Connect electrical conductors between multi-wide units, but not to the main power source. This includes the bonding wire between multi-wide units. Pg. _____

PLUMBING

Connect all sewer drains to an existing sewer tap or septic tank. Pg. _____

Connect all potable water supply piping to an existing water meter, water tap, or other independent water supply systems. Pg. _____

Permit Number: _____ Date: _____

Site Preparation

Debris and organic material removed _____
Water drainage Natural _____ Swale _____ Pad Other _____

Fastening multi wide units

Floor- Type Fastener _____ Length: _____ Spacing: _____
Walls- Type Fastener _____ Length _____ Spacing _____
Roof- Type Fastener _____ Length _____ Spacing _____

For used homes a min. 30 gauge, 8" wide, galvanized metal strip will be centered over the peak of the roof and fastened with galv. roofing nails at 2" on center on both sides of the centerline.

Gasket (weatherproofing requirement)

I understand a properly installed gasket is a requirement of all new and used homes and that condensation, mold, mildew and buckled marriage walls are a result of a poorly installed or no gasket being installed. I understand a strip of tape will not serve as a gasket.

Installer's initials MW

Type gasket: _____ Installed: _____

Pg. _____ Between Floors _____ Yes _____
Between Walls _____ Yes _____
Bottom of ridge beam _____ Yes _____

Weatherproofing

The bottom board will be repaired and/or taped. _____ Yes _____ Pg. _____
Siding on units is installed to manufacturer's specifications. _____ Yes _____
Fireplace chimney installed so as not to allow intrusion of rain water. _____ Yes _____

Miscellaneous

Skirting to be installed. _____ Yes _____ No _____ N/A _____
Dryer vent installed outside of skirting. _____ Yes _____ No _____ N/A _____
Range downflow vent installed outside of skirting. _____ Yes _____ No _____ N/A _____
Drain lines supported at 4' intervals. _____ Yes No _____ N/A _____
Electrical crossovers protected. _____ Yes No _____ N/A _____
Other: _____

Installer verifies all information given with this permit worksheet is accurate and true based on the manufacturer's installation instructions and or Rule 15C-1 & 2

Installer's Signature Maikr Williams Date 2/20/26