




## Mobile Home Permit Worksheet

Installer: Rusty Knowles License # 1H1038219  
 Address of home being installed 803 SW MARIS TERR. LAKE CITY, FL  
32024  
 Manufacturer Live Oak Homes Length x width 16x60

NOTE: If home is a single wide fill out one half of the blocking plan  
 If home is a triple or quad wide sketch in remainder of home  
 I understand Lateral Arm Systems cannot be used on any home (new or used)  
 where the sidewall ties exceed 5 ft 4 in.

Installer's initials RLK

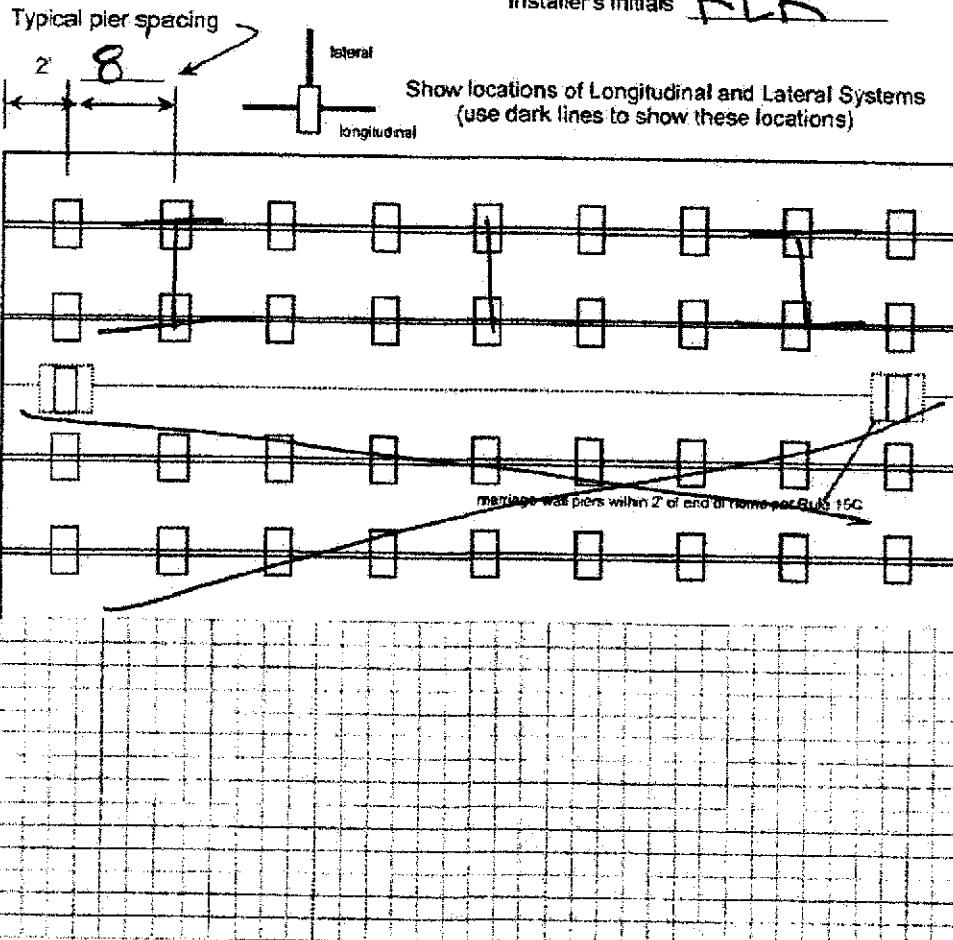

Permit Number:

Date: 10/30/25

New Home  Used Home

Home installed to the Manufacturer's Installation Manual  
 Home is installed in accordance with Rule 15-C

Single wide  Wind Zone II  Wind Zone III  
 Double wide  Installation Decal # 121747  
 Triple/Quad  Serial # ordered

### PIER SPACING TABLE FOR USED HOMES

Load bearing capacity (sq in)	Footer size	16" x 16" (256)	18 1/2" x 18 1/2" (342)	20" x 20" (400)	22" x 22" (484)*	24" X 24" (576)*	26" x 26" (870)
1000 psf	3'	4'	5'	6'	7'	8'	8'
1500 psf	4 1/2'	6'	7'	8'	8'	8'	8'
2000 psf	6'	8'	8'	8'	8'	8'	8'
2500 psf	7 1/2'	8'	8'	8'	8'	8'	8'
3000 psf	8'	8'	8'	8'	8'	8'	8'
3500 psf	8'	8'	8'	8'	8'	8'	8'

\*Interpolated from Rule 15C-1 pier spacing table.

### I-beam pier pad size

17.5 x 25.5

### Perimeter pier pad size

12.4

### Other pier pad sizes (required by the mfg.)

16x16

Draw the approximate locations of marriage wall openings 4 foot or greater. Use this symbol to show the piers.

List all marriage wall openings greater than 4 foot and their pier pad sizes below.

Opening Pier pad size

NA

### POPULAR PAD SIZES

Pad Size	Sq. in
15 x 16	256
16 x 18	288
18.5 x 18.5	342
16 x 22.5	360
17 x 22	374
13 1/4 x 26 1/4	348
20 x 20	400
17 3/16 x 25 3/16	441
17 1/2 x 25 1/2	446
24 x 24	576
26 x 26	676

4 ft  5 ft

### ANCHORS

### FRAME TIES

within 2' of end of home  
spaced at 5' 4" oc

### OTHER TIES

Sidewall  
Longitudinal  
Marriage Wall  
Shear Wall  
Number 10

### TIEDOWN COMPONENTS

#### Longitudinal Stabilizing Device (LSD)

Manufacturer None

#### Longitudinal Stabilizing Device w/ Lateral Arms

Manufacturer None



## Mobile Home Permit Worksheet

### POCKET PENETROMETER TEST

The pocket penetrometer tests are rounded down to 1500 psf or check here to declare 1000 lb. soil        without testing.

5                 

### POCKET PENETROMETER TESTING METHOD

1. Test the perimeter of the home at 6 locations.
2. Take the reading at the depth of the footer.
3. Using 500 lb. increments, take the lowest reading and round down to that increment.

### TORQUE PROBE TEST

The results of the torque probe test is 111 inch pounds or check here if you are declaring 5' anchors without testing       . A test showing 275 inch pounds or less will require 5' anchors. 111

Note: A state approved lateral arm system is being used and 4 ft. anchors are allowed at the sidewall locations. I understand 5' anchors are required at all centerline tie points where the torque test reading is 275 or less and where the mobile home manufacturer may require anchors with 4000 lb. holding capacity.

Installer's initials RLK

### ALL TESTS MUST BE PERFORMED BY A LICENSED INSTALLER

Installer Name Rusty Knowles

Date Tested 10/30/25

### ELECTRICAL

Connect electrical conductors between multi-wide units, but not to the main power source. This includes the bonding wire between multi-wide units. Pg. 15C1

### PLUMBING

Connect all sewer drains to an existing sewer tap or septic tank. Pg. 15C1

Connect all potable water supply piping to an existing water meter, water tap, or other independent water supply systems. Pg. 15C1

Permit Number: \_\_\_\_\_

Date: 10/30/25

### Site Preparation

Debris and organic material removed   
Water drainage: Natural  Swale  Pad  Other

### Fastening multi-wide units

Floor- Type Fastener: Logs Length: 13" Spacing: 20  
Walls- Type Fastener: Screws Length: 6" Spacing: 24  
Roof- Type Fastener: Straps Length: 13/4" Spacing: 18

For used homes a min. 30 gauge, 8" wide, galvanized metal strip will be centered over the peak of the roof and fastened with galv. roofing nails at 2" on center on both sides of the centerline.

### Gasket (weatherproofing requirement)

I understand a properly installed gasket is a requirement of all new and used homes and that condensation, mold, mildew and buckled marriage walls are a result of a poorly installed or no gasket being installed. I understand a strip of tape will not serve as a gasket.

Installer's initials RLK

Type gasket \_\_\_\_\_

factory  
installed

Installed:

Between Floors  Yes   
Between Walls  Yes   
Bottom of ridge beam  Yes

### Weatherproofing

The bottom board will be repaired and/or taped.  Yes  Pg. 15C1  
Siding on units is installed to manufacturer's specifications.  Yes   
Fireplace chimney installed so as not to allow intrusion of rain water.  Yes


### Miscellaneous

Skirting to be installed.  Yes  No  N/A   
Dryer vent installed outside of skirting.  Yes  No  N/A   
Range downflow vent installed outside of skirting.  Yes  No  N/A   
Drain lines supported at 4' intervals.  Yes  No  N/A   
Electrical crossovers protected.  Yes  No  N/A   
Other: \_\_\_\_\_

Installer verifies all information given with this permit worksheet is accurate and true based on the manufacturer's installation instructions and or Rule 15C-1 & 2

Installer's Signature

Date 10/30/25

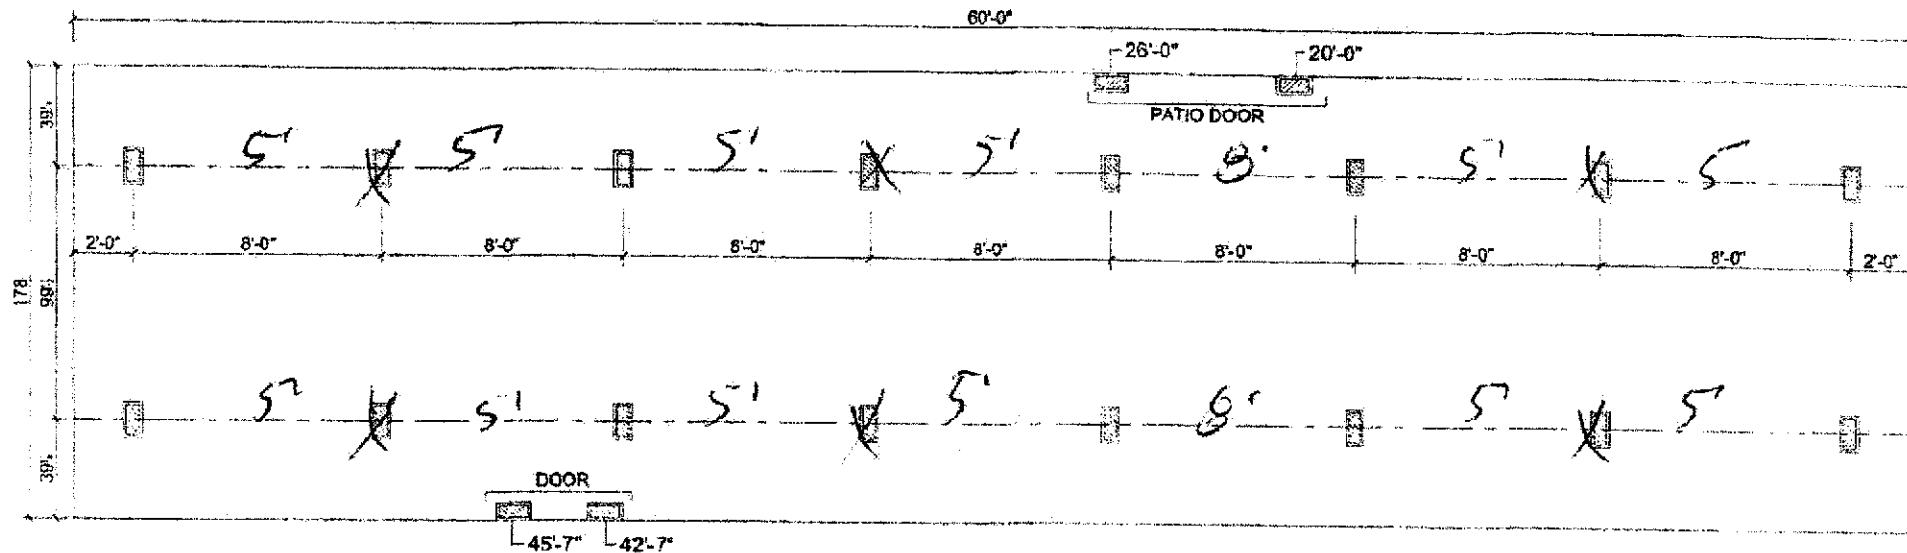

### **SUPPORT PIER/TYP**

06/22/22

#### FOUNDATION NOTES:

- THIS DRAWING IS DESIGNED FOR THE STANDARD WIND ZONE AND IS TO BE USED IN CONJUNCTION WITH THE INSTALLATION MANUAL AND ITS SUPPLEMENTS.
- FOOTINGS ARE SHOWN FOR EXAMPLE ONLY QUANTITY AND SPACING MAY VARY BASED ON PAD TYPE, SOIL CONDITION, ETC.
- FOOTINGS ARE REQUIRED AT SUPPORT POSTS, SEE INSTALLATION MANUAL FOR REQUIREMENTS.

## **Live Oak Homes**

**MODEL: M-5602A - 16 X 60 (BOX)**

## **2-BEDROOM / 2-BATH**

**(99.5" I-BEAM SPACING)**

M-5602A

License Number: IH / 1038219 / Name: RUSTY L KNOWLES

Order #: 6673	Label #: 121742	Manufacturer: _____	(Check Size of Home)
Homeowner: _____	Address: _____	Year Model: _____	Single _____
City/State/Zip: _____	Date installed: _____	Length & Width: _____	Double _____
Phone #: _____	Installed Wind Zone: _____	Type Lateral Arm System: _____	Triple _____
Label #: 121742	New Home: _____ Used Home: _____	Date Plate Wind Zone: _____	HUD Label #: _____
NAME: RUSTY L KNOWLES	Label #: 121742	Permit #: _____	Torque Probe / in-lbs: _____
DATE OF INSTALLATION: 08/21/19	INSTRUCTIONS		
<p>PLEASE WRITE DATE OF INSTALLATION AND AFFIX LABEL NEXT TO HUD LABEL. USE PERMANENT INK PEN OR MARKER ONLY.</p> <p>COMPLETE INFORMATION ABOVE AND KEEP ON FILE FOR A MINIMUM OF 2 YEARS. YOU ARE REQUIRED TO PROVIDE COPIES WHEN REQUESTED.</p> <p>LICENSE #: IH / 1038219 / 1 ORDER #: 6673</p> <p>CERTIFIES THAT THE INSTALLATION OF THIS MOBILE HOME IS IN ACCORDANCE WITH FLORIDA STATUTES 320.8219, 320.8325 AND RULES OF THE HIGHWAY SAFETY AND MOTOR VEHICLES.</p>			