

Mobile Home Permit Worksheet

Application Number: _____

Date: _____

New Home ☒ Used Home ☐

Home installed to the Manufacturer's Installation Manual
Home is installed in accordance with Rule 15-C

Single wide ☐ Wind Zone II ☒ Wind Zone III ☐

Double wide ☒ Installation Decal # 107796

Triple/Quad ☐ Serial # 052-000-H-AS23032AB

Installer: Robert Sheppard License # H/10253266

Address of home being installed: 2220 SW Clintway

Lakecity FL 32924

Manufacturer: Champion Length x width: 48x26

NOTE: If home is a single wide fill out one half of the blocking plan
If home is a triple or quad wide sketch in remainder of home
I understand Lateral Arm Systems cannot be used on any home (new or used)
where the sidewall ties exceed 5 ft 4 in.


Installer's initials: RS

Typical pier spacing

lateral

longitudinal

Show locations of Longitudinal and Lateral Systems
(use dark lines to show these locations)

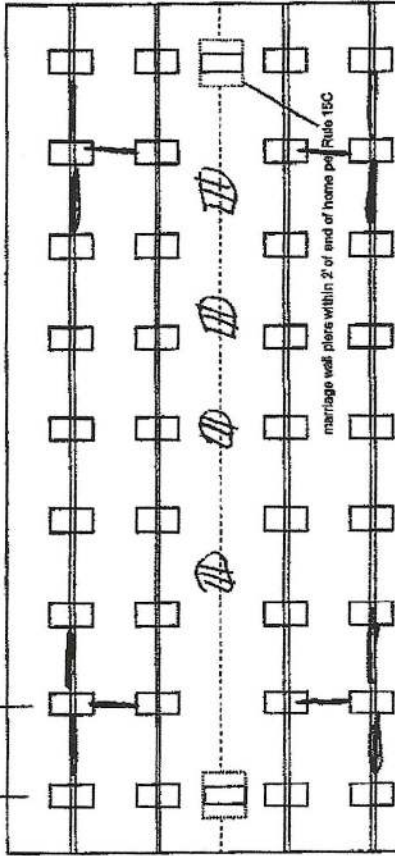

PIER SPACING TABLE FOR USED HOMES

Load bearing capacity (sq in)	16" x 16" (256)	18 1/2" x 16 1/2" (342)	20" x 20" (400)	22" x 22" (484)*	24" x 24" (576)*	26" x 26" (676)
1000 psf	3'	4'	5'	6'	7'	8'
1500 psf	4'	5'	6'	7'	8'	8'
2000 psf	5'	6'	7'	8'	8'	8'
2500 psf	6'	7'	8'	8'	8'	8'
3000 psf	7'	8'	8'	8'	8'	8'
3500 psf	8'	8'	8'	8'	8'	8'

* Interpolated from Rule 15C-1 pier spacing table.

PIER PAD SIZES

I-beam pier pad size

17x25

Perimeter pier pad size

16x16

Other pier pad sizes (required by the mfg.)

17x25

Draw the approximate locations of marriage wall openings 4 foot or greater. Use this symbol to show the piers.



List all marriage wall openings greater than 4 foot and their pier pad sizes below.

Opening

Pier pad size

4 ft 5 ft

ANCHORS

FRAME TIES

within 2' of end of home spaced at 5' 4" oc

TIEDOWN COMPONENTS

Longitudinal Stabilizing Device (LSD)

Manufacturer

Longitudinal Stabilizing Device w/ Lateral Arms

Manufacturer

01101V

OTHER TIES

Number

2

4

4

Mobile Home Permit Worksheet

POCKET PENETROMETER TEST

The pocket penetrometer tests are rounded down to 1500 psf or check here to declare 1000 lb. soil without testing.

x 1700 x 1600 x 1600

POCKET PENETROMETER TESTING METHOD

1. Test the perimeter of the home at 6 locations.
2. Take the reading at the depth of the footer.
3. Using 500 lb. increments, take the lowest reading and round down to that increment.

x 1700 x 1700 x 1600

TORQUE PROBE TEST

The results of the torque probe test is 290 inch pounds or check here if you are declaring 5" anchors without testing. A test showing 275 inch pounds or less will require 5 foot anchors.

Note: A state approved lateral arm system is being used and 4 ft. anchors are allowed at the sidewall locations. I understand 5 ft. anchors are required at all centerline tie points where the torque test reading is 275 or less and where the mobile home manufacturer may require anchors with 4000 lb. holding capacity.

ALL TESTS MUST BE PERFORMED BY A LICENSED INSTALLER

Installer Name

Date Tested

Robert Sheppard
11-05-25

Electrical

Connect electrical conductors between multi-wide units, but not to the main power source. This includes the bonding wire between multi-wide units. Pg. 25

Plumbing

Connect all sewer drains to an existing sewer tap or septic tank. Pg. 28
Connect all potable water supply piping to an existing water meter, water tap, or other independent water supply systems. Pg. 28

Application Number:

Date:

Site Preparation

Debris and organic material removed ☒ Swale ☒ Pad ☒ Other ☐

Fastening multi wide units

Floor: Type Fastener: 1035 Length: 5" Spacing: 16"
Walls: Type Fastener: 5045 Length: 4" Spacing: 16"
Roof: Type Fastener: 1045 Length: 6" Spacing: 16"
For used homes a min. 30 gauge, 8" wide, galvanized metal strip will be centered over the peak of the roof and fastened with galv. roofing nails at 2" on center on both sides of the centerline.

Gasket (weatherproofing requirement)

I understand a properly installed gasket is a requirement of all new and used homes and that condensation, mold, mildew and buckled marriage walls are a result of a poorly installed or no gasket being installed. I understand a strip of tape will not serve as a gasket.

Installer's initials

Type gasket
Pg. 19

Form

Installed:

Between Floors Yes ☒
Between Walls Yes ☒
Bottom of ridgebeam Yes ☒

Weatherproofing

The bottomboard will be repaired and/or taped. Yes ☒ Pg.
Siding on units is installed to manufacturer's specifications. Yes ☒
Fireplace chimney installed so as not to allow intrusion of rain water. Yes ☒

Miscellaneous

Skirting to be installed. Yes ☒ No ☐
Dryer vent installed outside of skirting. Yes ☒ N/A ☐
Range downflow vent installed outside of skirting. Yes ☒
Drain lines supported at 4 foot intervals. Yes ☒
Electrical crossovers protected. Yes ☒
Other:

Installer verifies all information given with this permit worksheet is accurate and true based on the manufacturer's installation instructions and or Rule 15C-1 & 2

Installer Signature


Date

Robert Sheppard
11-05-25

SEOGWICK

May 2020

Dustin Barwood

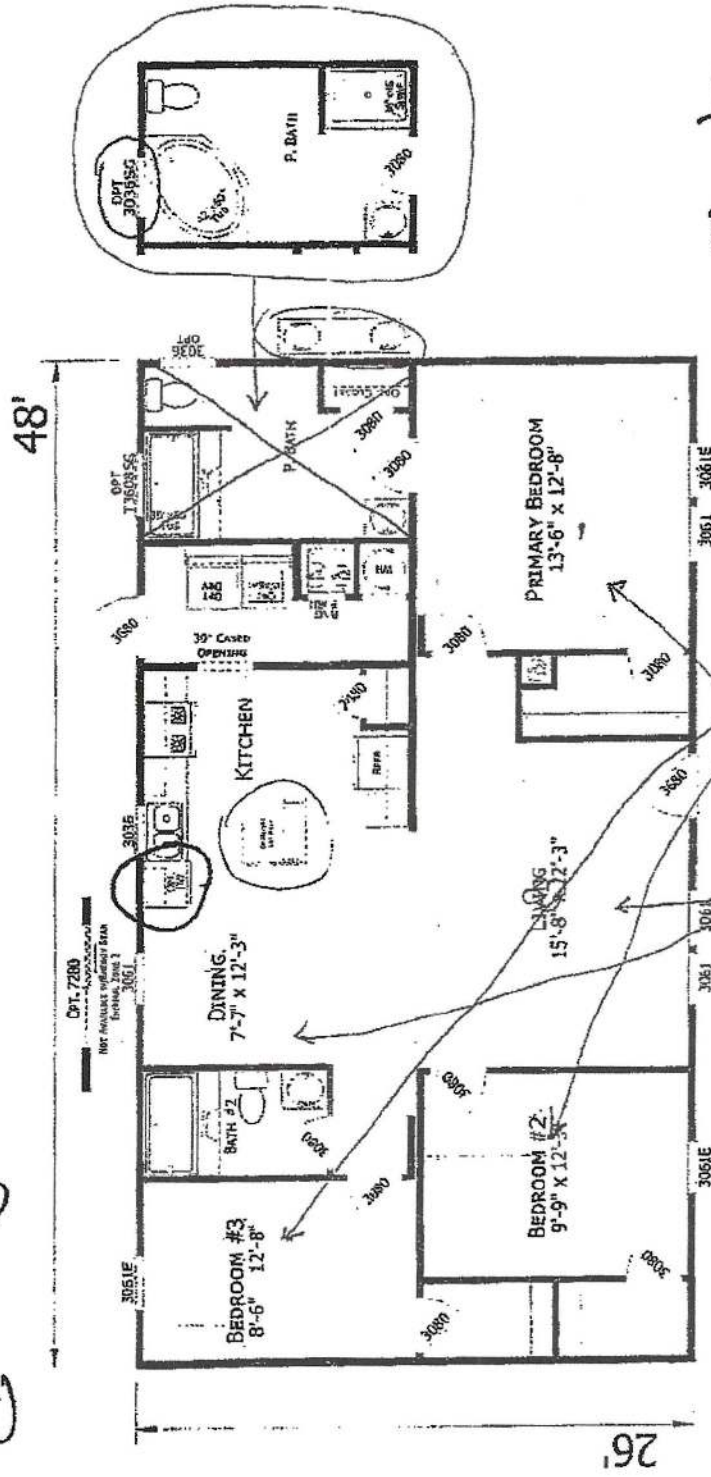

Shingles -
wood shavings

48'-0" X 26'-0"
1248 SQ. FT. TOTAL

PAINTED SHEETROCK
TAPE & TEXTURED

PAINTED SHEETROCK WITH CHAIR RAILS

**CHAMPION
HOME BUILDERS**

1969 年 4 月 15 日 星期四

052-2848-229-HRN
48'-0" X 26'-0"
3 BD 2 BT

LITERATURE
PLAN

0167: L-101

and the following conditions:

11.1111/1365-31十三.07.2014.0011


RECEIVED
JAN 10 1978

HOME BUILDERS

THE UNIVERSITY OF CHICAGO PRESS
CHICAGO, ILL. 60637

Cabinets - O-Zack Shadow
wall paint colors. See fifth page.
wall board - O-Zack Gaster.

Y.M. 65 - 192

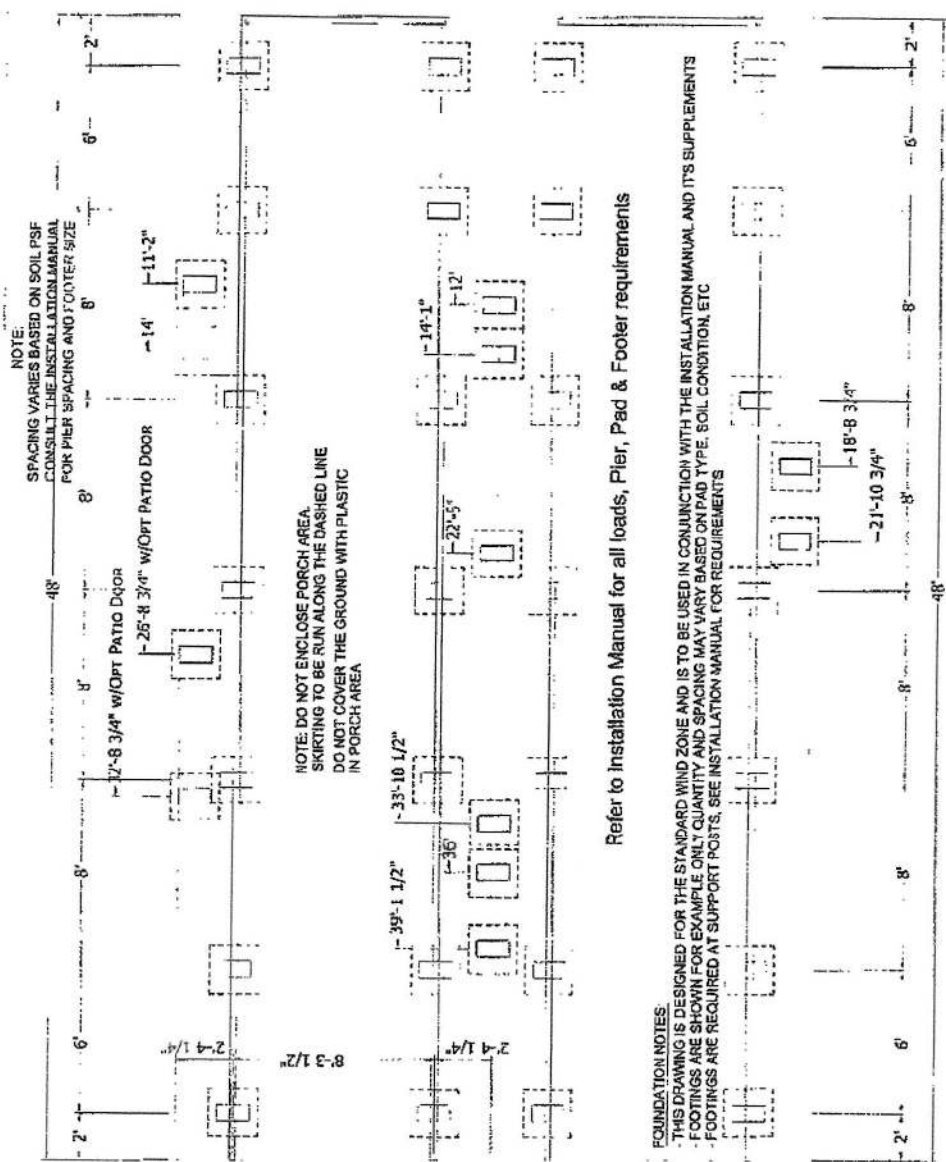

CHAMPION
HOME BUILDERS
 1418 WILSON AVENUE, SUITE 100, WILSON, NC 27157
 PHONE: 704.241.1000

PERMITS/PLANS

052-2848-229-HRN
 48'-0" X 26'-0"
 3 BD 2 BT
 1/2" = 1'-0"

PIER
 FOUNDATION
 PLAN

PR-101

PERMITS/PLANS