## **Mobile Home Permit Worksheet**

DOCKET DENETDONETED TEAT
POCKET PENETROMETER TEST
The pocket penetrometer tests are rounded down to psf or check here to declare 1000 lb. soil without testing.
x assumed x 1
Tion pst ~+
POCKET PENETROMETER TESTING METHOD
Test the perimeter of the home at 6 locations.
Take the reading at the depth of the footer.
Using 500 lb. increments, take the lowest reading and round down to that increment.
x x x
TORQUE PROBE TEST
The secults of the town
The results of the torque probe test is inch pounds or check here if you are declaring 5' anchors without testing . A test
showing 275 inch pounds or less will require 5 foot anchors.
Note: A state approved lateral arm system is being used and 4 ft. anchors are allowed at the sidewall locations. I understand 5 ft
anchors are required at all centerline tie points where the torque test
reading is 275 or less and where the mobile home manufacturer may requires anchors with 4000 lb holding capacity.
Installer's initials
ALL TESTS MUST BE PERFORMED BY A LICENSED INSTALLER
Installer Name Lonney Carmichael
Date Tested04-25-2024
10. 10 May 1
Electrical

Connect electrical conductors between multi-wide units, but not to the main power source. This includes the bonding wire between multi-wide units. Pg. 12-24

## Plumbing


Connect all sewer drains to an existing sewer tap or septic tank. Pg. 12-24

Connect all potable water supply piping to an existing water meter, water tap, or other independent water supply systems. Pg. 12-24

	Site Preparation
Debris a Water d	nd organic material removed \$\forall \subseteq \text{Pad}  Other  \text{.}
	Fastening multi wide units
Floor: Walls: Roof:	Type Fastener: Type Fastener: Strew Length: W" Spacing: 1'0 C Length: W" Spacing: 2'0 C Length: W" Spacing: 2'0 C Length: W" Spacing: 3'0 C Length: W" Spacing: 3'0 C Length: W" Spacing: 3'0 C Length: W" Spacing: 2'0 C Length:
	Gasket (weatherproofing requirement)
nomes a a result of of tape v	and a properly installed gasket is a requirement of all new and used nd that condensation, mold, meldew and buckled marriage walls are of a poorly installed or no gasket being installed. I understand a strip rill not serve as a gasket.  Installer's initials
Type gas Pg. 20	Installed: Between Floors Yes Between Walls Yes Bottom of ridgebeam Yes
	Weatherproofing
siding of	omboard will be repaired and/or taped. Yes . Pg. 20-25 units is installed to manufacturer's specifications. Yes chimney installed so as not to allow intrusion of rain water. Yes
	Miscellaneous
Oryer ver Range do Orain line	t installed Yes No at installed outside of skirting. Yes N/A swnflow vent installed outside of skirting. Yes N/A es supported at 4 foot intervals. Yes crossovers protected. Yes
	ler verifies all information given with this permit workshee is accurate and true based on the ufacturer's installation instructions and or Rule 15C-1 & 2
HILL COLUMN	

Installer Signature



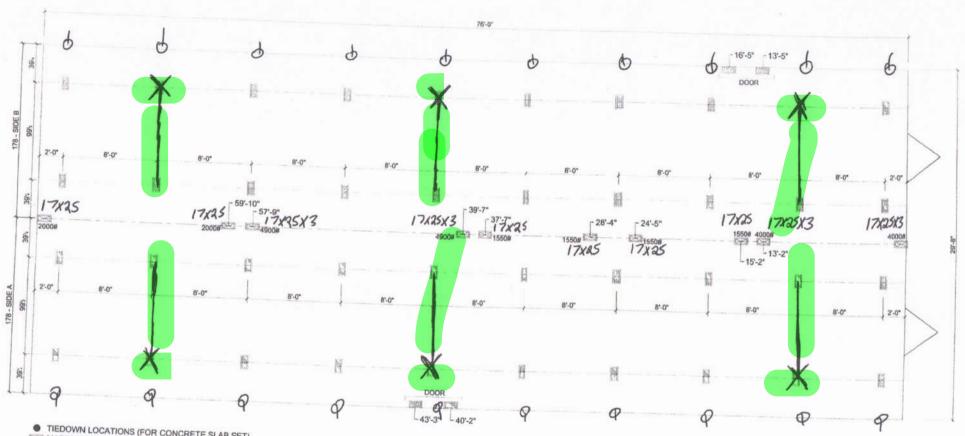

 TIEDOWN LOCATIONS (FOR CONCRETE SLAB SET) MARRIAGE LINE OPENING SUPPORT PIER/TYP.

REV: 09/22/22

SUPPORT PIER/TYP

FOUNDATION NOTES:

THIS DRAWING IS DESIGNED FOR THE STANDARD WIND ZONE AND IS TO BE USED IN CONJUNCTION WITH THE INSTALLATION MANUAL AND IT'S SUPPLEMENTS.
- FOOTINGS ARE SHOWN FOR EXAMPLE ONLY QUANTITY AND SPACING MAY VARY BASED ON PAD TYPE, SOIL CONDITION, ETC.
- FOOTINGS ARE REQUIRED AT SUPPORT POSTS, SEE INSTALLATION MANUAL FOR REQUIREMENTS.

Live Oak Homes MODEL: L-3764V - 32 X 80 4-BEDROOM / 2-BATH

Frame piers 4'0/C 17x25 Centerline per diagram

(99-1/2" I-BEAM SPACING)

L-3764V

Order #: 6158	Label #: 108781	Manufacturer: LIVE DAK	(Check Size of Home)	
Homeowner: JOha	nna Veras	Year Model: 20124	Single  Double  Triple	
Address:	tarlowe Pl.	Length & Width:		
City/State/Zip: LOK	City	Type Longitudinal System:	HUD Label #:	
Phone #:3 8 10 - 9	105-1314	Type Lateral Arm System:	Soil Bearing / PSF:	
Date Installed:		New Home:	Torque Probe / in-lbs:	
Installed Wind Zone:		Data Plate Wind Zone:	Permit #:	

108781	N CERTIFICATION LABEL
LABEL#	DATE OF INSTALLATION
RODNEY A. CARMICHAI	EL
NAME	
IH / 1025656 / 1	6158
IN ACCORDANCE WITH	ORDER# STALLATION OF THIS MOBILE HOME IS FLORIDA STATUTES 320,8249, 320,8325 SHWAY SAFETY AND MOTOR VEHICLES.

## INSTRUCTIONS

PLEASE WRITE DATE OF INSTALLATION AND AFFIX LABEL NEXT TO HUD LABEL. USE PERMANENT INK PEN OR MARKER ONLY. COMPLETE INFORMATION ABOVE AND KEEP ON FILE FOR A MINIMUM OF 2 YEARS. YOU ARE REQUIRED TO PROVIDE COPIES WHEN REQUESTED.