

COLUMBIA COUNTY PERMIT WORKSHEET

page 1 of 2

These worksheets must be completed and signed by the installer.
Submit the originals with the packet.

Installer Fernon Jones License # IH1025418

911 Address where home is being installed 528 S.W. Packard St
Lake City, FL 32025

Manufacturer West Length x width 14x66

NOTE: if home is a single wide fill out one half of the blocking plan
if home is a triple or quad wide sketch in remainder of home

I understand Lateral Arm Systems cannot be used on any home (new or used)
where the sidewall ties exceed 5 ft 4 in

Installer's initials F.J.

New Home ☐ Used Home ☒
Home installed to the Manufacturer's Installation Manual ☐
Home is installed in accordance with Rule 15-C ☒
Single wide ☒ Wind Zone II ☒ Wind Zone III ☐
Double wide ☐ Installation Decal # 8272
Triple/Quad ☐ Serial # GAFK07A18279WF
(425) provided

PIER SPACING TABLE FOR USED HOMES

Load bearing capacity	Footer size (sq in)	16" x 16" (256)	18 1/2" x 18 1/2" (342)	20" x 20" (400)	22" x 22" (484)*	24" x 24" (576)*	26" x 26" (676)
1000 psf	3'	4'	4'	5'	6'	7'	8'
1500 psf	4' 6"	6'	6'	7'	8'	8'	8'
2000 psf	6'	8'	8'	8'	8'	8'	8'
2500 psf	7' 6"	8'	8'	8'	8'	8'	8'
3000 psf	8'	8'	8'	8'	8'	8'	8'
3500 psf	8'	8'	8'	8'	8'	8'	8'

* interpolated from Rule 15C-1 pier spacing table.

PIER PAD SIZES

I-beam pier pad size 17x25
Perimeter pier pad size n/a
Other pier pad sizes (required by the mfg) 16x16

Draw the approximate locations of marriage wall openings 4 foot or greater Use this symbol to show the piers.

List all marriage wall openings greater than 4 foot and their pier pad sizes below

Opening n/a Pier pad size n/a
n/a n/a
n/a n/a

TIEDOWN COMPONENTS

Longitudinal Stabilizing Device (LSD)
Manufacturer Longitudinal Stabilizing Device w/ Lateral Arms
Manufacturer

OTHER TIES

Number 3
Sidewall 2
Longitudinal 1
Marriage wall 1
Shearwall

POPULAR PAD SIZES



Pad Size	Sq In
16 x 16	256
16 x 18	288
18 5/8 x 18 5/8	342
16 x 22 1/2	360
17 x 22	374
13 1/4 x 26 1/4	348
20 x 20	400
17 3/16 x 25 3/16	441
17 1/2 x 25 1/2	446
24 x 24	576
26 x 26	676

ANCHORS

4 ft ☒ 5 ft

FRAME TIES

within 2' of end of home spaced at 5' 4" oc

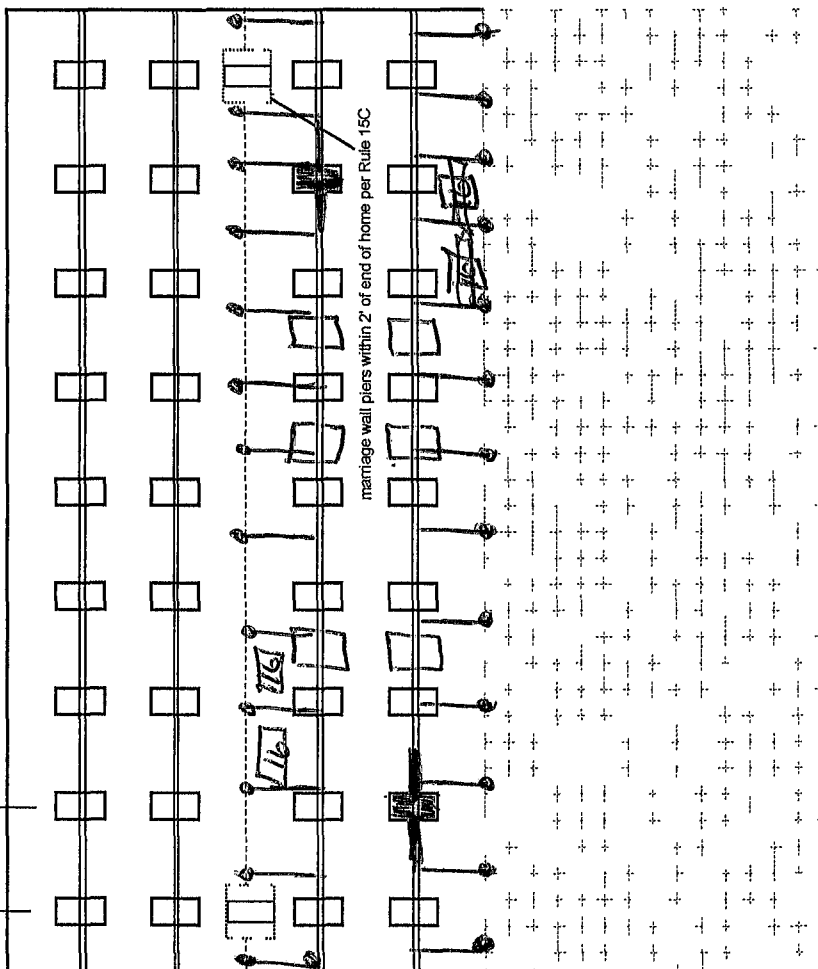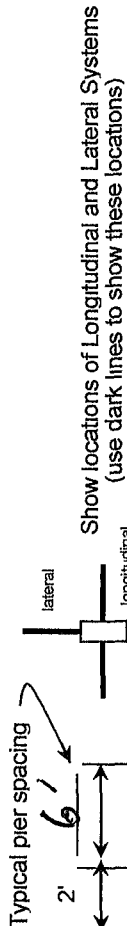

POCKET PENETROMETER TEST

The pocket penetrometer tests are rounded down to _____ psf
or check here to declare 1000 lb soil _____ without testing

x 2000 x 1500 x 2000

POCKET PENETROMETER TESTING METHOD

1. Test the perimeter of the home at 6 locations
2. Take the reading at the depth of the footer
3. Using 500 lb. increments, take the lowest reading and round down to that increment.

x 1500 x 2000 x 2000

TORQUE PROBE TEST

The results of the torque probe test is 3000 inch pounds or check here if you are declaring 5' anchors without testing _____ A test showing 275 inch pounds or less will require 5 foot anchors.

Note: A state approved lateral arm system is being used and 4 ft. anchors are allowed at the sidewall locations. I understand 5 ft anchors are required at all centerline tie points where the torque test reading is 275 or less and where the mobile home manufacturer may requires anchors with 4000 lb holding capacity.

F.J. Installer's initials

ALL TESTS MUST BE PERFORMED BY A LICENSED INSTALLER

Installer Name

Fernon Jones

Date Tested

3/3/12

Electrical

Connect electrical conductors between multi-wide units, but not to the main power source. This includes the bonding wire between multi-wide units. Pg n/a

Plumbing

Connect all sewer drains to an existing sewer tap or septic tank. Pg 15

Connect all potable water supply piping to an existing water meter, water tap, or other independent water supply systems. Pg 15

Site Preparation

Debris and organic material removed _____
Water drainage. Natural ☒ Swale _____ Pad _____ Other _____

Fastening multi wide units

Floor: Type Fastener: n/a Length _____ Spacing _____
Walls: Type Fastener: n/a Length _____ Spacing _____
Roof: Type Fastener: n/a Length _____ Spacing _____
For used homes & min. 30 gauge, 8" wide, galvanized metal strip will be centered over the peak of the roof and fastened with galv. roofing nails at 2" on center on both sides of the centerline

Gasket (weatherproofing requirement)

I understand a properly installed gasket is a requirement of all new and used homes and that condensation, mold, mildew and buckled marnage walls are a result of a poorly installed or no gasket being installed. I understand a strip of tape will not serve as a gasket.

Installer's initials F.J.

Type gasket n/a Installed:
Pg _____ Between Floors Yes n/a
Between Walls Yes n/a
Bottom of ridgebeam Yes n/a

Weatherproofing

The bottomboard will be repaired and/or taped Yes _____ Pg _____
Siding on units is installed to manufacturer's specifications Yes _____
Fireplace chimney installed so as not to allow intrusion of rain water Yes _____

Miscellaneous

Skirting to be installed Yes ☒ No owner
Dryer vent installed outside of skirting Yes ☒ N/A
Range downflow vent installed outside of skirting Yes ☒ N/A
Drain lines supported at 4 foot intervals Yes ☒ owner
Electrical crossovers protected Yes n/a
Other _____

Installer verifies all information given with this permit worksheet is accurate and true based on the

Installer Signature

Fernon Jones

Date 3/3/12