

PERMIT NUMBER

DIH000017

Corbett's Mobile Home Center



Address of home being installed

Manufacturer Deslanx Length x width 58' x 28'

NOTE: If home is a single wide fill out one half of the blocking plan
If home is a triple or quad wide sketch in remainder of home

I understand Lateral Arm Systems cannot be used on any home (new or used) where the sidewall ties exceed 5 ft 4 in.

Installer's initials RL

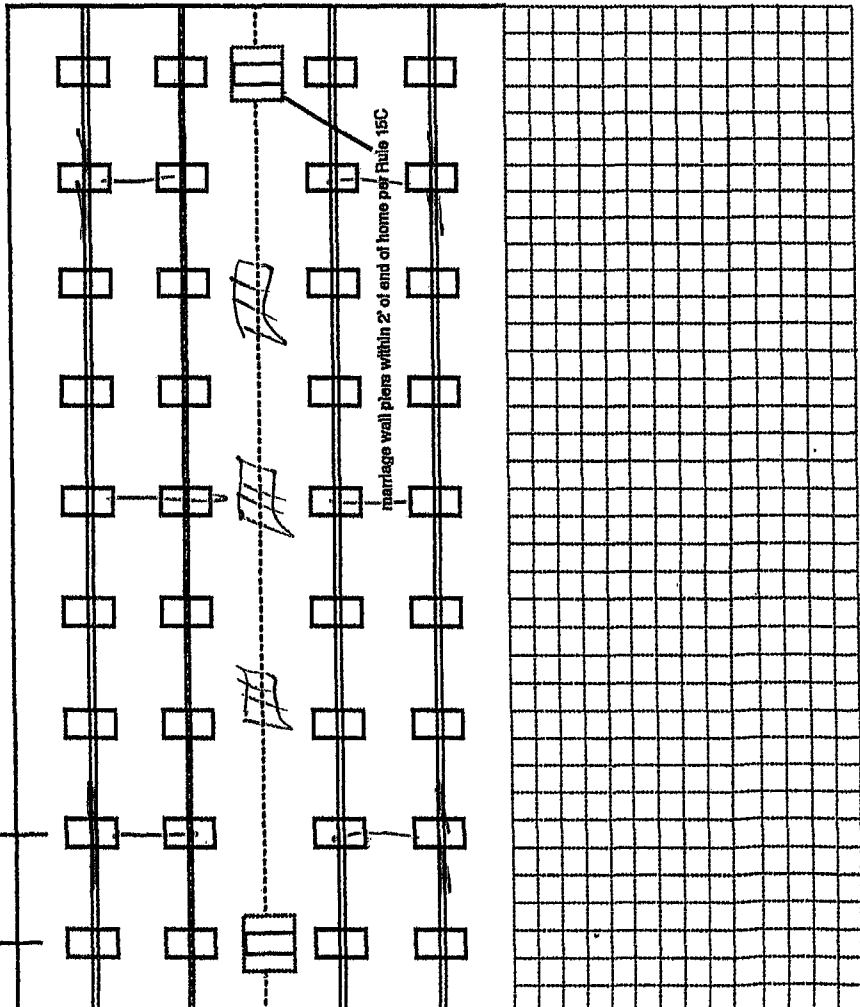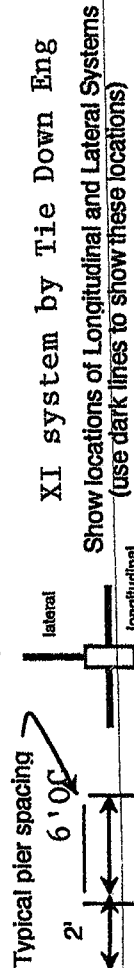

New Home ☒ Used Home ☐
Home installed to the Manufacturer's Installation Manual ☒
Home is installed in accordance with Rule 15-C ☐
Single wide ☐ Wind Zone II ☒ Wind Zone III ☐
Double wide ☒ Installation Decal # 15157
Triple/Quad ☐ Serial # 5960A+B

Roof System: ☒ Typical ☐ Hinged

PIER SPACING TABLE FOR USED HOMES

Load bearing capacity	Footer size (sq in)	16" x 16" (256)	18 1/2" x 18 1/2" (342)	20" x 20" (400)	22" x 22" (484)*	24" x 24" (576)*	26" x 26" (676)
1000 psf	3'	3'	4'	5'	6'	7'	8'
1500 psf	4' 6"	4' 6"	6'	7'	8'	8'	8'
2000 psf	6'	6'	8'	8'	8'	8'	8'
2500 psf	7' 6"	7' 6"	8'	8'	8'	8'	8'
3000 psf	8'	8'	8'	8'	8'	8'	8'
3500 psf	8'	8'	8'	8'	8'	8'	8'

* Interpolated from Rule 15C-1 pier spacing table.

PIER PAD SIZES

I-beam pier pad size 24 x 24 x 1
Perimeter pier pad size 24 x 24 x 1
Other pier pad sizes (required by the mfg.) _____

Draw the approximate locations of marriage wall openings 4 foot or greater. Use this symbol to show the piers.

List all marriage wall openings greater than 4 foot and their pier pad sizes below.

Opening 12' 0" Pier pad size 3 = 24 x 24 x 1

ANCHORS

4 ft ☒ 5 ft

FRAME TIES

within 2' of end of home spaced at 5' 4" oc 1/2"

OTHER TIES

Number 1/2"
Sidewall 1/2"
Longitudinal 1/2"
Marriage wall 1/2"
Shearwall 1/2"

TIEDOWN COMPONENTS

Longitudinal Stabilizing Device (LSD) Manufacturer Lie Down Eng
Longitudinal Stabilizing Device w/ Lateral Arms Manufacturer Lie Down Eng

PERMIT NUMBER

POCKET PENETROMETER TEST

The pocket penetrometer tests are rounded down to 2000 psf or check here to declare 1000 lb. soil without testing.

X1000 X1050 X1100

POCKET PENETROMETER TESTING METHOD

1. Test the perimeter of the home at 6 locations.
2. Take the reading at the depth of the footer.
3. Using 500 lb. increments, take the lowest reading and round down to that increment.

X1000 X1020 X1050

TORQUE PROBE TEST

The results of the torque probe test is 2-19 inch pounds or check here if you are declaring 5' anchors without testing. A test showing 275 inch pounds or less will require 5 foot anchors.

Note: A state approved lateral arm system is being used and 4 ft. anchors are allowed at the sidewall locations. I understand 5 ft anchors are required at all centerline tie points where the torque test reading is 275 or less and where the mobile home manufacturer may requires anchors with 4000 lb holding capacity.

Installer's initials

ALL TESTS MUST BE PERFORMED BY A LICENSED INSTALLER

Installer Name Corbett's Mobile Home Center

Date Tested 2-28-14

Electrical

Connect electrical conductors between multi-wide units, but not to the main power source. This includes the bonding wire between multi-wide units. Pg. 14

Plumbing

Connect all sewer drains to an existing sewer tap or septic tank. Pg. 15

Connect all potable water supply piping to an existing water meter, water tap, or other independent water supply systems. Pg. 15

Site Preparation

Debris and organic material removed Yes
Water drainage: Natural Swale Pad Other

Fastening multi wide units

Floor: Type Fastener: 3/8 Lag Length: 5" Spacing: 16" OC
Walls: Type Fastener: 8 screw Length: 3" Spacing: 24" OC
Roof: Type Fastener: 3/8 Lag Length: 3" Spacing: 16" OC
For used homes a min. 30 gauge, 8" wide, galvanized metal strip will be centered over the peak of the roof and fastened with galv. roofing nails at 2" on center on both sides of the centerline.

Gasket (weatherproofing requirement)

I understand a properly installed gasket is a requirement of all new and used homes and that condensation, mold, mildew and buckled marriage walls are a result of a poorly installed or no gasket being installed. I understand a strip of tape will not serve as a gasket.

Installer's initials RC

Type gasket Foam

Pg. 8

Installed:

Between Floors Yes X
Between Walls Yes X
Bottom of ridgebeam Yes X

Weatherproofing

The bottomboard will be repaired and/or taped. Yes X Pg. 21
Siding on units is installed to manufacturer's specifications. Yes X
Fireplace chimney installed so as not to allow intrusion of rain water. Yes X

Miscellaneous

Skirting to be installed. Yes X No X
Dryer vent installed outside of skirting. Yes N/A No X
Range downflow vent installed outside of skirting. Yes N/A No X
Drain lines supported at 4 foot intervals. Yes X No X
Electrical crossovers protected. Yes X No X
Other:

Installer verifies all information given with this permit worksheet
Is accurate and true based on the
manufacturer's Installation instructions and or Rule 15C-1 & 2

Installer Signature [Signature] Date 2-28-14