

COLUMBIA COUNTY PERMIT WORKSHEET

page 1 of 2


These worksheets must be completed and signed by the installer.
Submit the originals with the packet.

Installer Fernon Jones License # FH1025418
911 Address where home is being installed X 142 NW Owl Way
LAKE CITY, FL
Manufacturer _____ Length x width 14x76

NOTE: if home is a single wide fill out one half of the blocking plan
if home is a triple or quad wide sketch in remainder of home

I understand Lateral Arm Systems cannot be used on any home (new or used)
where the sidewall ties exceed 5 ft 4 in

Installer's initials F.J.

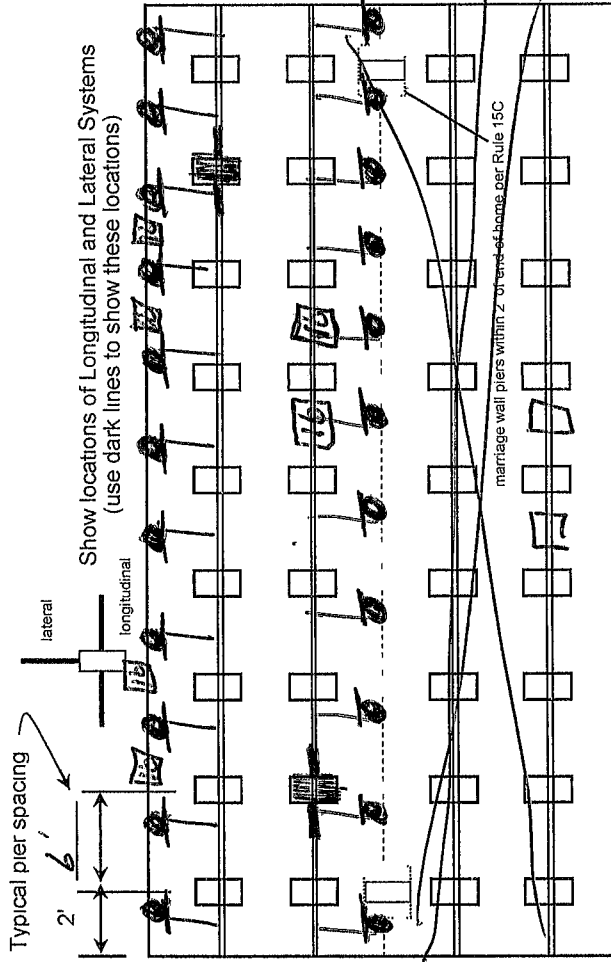

PIER SPACING TABLE FOR USED HOMES

Load bearing capacity	Footer size (sq in)	16" x 16" (256)	18 1/2" x 18 1/2" (342)	20" x 20" (400)	22" x 22" (484)*	24" x 24" (576)*	26" x 26" (676)
1000 bsf	3'	4'	4'	5'	6'	7'	8'
1500 bsf	4'	6'	6'	7'	8'	8'	8'
2000 bsf	6'	8'	8'	8'	8'	8'	8'
2500 bsf	7'	8'	8'	8'	8'	8'	8'
3000 bsf	8'	8'	8'	8'	8'	8'	8'
3500 bsf	8'	8'	8'	8'	8'	8'	8'

* interpolated from Rule 15C-1 pier spacing table.

PIER PAD SIZES

I-beam pier pad size 20x20
Perimeter pier pad size 16x16 piers
Other pier pad sizes (required by the mfg) w/1A

Draw the approximate locations of marriage wall openings 4 foot or greater Use this symbol to show the piers

List all marriage wall openings greater than 4 foot and their pier pad sizes below

Opening w/1A Pier pad size w/1A

4 ft 5 ft

FRAME TIES

within 2' of end of home spaced at 5' 4" oc F.J.

TIEDOWN COMPONENTS

Longitudinal Stabilizing Device (LSD)
Manufacturer 2
Longitudinal Stabilizing Device w/ Lateral Arms
Manufacturer _____

OTHER TIES

Number 2
Sidewall
Longitudinal
Marriage wall
Shearwall

ANCHORS

COLUMBIA COUNTY PERMIT WORKSHEET

page 2 of 2

POCKET PENETROMETER TEST

The pocket penetrometer tests are rounded down to 1500 psf or check here to declare 1000 lb soil without testing

1500 x 1500 x 1500

POCKET PENETROMETER TESTING METHOD

- Test the perimeter of the home at 6 locations
- Take the reading at the depth of the footer
- Using 500 lb increments, take the lowest reading and round down to that increment

1500 x 1500 x 1500

TORQUE PROBE TEST

The results of the torque probe test is 290 inch pounds or check here if you are declaring 5' anchors without testing A test showing 275 inch pounds or less will require 5 foot anchors

Note: A state approved lateral arm system is being used and 4 ft anchors are allowed at the sidewall locations I understand 5 ft anchors are required at all centerline tie points where the torque test reading is 275 or less and where the mobile home manufacturer may requires anchors with 4000 lb holding capacity F.S. Installer's initials

ALL TESTS MUST BE PERFORMED BY A LICENSED INSTALLER

Installer Name Fernon Jones
Date Tested 2/26/14

Electrical

Connect electrical conductors between multi-wide units, but not to the main power source This includes the bonding wire between multi-wide units Pg 15

Plumbing

Connect all sewer drains to an existing sewer tap or septic tank Pg 15
Connect all potable water supply piping to an existing water meter, water tap, or other independent water supply systems Pg 15

Site Preparation

Debris and organic material removed ✓
Water drainage Natural Swale Pad ✓ Other _____

Fastening multi wide units

Floor Type Fastener N/A Length _____ Spacing _____
Walls Type Fastener _____ Length _____ Spacing _____
Roof Type Fastener _____ Length _____ Spacing _____
For used homes a min 30 gauge, 8" wide, galvanized metal strip will be centered over the peak of the roof and fastened with galv roofing nails at 2" on center on both sides of the centerline

Gasket (weatherproofing requirement)

I understand a properly installed gasket is a requirement of all new and used homes and that condensation, mold, mildew and buckled marriage walls are a result of a poorly installed or no gasket being installed I understand a strip of tape will not serve as a gasket.

Type gasket N/A Installer's initials F.S.
Pg 15 Installed _____
Between Floors Yes _____
Between Walls Yes _____
Bottom of ridgebeam Yes _____

Weatherproofing

The bottomboard will be repaired and/or taped Yes ✓ Pg 14
Siding on units is installed to manufacturer's specifications Yes ✓
Fireplace chimney installed so as not to allow intrusion of rain water Yes _____

Miscellaneous

Skirting to be installed Yes ✓ No _____
Dryer vent installed outside of skirting Yes ✓ N/A _____
Range downflow vent installed outside of skirting Yes ✓ N/A _____
Drain lines supported at 4 foot intervals Yes ✓
Electrical crossovers protected Yes ✓
Other _____

Installer verifies all information given with this permit worksheet is accurate and true based on the

Installer Signature Fernon Jones Date 2/26/14