

COLUMBIA COUNTY PERMIT WORKSHEET

page 1 of 2

These worksheets must be completed and signed by the installer.
Submit the originals with the packet.


Installer Darryl McElroy License # FFH-1025315
911 Address where home is being installed 4446 NW Sophie Drive
Manufacturer White Spans Length x width 14' x 26'

New Home ☐ Used Home ☒
Home installed to the Manufacturer's Installation Manual ☐
Home is installed in accordance with Rule 15-C ☒
Single wide ☒ Wind Zone II ☒ Wind Zone III ☐
Double wide ☐ Installation Decal # 9113
Triple/Quad ☐ Serial # 019408

NOTE: if home is a single wide fill out one half of the blocking plan
if home is a triple or quad wide sketch in remainder of home

I understand Lateral Arm Systems cannot be used on any home (new or used)
where the sidewall ties exceed 5 ft 4 in

Installer's initials DM

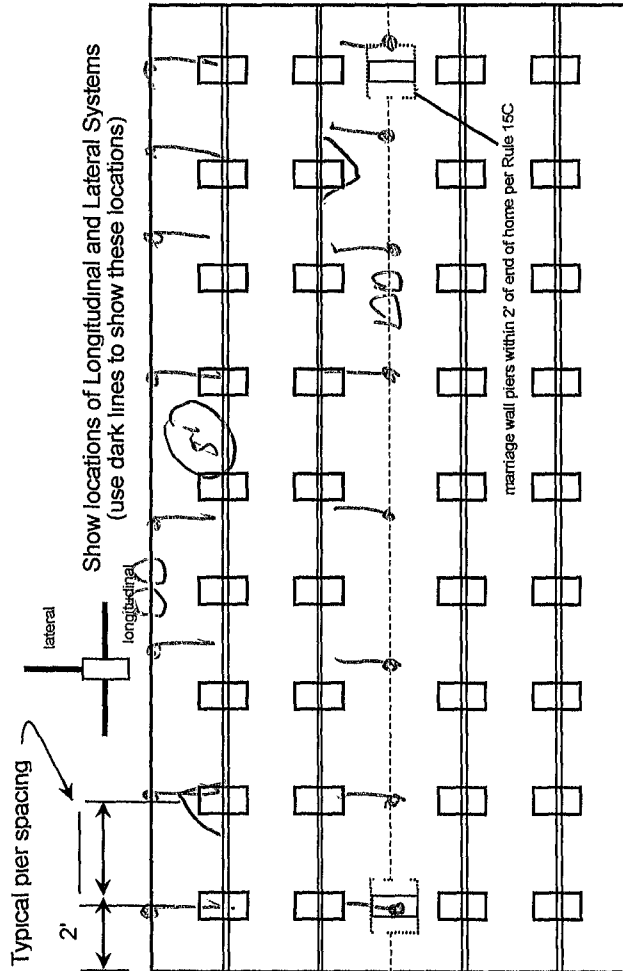

PIER SPACING TABLE FOR USED HOMES

Load bearing capacity	Footer size (sq in)	16" x 16" (256)	18 1/2" x 18 1/2" (342)	20" x 20" (400)	22" x 22" (484)*	24" x 24" (576)*	26" x 26" (676)
1000 psf	3'	3'	4'	5'	6'	7'	8'
1500 psf	4'6"	4'6"	6'	7'	8'	8'	8'
2000 psf	6'	6'	8'	8'	8'	8'	8'
2500 psf	7'6"	7'6"	8'	8'	8'	8'	8'
3000 psf	8'	8'	8'	8'	8'	8'	8'
3500 psf	8'	8'	8'	8'	8'	8'	8'

* interpolated from Rule 15C-1 pier spacing table

PIER PAD SIZES

I-beam pier pad size 16x16
Perimeter pier pad size _____
Other pier pad sizes (required by the mfg.) _____

Draw the approximate locations of marriage wall openings 4 foot or greater. Use this symbol to show the piers.



List all marriage wall openings greater than 4 foot and their pier pad sizes below

Opening _____ Pier pad size _____

ANCHORS

4 ft ☒ 5 ft

FRAME TIES

within 2' of end of home spaced at 5' 4" oc ☒

TIEDOWN COMPONENTS

Longitudinal Stabilizing Device (LSD)
Manufacturer _____
Longitudinal Stabilizing Device w/ Lateral Arms
Manufacturer _____

OTHER TIES

Sidewall _____
Longitudinal _____
Marriage wall _____
Shearwall _____

POCKET PENETROMETER TEST

The pocket penetrometer tests are rounded down to 2000 psf or check here to declare 1000 lb soil without testing

2000 x 2000 x 2100

POCKET PENETROMETER TESTING METHOD

- 1 Test the perimeter of the home at 6 locations
2. Take the reading at the depth of the footer
3. Using 500 lb. increments, take the lowest reading and round down to that increment.

2000 x 2100 x 2100

TORQUE PROBE TEST

The results of the torque probe test is 275 inch pounds or check here if you are declaring 5' anchors without testing _____ A test showing 275 inch pounds or less will require 5 foot anchors.

Note: A state approved lateral arm system is being used and 4 ft. anchors are allowed at the sidewall locations. I understand 5 ft anchors are required at all centerline tie points where the torque test reading is 275 or less and where the mobile home manufacturer may requires anchors with 4000 lb. holding capacity.

DM Installer's initials

ALL TESTS MUST BE PERFORMED BY A LICENSED INSTALLER

Installer Name Doug McElmish

Date Tested 5-28-12

Electrical

Connect electrical conductors between multi-wide units, but not to the main power source. This includes the bonding wire between multi-wide units. Pg 3

Plumbing

Connect all sewer drains to an existing sewer tap or septic tank. Pg 6
Connect all potable water supply piping to an existing water meter, water tap, or other independent water supply systems. Pg. 7

Site Preparation

Debris and organic material removed ✓
Water drainage. Natural Swale Pad ✓ Other _____

Fastening multi wide units

Floor: Type Fastener _____ Length _____ Spacing _____
Walls: Type Fastener _____ Length _____ Spacing _____
Roof: Type Fastener _____ Length _____ Spacing _____
For used homes a min. 30 gauge, 8" wide, galvanized metal strip will be centered over the peak of the roof and fastened with galv. roofing nails at 2" on center on both sides of the centerline

Gasket (weatherproofing requirement)

I understand a properly installed gasket is a requirement of all new and used homes and that condensation, mold, mildew and buckled marriage walls are a result of a poorly installed or no gasket being installed. I understand a strip of tape will not serve as a gasket.

Installer's initials _____

Type gasket _____
Pg _____

Installed.
Between Floors Yes _____
Between Walls Yes _____
Bottom of ridgebeam Yes _____

Weatherproofing

The bottomboard will be repaired and/or taped Yes ✓ Pg 8
Siding on units is installed to manufacturer's specifications Yes ✓
Fireplace chimney installed so as not to allow intrusion of rain water. Yes N/A

Miscellaneous

Skirting to be installed Yes ✓ No _____
Dryer vent installed outside of skirting Yes ✓ N/A _____
Range downflow vent installed outside of skirting Yes ✓ N/A _____
Drain lines supported at 4 foot intervals Yes ✓
Electrical crossovers protected Yes _____
Other _____

Installer verifies all information given with this permit worksheet is accurate and true based on the

Installer Signature D.M.

Date 5-28-12