





TYPICAL WAL SECTION



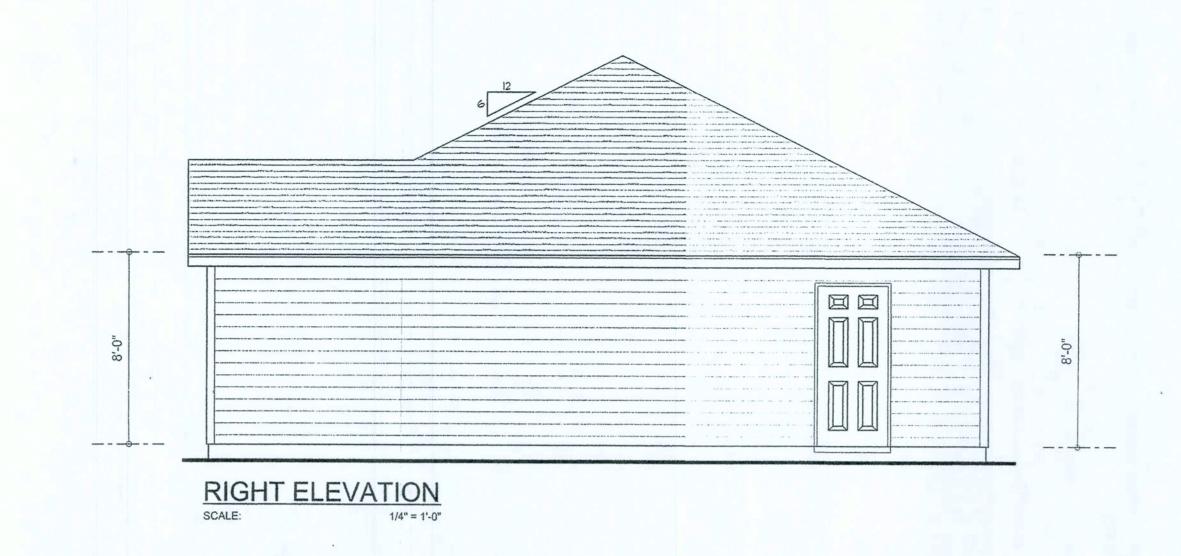

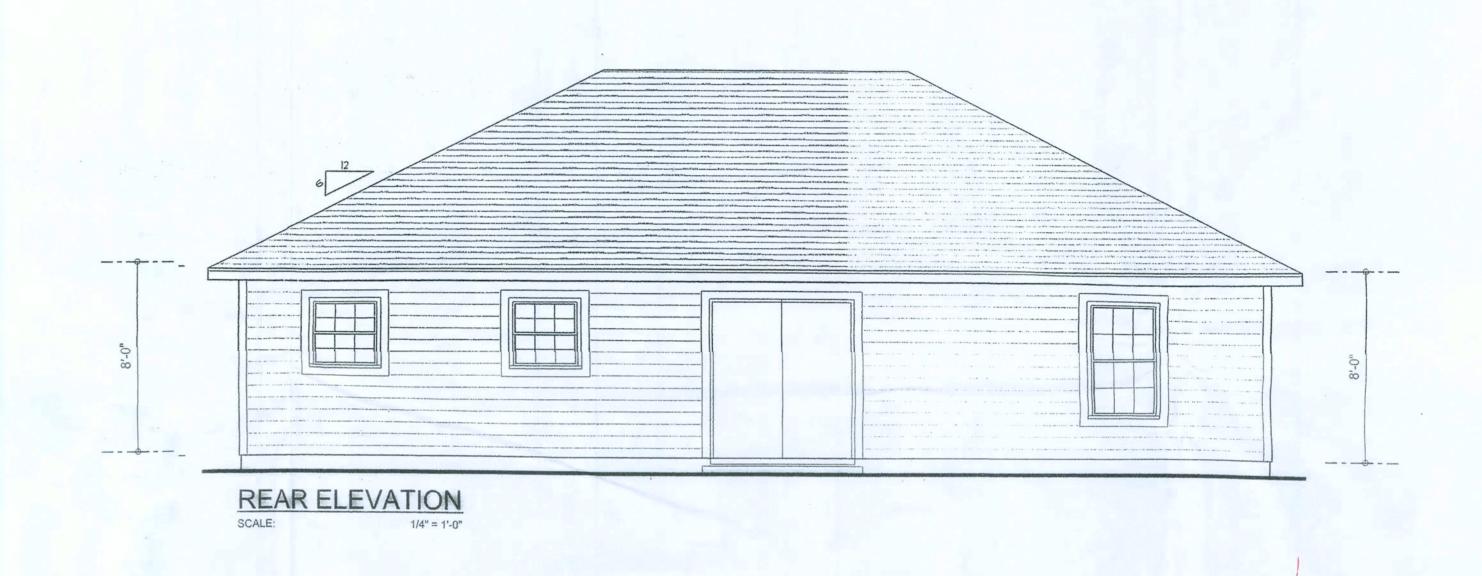

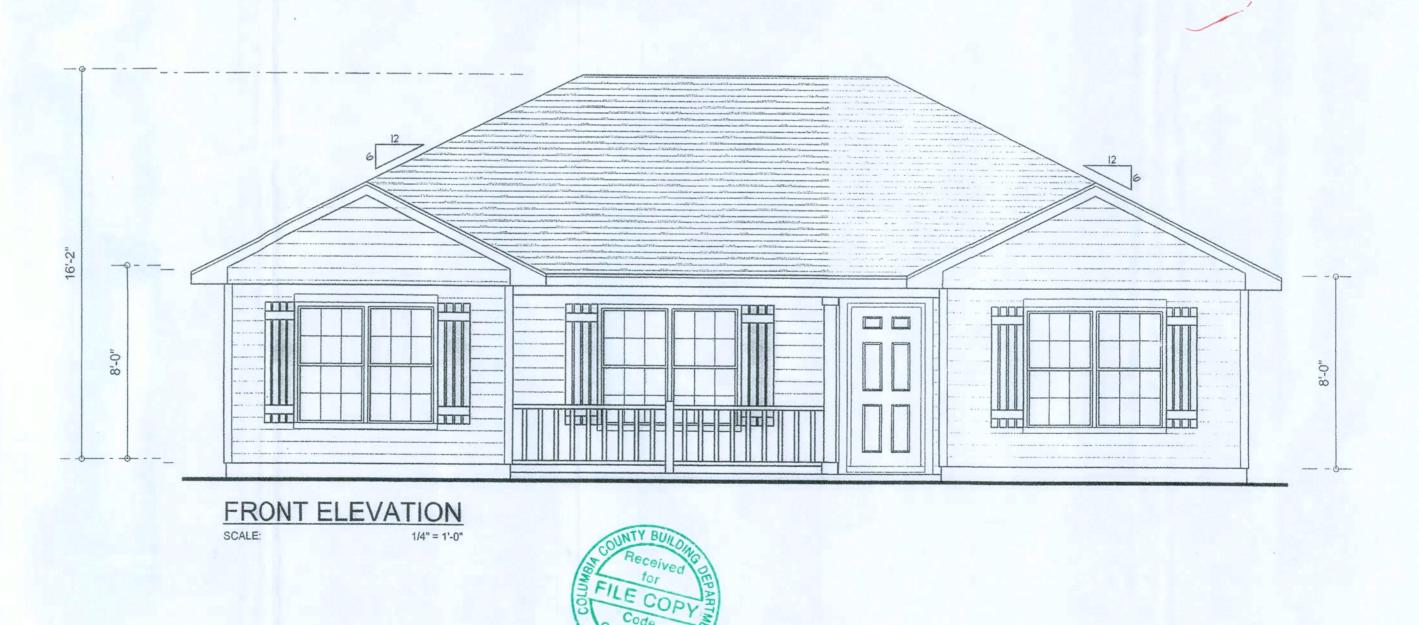

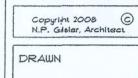

REVISION:

RAWN

1300 MODEL

NICHOLAS PAUL GEISLER ARCHITECT


DATE: 28/Ja/2008 COMM:

SHEET NUMBER

OF & SHEETS

17 200 AROOOTOOS

OFFice Copy

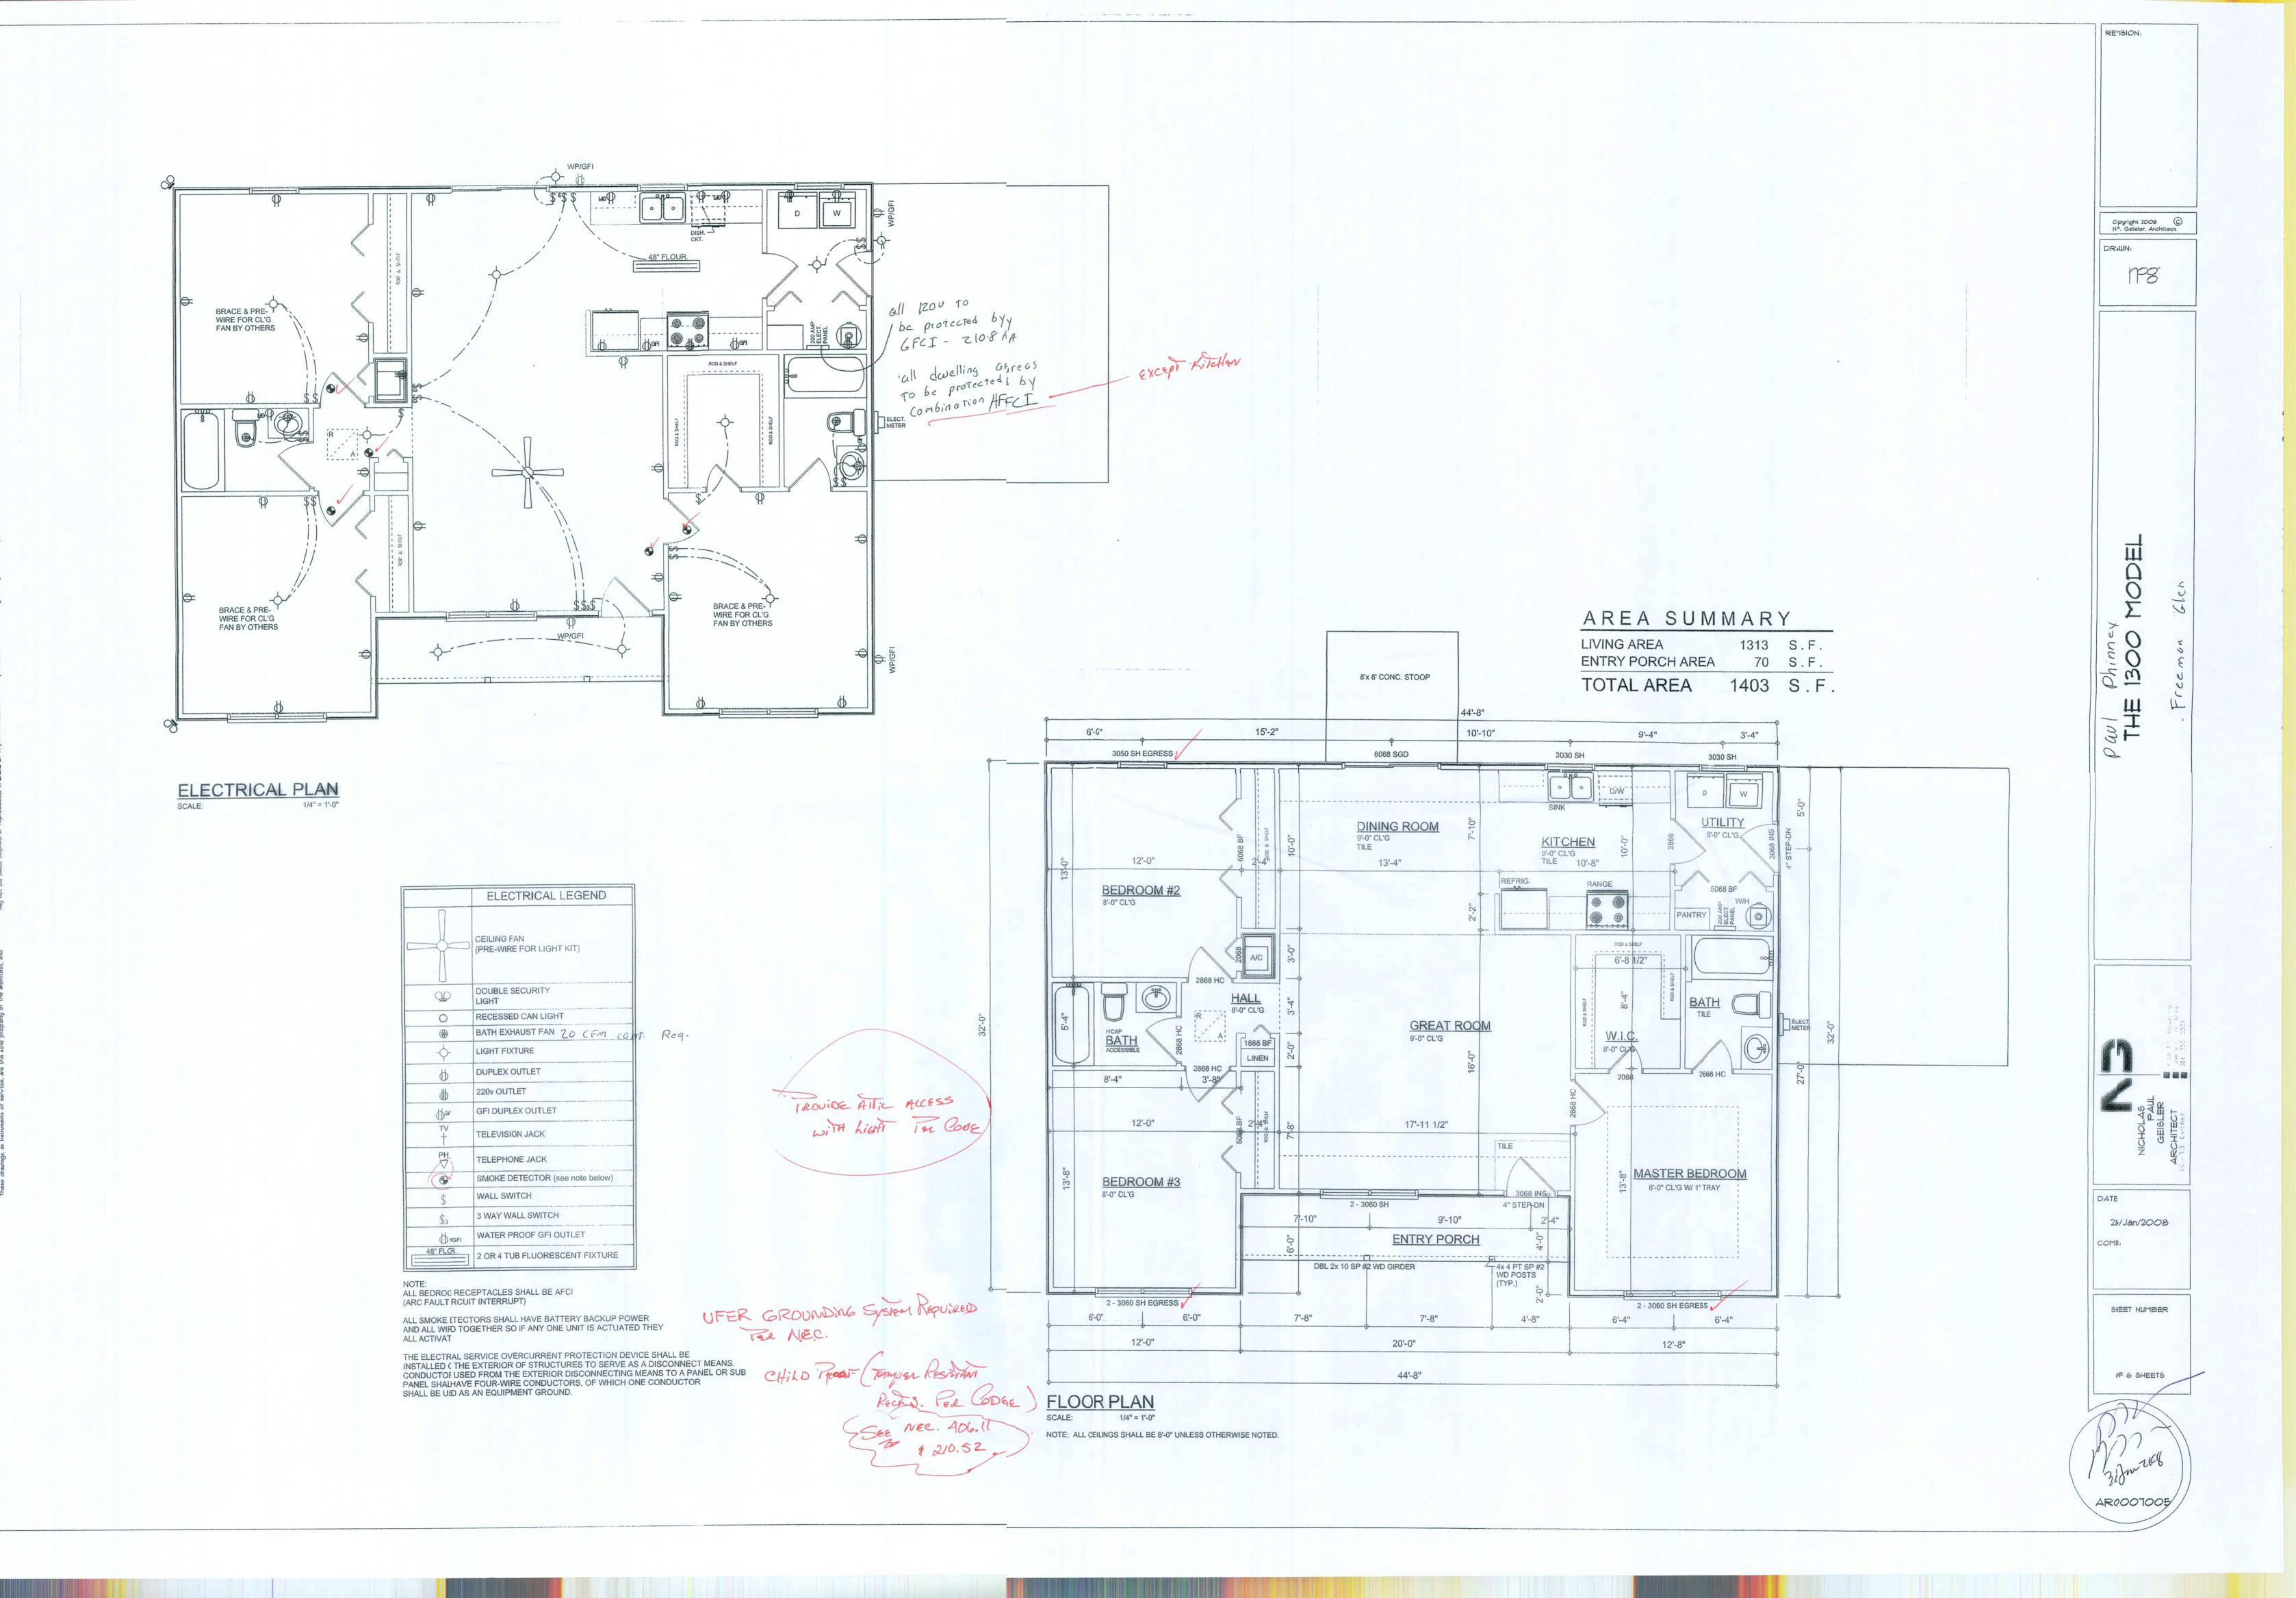

CONCRETE / MASONRY / METALS GENERAL NOTES:

- DESIGN SOIL BEARING PRESSURE: 1500 PSF.
- 2. EXPANSIVE SOILS: WHERE DIRECTED BY THE SOILS ENGINEER, SOIL AUGMENTATION PER THE SOILS ENGINEER'S SPECIFICATIONS SHALL BE IMPLEMENTED PRIOR TO PLACING ANY FOUNDATIONS - TESTS AS SPECIFIED SHALL BE PREFORMED TO DETERMINE THE SUITABILITY OF THE SUB-GRADE TO SUPPORT THE DESIGN LOADS.
- CLEAN SAND FILL OVER STRIPPED AND COMPACTED EXISTING GD. SHALL BE PLACED IN 12" LIFTS. BOTH SUB-SOIL AND FILL COMPAC-TION SHALL BE NOT LESS THAN 98% AS MEASURED BY A MODIFIED PROCTOR TEST AT THE RATE OF ONE TEST FOR EACH 1500 SF OF BUILDING PAD AREA, OR FRACTION THEREOF, FOR EACH 12" LIFT.
- 4. REINFORCING STEEL SHALL BE GRADE 60 AND MEET THE REQUIRE-MENTS OF ASTM A615, ALL BENDS SHALL BE MADE COLD.
- 5. WELDED WIRE MESH SLAB REINFORCING SHALL MEET THE REQUIRE-MENTS OF ASTM A185 - MIN. YEILD STRESS = 85 KSI.
- CONCRETE SHALL BE STANDARD MIX F'c = 3000 PSI FOR ALL FTGS, SLABS, COLUMNS AND BEAMS OR SHALL BE STANDARD PUMP MIX F'c = 3000 PSI. STRENGTH SHALL BE ATTAINED WITHIN 28 DAYS OF PLACE-MENT. MIXING, PLACING AND FINISHING SHALL BE AS PER ACI STANDARDS.
- CONCRETE BLOCK SHALL BE AS PER MANUFACTURER'S PRODUCT GUIDE FOR ASTM C-90 REQUIREMENTS WITH MEDIUM SURFACE FINISH -F'm = 1500 PSI.
- 8. MORTAR SHALL BE TYPE "M" OR "N" FOR ALL MASONRY UNITS.
- STRUCTURAL STEEL SHALL CONFORM TO ASTM A36 STANDARDS FOR STRENGTH, BOLTS SHALL BE ASTM A307 / GRADE 1 OR A325, AS PER PLAN REQUIREMENTS.
- 10. WELDS SHALL BE AS PER "AMERICAN WELDING SOCIETY" STANDARDS FOR STRUCTURAL STEEL APPLICATIONS.

PRESSURE TREATED SILL. OR FOUNDATION GRADE SILL 1/2" X 16" ANCHOR BOLT 6'-0" O.C. MAX. 1 FLOOR, 4'-0" MAX. 2 FLOORS EACH SILL PIECE -4" CONC. SLAB WITH 6X6 10 - 10 WWM TOP & BOTTOM 1'-6" O.C. MAXIMUM HORIZONTAL -6 MIL. VAPOR BARRIER 1'-0"

SLAB & THICKENED EDGE FOOTING SCALE: = NOT TO SCALE

THE DESIGN WIND SPEED FOR THIS PROJECT IS 110 MPH PER 2007 FBC 1609 AND LOCAL JURISDICTION REQUIREMENTS

POINT LOADS OF 4.0 K OR GREATER SHALL BE SUPPORTED VIA A MODIFIED FOUNDATION PLAN TAKING THESE LOADS INTO CONSIDERATION. THE CONTRACTOR SHALL MAKE THE ENGINEERED TRUSS SHOP DRAWINGS AVAILABLE TO THE ARCHITECT FOR THE PURPOSE OF RENDERING SUCH MODIFICATIONS

PRIOR TO POURING ANY CONCRETE.

ADDED FILL SHALL BE APPLIED IN 8" LIFTS -EA. LIFT SHALL BE CONPACTED TO 98% DRY COMPACTION PER THE "MODIFIED PROCTOR" METHOD.

PLUMBING CONTRACTOR SHALL PREPARE "AS-BUILT" SHOP DRAWINGS INDICATING ALL PLUMBING WORK, INCLUDING ALL PLUMBING LINE LOCATIONS AND RISER DIAGRAM - CONT'R SHALL PROVIDE 1 COPY OF AS-BUILT DWGS TO OWNER AND 1 COPY TO THE PERMIT ISSUING AUTHORITY.

H.V.A.C. CONTRACTOR SHALL PREPARE "AS-BUILT" SHOP DRAWINGS INDICATING ALL H.V.A.C. WORK, INCLUDING ALL DUCTWORK LOC., SIZES, LINES, EQUIPMENT SCH. & BALANCING REPORT - CONT'R SHALL PROVIDE 1 COPY OF AS-BUILT DWGS TO OWNER & 1 COPY TO THE PERMIT ISSUING AUTHORITY.

DRAWI:

Copyriht 2008 C N.P. Gisler, Architect

REVISDN:

5DEC08

6 SHEETS

Roof Framing PLAN

SCALE: 1/4" = 1'-0"

NOTE!

ANCHOR GIRDER TRUSS(ES) TO HEADER WITH 2 "SIMPSON" LGT(2, 3 OR 4), ANCHOR HEADER TO KING STUDS W/2 "SIMPSON" ST22 EA. END - TYP., T.O.

NOTE!

ALL EXTERIOR WALLS ARE 2X4 STUDS W/
1/2" THICK CDX PLYWD. SHEATHING (4")

NOTE!

ALL PENETRATIONS OF THE TOP PLATE OF ALL LOAD BEARG WALLS SHALL BE SEALED WITH FIRE RETARDANT CAULKIN INCLUDING WIRING, PLUMBING OR OTHER SUCH PENETRADNS. WALLS OVER 8'-0" TALL SHALL HAVE CONTINUOUS BLOCKINTO LIMIT CAVITY HEIGHT TO 8'-0". PENETRATIONS THROUGH SUCH BLOCKING SHALL BE TREATED IN THE SAME MANNEF AS TOP PLATES, NOTED ABOVE

ROOF P.AN NOTES

R-1 SEE ITERIOR ELEVATIONS FOR ROOF PITCH

RFER TO THE WINDOW/DOOR HEADER

MIMUM SIZE HEADERS AND ALTERNATES

SHEDULE ON SHEET SD.4 FOR ALL

MIMUM SIZE ALLOWABLE IS 2-2X10.

- R-2 ALL (ERHANG 18" UNLES OTHERWISE NOTED
- R-3 PROVE ATTIC VENTILATION IN ACCORINCE WITH SCHEDULE ON SD.3
- R-4 SEE ITERIOR ELEVATIONS AND FLOOR PLANTO VERIFY PLATE AND HEEL HEIGHTS
- R-5 MOVALL VENTS AND OTHER ROOPENETRATIONS TO REAR

NOTE!

SHEATH ROOF W/ 1/2" CDX PLYWOOD PLACED W/ LONG DIMENSION PERPENDICULAR TO THE ROOF TRUSSES, SECURE TO FRAMING W/ 8d NAILS - AS PER DETAIL ON SHEET SD.4

NOTE!

THE DESIGN WIND SPEED FOR THIS
PROJECT IS 110 MPH PER FBC 1606
AND LOCAL JURISDICTION REQUIREMENTS

GENERAL TRUSS NOTITES:

1. TRUSSES SHALL BE DE ESIGNED BY A LICENSED ENGINEER, AND IN ACCORDANCE WITH THE REQUIREMENTS OF THE "NATIONAL FOREST PRODUCTS ASSOCIATION" MANUAL FOR "STRESS S RATED LUMBER AND IT'S CONNECTIONS", LATEST Ed., ALONG W/ THE "TRUSS PLATE INSTITUTE" SUGGESTED GUIDELINES FOR TEMPORARY AND PERMANENT BRACING, 3, AND HANDLING OF TRUSSES. TRUSS SHOP DRAWINGS SHALL INCLUDE TRUSS DESIG GN, PLACEMENT PLANS, DETS, & TRUSS TO TRUSS CONNECTIONS.

- CONSTRUCT EXTERIOR WALLS W/ 2 TOP PLATES & 1 SILL

W/ 7/16" OSB, APPLIED W/ 8d COMMON NAILS @ 4" O.C. ALONG EDGES & 8" O.C. ALONG INTERMEDIATE SUPPORTS

PLATE, 2X4 STUDS @ 16" O.C., & "SIMPSON" SP2/SP1

FASTEN TOP PLATE WITH 16d NAILS AT

-ANCHOR ALL TRUSSES WITH "SEMCO"

HDPT2 STRAPS & 6 - 10" NAILS

_-2X4 SUB-FASCIA, TYPICAL @ ALL

T TRUSS EAVES & GABLE ENDS

¹ 12" O.C., TYPICAL T.O.


STUD/PLATE CONNECTORS @ 32" O.C. - SHEATH WALL

- 2. TRUSS SHOP DRAWING GS SHALL BE SIGNED & SEALED BY THE DESIGNING ENGINEER.
- 3. FOLLOWING DEVELOPMMENT OF TRUSS SHOP DRAWINGS, ADJUSTMENTS TO THE ANCHOR REQUIRMENTS MAY BE REQUIRED DEPENDING ON THE ENGINEERED GRAVITY AND WIND UPLIFT REQUIREMENTS OF TRUSSES OR GIRDERS. THE CONTRACTOR SHALL MAKE AVAILABLE A COMPLET SET OF TRUSS SHOP DRAWINGS TO THE ARCHITECT FOR THE PURPOSE OF REVIEW G OF LOADS IMPOSED ON THE BALANCE OF THE STRUCTURE. ANY SUCH REQUIRED CHAN NGE SHALL BE INCORPORATED INTO THE CONSTRUCTION OF THIS STRUCTURE.


WOOD STRUCTURAL NOTES

- TEMPORARY BRACING OF THE STRUCTURE DURING ERECTION, REQUIRED FOR SAFE AND STABLE CONSTRUCTION, SHALL BE THE SOLE RESPON-SIBILITY OF THE CONTRACTOR SO ENGAGED. TEMPORARY & PERMANENT BRACING OF ROOF TRUSSES SHALL BE AS PER THE STANDARD GUIDE-LINES OF THE "TRUSS PLATE INSTITUTE".
- 2. ALL TRUSSES SHALL BE DESIGNED BY A LICENSED PROFESSIONAL ENGINEER & SHALL BE SIGNED AND SEALED BY SAME. TRUSS DESIGN SHALL INCLUDE PLACEMENT PLANS, TRUSS DETAILS, TRUSS TO TRUSS CONNECTIONS & THE STANDARD SPECIFICATIONS & RECOMMENDATIONS OF INSTALLATION OF THE "TRUSS PLATE INSTITUTE".
- WOOD STUDS IN EXTERIOR WALLS & INTERIOR BEARING WALLS SHALL BE NOT LESS THAN Nr.2 HEM-FIR OR BETTER.
- CONNECTORS FOR WOOD FRAMING SHALL BE GALVANIZED METAL OR BLACK METAL AS MANUFACTURED OR AS CALLED FOR IN THE PLANS AND BE OF A DESIGN SUITABLE FOR THE LOADS AND USE INTENDED. REFER TO THE JOINT REINFORCEMENT SCHEDULE FOR PRINCIPLE CON-NECTIONS.

AREA OF ATTIC	REQ'D L.F. OF VENT	NET FREE AREA OF INTAKE
1600 SF	20 LF	410 SQ.IN.
1900 SF	24 LF	490 SQ.IN.
2200 SF	28 LF	570 SQ.IN.
2500 SF	32 LF	650 SQ.IN.
2800 SF	36 LF	730 SQ.IN.
3100 SF	40 LF	820 SQ.IN.
3600 SF	44 LF	900 SQ.IN.

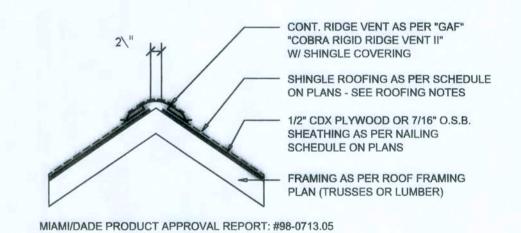



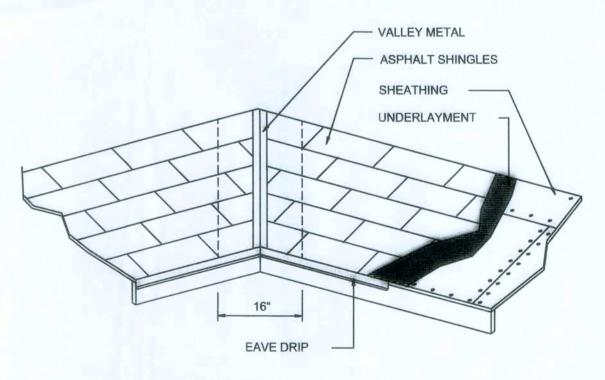

VALLEY FLASHING

	MINIMUM		
MATERIAL	THICKNESS (in)	GAGE	WEIGH (OZ.)
COPPER			16
ALUMINUM	0.024		
STAINLESS STEEL		28	
GALVANIZED STEEL	0.0179	26 (ZINC COATED G90)	
ZINC ALLOY LEAD PAINTED TERNE	0.027		40 20

Roofing/Flashing DETS.

SCALE: NONE

Copyright 008 C N.P. Geislr, Architect

REVISION

DRAWN:

rpg

N GLEN, COLUMBIA COUNTY, FL THE 1300 MODEL

NICHOLAS
PAUL
GEISLER
ARCHITECT
Lake City, FL 32055

DATE:

15PEC08

COMM:

SHEET:

S.4

124

AR0017005

FLORIDA BUILDIG CODE

Compliance Simmary

TYPE OF CONSTRUCTION

Roof: Hip Construction, Wood Trusses @ "O Walls: 2x4 Wood Studs @ 16" O.C. Floor: 4" Thk. Concrete Slab W/ Fibermeshoncrete Additive

Foundation: Continuous Footer/Stem Wa

ROOF DECKING

Material: 1/2" CD Plywood or 7/16" O.S.B. Sheet Size: 48"x96" Sheets Perpendiculdo Roof Framing Fasteners: 8d Common Nails per schedulon sheet A.7

SHEARWALLS

1/2" CD Plywood or 7/16" O.S.I Material: 48"x96" Sheets Placed Vertil Sheet Size:

8d Common Nails @ 4" O.C. Iges & 8" O.C. Interior Dragstrut: Double Top Plate (S.Y.P.) Wid Nails @ 12" O.C. Wall Studs: 2x4 Hem Fir Studs @ 16" O.

HURRICANE UPLIFT CONNECTORS

Truss Anchors: SEMCO HDPT2 @ Ea. Tss End (Typ. U.O.N.) Wall Tension: Wall Sheathing Nailing is requate - 8d @ 4" O.C. Top & Bot. Anchor Bolts: 1/2" A307 Bolts @ 48" O. - 1st Bolt 6" from corner Corner Hold-down Device: (1) HD5@ each corner Sinson ABU44/ABU66 @ each column Porch Column Base Connector: impson EPC44/PC44 @ each column Porch Column to Beam Connector:

FOOTINGS AND FOUNDATIONS

Footing: 20"x12" Cont. W/2-#5 Bars Cont. 1-#3 Transverse @ 24" O.C.

Stemwall: 8" C.M.U. W/1-#5 Vertical Dowel 48" O.C.

FLORIDA BUILDING CŒ, 200	1 EDITION.	
BASIC WIND SPEED:	110 MPH	
WIND IMPORTANCE FACTOR (I):	I = 1.00	
BUILDING CATAGORY:	CATAGORY II	
WIND EXPOSURE:	"B"	
INTERNAL PRESSURE COEFFICIENT:	+/- 0.18	
MWFRS PER TABLE 1606.2A (FBC 2001) DESIGN WIND PRESSURES:	ROOF: - 23.1 PSF WALLS: + 26.6 PSF EAVES: - 32.3 PSF	
COMPONENTS & CLADING PER TABLES 1606.2B & 1606.2C (FBC 2001) DESIGN WIND PRESSURES:	OP'NGS: + 21.8 / - 29.1 PSF EAVES: - 68.3 PSF ROOF: + 19.9 / - 25.5 PSF	

TERMITE PROTECTION NOTE:

SOIL CHEMICAL BARRIER METHOD:

1. A PERMANENT SIGN WHICH IDENTIFIES THEERMITE TREATMENT PROVIDER AND NEED FOR REINSPECTION AND TREATMET CONTRACT RENEWAL SHALL BE PROVIDED. THE SIGN SHALL BE POSTED MR THE WATER HEATER OR ELECTRIC PANEL. FBC 104.2.6

2. CONDENSATE AND ROOF DOWNSPOUTS SALL DISCHARGE AT LEAST 1'-0" AWAY FROM BUILDING SIDE WALLS. FBC 1501.4

3. IRRIGATION/SPRINKLER SYSTEMS INCLUDG ALL RISERS AND SPRAY HEADS SHALL NOT BE INSTALLED WITHIN 1'-FROM BUILDING SIDE WALLS.

FBC 1503.4.4 4. TO PROVIDE FOR INSPECTION FOR TERMITINFESTATION, BETWEEN WALL COVERINGS AND FINAL EARTH GRADE SHALIJOT BE LESS THAN 6".

EXCEPTION: PAINT AND DECORATIVE CEMENOUS FINISH LESS THAN 5/8" THICK ADHERED DIRECTLY TO THE FOUNDATIN WALL. FBC 1403.1.6 5. INITIAL TREATMENT SHALL BE DONE AFTEALL EXCAVATION AND

BACKFILL IS COMPLETE. FBC 1816.1.1 6. SOIL DISTURBED AFTER THE INITIAL TREATENT SHALL BE RETREATED INCLUDING SPACES BOXED OR FORMED. FB1816.1.2

7. BOXED AREAS IN CONCRETE FLOOR FOR SESEQUENT INSTALLATION OF TRAPS, ETC., SHALL BE MADE WITH PERMIENT METAL OR PLASTIC FORMS. PERMANENT FORMS MUST BE OF A SE AND DEPTH THAT WILL ELIMINATE THE DISTURBANCE OF SOIL AFTEFHE INITIAL TREATMENT.

8. MINIMUM 6 MIL VAPOR RETARDER MUST BENSTALLED TO PROTECT AGAINST RAINFALL DILUTION. IF RAINFALL O(URS BEFORE VAPOR RET-ARDER PLACEMENT, RETREATMENT IS REQUED. FBC 1816.1.4 9. CONCRETE OVERPOUR AND MORTAR ALOB THE FOUNDATION PERIMETER

MUST BE REMOVED BEFORE EXTERIOR SOIL REATMENT. FBC 1816.1.5 10. SOIL TREATMENT MUST BE APPLIED UND! ALL EXTERIOR CONCRETE OR GRADE WITHIN 1'-0" OF THE STRUCTURE DEWALLS. FBC 1816.1.6

11. AN EXTERIOR VERTICAL CHEMICAL BARRR MUST BE INSTALLED AFTER CONSTRUCTION IS COMPLETE INCLUDING LADSCAPING AND IRRIGATION. ANY SOIL DISTURBED AFTER THE VERTICAL ERRIER IS APPLIED, SHALL BE RETREATED. FBC 1816.1.6

12. ALL BUILDINGS ARE REQUIRED TO HAVE IR-CONSTRUCTION TREATMENT. FBC 1816.1.7

13. A CERTIFICATE OF COMPLIANCE MUST BESUED TO THE BUILDING DEPART-MENT BY # LICENSED PEST CONTROL COMPJY BEFORE A CERTIFICATE OF OCCUPANCY WILL BE ISSUED. THE CERTIFICIE OF COMPLIANCE SHALL STATE: "THE BUILDING HAS RECEIVED A COMPLETE TEATMENT FOR THE PREVENTION OF SUBTERRANEAN TERMITES. THE TREATMIT IS IN ACCORDANCE WITH THE RULES AND LAWS OF THE FLORIDA DEPARTMENT OF AGRICULTURE AND CONS-UMER SERVICES". FBC 1816.1.7

14. AFTER ALL WORK IS COMPLETED, LOOSE/OOD AND FILL MUST BE REMOVED FROM BELOW AND WITHIN 1'-0" OF THE BUILDIG. THIS INCLUDES ALL GRADE STAKES, TUB TRAP BOXES, FORMS, SHORINOR OTHER CELLULOSE CONTAINING MATERIAL. FBC 2303.1.3

15. NO WOOD, VEGETATION, STUMPS, CARDEARD, TRASH, ETC., SHALL BE BURIED WITHIN 15'-0" OF ANY BUILDING OR PROPOSEBUILDING. FBC 2303.1.4

FRAMING ANCHOR & SCHEDULE

APPLICATION MANUF'R/MODEL TRUSS TO WALL: 960# SEMCO HDPT2, W/ 6 - 10d NAILS GIRDER TRUSS TO POST/HEAADER: SIMPSON LGT, W/ 28 - 16d NAILS 1785# HEADER TO KING STUD(S): 1370# SIMPSON ST22 PLATE TO STUD: 1065# SIMPSON SP2 STUD TO SILL: 585# SIMPSON SP1 PORCH BEAM TO POST: SIMPSON PC44/EPC44 1700# PORCH POST TO FND.: SIMPSON ABU44 2200# MISC. JOINTS SIMPSON A34 315#/240#


ALL ANCHORS SHALL BE SECCURED W/ NAILS AS PRESCRIBED BY THE MANUFACTURER FOR MAXIMI_{NUM} JOINT STRENGTH, UNLESS NOTED OTHERWISE.

NOTE: REFER TO THE INCLUDED STITRUCTURAL DETAILS FOR ADDITIONAL ANCHORS/ JOINT REINFORCEMENT AND 3 FASTENERS.

ALL UNLISTED JOINTS IN THEE LOAD PATH SHALL BE REINFORCED WITH SIMPSON A34 FRAMING ANCHHORS, TYPICAL T.O.

"SEMCO" PRODUCT APPROVA/AL: MIAMI/DADE COUNTY REPOR T #95-0818.15

"SIMPSON" PRODUCT APPRO'DVALS: MIAMI/DADE COUNTY REPOR 2T #97-0107.05, #96-1126.11, #99-0623.04 SBCC1 NER-443, NER-393

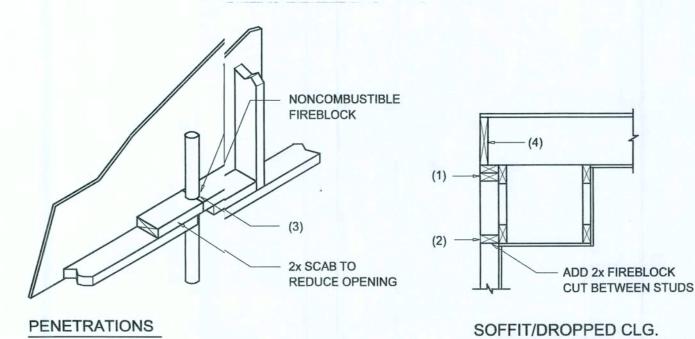

FIREBLOCKING NOTES:

FIREBLOCKING SHALL BE INSTAL $_{\mbox{\scriptsize LLED}}$ IN WOOD FRAME CONSTRUCTION IN THE FOLLOWING LOCATIONS:


1. IN CONCEALED SPACES OF \$ STUD WALLS AND PARTITIONS INCLUDING FURRED SPACES AT CEILING AND FLILOOR LEVELS.

2. AT ALL INTERCONNECTIONS IS BETWEEN CONCEALED VERTICAL AND HORIZONTAL SPACES SUCH AS OCCUR ATAT SOFFITS, DROP CEILINGS, COVE CEILINGS, ETC.

3. AT OPENINGS AROUND VEN NTS, PIPES, DUCTS, CHIMNEYS AND FIREPLACES AT CEILING AND FLOOR LEVELS WITH "PYROPANEL MULTIFLEX SEALANT"

4. AT ALL INTERCONNECTIONS IS BETWEEN CONCEALED VERTICAL STUD WALL OR PARTITION SPACES AND COONCEALED SPACES CREATED BY AN ASSEMBLY OF FLOOR JOISTS, FIREBLO OCKING SHALL BE PROVIDED FOR THE FULL DEPTH OF THE JOISTS AT THE ENDS AND OVER THE SUPPORTS.

Fire Stopping DETAILS

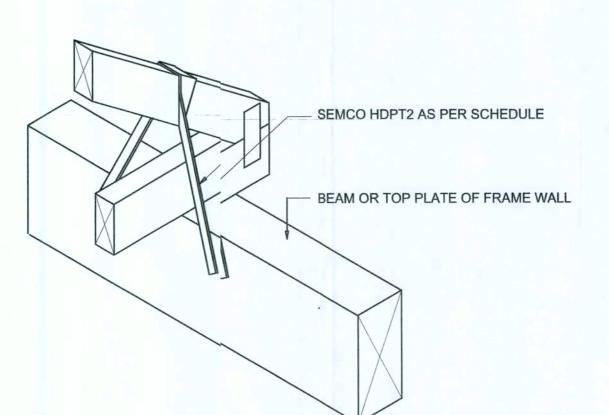

TRUSS TO WOOD BEAM

SEMCO HIDPT2 SCALE: 1/2" = 1'-0"

General Roofing NOTES:

ASPHALT SHINGLES SHALL BE FASTENED TO SOLIDLY SHEATHED DECKS.

ASPHALT SHINGLES SHALL BE USED ONLY ON ROOF SLOPES OF 2:12 OR GREATER. FOR ROOF SLOPES FROM 2:12 TO 4:12, DBL. UNDERLAYMENT IS REQUIRED.

UNLESS OTHERWISE NOTED, UNDERLAYMENT SHALL CONFORM W/ ASTM D 226, TYPE 1, OR ASTM D 4869, TYPE 1.

SELF-ADHERING POLYMER MODIFIED BITUMEN SHEET: SELF ADHERING POLYMER MODIFIED BITUMEN SHALL COMPLY W/ ASTM D 1970.

ASPHALT SHINGLES:

ASPHALT SHINGLES SHALL HAVE SELF SEAL STRIPS OR BE INTERLOCKING,

AND COMPLY WITH ASTM D 225 OR ASTM D 3462.

FASTENERS FOR ASPHALT SHINGLES SHALL BE GALVANIZED, STAINLESS STEEL, ALUMINUM OR COPPER ROOFING NAILS, MINIMUM 12 GAUGE SHANK WITH A MINIMUM 3/8 INCH DIAMETER HEAD, OF A LENGTH TO PENETRATE THROUGH THE ROOFING MATERIAL AND A MINIMUM 3/4" INTO THE ROOF SHEATHING. WHERE THE SHEATHING IS LESS THAN 3/4" THICK, THE NAILS SHALL PENETRATE THROUGH THE SHEATHING.

ASPHALT SHINGLES SHALL BE SECURED TO THE ROOF WITH NOT LESS THAN FOUR FASTENERS PER STRIP SHINGLE OR TWO FASTENERS PER INDIVIDUAL SHINGLE. WHERE ROOFS LOCATED IN BASIC WIND SPEED OF 110 MPH OR GREATER, SPECIAL METHODS OF FASTENING ARE REQUIRED. UNLESS OTHERWISE NOTED, ATTACHMENT OF ASPHALT SHINGLES SHALL CONFORM WITH ASTM D 3161 OR M-DC PA 107-95.

UNDERLAYMENT APPLICATION:

STAY IN PLACE.

FOR ROOF SLOPES FORM 2:12 TO 4:12, UNDERLAYMENT SHALL BE A MINIMUM 1. STARTING AT THE EAVE, A 19 INCH STRIP OF UNDERLAYMENT SHALL BE APPLIED PARALLEL WITH THE EAVE AND FASTENED SUFFICIENTLY TO

2. STARTING AT THE EAVE, 36 INCH WIDE STRIPS OF UNDERLAYMENT FELT SHALL BE APPLIED OVERLAPPING SUCCESSIVE SHEETS 19 INCHES AND FASTENED SUFFICIENTLY TO STAY IN PLACE.

FOR ROOF SLOPED 4:12 AND GREATER, UNDERLAYMENT SHALL BE A MINIMUM OF ONE LAYER OF UNDERLAYMENT FELT APPLIED AS FOLLOWS: STARTING AT THE EAVE, UNDERLAYMENT SHALL BE APPLIED SHINGLE FASHION PARALLEL TO THE EAVE, LAPPED 2 INCHES, AND FASTENED SUFFICIENTLY TO STAY IN PLACE.

BASE AND CAP FLASHINGS:

BASE AND CAP FLASHING SHALL BE INSTALLED IN ACCORDANCE W/ MFGR'S INSTALLATION INSTRUCTIONS. BASE FLASHING SHALL BE OF EITHER CORROSION RESISTANT METAL OF MINIMUM NOMINAL THICKNESS 0.019 INCH OR MINERAL SURFACE ROLL ROOFING WEIGHING A MINIMUM OF 77 LBS PER 100 SQUARE FEET. CAP FLASHING SHALL BE CORROSION RESISTANT METAL OF MINIMUM NOMINAL THICKNESS OF 0.019 INCH.

VALLEYS:

VALLEY LININGS SHALL BE INSTALLED IN ACCORDANCE W/ MANUFACTURER'S INSTALLATION INSTRUCTIONS BEFORE APPLYING ASPHALT SHINGLES. VALLEY LININGS OF THE FOLLOWING TYPES SHALL BE PERMITTED. 1. FOR OPEN VALLEYS LINED WITH METAL, THE VALLEY LINING SHALL BE

AT LEAST 16" WIDE AND OF ANY OF THE CORROSION RESISTANT METALS IN FBC TABLE 1507.3.9.2. 2. FOR OPEN VALLEYS, VALLEY LINING OF TWO PLIES OF MINERAL SURFACE ROLL ROOFING SHALL BE PERMITTED. THE BOTTOM LAYER SHALL BE 18 INCHES AND THE TOP LAYER A MINIMUM OF 36 INCHES WIDE.

3. FOR CLOSED VALLEYS VALLEY LINING SHALL BE ONE OF THE FOLLOWING:

 BOTH TYPES 1 AND 2 ABOVE, COMBINED. 2. ONE PLY OF SMOOTH ROLL ROOFING AT LEAST 36 INCHES WIDE AND COMPLYING WITH ASTM D 224.

3. SPECIALTY UNDERLAYMENT AT LEAST 36 INCHES WIDE AND COMPLYING WITH ASTM D 1970.

NOTE!!!

ROOFSHINGLES SHALL BE AS MANUFACTURED BY "TAMKO ROOFING PRODUCTS" OF THE FOLLOWING MODELS:

GLASS-SEAL AR ELITE GLASS-SEAL AR HERITAGE 30 AR HERITAGE 40 AR HERITAGE 50 AR

THESE SHINGLES MEET THE REQUIREMENTS OF ASTM D-3161 TYPE 1 MODIFIED TO 110 MPH WINDS & FBC TAS 100, USING 4 NAILS/SHINGLE


Copyright 2008 N.P. Geisler, Amitect DRAWN:


300 뿟

15DE@8

SHEET:


6 SHETS

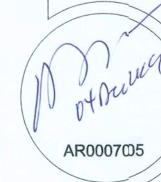

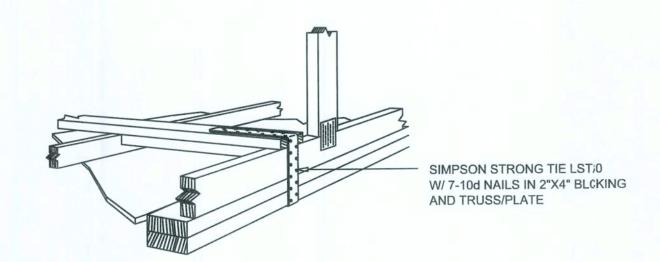

GABLE END GYPSUM DIAPHRAGM HOLDOWN CONNECTOR


SCALE: NONE

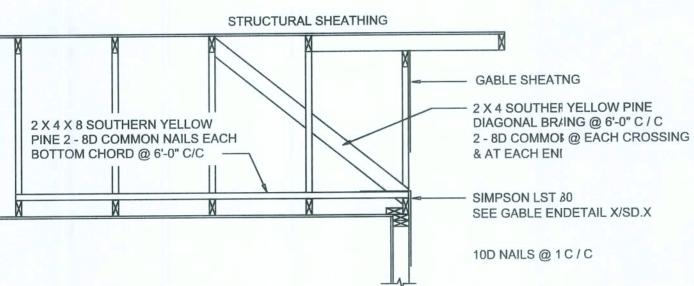

END WALL BRACING FOR **CEILING DIAPHRAGM**

(ALTERNATIVE TO BALLOON FRAMING) NOTE: ALL WOOD TO BE NUMBER 2 GRADE SOUTHERN YELLOW PIN

F	ROOF SHEATI	HING FASTEN	NINGS
NAILING ZONE	SHEATHING TYPE	FASTENER	SPACING 3
1	7/16 " O.S.B. OR 15/32 CDX	8d COMMON OR	6 in. o.c. EDGE _{GE} 12 in. o.c. FIEL _{ELD}
2		8d HOT DIPPED GALVANIZED	6 in. o.c. EDGE _{3E} 6 in. o.c. FIELD _{LD}
3		BOX NAILS	4 in. o.c. @ GABLE ET ENDWALL OR GABLE TRUSUSS 6 in. o.c. EDGE SE 6 in. o.c. FIELD

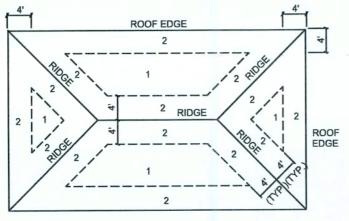

ROOF SHEATHING NAILING ZONES (HIP ROOF)


ROOF SHEATHING NAILING ZONES (GABLE ROOF)

Roof Nail Pattern DET.


SCALE: NONE


/		
		1
1	В	
	thems.	/


			BUILDING WIDTH (FT)				
HEADERS HEADER		20'		28'		36'	
SUPPORTING:	SIZE	SPAN	# JACKS	SPANN	# JACKS	SPAN	# JACKS
	2-2x4	3'-6"	1	3'-2"2"	1	2'-10"	1
ROOF, CEILING	2-2x6	5'-5"	1	4'-8"}"	1	4'-2"	1
	2-2x8	6'-10"	1	5'-11 1"	2	5'-4"	1
	2-2x10	8'-5"	2	7'-3"3"	2	6'-6"	2
	2-2x12	9'-9"	2	8'-5";"	2	7'-6"	2
	3-2x8	8'-4"	1	7'-5";"	1	6'-8"	1
	3-2x10	10'-6"	1	9'-1" "	2	8'-2"	1
	3-2x12	12'-2"	2	10'-7"7"	2	9'-5"	2
	4-2x8	9'-2"	1	8'-4" "	1	9'-2"	1
	4-2x10	11'-8"	1	10'-6"3"	1	9'-5"	1
	4-2x12	14'-1"	1	12'-2'.2"	2	10'-11"	1

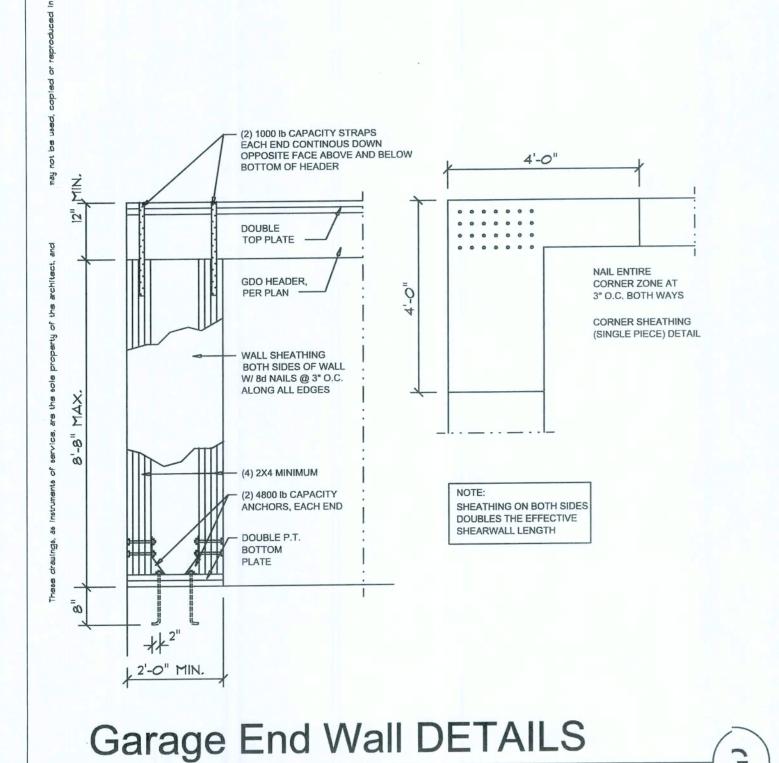


SCALE: 1/2" = 1'-0"

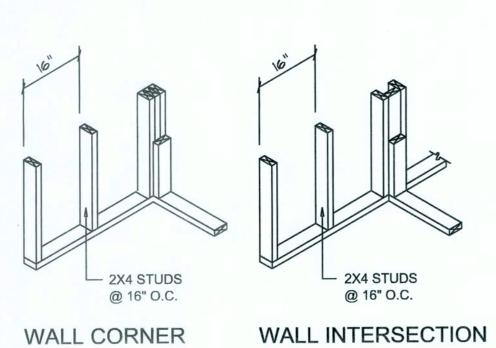

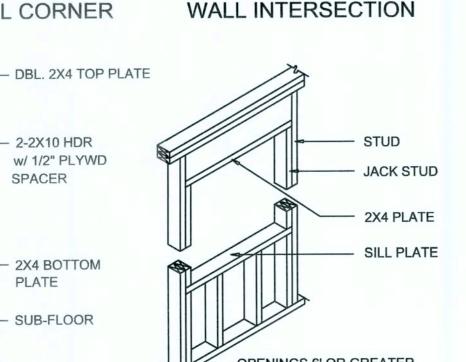


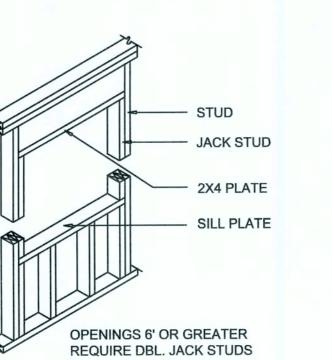



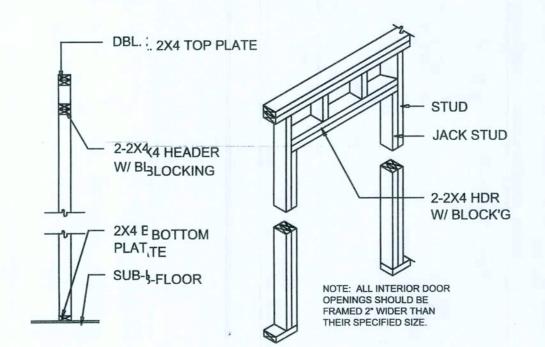


NON-BEALRING WALL HEADER

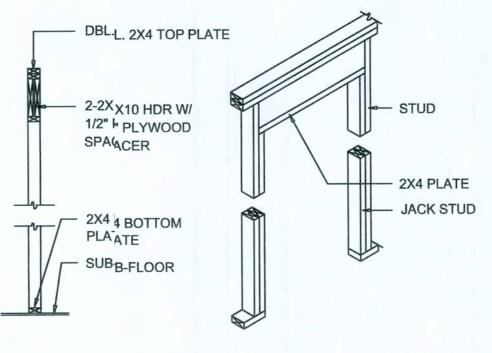

BEARING; WALL HEADER


Wall Framing/Header DETAILS

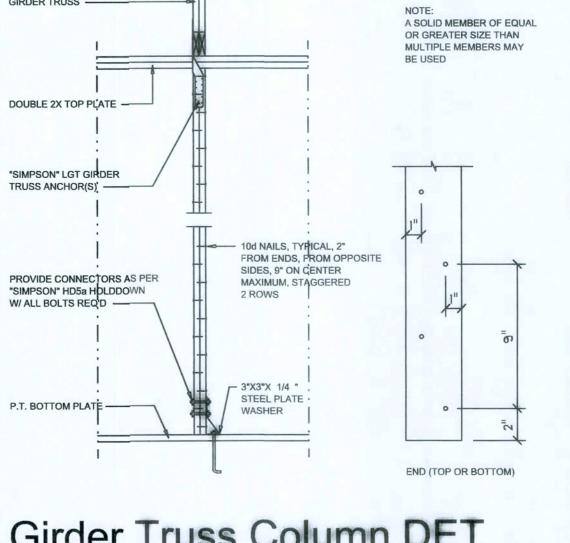

Girder Truss Column DET.

SCALE: 1/2" = 1'-0"

GIRDER TRUSS ----

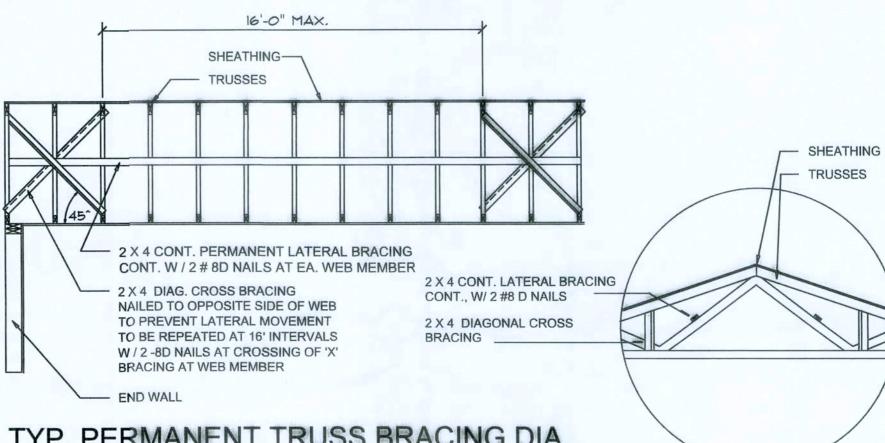


TYP. PERMANENT TRUSS BRACING DIA.

NOTE: ALL WOOD TO BE NUMBER 2 GRADE SOUTHERN YELLOW PINE

Truss Bracing DETAILS

SCALE: AS NOTED

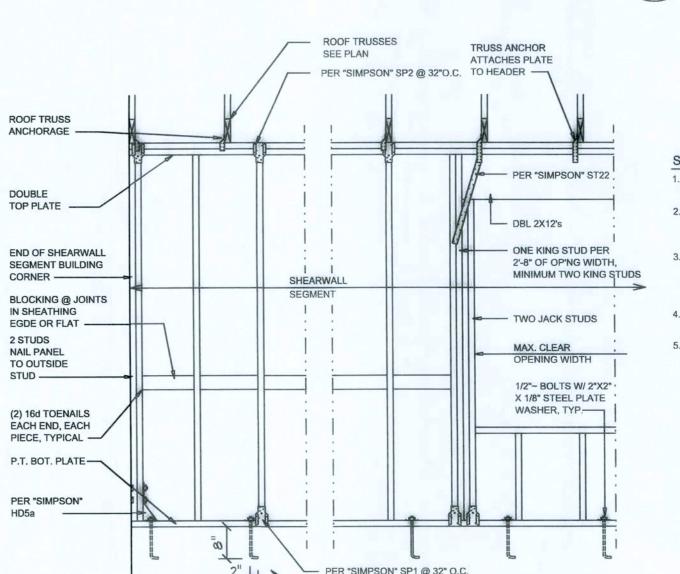

- 1. ALL SHEARWALLS SHALL BE TYPE 2 SHEARWALLS
- AS DEFINED BY STD 10-97 SBBCI 305.4.3. 2. THE WALL SHALL BE ENTIRELY SHEATHED WITH 7/16 " O.S.B. INCLUDING AREAS ABOVE AND BELOW
- 3. ALL SHEATHING SHALL BE ATTACHED TO FRAMING ALONG ALL FOUR EDGES WITH JOINTS FOR ADJACENT PANELS OCCURING OVER COMMON FRAMING MEMBERS OR ALONG BLOCKING.
- 4. NAIL SPACING SHALL BE 6" O.C. EDGES AND
- 12" O.C. IN THE FIELD. TYPE 2 SHEARWALLS ARE DESIGNED FOR THE OPENING IT CONTAINS. MAXIMUM HEIGHT OF OPENING SHALL BE 5/6 TIMES THE WALL HEIGHT. THE MINIMUM DISTANCE BETWEEN OPENINGS SHALL BE THE WALL HEIGHT/3.5 FOR 8'-0" WALLS (2'-3").

OPENING WIDTH	SILL PLATES	16d TOE NAILS EACH END
UP TO 6'-0"	(1) 2x4 OR (1) 2x6	1
> 6' TO 9'-0"	(3) 2x4 OR (1) 2x6	2
> 9' TO 12'-0"	(5) 2x4 OR (2) 2x6	3

Shear Wall DETAILS

SCALE: NONE



DRAWN:

REVISION:

1300 MODE GEN,

15DE¢08

SHEET: S.6 6 SHEETS

