

# Cool and Cobb Engineering Company

---

Date: 7/16/2021

Job: Mike House

Location: 228 SE Oak Hill St.  
Lake City, FL 32025

Message: As of this date I have inspected the Installation Log on the above noted project and based on the Installation Log I hereby approve the installation as being in accordance with the design completed and certified by me for this project. This certification does not address any possible sinkhole activity as defined in Florida Statute § 627.706.

Sincerely,

7/16/2021

Kenneth F Wheeler, P.E.

State of Florida

Professional Engineer No. 60417



Digitally signed by  
Kenneth F  
Wheeler:A01410D00000  
177F9B0868D00017594  
Date: 2021.07.16  
09:02:27 -04'00'

This item has been electronically sealed by Kenneth F. Wheeler using a digital signature and date. Printed copies of this document are not considered signed and sealed and the signature must be verified on any electronic copies.

203 W. Main St.  
Avon Park, FL 33825  
Office: (863) 657-2323  
Fax: (863) 657-2324  
Email: ken@coolandcobb.com

# Solid Foundations

2704 SW Main Blvd

Lake City, FL 32025

855-227-0300

[www.solidfoundations.com](http://www.solidfoundations.com)



SF Representative: Jimbo Willis

Cell: (386)288-3240

Email: [jimmie@solidfoundations.com](mailto:jimmie@solidfoundations.com)

## AS-BUILT


CONTRACT DATE: 1/7/2021

SUBMITTED TO: Mike House

ADDRESS: \_\_\_\_\_

EMAIL: \_\_\_\_\_

Phone: \_\_\_\_\_

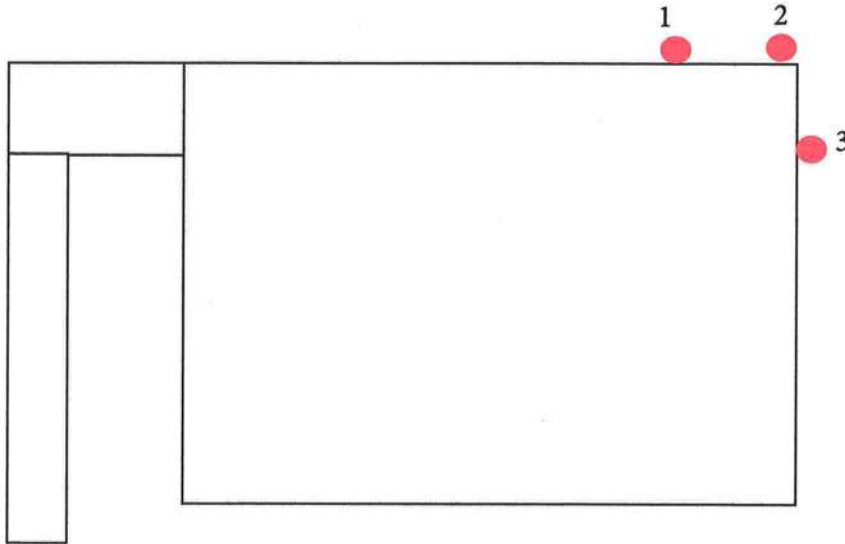

Digitally signed by

Kenneth F

Wheeler:A01410D000

00177F9B0868D0001

7594

Date: 2021.07.16

09:02:58 -04'00'

This item has been electronically sealed by Kenneth F. Wheeler using a digital signature and date. Printed copies of this document are not considered signed and sealed and the signature must be verified on any electronic copies.

Push Pier Model 300: ●

Push Pier Model 250: ●

Helical Pier: ●

Crawl Space Pier: ●

Interior Pier: ●

Low Profile Bracket: ●

Porch Bracket: ●

R&R Concrete ☐

Polyurethane 700: ■

Polyurethane 430: ■

Windows/Doors: ■

Floor Joist: ■

7/16/2021

Kenneth F. Wheeler, P.E.

PE# 60417

Cool and Cobb Engineering Co.

203 W. Main St.

Avon Park, FL 33825



2704 SW Main Blvd, Lake City FL 32025  
[www.SolidFoundations.com](http://www.SolidFoundations.com)

AS-BUILT

## HELICAL PILE INSTALLATION LOG

CLIENT NAME:

PROJECT NAME: Mike House

PROJECT ADDRESS: 228 SE Oak St. Lake City, FL 32025

PROJECT NUMBER: 21-0024

DATE: 7/7/2021

| PILE NUMBER |            | 1         | 2         | 3         | 4 | 5 | 6 | 7 | 8 | 9 | 10 |
|-------------|------------|-----------|-----------|-----------|---|---|---|---|---|---|----|
| Section     | Pier Depth |           |           |           |   |   |   |   |   |   |    |
| 1           | 7          | 700       | 700       | 700       |   |   |   |   |   |   |    |
| 2           | 14         | 800       | 800       | 800       |   |   |   |   |   |   |    |
| 3           | 21         | 900       | 900       | 900       |   |   |   |   |   |   |    |
| 4           | 28         | 1000@24ft | 1000@24ft | 1000@24ft |   |   |   |   |   |   |    |
| 5           |            |           |           |           |   |   |   |   |   |   |    |
| 6           |            |           |           |           |   |   |   |   |   |   |    |
NOTES:

PILE INSTALLER NAME: Jason Medlock

Reviewer: Dustin Gayheart

7/16/2021  
Kenneth F. Wheeler, P.E.  
PE# 60417



Digitally signed by  
Kenneth F  
Wheeler:A01410D00000  
177F9B0868D00017594  
Date: 2021.07.16  
09:03:34 -04'00'

Cool and Cobb Engineering Co.  
203 W. Main St.  
Avon Park, FL 33825