



TATOM  
RESIDENCE

SIGNATURE: \_\_\_\_\_  
DATE: 12/03/09

LAKE CITY,  
FLORIDA

LIMITATIONS OF USE:

THE DRAWINGS CONTAINED WITHIN THIS SET OF DOCUMENTS ARE INTENDED FOR THE ONE TIME USE IN REFERENCE TO THE PROJECT LISTED ABOVE ONLY. ANY UNAUTHORIZED COPYING OF OR UTILIZATION OF THE DOCUMENTS OR ANY PART WITHIN IS COPYRIGHT INFRINGEMENT OF INTELLECTUAL PROPERTY.

LIABILITY DISCLAIMER:

THE DRAWINGS CONTAINED WITHIN THIS SET OF DOCUMENTS ARE INTENDED FOR CONTRACTOR'S STANDARD CONSTRUCTION. W.E.B. DESIGNS IS RESPONSIBLE ONLY FOR THE ACCURATE REPRESENTATION, COORDINATION, AND DEPICTION OF THE GENERAL DESIGN. THE CONTRACTOR IS RESPONSIBLE AND LIABLE FOR THE SELECTION OF BOTH MATERIALS AND METHODS OF CONSTRUCTION IN REGARDS TO BUT NOT LIMITED TO THERMAL AND MOISTURE PROTECTION, PROPER APPLICATION AND INSTALLATION OF PRODUCTS ACCORDING TO MANUFACTURER'S RECOMMENDATIONS, AND THE UTILIZATION AND IMPLEMENTATION OF INDUSTRY STANDARDS. THE CONTRACTOR IS ALSO RESPONSIBLE FOR FIELD VERIFICATION OF ALL DIMENSIONS OF PREEXISTING CONSTRUCTION PRIOR TO THE FABRICATION OR COMMENCEMENT OF ANY NEW WORK. ACCEPTANCE BY CONTRACTOR OF THESE DRAWINGS FOR CONSTRUCTION IS ACKNOWLEDGMENT TO AND AGREEMENT WITH THESE TERMS AND CONDITIONS.

CONSTRUCTION  
DOCUMENTS FOR  
CONTRACTOR'S  
STANDARD  
CONSTRUCTION

PROJECT NO.: 09024


DATE: DECEMBER 03, 2009

REVISION DATES:

DATE CHECKED: DECEMBER 03, 2009

SLAB PLAN,  
SLAB DETAILS


S1.10

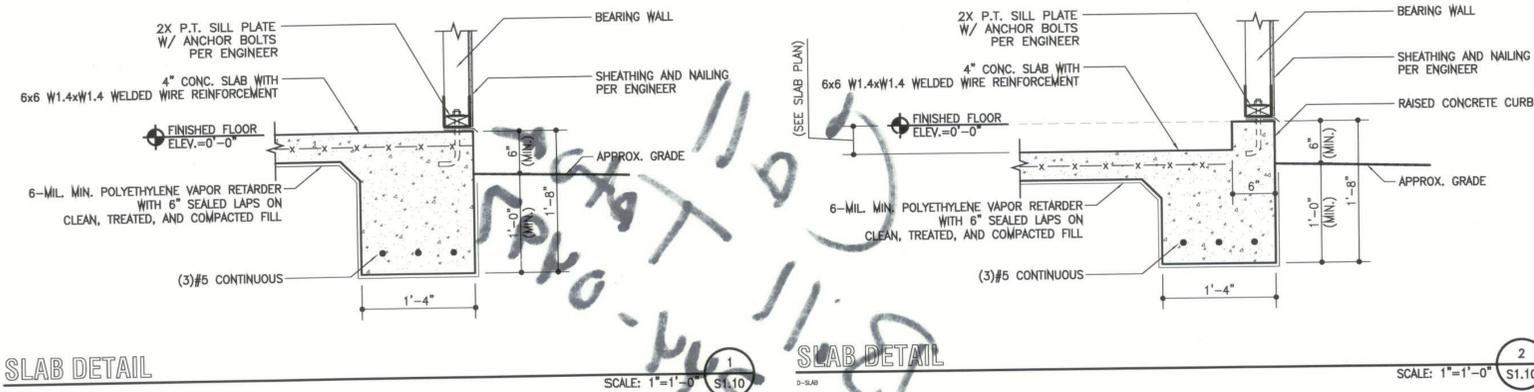

SLAB DETAIL


SCALE: 1"=1'-0" S1.10

SCALE: 1"=1'-0" S1.10

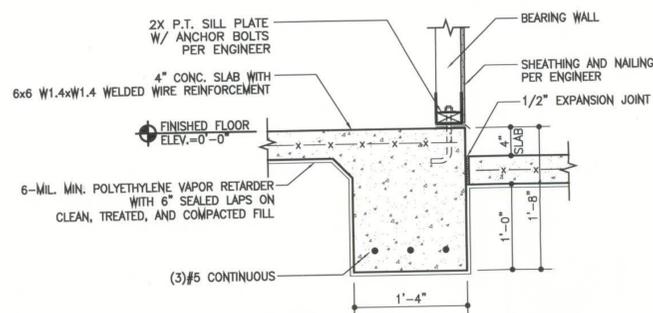


SLAB DETAIL

SCALE: 1"=1'-0" S1.10

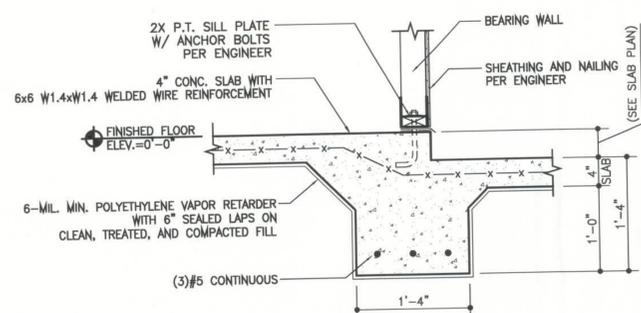

SLAB DETAIL

SCALE: 1"=1'-0" S1.10

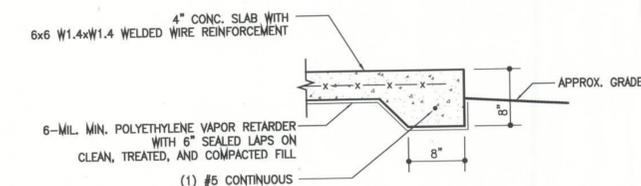

SLAB DETAIL (EXTERIOR CONCRETE PADS, SIDEWALKS, AND DRIVEWAYS)

SCALE: 1"=1'-0" S1.10

SLAB LEGEND


- F.D. FLOOR DRAIN
- BUILT-UP SLAB, SLOPE TO DRAIN PER CONTRACTOR'S STANDARD CONSTRUCTION
- EXTERIOR SLAB TO RECEIVE LIGHT BROOM FINISH
- RECESSED SLAB, SEE TAG FOR ELEVATION

NOTES:

1. STRUCTURAL REVIEWED AND CORRECTIONS BY:  
W.S.E. WAYLAND STRUCTURAL ENGINEERING
2. SEE STRUCTURAL ENGINEERING PACKAGE BY WISE WAYLAND STRUCTURAL ENGINEERING FOR ADDITIONAL INFORMATION.
3. WIND LOAD ANALYSIS AND ENGINEER'S MARKUPS AND DRAWINGS SUPERSEDE.
4. W.E.B. DESIGNS RECOMMENDS THAT SOIL TESTS BE PERFORMED ON SITE TO DETERMINE SOIL CLASSIFICATION, SOIL DENSITY, AND SOIL BEARING CAPACITY AND THAT THE RESULTS ARE REVIEWED BY A LICENSED STRUCTURAL ENGINEER FOR APPROVAL/RECOMMENDATIONS.
5. W.E.B. DESIGNS RECOMMENDS THAT TESTS BE PERFORMED TO DETERMINE THE ELEVATION OF THE WATER TABLE ON SITE AND ANY UNDERGROUND WATER MOVEMENT AND THAT ALL NECESSARY PRECAUTIONS ARE TAKEN TO ELIMINATE THE POTENTIAL EXISTENCE OF HYDROSTATIC PRESSURE IF NECESSARY.
6. CONTRACTOR SHALL COORDINATE WITH ALL APPLICABLE ENGINEERS THE LOCATION OF INTERIOR BEARING WALLS AND COLUMNS. REQUIRED LOCATIONS SHALL BE COORDINATED WITH THE TRUSS PACKAGE, SLAB PLAN, AND ALL TRADES AS REQUIRED.
7. SOIL SHALL BE COMPACTED TO A MINIMUM OF 95% OF MODIFIED PROCTOR AND TESTED IN LIFTS NOT TO EXCEED 12".

SLAB PLAN

09/09/04

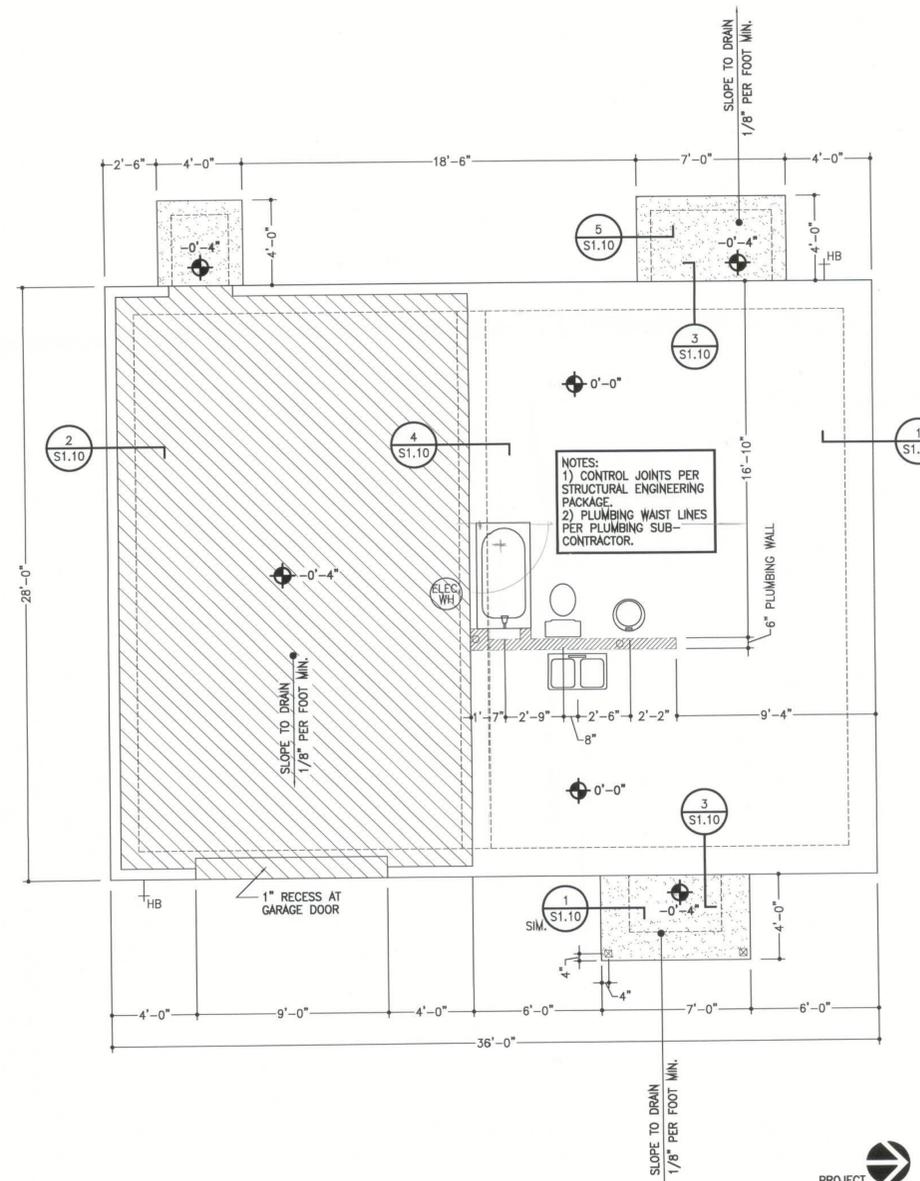

PROJECT  
SCALE: 1/4"=1'-0"