

COLUMBIA COUNTY PERMIT WORKSHEET

page 1 of 2


These worksheets must be completed and signed by the installer.
Submit the originals with the packet.

Installer Rusty L. Knoles License # TH1058219
911 Address where home is being installed 220 SW Turner Pl
Manufacturer Valco City fc 32025 Length x width 24x40

NOTE: if home is a single wide fill out one half of the blocking plan
if home is a triple or quad wide sketch in remainder of home

I understand Lateral Arm Systems cannot be used on any home (new or used)
where the sidewall ties exceed 5 ft 4 in

Installer's initials RLK

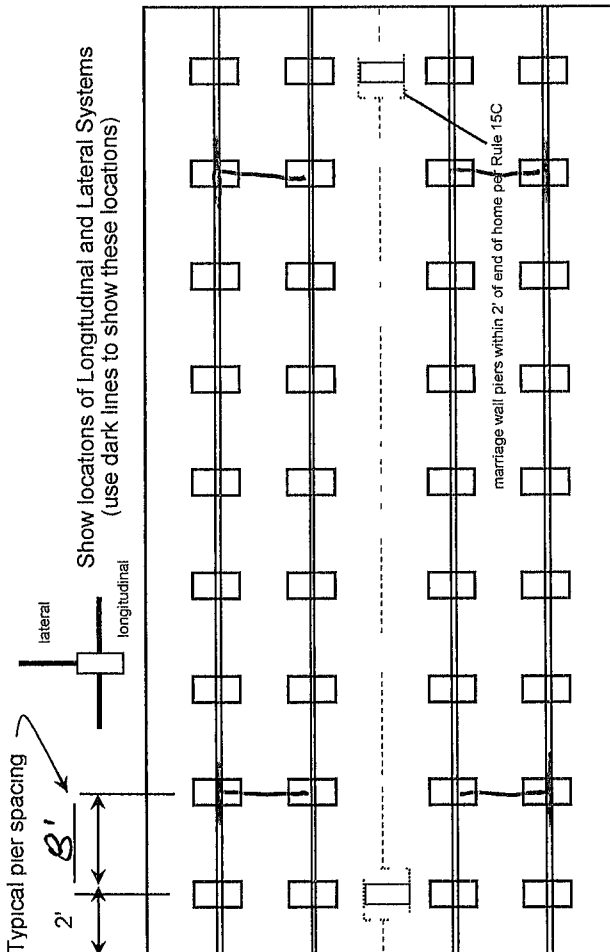

New Home ☐ Used Home ☒
Home installed to the Manufacturer's Installation Manual ☐
Home is installed in accordance with Rule 15-C ☒
Single wide ☐ Wind Zone II ☒ Wind Zone III ☐
Double wide ☒ Installation Decal # 20741
Triple/Quad ☐ Serial # N84109A3B

PIER SPACING TABLE FOR USED HOMES

Load bearing capacity	Footer size (sq in)	16" x 16" (256)	18 1/2" x 18 1/2" (342)	20" x 20" (400)	22" x 22" (484)*	24" x 24" (576)*	26" x 26" (676)
1000 psf	3'	4'	4'	5'	6'	7'	8'
1500 psf	4'	6'	6'	7'	8'	8'	8'
2000 psf	6'	8'	8'	8'	8'	8'	8'
2500 psf	7'	8'	8'	8'	8'	8'	8'
3000 psf	8'	8'	8'	8'	8'	8'	8'
3500 psf	8'	8'	8'	8'	8'	8'	8'

* interpolated from Rule 15C-1 pier spacing table

PIER PAD SIZES

I-beam pier pad size 23 1/4 x 31 1/4
Perimeter pier pad size N/A
Other pier pad sizes (required by the mfg) 16x16

Draw the approximate locations of marriage wall openings 4 foot or greater Use this symbol to show the piers

List all marriage wall openings greater than 4 foot and their pier pad sizes below

Opening over 15' Pier pad size 24x24

ANCHORS

4 ft ☒ 5 ft ☒

FRAME TIES

within 2' of end of home spaced at 5' 4" oc

TIEDOWN COMPONENTS

Longitudinal Stabilizing Device (LSD)
Manufacturer Oliver Technologies
Longitudinal Stabilizing Device w/ Lateral Arms
Manufacturer Oliver Technologies

OTHER TIES

Number 16
Sidewall 4
Longitudinal 2
Marriage wall 2
Shearwall 2

COLUMBIA COUNTY PERMIT WORKSHEET

page 2 of 2

POCKET PENETROMETER TEST

The pocket penetrometer tests are rounded down to _____ psf or check here to declare 1000 lb soil _____ without testing

X 1.0 X 1.0 X 1.0

POCKET PENETROMETER TESTING METHOD

- 1 Test the perimeter of the home at 6 locations
- 2 Take the reading at the depth of the footer
- 3 Using 500 lb increments, take the lowest reading and round down to that increment.

X 1.0 X 1.0 X 1.0

TORQUE PROBE TEST

The results of the torque probe test is 1465 inch pounds or check here if you are declaring 5' anchors without testing _____ A test showing 275 inch pounds or less will require 5 foot anchors

Note: A state approved lateral arm system is being used and 4 ft. anchors are allowed at the sidewall locations I understand 5 ft anchors are required at all centerline tie points where the torque test reading is 275 or less and where the mobile home manufacturer may requires anchors with 4000 lb holding capacity

Installer's initials

ALL TESTS MUST BE PERFORMED BY A LICENSED INSTALLER

Installer Name

Date Tested

Electrical

Connect electrical conductors between multi-wide units, but not to the main power source This includes the bonding wire between multi-wide units Pg 152-1

Plumbing

Connect all sewer drains to an existing sewer tap or septic tank. Pg 152-1

Connect all potable water supply piping to an existing water meter, water tap, or other independent water supply systems Pg 152-1

Site Preparation

Debris and organic material removed _____
Water drainage Natural _____ Swale _____ Pad _____ Other _____

Fastening multi wide units

Floor Type Fastener Wass Length 6" Spacing 20"
Walls Type Fastener Screws Length 4" Spacing 24"
Roof Type Fastener Stap Length 1 3/4" Spacing 48"
For used homes a min 30 gauge, 8" wide, galvanized metal strip will be centered over the peak of the roof and fastened with galv roofing nails at 2" on center on both sides of the centerline

Gasket (weatherproofing requirement)

I understand a properly installed gasket is a requirement of all new and used homes and that condensation, mold, mildew and buckled marriage walls are a result of a poorly installed or no gasket being installed I understand a strip of tape will not serve as a gasket.

Installer's initials

Type gasket

Pg 152-1

Installed

Between Floors Yes _____

Between Walls Yes _____

Bottom of ridgebeam Yes _____

Weatherproofing

The bottomboard will be repaired and/or taped Yes _____ Pg 152-1
Siding on units is installed to manufacturer's specifications Yes _____
Fireplace chimney installed so as not to allow intrusion of rain water Yes _____

Miscellaneous

Skirting to be installed Yes _____ No _____

Dryer vent installed outside of skirting Yes _____ N/A _____

Range downflow vent installed outside of skirting Yes _____ N/A _____

Drain lines supported at 4 foot intervals Yes _____

Electrical crossovers protected Yes _____


Other _____

Installer verifies all information given with this permit worksheet is accurate and true based on the

Installer Signature

Date 3-6-14

24x40

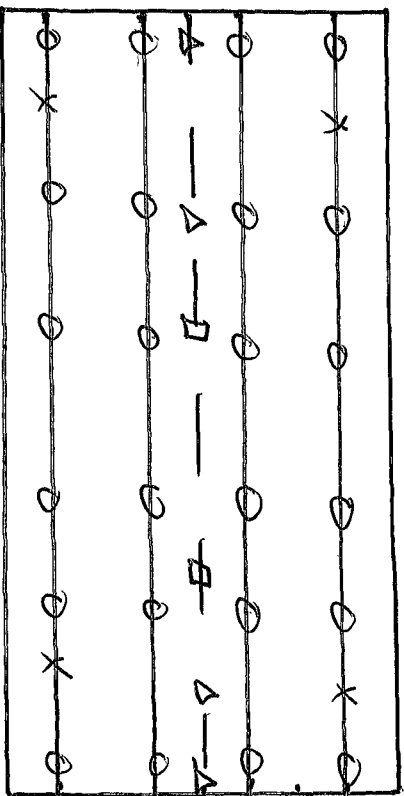

X - 4-1101V All steel foundation snow olives tech

O - I Beam piers 8' o.c. using 23 1/4 x 3 1/4 Abs pads

Δ - Center line piers 8' o.c. using 16 x 16 Abs pads

□ - center line piers on opening over 15' 24x24 Abs pads