


Mobile Home Permit Worksheet

Installer: Dale Houston License # 1H1133271
 Address of home being installed SW Vixen Ln
Fort White FL 32038
 Manufacturer Clayton Length x width 16x74

NOTE: if home is a single wide fill out one half of the blocking plan
 if home is a triple or quad wide sketch in remainder of home
 I understand Lateral Arm Systems cannot be used on any home (new or used)
 where the sidewall ties exceed 5 ft 4 in.

Typical pier spacing

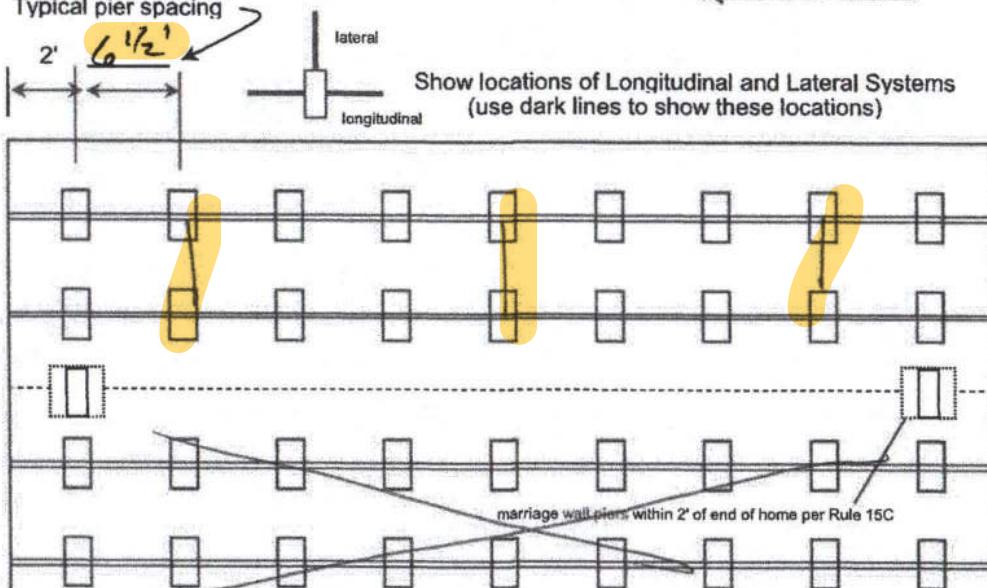

See Attached Diagram



06-08-2023

Application Number: _____

Date: _____

New Home

Used Home

Home installed to the Manufacturer's Installation Manual
 Home is installed in accordance with Rule 15-C



Single wide

Wind Zone II Wind Zone III

Double wide

Installation Decal # _____

Triple/Quad

Serial # WHC030510GA

PIER SPACING TABLE FOR USED HOMES

Load bearing capacity	Footer size (sq in)	16" x 16" (256)	18 1/2" x 18 1/2" (342)	20" x 20" (400)	22" x 22" (484)*	24" X 24" (576)*	26" x 26" (676)
1000 psf	3'	4'	5'	6'	7'	8'	
1500 psf	4' 6"	6'	7'	8'	8'	8'	
2000 psf	6'	8'	8'	8'	8'	8'	
2500 psf	7' 6"	8'	8'	8'	8'	8'	
3000 psf	8'	8'	8'	8'	8'	8'	
3500 psf	8'	8'	8'	8'	8'	8'	

* interpolated from Rule 15C-1 pier spacing table.

PIER PAD SIZES

I-beam pier pad size

2 3 x 3 1

Perimeter pier pad size

16 x 16

Other pier pad sizes (required by the mfg.)

Draw the approximate locations of marriage wall openings 4 foot or greater. Use this symbol to show the piers.

List all marriage wall openings greater than 4 foot and their pier pad sizes below.

Opening

Pier pad size

N 1/4

N 1/4

ANCHORS

4 ft

5 ft

FRAME TIES

within 2' of end of home
 spaced at 5' 4" oc

OTHER TIES

Number
 Sidewall 5 1/4
 Longitudinal 6
 Marriage wall 1 1/2
 Shearwall 1/2

TIEDOWN COMPONENTS

Longitudinal Stabilizing Device (LSD)

Manufacturer Other

Longitudinal Stabilizing Device w/ Lateral Arms

Manufacturer Other

Mobile Home Permit Worksheet

Application Number: _____ Date: _____

POCKET PENETROMETER TEST

The pocket penetrometer tests are rounded down to _____ psf or check here to declare 1000 lb. soil without testing.

POCKET PENETROMETER TESTING METHOD

1. Test the perimeter of the home at 6 locations.
2. Take the reading at the depth of the footer.
3. Using 500 lb. increments, take the lowest reading and round down to that increment.

TORQUE PROBE TEST

The results of the torque probe test is _____ inch pounds or check here if you are declaring 5' anchors without testing _____. A test showing 275 inch pounds or less will require 5 foot anchors.

Note: A state approved lateral arm system is being used and 4 ft. anchors are allowed at the sidewall locations. I understand 5 ft anchors are required at all centerline tie points where the torque test reading is 275 or less and where the mobile home manufacturer may requires anchors with 4000 lb holding capacity.

DH

Installer's initials

ALL TESTS MUST BE PERFORMED BY A LICENSED INSTALLER

Installer Name

Dale Houston

Date Tested

Electrical

Connect electrical conductors between multi-wide units, but not to the main power source. This includes the bonding wire between multi-wide units. Pg. *95*

Plumbing

Connect all sewer drains to an existing sewer tap or septic tank. Pg. *69*

Connect all potable water supply piping to an existing water meter, water tap, or other independent water supply systems. Pg. *98*



Site Preparation

Debris and organic material removed

Water drainage: Natural Swale Pad Other

Fastening multi wide units

Floor:

Type Fastener: **N/A**

Length: **N/A**

Spacing: **N/A**

Walls:

Type Fastener: **N/A**

Length: **N/A**

Spacing: **N/A**

Roof:

Type Fastener:

Length: **N/A**

Spacing: **N/A**

For used homes a min. 30 gauge, 8" wide, galvanized metal strip will be centered over the peak of the roof and fastened with galv. roofing nails at 2" on center on both sides of the centerline.

Gasket (weatherproofing requirement)

I understand a properly installed gasket is a requirement of all new and used homes and that condensation, mold, mildew and buckled marriage walls are a result of a poorly installed or no gasket being installed. I understand a strip of tape will not serve as a gasket.

Installer's initials

N/A

Type gasket **N/A**

Pg.

Installed:

Between Floors Yes

Between Walls Yes

Bottom of ridgebeam Yes

N/A

Weatherproofing

The bottomboard will be repaired and/or taped. Yes

Pg. 112

Siding on units is installed to manufacturer's specifications. Yes

Yes

Fireplace chimney installed so as not to allow intrusion of rain water. Yes

Yes

N/A

Miscellaneous

Skirting to be installed Yes

No

Dryer vent installed outside of skirting. Yes

N/A

Range downflow vent installed outside of skirting. Yes

Drain lines supported at 4 foot intervals. Yes

N/A

Electrical crossovers protected. Yes

Other: _____

N/A

Installer verifies all information given with this permit worksheet is accurate and true based on the manufacturer's installation instructions and or Rule 15C-1 & 2

Installer Signature *Dale Houston*

Date *2/25/23*

20 LB ROOF LOAD SIDEWALL OPENING PIER LOAD 16' BOX WIDTH	SIDEWALL OPENING (FT) REQUIRED PIER LOAD (LBS)					
	3	4	5	6	8	10
	1244	1413	1581	1750	2088	2425

*FOR 30 LB & 40 LB ROOF LOAD REFER TO TABLES 7 & 7a IN THE INSTALLATION MANUAL.



PIER LEGEND

- = PIER MAIN BEAM
- = PIER PERIMETER
- = PIER PORCH/RECESSED ENTRY

SERVICE DROP LEGEND

- E** = ELECTRICAL DROP
- W** = WATER INLET
- D** = DWV PLUMBING DROP
- G** = GAS INLET



DATE DRAWN	11/25/2019
DATE PRINTED	3/1/2022
SCALE	3/16"=1'
PLAN NO.	CE-S010-76-3
SHEET NAME	99.5 FRAME PIERS
SHEET NO.	SU-1.
MODEL NAME	Sydney
MODEL NO.	CEA16763AH
MODEL SGT.	1140
BOX SIZE	16" X 76"
DRAWN BY	Alex Whaley
DATE DRAWN	11/25/2019
DATE PRINTED	3/1/2022
SCALE	3/16"=1'
PLAN NO.	CE-S010-76-3
SHEET NAME	99.5 FRAME PIERS
SHEET NO.	SU-1.

NOTES.

1. REFER TO TABLES 6 AND 6a IN THE INSTALLATION MANUAL FOR LOAD ON FRAME PIER FOOTINGS FOR HOMES THAT DO NOT REQUIRE PERIMETER BLOCKING. REFER TO TABLES 7 AND 7a IN THE INSTALLATION MANUAL FOR LOAD ON FRAME PIER FOOTINGS FOR HOMES THAT REQUIRE PERIMETER BLOCKING. REFER TO TABLES 10 AND 10a TO DETERMINE FOOTING SIZE FOR ALL PIERS.
2. REFER TO TABLE 9 FOR PIER CONFIGURATION AND MAXIMUM ALLOWABLE HEIGHTS. CROSS REFERENCE THE PIER HEIGHT WITH THE MAXIMUM ALLOWABLE FLOOR HEIGHT LISTED IN THE FRAME TIEDOWN CHARTS (TABLE 18, 19, AND 20).
3. THE MAXIMUM SPACING FOR FRAME SUPPORT PIERS FOR 8" I-BEAMS IS 8 FEET, 10" & 12" I-BEAMS IS 10 FEET.
4. SERVICE DROP LOCATIONS IDENTIFIED ARE APPROXIMATE.
5. FLOOR WIDTH SHOWN IS FOR STANDARD PRODUCT ONLY. CONTACT THE MFG FACILITY FOR SPECIFICATIONS OF OPTIONS ORDERED.

