

COLUMBIA COUNTY PERMIT WORKSHEET

page 1 of 2

These worksheets must be completed and signed by the installer.
Submit the originals with the packet.

Installer Rudy L. Kewen License # EL1039219


911 Address where home is being installed NW Wilton Way

Manufacturer Live Oak Length x width 28 x 60

NOTE: if home is a single wide fill out one half of the blocking plan
if home is a triple or quad wide sketch in remainder of home

I understand Lateral Arm Systems cannot be used on any home (new or used) where the sidewall ties exceed 5 ft 4 in.

Installer's initials RLK

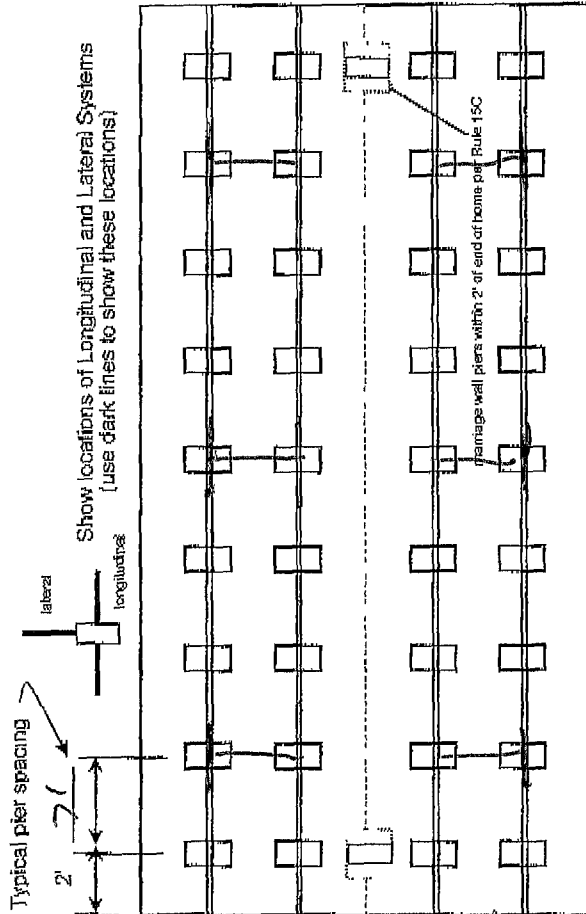

New Home ☒ Used Home ☐
Home installed to the Manufacturer's Installation Manual ☒
Home is installed in accordance with Rule 15-C ☐
Single wide ☐ Wind Zone II ☒ Wind Zone III ☐
Double wide ☒ Installation Decal # 18209
Triple/Quad ☐ Serial # ordered

LOHGA11314962AB

PIER SPACING TABLE FOR USED HOMES

Load bearing capacity (sq in)	16" x 16" (256)	18 1/2" x 18 1/2" (342)	20" x 20" (400)	22" x 22" (484)*	24" x 24" (576)*	28" x 28" (676)
1000 psf	3'	4'	5'	6'	7'	8'
1500 psf	4'	5'	6'	7'	8'	9'
2000 psf	5'	6'	7'	8'	9'	10'
2500 psf	6'	7'	8'	9'	10'	11'
3000 psf	7'	8'	9'	10'	11'	12'
3500 psf	8'	9'	10'	11'	12'	13'

* interpolated from Rule 15C-1 pier spacing table

PIER PAD SIZES

I-beam pier pad size 23 1/4 x 3 1/4

Perimeter pier pad size NA

Other pier pad sizes (required by the mfg.) 16 x 16

Draw the approximate locations of marriage wall openings 4 foot or greater. Use this symbol to show the piers.

List all marriage wall openings greater than 4 foot and their pier pad sizes below.

Opening

Pier pad size

23 1/4 x 3 1/4

POPULAR PAD SIZES

Pad Size	Sq In
16 x 16	256
18 x 18	324
18 1/2 x 18 1/2	342
20 x 20	400
22 x 22	484
24 x 24	576
28 x 28	784

ANCHORS

4 ft

5 ft

FRAME TIES

within 2' of end of home spaced at 5' 4" oc

OTHER TIES

Number 22
Sidewall 6
Longitudinal 2
Marriage wall 2
Shearwall 2

TIEDOWN COMPONENTS

Longitudinal Stabilizing Device (LSD)

Manufacturer Oliver Tech

Longitudinal Stabilizing Device w/ Lateral Arms

Manufacturer Oliver Tech

COLUMBIA COUNTY PERMIT WORKSHEET

page 2 of 2

POCKET PENETROMETER TEST

The pocket penetrometer tests are rounded down to _____ psf or check here to declare 1000 lb soil _____ without testing.

X 1.0

X 1.0

X 1.0

POCKET PENETROMETER TESTING METHOD

1 Test the perimeter of the home at 6 locations.
2 Take the reading at the depth of the footer
3 Using 500 lb increments, take the lowest reading and round down to that increment.

X 1.0

X 1.0

X 1.0

TORQUE PROBE TEST

The results of the torque probe test is NA inch pounds or check here if you are declaring 5' anchors without testing _____ A test showing 275 inch pounds or less will require 5 foot anchors.

Note: A state approved lateral arm system is being used and 4 ft. anchors are allowed at the sidewall locations. I understand 5 ft anchors are required at all centerline tie points where the torque test reading is 275 or less and where the mobile home manufacturer may requires anchors with 4000 lb holding capacity

ALL TESTS MUST BE PERFORMED BY A LICENSED INSTALLER

Installer Name

1-10-13

Date Tested

1-10-13

Installer's initials

RLK

Site Preparation

Debris and organic material removed _____
Water drainage Natural _____ Swale _____ Pad _____ Other _____

Fastening multi wide units

Floor Type Fastener LAGS Length 6" Spacing 20"
Walls Type Fastener LAGS Length 4" Spacing 24"
Roof Type Fastener LAGS Length 1 1/4" Spacing 48"
For used homes a min 30 gauge, 3" wide, galvanized metal strip will be centered over the peak of the roof and fastened with galv roofing nails at 2' on center on both sides of the centerline.

Gasket (weatherproofing requirement)

I understand a properly installed gasket is a requirement of all new and used homes and that condensation, mold, mildew and buckled marriage walls are a result of a poorly installed or no gasket being installed. I understand a strip of tape will not serve as a gasket.

Installer's initials

RLK

Type gasket

Pg. 10 Factory _____
Installed _____
Between Floors Yes _____
Between Walls Yes _____
Bottom of ridgebeam Yes _____

Weatherproofing

The bottomboard will be repaired and/or taped. Yes _____
Siding on units is installed to manufacturer's specifications. Yes _____ Pg. 152-1
Fireplace chimney installed so as not to allow intrusion of rain water Yes _____

Miscellaneous

Skirting to be installed Yes _____ No _____
Dryer vent installed outside of skirting. Yes _____ N/A _____
Range downflow vent installed outside of skirting. Yes _____ N/A _____
Drain lines supported at 4 foot intervals. Yes _____
Electrical crossovers protected. Yes _____
Other _____

Installer verifies all information given with this permit worksheet is accurate and true based on the

Installer Signature

1-10-14

Date

1-10-14

Electrical


Connect electrical conductors between multi-wide units, but not to the main power source. This includes the bonding wire between multi-wide units. Pg. 152-1

Plumbing

Connect all sewer drains to an existing sewer tap or septic tank. Pg. 152-1
Connect all potable water supply piping to an existing water meter, water tap, or other independent water supply systems. Pg. 152-1

53

6-1101V from Oliver Technologies
I Beam piers 7' o.c. using 23" x 3 1/4"

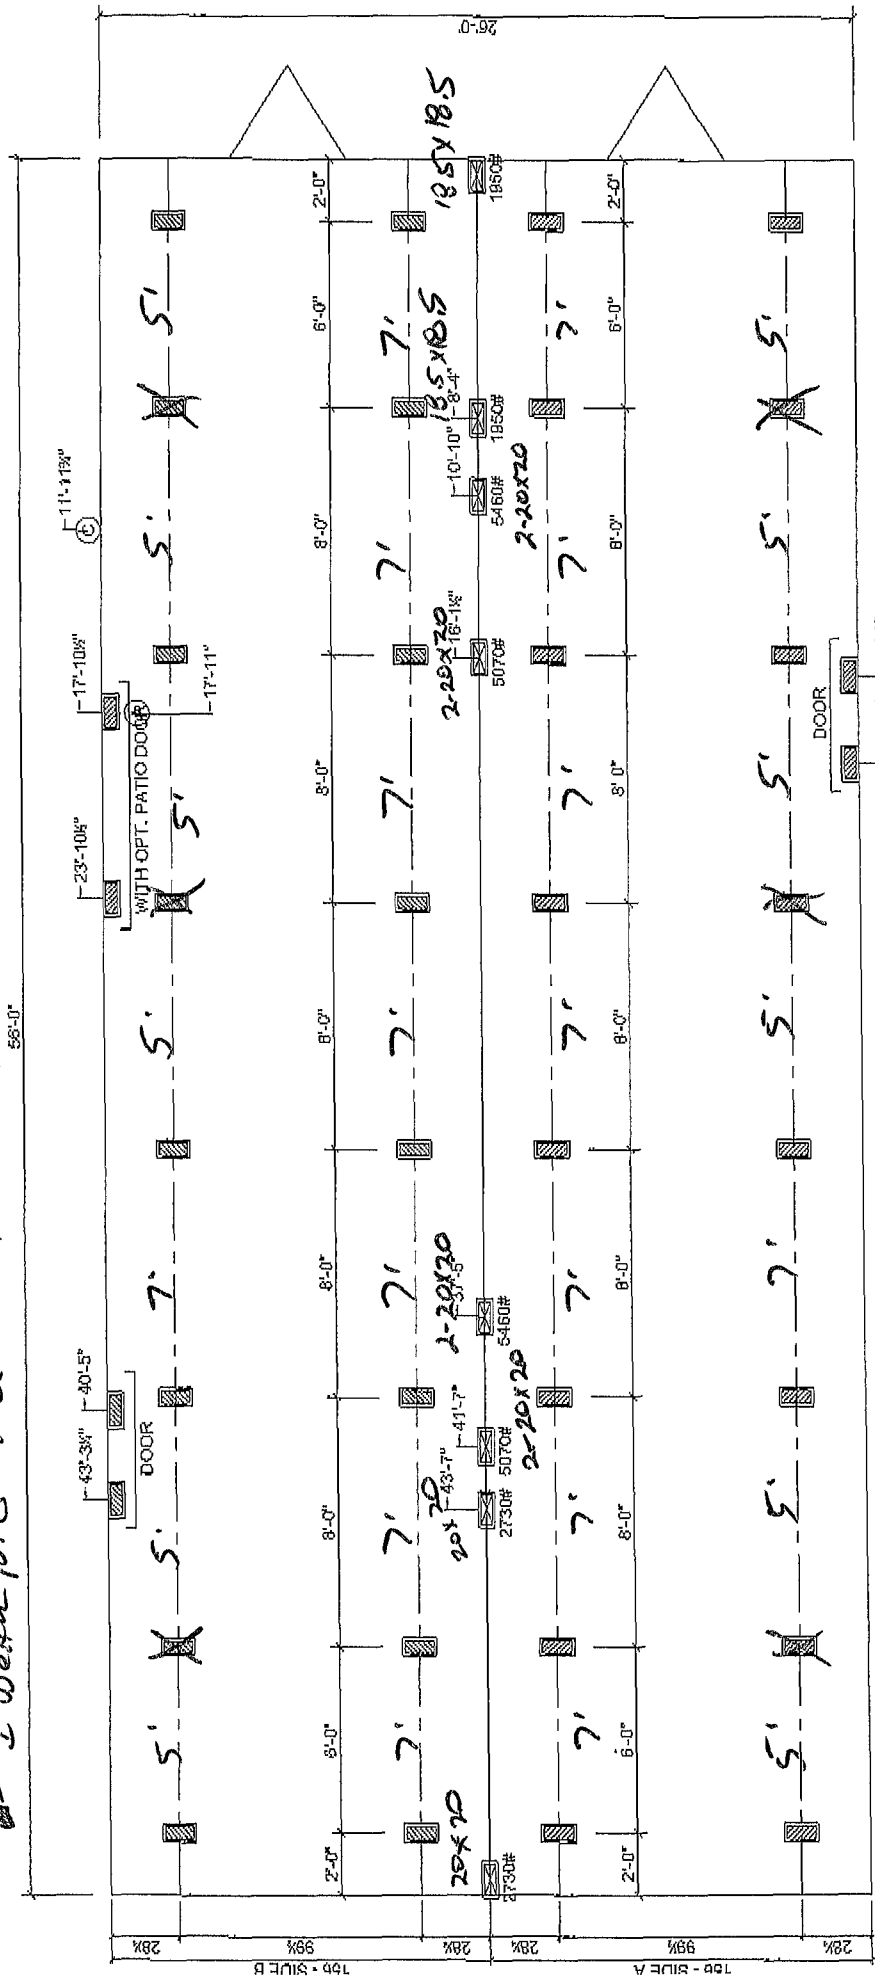

53

MARRIAGE LINE OPENING SUPPORT PIER/TYP
SUPPORT PIER/TYP

3/17/08

FOUNDATION NOTES:

THIS DRAWING IS DESIGNED FOR THE STANDARD WIND ZONE AND IS TO BE USED IN CONJUNCTION WITH THE INSTALLATION MANUAL AND ITS SUPPLEMENTS.
FOOTINGS ARE SHOWN FOR EXAMPLE ONLY QUANTITY AND SPACING MAY VARY BASED ON PAD TYPE, SOIL CONDITION, ETC.
FOOTINGS ARE REQUIRED AT SUPPORT POSTS, SEE INSTALLATION MANUAL FOR REQUIREMENTS.

- (A) MAIN ELECTRICAL
- (B) ELECTRICAL CROSSOVER
- (C) WATER INLET
- (D) WATER CROSSOVER (IF ANY)
- (E) GAS INLET (IF ANY)
- (F) GAS CROSSOVER (IF ANY)
- (G) DUCT CROSSOVER
- (H) SEWER DROPS
- (I) RETURN AIR (W/OPT. HEAT PUMP OH DUCT)
- (J) SUPPLY AIR (W/OPT. HEAT PUMP OH DUCT)

Live Oak Homes
MODEL: S-2563B - 28 X 56
3-BEDROOM / 2-BATH

M-2563D