



Mobile Home Permit Worksheet

Installer: Ernest Scott Johnson License # 1H/1025249
 Address of home being installed 430 SW Bishop
Lake City FL 32024
 Manufacturer Palm Harbor Length x width 30 x 52

NOTE: If home is a single wide fill out one half of the blocking plan
 If home is a triple or quad wide sketch in remainder of home
 I understand Lateral Arm Systems cannot be used on any home (new or used)
 where the sidewall ties exceed 5 ft 4 in.

Installer's initials ESJ

Typical pier spacing

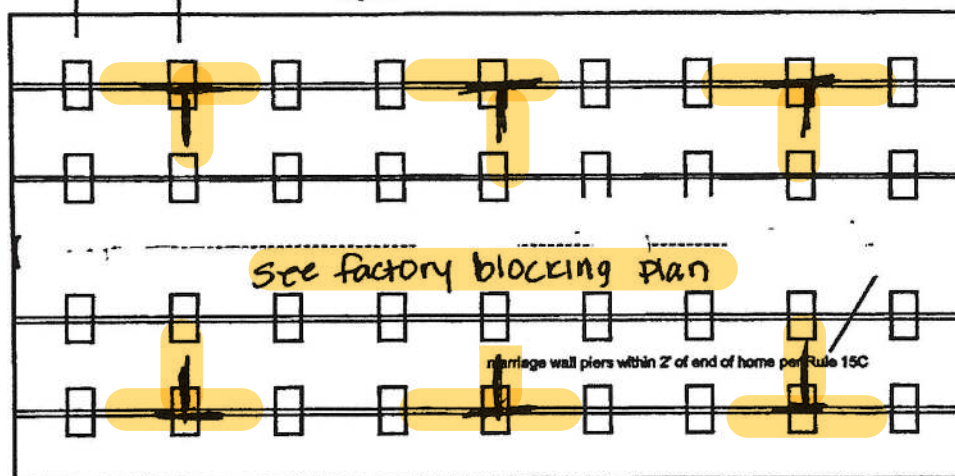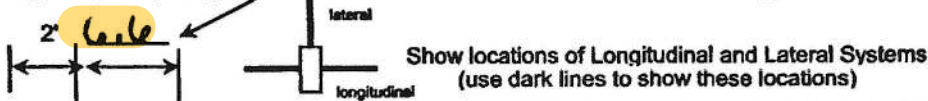

11-29-2022

Application Number: _____ Date: _____

New Home ☒ Used Home ☐

Home installed to the Manufacturer's Installation Manual
 Home is installed in accordance with Rule 15-C ☒

Single wide ☐ Wind Zone II ☒ Wind Zone III ☐

Double wide ☒ Installation Decal # 94300

Triple/Quad ☐ Serial # PHH 340F122-22823AB

PIER SPACING TABLE FOR USED HOMES

Load bearing capacity	Footer size (sq in)	16' x 16' (256)	18 1/2' x 18 1/2' (342)	20' x 20' (400)	22' x 22' (484)	24' x 24' (576)	26' x 26' (676)
1000 psf		3'	4'	5'	6'	7'	8'
1500 psf		4' 6"	6'	7'	8'	8'	8'
2000 psf		6'	8'	8'	8'	8'	8'
2500 psf		7' 6"	8'	8'	8'	8'	8'
3000 psf		8'	8'	8'	8'	8'	8'
3500 psf		8'	8'	8'	8'	8'	8'

* interpolated from Rule 15C-1 pier spacing table.

PIER PAD SIZES

I-beam pier pad size 17.5 x 25.5 6.6"

Perimeter pier pad size 17.5 x 25.5

Other pier pad sizes
(required by the mfg.)

Draw the approximate locations of marriage wall openings 4 foot or greater. Use this symbol to show the piers.

List all marriage wall openings greater than 4 foot and their pier pad sizes below.

Opening Pier pad size

See
factory
blocking plan

TIEDOWN COMPONENTS

Longitudinal Stabilizing Device (LSD)
 Manufacturer
 Longitudinal Stabilizing Device w/ Lateral Arms
 Manufacturer Oliver 1101V

POPULAR PAD SIZES

Pad Size	Sq In
16 x 16	256
16 x 18	288
18.5 x 18.5	342
16 x 22.5	360
17 x 22	374
13 1/4 x 26 1/4	348
20 x 20	400
17 3/16 x 25 3/16	441
17 1/2 x 25 1/2	446
24 x 24	576
26 x 26	676

ANCHORS

4 ft ☒ 5 ft ☒

FRAME TIES

within 2' of end of home
 spaced at 5' 4" oc ☒

OTHER TIES

	Number
Sidewall	<u>24</u>
Longitudinal	<u>40</u>
Marriage wall	<u>4</u>
Shearwall	<u>2</u>

Mobile Home Permit Worksheet

Application Number: _____ Date: _____

POCKET PENETROMETER TEST

The pocket penetrometer tests are rounded down to _____ psf or check here to declare 1000 lb. soil without testing.

x 1000 x 1000 x 1000

POCKET PENETROMETER TESTING METHOD

1. Test the perimeter of the home at 6 locations.
2. Take the reading at the depth of the footer.
3. Using 500 lb. increments, take the lowest reading and round down to that increment.



x 1000 x 1000 x 1000

TORQUE PROBE TEST

The results of the torque probe test is _____ inch pounds or check here if you are declaring 5' anchors without testing. A test showing 275 inch pounds or less will require 5 foot anchors.

Note: A state approved lateral arm system is being used and 4 ft. anchors are allowed at the sidewall locations. I understand 5 ft anchors are required at all centerline tie points where the torque test reading is 275 or less and where the mobile home manufacturer may requires anchors with 4000 lb. holding capacity.

Installer's Initials

ALL TESTS MUST BE PERFORMED BY A LICENSED INSTALLER

Installer Name

Ernest Scott Johnson

Date Tested

Assumed driver 11/14 uses 4 & 5' anchors Both

Electrical

Connect electrical conductors between multi-wide units, but not to the main power source. This includes the bonding wire between multi-wide units. Pg. _____

Plumbing

Connect all sewer drains to an existing sewer tap or septic tank. Pg. _____

Connect all potable water supply piping to an existing water meter, water tap, or other independent water supply systems. Pg. _____

Site Preparation

Debris and organic material removed _____
Water drainage: Natural _____ Swale _____ Pad ☒ Other _____

Fastening multi wide units

Floor: Type Fastener: lags Length: 7 Spacing: 20
Walls: Type Fastener: lags Length: 6 Spacing: 10
Roof: Type Fastener: lags Length: 7 Spacing: 20

For used homes a min. 30 gauge, 8" wide, galvanized metal strip will be centered over the peak of the roof and fastened with galv. roofing nails at 2" on center on both sides of the centerline.

Gasket (weatherproofing requirement)

I understand a properly installed gasket is a requirement of all new and used homes and that condensation, mold, mildew and buckled marriage walls are a result of a poorly installed or no gasket being installed. I understand a strip of tape will not serve as a gasket.

Installer's Initials

Type gasket R11
Pg. factory

Installed:

Between Floors Yes ☒
Between Walls Yes ☒
Bottom of ridgebeam Yes ☒

Weatherproofing

The bottomboard will be repaired and/or taped. Yes ☒ Pg. _____
Siding on units is installed to manufacturer's specifications. Yes ☒
Fireplace chimney installed so as not to allow intrusion of rain water. Yes ☒

Miscellaneous

Skirting to be installed. Yes ☒ No _____
Dryer vent installed outside of skirting. Yes ☒ N/A _____
Range downflow vent installed outside of skirting. Yes ☒ N/A _____
Drain lines supported at 4 foot intervals. Yes ☒
Electrical crossovers protected. Yes ☒
Other: _____

Installer verifies all information given with this permit worksheet is accurate and true based on the manufacturer's installation instructions and or Rule 15C-1 & 2

Installer Signature

Ernest Scott Johnson Date _____




Blue Ridge II


BLOCKING LOCATIONS SHOWN ARE CONSIDERED TYPICAL. BLOCKS MAY BE MOVED FROM LOCATION SHOWN (WITH THE EXCEPTION OF BEARING WALL OR COLUMN LOCATIONS) AS LONG AS THE SPACING SPECIFIED IS NOT EXCEEDED. LINE 888 DIMENSIONS SPECIFIED IN THE NOTE ALLOW THE DISTANCE BETWEEN ADJACENT PILES MAY DEVIATE FROM THE 18" STD SPACING BY 1/8" TO 1/4" AS THE OVERALL AVERAGE DISTANCE BETWEEN PILES IS EQUAL TO OR LESS THAN THE LISTED SPACING. SEE SECTION 3 IN THE PALM HARBOR HOMES INSTALLATION MANUAL FOR MORE SPECIFIC ON BLOCKING THE HOME.

COLUMN LOADS

- ① = 8016 LBS.
- ② = 8016 LBS.

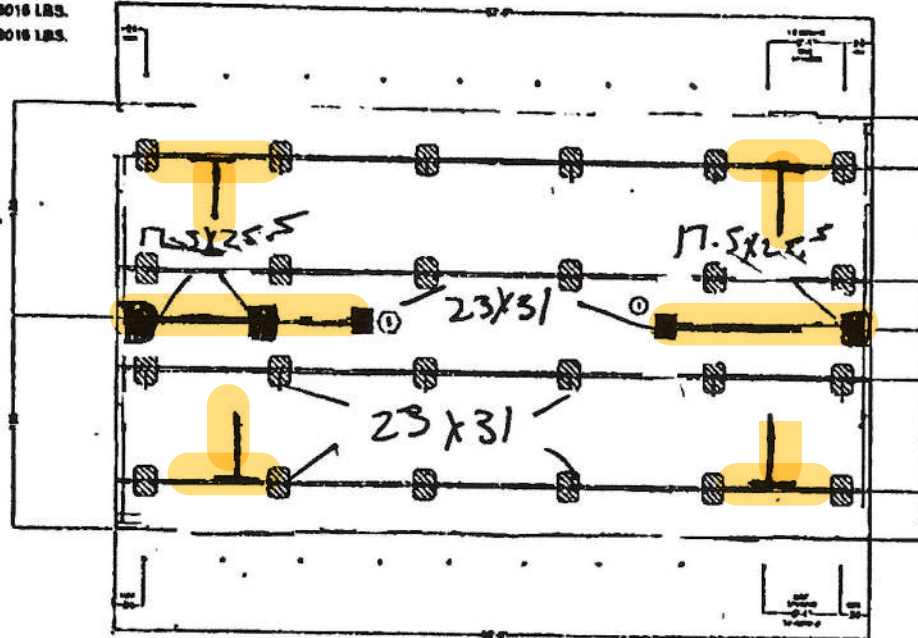

This plan may be built in an exact mirror image about its axis without any re-approval.
(May be applied left-to-right AND / OR front-to-rear.)

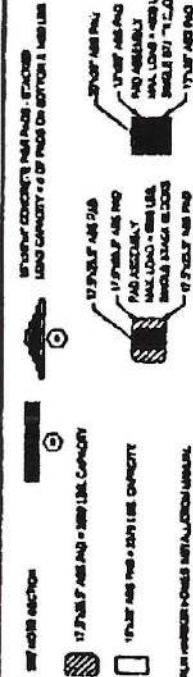

LEGEND

STABILIZER SYSTEM REQUIRED FOR ALL PALM HARBOR HOMES WITH ALUMINUM WALLS.

Model Number: CC30523A Serial Number: TBD	
2/3	
BLK-1	

NOTES

1. BLOCKING SPACING BASED ON 2000 LBS. LOAD ON EACH AND MIN. PILE BEARING CAPACITY.
2. CONCRETE BLOCKS ARE ONLY BUILT AT 2000 POUNDS, 4000 POUNDS OR HIGHER AND 16\"/>

7. STABILIZER SYSTEM FOR PALM HARBOR INSTALLATION MANUAL AND ALL EXISTING ANCHORS ARE SPACED AT 18\"/>



1/13/14

DATE

1/13/14

BDH/NTS

COILING CRAFT

BLUE RIDGE II

BLOCKING


11

11

340

CC30523A

Collins Craft Series

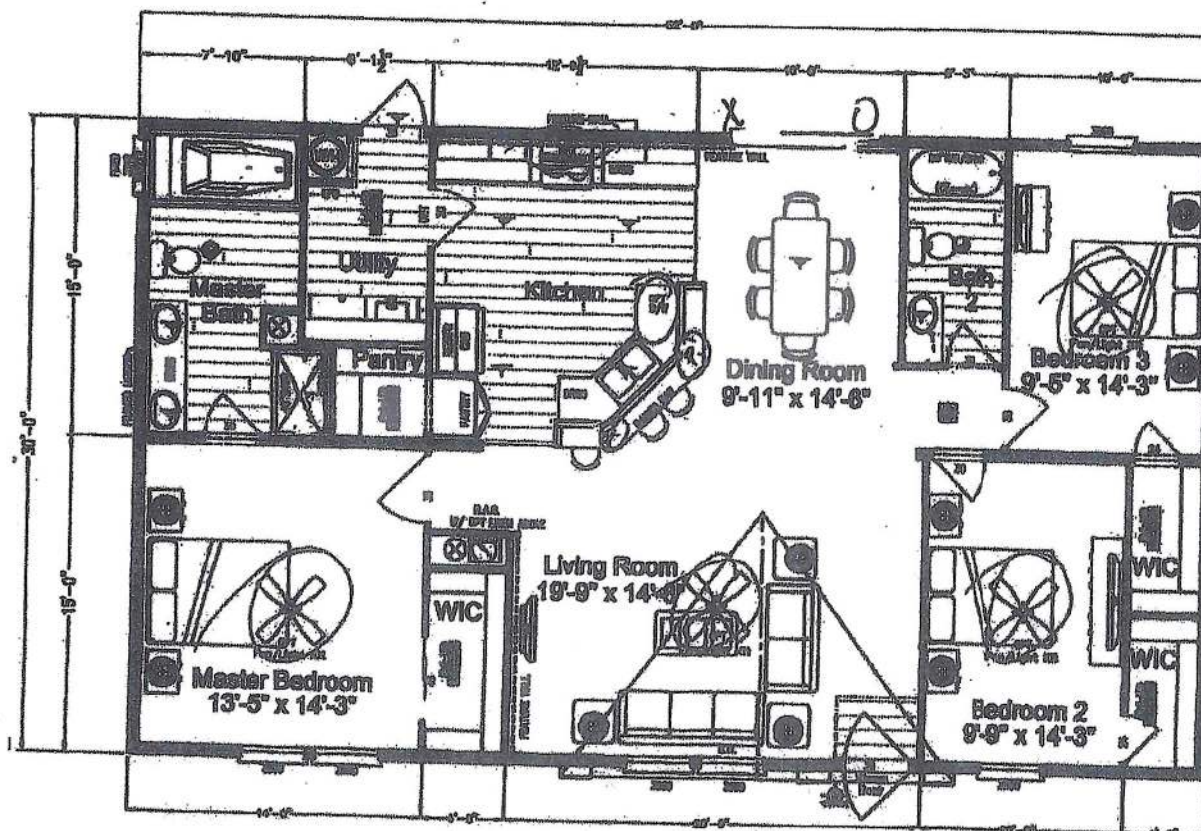

Blue Ridge II

340CC30528A

Approx. 1,800 Sq. Ft.

52' x 30'

3 Bedrooms, 2 Bathrooms
Master Suite w/ Garden Tub
Walk-In Closets Throughout
Kitchen w/ Raised Bar

Large Kitchen Pantry
Laundry Room w/ Washer &
Dryer Hook-ups
Full Bathroom w/ Front Door
Access

Original Spec
From PCMC
Release Date: MAY 26 2021

BOOKED